DOCUMENT No	REV	DOCUMENT TITLE	FORMAT
CONTDOCS/ 001	C	COVER SHEET	ACAD
AC 002	AC	DOCUMENT SCHEDULE - No.s 001 TO 100	ACAD
003	U	DOCUMENT SCHEDULE - No.s 101 TO 200	ACAD
004	K	DOCUMENT SCHEDULE - No.s 201 TO 300	ACAD
005			
006			
007			
008			
009			
010			
011			
012			
013			
014			
015			
016			
018	C	NOTES & ABBREVIATIONS	ACAD
020	D	PLC CABINET - EXTERNAL GENERAL ARRANGEMENT	ACAD
LAYOUTS/ 021	M	PLC CABINET - SWINGFRAME LAYOUT	ACAD
022	F	PLC CABINET - BACKPLATE LAYOUT	ACAD
023	C	PLAN VIEW / PLINTH FIXING DETAILS	ACAD
024	C	EMC CONTACT CLIP & EARTHING STRAP DETAILS	ACAD
025	C	24V DISTRIBUTION BOARD LAYOUT	ACAD
026	J	ANNUNCIATOR LAYOUT - No.3 PLANT	ACAD
026A	B	ANNUNCIATOR LAYOUT - No.3 PLANT	ACAD
027	D	ANNUNCIATOR LAYOUT - No.7 PLANT	ACAD
028	E	CONTROL PLATE LAYOUT - No.3 PLANT	ACAD
029	C	CONTROL PLATE LAYOUT - No.7 PLANT	ACAD
030	C	SYSTEM STATUS PLATE LAYOUT	ACAD
031	G	HIMA PES AND HSD PSU 1U LABEL STRIPS	ACAD
AC 032	E	LABEL DETAILS	ACAD
032A	D	LABEL DETAILS	ACAD
033	0	KEYSWITCH PLATE LAYOUT DETAILS	ACAD
034	0	KEYSWITCH PLATE LAYOUT DETAILS	ACAD
PWRDIST/ 035	F	POWER DISTRIBUTION -	ACAD
037		230Vac/24Vdc	
038			
039	F	PSU ALARM AND JUMPER CONFIGURATION	ACAD
040	D	MAIN SCHEMATIC FOR POWER AND WATCHDOG	ACAD
041	C	H51q-HS COMMUNICATION CONNECTION DETAILS	ACAD
042	0	KEYSWITCH WIRING DETAILS	
043	C	F7133 24Vdc DISTRIBUTION CARD 1118	ACAD
044	D	F7133 24Vdc DISTRIBUTION CARD 1119	ACAD
045	D	F7133 24Vdc DISTRIBUTION CARD 1120	ACAD
046	D	F7133 24Vdc DISTRIBUTION CARD 1121	ACAD
047	D	F7133 24Vdc DISTRIBUTION CARD 1218	ACAD
048	D	F7133 24Vdc DISTRIBUTION CARD 1219	ACAD
049	D	F7133 24Vdc DISTRIBUTION CARD 1220	ACAD
050	C	F7133 24Vdc DISTRIBUTION CARD 1221	ACAD

DOCUMENT No	REV	DOCUMENT TITLE	FORMAT
FLDS/ 051	J	FUNCTIONAL LOGIC DIAGRAM - No.3 PLANT COPPER DISSOLVING AREA	ACAD
052	H	FUNCTIONAL LOGIC DIAGRAM - No.3 PLANT COPPER DISSOLVING AREA	ACAD
053	F	FUNCTIONAL LOGIC DIAGRAM - No.3 PLANT COPPER DISSOLVING AREA	ACAD
054	F	FUNCTIONAL LOGIC DIAGRAM - No.3 PLANT CALCINER AND DRIER	ACAD
055	D	DRAWING DELETED LOGIC SPLIT TO 55A & 55B	ACAD
055A	A	FUNCTIONAL LOGIC DIAGRAM - No.3 PLANT ZINC DISSOLVING AREA	ACAD
055B	C	FUNCTIONAL LOGIC DIAGRAM - No.3 PLANT ZINC DISSOLVING AREA	ACAD
056	G	DRAWING DELETED	ACAD
056A	B	FUNCTIONAL LOGIC DIAGRAM - No.3 PLANT ZINC DISSOLVING AREA	ACAD
057	E	FUNCTIONAL LOGIC DIAGRAM - No.7 PLANT	ACAD
058	0	FUNCTIONAL LOGIC DIAGRAM - No.3 PLANT ZINC DISSOLVING AREA	ACAD
LOOPS/ 070	C	TYPICAL LOOP DIAGRAM - INPUTS	ACAD
071	D	TYPICAL LOOP DIAGRAM - OUTPUTS	ACAD
072			
073			
074			
075	E	LOOP DRAWING - INPUTS	ACAD
076	K	LOOP DRAWING - INPUTS	ACAD
077	F	LOOP DRAWING - INPUTS	ACAD
078	D	LOOP DRAWING - INPUTS	ACAD
079	E	LOOP DRAWING - INPUTS	ACAD
080	G	LOOP DRAWING - INPUTS	ACAD
081	K	LOOP DRAWING - INPUTS	ACAD
082	F	LOOP DRAWING - INPUTS	ACAD
083	B	LOOP DRAWING - INPUTS	
084	C	LOOP DRAWING - INPUTS	
085	A	LOOP DRAWING - INPUTS	
086	B	LOOP DRAWING - INPUTS	
087	E	LOOP DRAWING - INPUTS	ACAD
088	F	LOOP DRAWING - INPUTS	ACAD
AC 089	G	LOOP DRAWING - INPUTS	ACAD
090	G	LOOP DRAWING - INPUTS	ACAD
091	C	LOOP DRAWING - INPUTS	ACAD
092	E	LOOP DRAWING - INPUTS	ACAD
093	F	LOOP DRAWING - INPUTS	ACAD
094	G	LOOP DRAWING - INPUTS	ACAD
095	F	LOOP DRAWING - INPUTS	ACAD
096	E	LOOP DRAWING - INPUTS	ACAD
097	F	LOOP DRAWING - INPUTS	ACAD
098	E	LOOP DRAWING - INPUTS	ACAD
099	A	LOOP DRAWING - INPUTS	
100	A	LOOP DRAWING - INPUTS	

THIS DRAWING IS THE PROPERTY OF HIMA-SELLA LIMITED AND IS LOANED IN CONFIDENCE FOR USE WITH OUR WORK. IT IS NOT TO BE REPRODUCED IN ANY MANNER, SUBMITTED TO OUTSIDE PARTIES FOR EXAMINATION OR USED DIRECTLY OR INDIRECTLY FOR PURPOSES OTHER THAN THOSE FOR WHICH IT WAS FURNISHED WITHOUT WRITTEN CONSENT.

Template Revision – For Office Records Only

REV	AUTH	DATE	CAD TEMPLATE REF.
B	MB	7.4.10	A3-FRAME

Scale on A3 sheet	N/A
Dimensions	N/A

DO NOT STAMP 'MASTER' UNTIL ALL WORK IS FULLY CADDED

Rev	Design	Drawn	Chkd	Appd	Description	Date
V	DP	DB	JP	CT	PLANT 3 ESD CABINET MODS C10265039V	15.04.21
W	DP	DB	AD	CT	PLANT 3 ESD CABINET MODS C10265039V	09.06.21
X	DP	AL	AD	CT	AS BUILT C10265039V	13.07.21
Y	DP	TC	CT	CT	AS BUILT C10265037V	31.08.22
Z	JP	TC	CT	DP	PLANT 3 CALCINER MODS C10265047V	16.08.24
AA	JP	TC	AD	DP	CLIENT COMMENTS C10265047V	24.09.24
AB	JP	TC	AD	DP	C10265049V MODIFICATIONS	02.10.24
AC					AS BUILT C10265047V	01.07.25

Designed	NH
Drawn	NH
Checked	CW
Approved	NGB
Date	28.04.00
Cad Reference	10265-P3-002

HIMA–SELLA LIMITED © HIMA-SELLA

Title : DOCUMENT SCHEDULE - No.s 001 TO 100
ICI SYNETIX SCHEDULE - No.3 AND No.7 PLANTS
FISHER-ROSEMOUNTP.O. No. 99003994

Contract/ Drawing No	C10265H-P3	002	REV	AC

DOCUMENT No	REV	DOCUMENT TITLE	FORMAT	DOCUMENT No	REV	DOCUMENT TITLE	FORMAT
LOOPS/ 101	A	LOOP DRAWING - INPUTS	ACAD	151			
102	C	LOOP DRAWING - INPUTS	ACAD	152			
103	0	LOOP DRAWING - INPUTS		153	C	LOOP DRAWING - OUTPUTS	ACAD
104	0	LOOP DRAWING - INPUTS		154	C	LOOP DRAWING - OUTPUTS	ACAD
105	0	LOOP DRAWING - INPUTS		155	C	LOOP DRAWING - OUTPUTS	ACAD
106	0	LOOP DRAWING - INPUTS		156	C	LOOP DRAWING - OUTPUTS	ACAD
107	E	LOOP DRAWING - OUTPUTS	ACAD	157			
108	F	LOOP DRAWING - OUTPUTS	ACAD	158			
109	C	LOOP DRAWING - OUTPUTS	ACAD	159			
110	D	LOOP DRAWING - OUTPUTS	ACAD	160			
111	D	LOOP DRAWING - OUTPUTS	ACAD	161			
112	D	LOOP DRAWING - OUTPUTS	ACAD	162			
113	D	LOOP DRAWING - OUTPUTS	ACAD	163			
114	C	LOOP DRAWING - OUTPUTS	ACAD	164			
115	E	LOOP DRAWING - OUTPUTS	ACAD	165	C	LOOP DRAWING - OUTPUTS	ACAD
116	F	LOOP DRAWING - OUTPUTS	ACAD	166	D	LOOP DRAWING - OUTPUTS	ACAD
117	E	LOOP DRAWING - OUTPUTS	ACAD	167			
118	D	LOOP DRAWING - OUTPUTS	ACAD	168			
119	D	LOOP DRAWING - OUTPUTS	ACAD	169			
120	D	LOOP DRAWING - OUTPUTS	ACAD	170			
121	D	LOOP DRAWING - OUTPUTS	ACAD	171			
122	E	LOOP DRAWING - OUTPUTS	ACAD	172			
123	C	LOOP DRAWING - OUTPUTS		173			
124	C	LOOP DRAWING - OUTPUTS		174			
125	C	LOOP DRAWING - OUTPUTS		175			
126	C	LOOP DRAWING - OUTPUTS		176			
127	A	LOOP DRAWING - OUTPUTS		177			
128	A	LOOP DRAWING - OUTPUTS		178			
129	A	LOOP DRAWING - OUTPUTS		179			
130	A	LOOP DRAWING - OUTPUTS		180			
131	E	LOOP DRAWING - OUTPUTS	ACAD	181			
132	E	LOOP DRAWING - OUTPUTS	ACAD	182			
133	F	LOOP DRAWING - OUTPUTS	ACAD	183			
134	D	LOOP DRAWING - OUTPUTS	ACAD	184			
135	E	LOOP DRAWING - OUTPUTS	ACAD	185			
136	B	LOOP DRAWING - OUTPUTS	ACAD	186			
137	B	LOOP DRAWING - OUTPUTS	ACAD	187			
138	C	LOOP DRAWING - OUTPUTS	ACAD	188			
139	C	LOOP DRAWING - OUTPUTS	ACAD	189			
140	A	LOOP DRAWING - OUTPUTS	ACAD	190			
141	A	LOOP DRAWING - OUTPUTS	ACAD	191			
142	A	LOOP DRAWING - OUTPUTS	ACAD	192			
U 143	J	LOOP DRAWING - INPUTS	ACAD	193			
144	E	LOOP DRAWING - INPUTS	ACAD	194			
145	D	LOOP DRAWING - INPUTS	ACAD	195			
146	D	LOOP DRAWING - INPUTS	ACAD	196			
147	D	LOOP DRAWING - INPUTS	ACAD	197			
148	D	LOOP DRAWING - INPUTS	ACAD	198			
149				199			
150				SCHEDULE/ 200	E	ELCO SCHEDULES - ESD/ANNUNCIATOR	ACAD

THIS DRAWING IS THE PROPERTY OF HIMA-SELLA LIMITED AND IS LOANED IN CONFIDENCE FOR USE WITH OUR WORK. IT IS NOT TO BE REPRODUCED IN ANY MANNER, SUBMITTED TO OUTSIDE PARTIES FOR EXAMINATION OR USED DIRECTLY OR INDIRECTLY FOR PURPOSES OTHER THAN THOSE FOR WHICH IT WAS FURNISHED WITHOUT WRITTEN CONSENT.

Template Revision – For Office Records Only

REV	AUTH	DATE	CAD TEMPLATE REF.
B	MB	7.4.10	A3-FRAME

Scale on A3 sheet	N/A
Dimensions	N/A

DO NOT STAMP 'MASTER' UNTIL ALL WORK IS FULLY CADDED

Rev	Design	Drawn	Chkd	Appd	Description	Date
U					C10265049V MODIFICATIONS	02.10.24
M	DP	HG	SP	CT	AS BUILT POST C10265033V	01.05.19
N	DP	DB	EEM	CT	PLANT 3 ESD CABINET MODS C10265039V	29.01.21
P	DP	DB	JP	CT	PLANT 3 ESD CABINET MODS C10265039V	15.04.21
Q	DP	AL	AD	CT	AS BUILT C10265039V	13.07.21
R	DP	TC	CT	CT	AS BUILT C10265037V	31.08.22
S	JP	TC	CT	DP	PLANT 3 CALCINER MODS C10265047V	16.08.24
T	JP	TC	AD	DP	CLIENT COMMENTS C10265047V	29.10.14

Designed	NH
Drawn	NH
Checked	CW
Approved	NGB
Date	28.04.00
Cad Reference	10265-P3-003

HIMA–SELLA LIMITED © HIMA-SELLA

Title : DOCUMENT SCHEDULE - No.s 101 TO 200
ICI SYNETIX SCHEDULE - No.3 AND No.7 PLANTS
FISHER-ROSEMOUNTP.O. No. 99003994

Contract/ Drawing No	C10265H-P3	003	REV	U

DOCUMENT No	REV	DOCUMENT TITLE	FORMAT	DOCUMENT No	REV	DOCUMENT TITLE	FORMAT
SCHEDULE/ 201	F	ELCO SCHEDULES - ESD/ANNUNIATOR	ACAD	251			
202	F	ELCO SCHEDULES - ESD/ANNUNIATOR	ACAD	252			
203	F	ELCO SCHEDULES - ESD/OPERATORS CONSOLE	ACAD	253			
J 204	C	ELCO SCHEDULES - ESD/OPERATORS CONSOLE	ACAD	254			
205	C	ELCO SCHEDULES - ESD/OPERATORS CONSOLE	ACAD	255			
206	D	ELCO SCHEDULES - ESD/OPERATORS CONSOLE	ACAD	256			
207				257			
208	D	ANNUNCIATOR WIRING DIAGRAM - No.3 PLANT (MODIFY)	ACAD	258			
209	C	ANNUNCIATOR WIRING DIAGRAM - No.7 PLANT	ACAD	259			
210				260			
211				261			
212	C	CONTROL PLATE WIRING DIAGRAM - No.3 PLANT	ACAD	262			
213	C	CONTROL PLATE WIRING DIAGRAM - No.7 PLANT	ACAD	263			
214				264			
215				265			
216				266			
249				299			
250				SCHEDULE/ 300			

THIS DRAWING IS THE PROPERTY OF HIMA-SELLA LIMITED AND IS LOANED IN CONFIDENCE FOR USE WITH OUR WORK. IT IS NOT TO BE REPRODUCED IN ANY MANNER, SUBMITTED TO OUTSIDE PARTIES FOR EXAMINATION OR USED DIRECTLY OR INDIRECTLY FOR PURPOSES OTHER THAN THOSE FOR WHICH IT WAS FURNISHED WITHOUT WRITTEN CONSENT.

Template Revision – For Office Records Only

REV	AUTH	DATE	CAD TEMPLATE REF.
A	PRS	23.2.00	A3-FRAME

Scale on A3 sheet	N/A
Dimensions	N/A

DO NOT STAMP 'MASTER' UNTIL ALL WORK IS FULLY CADDED

Rev	Design	Drawn	Chkd	Appd	Description	Date
C	NH	NH	CW	NGB	AS BUILT	06.06.00
D	CP	EJC	CW	NGB	SITE MODS	15.09.09
E	IM	AB	IM	MRS	SITE MODS	11.08.11
F	CT	RE	PGB	NGB	AS BUILT PER C10265-006V	29.05.12
G	DP	MW	AD	CT	AS BUILT PER C10265-012V	29.10.14
H	DP	HG	AD	CT	MODS TO 3 PLANT ESD SYSTEM AS PER C10265033V	28.03.19
J					MODS TO 3 PLANT ESD SYSTEM AS PER C10265039V	29.01.21

Designed	NH
Drawn	NH
Checked	CW
Approved	NGB
Date	28.04.00
Cad Reference	10265-P3-004

HIMA–SELLA LIMITED © HIMA-SELLA

Title : DOCUMENT SCHEDULE - No.s 201 TO 300
ICI SYNETIX SCHEDULE - No.3 AND No.7 PLANTS
FISHER-ROSEMOUNTP.O. No. 99003994

Contract/ Drawing No	C10265H-P3	004	REV	J

50 | 100 | 150 | 200 | 250 | 300 | 350 | 400

Ø = TERMINAL

= SAKR LINK TERMINAL

ASK1 = ASK1 FUSE TERMINAL

= FUSE

= RELAY

= DIODE

= N.C. CONTACT

= N.O. CONTACT

= LIGHT EMITTING DIODE
R = RED,

= NORMALLY OPEN
PUSHBUTTON

= DOOR OPERATED
SWITCH

= DOUBLE POLE MCB

= ELCO CONNECTOR
(FEMALE)

= ELCO CONNECTOR
(MALE)

= FLUORESCENT LAMP
WITH MOTION SENSOR

= CAPACITOR

DRAWING REFERENCES

GRID REFERENCE
DRAWING SERIAL No.
029 . 100
1112 : z6
CABINET
RACK
CARD POSITION
PIN REFERENCE

B20 = PART REF RE BOM

AA
03.212
= CONTINUATION REFERENCE
(AS SHOWN ON FLD DRG)

XXXX = REFERENCE TO DELTA V/MODBUS
(AS SHOWN ON FLD DRG)

= STATUS INDICATION LAMP
(AS SHOWN ON FLD DRG)

F P/B = PUSHBUTTON
(AS SHOWN ON FLD DRG)

B K/S = KEYSWITCH
(AS SHOWN ON FLD DRG)

DIGITAL I/P F3236 = 16-FOLD DIGITAL INPUT MODULE
(AS SHOWN ON FLD DRG)

ANALOG I/P F6217 = 8-FOLD ANALOGUE INPUT MODULE
(AS SHOWN ON FLD DRG)

AND = 'AND' GATE
(AS SHOWN ON FLD DRG)

OR = 'OR' GATE
(AS SHOWN ON FLD DRG)

T2 OFF 3-30 MINS = TIMER
(AS SHOWN ON FLD DRG)

F3330 = 8-FOLD OUTPUT MODULE
(AS SHOWN ON FLD DRG)

RELAY AMP H4135 = RELAY AMPLIFIER
(AS SHOWN ON FLD DRG)

1-5V V TO I VCON-HL 4-20mA = SIGNAL ISOLATOR
(AS SHOWN ON FLD DRG)

= INVERTER
(AS SHOWN ON FLD DRG)

WIRE COLOURS

IS DIGITAL	=	BLUE 0.5mmSq
IS ANALOG	=	SCREENED CABLE WHERE POSSIBLE
NON IS ANALOG	=	SCREENED CABLE WHERE POSSIBLE
NON IS DIGITAL	=	GREY 0.5mmSq
LOGIC	=	GREY 0.5mmSq (OFF RACK), GREY 0.22mmSq (INTER-RACK)
24V +ve	=	RED
24V -ve	=	BLACK
≥120Vac LIVE	=	BROWN
≥120Vac NEUTRAL	=	BLUE
≥120Vac EARTH	=	YELLOW/GREEN
SCREEN EARTH	=	GREEN, 0.5mmSq
I.S. EARTH	=	GREEN/BLUE BAND
5v +ve	=	YELLOW 2.5mmSq
5v -ve	=	GREEN 2.5mmSq

(24V +ve, 24V -ve, ≥120Vac LIVE, ≥120Vac NEUTRAL) SIZED AS DRGS

ALL WIRING TO BE TRI-RATED BS6231

THIS DRAWING IS THE PROPERTY OF HIMA-SELLA LIMITED AND IS LOANED IN CONFIDENCE FOR USE WITH OUR WORK. IT IS NOT TO BE REPRODUCED IN ANY MANNER, SUBMITTED TO OUTSIDE PARTIES FOR EXAMINATION OR USED DIRECTLY OR INDIRECTLY FOR PURPOSES OTHER THAN THOSE FOR WHICH IT WAS FURNISHED WITHOUT WRITTEN CONSENT.

Template Revision – For Office Records Only

REV	AUTH	DATE	CAD TEMPLATE REF.
A	PRS	23.2.00	STDPLC020

Scale on A3 sheet	1:10
Dimensions	mm

DO NOT STAMP 'MASTER' UNTIL ALL WORK IS FULLY CADDED

Rev	Design	Drawn	Chkd	Appd	Description	Date
P2	NH	NH	CW	NGB	GENERALLY UPDATED	11.04.00
C	NH	NH	CW	NGB	AS BUILT	06.06.00

Designed	NH
Drawn	NH
Checked	CW
Approved	NGB
Date	16.03.00
Cad Reference	
10265-P3-018#NH01	

HIMA–SELLA LIMITED © HIMA-SELLA

Title : PLC CABINET - EXTERNAL G.A.
ICI SYNETIX ESD SYSTEM - No.3 AND No.7 PLANTS
FISHER-ROSEMOUNT - P.O. No. 99003994

Contract/ Drawing No	C10265H/P3	018	REV	C

50 100 150 200 250 300 350 400

800 1200 800

400

CABINET ESD 1
No.3 AND No.7 PLANT
ISOLATE AT:
DSS-11D-3 WAY 2

180 °HINGES

D

2000

FRONT VIEW
(DOOR CLOSED)

300

250

TICO ANTI-VIBRATION
MOUNTING
12mm NOMINAL

ADJUSTABLE FEET
45mm - 120mm
35mm NOMINAL

100

SIDE VIEW

THIS DRAWING IS THE PROPERTY OF HIMA-SELLA LIMITED AND IS LOANED IN CONFIDENCE FOR USE WITH OUR WORK. IT IS NOT TO BE REPRODUCED IN ANY MANNER, SUBMITTED TO OUTSIDE PARTIES FOR EXAMINATION OR USED DIRECTLY OR INDIRECTLY FOR PURPOSES OTHER THAN THOSE FOR WHICH IT WAS FURNISHED WITHOUT WRITTEN CONSENT.

Template Revision – For Office Records Only

REV	AUTH	DATE	CAD TEMPLATE REF.
A	PRS	23.2.00	STDPLC020

Scale on A3 sheet	1:10
Dimensions	mm

DO NOT STAMP 'MASTER' UNTIL ALL WORK IS FULLY CADDED

Rev	Design	Drawn	Chkd	Appd	Description	Date
P2	NH	NH	CW	NGB	UPDATED WITH CLIENTS COMMENTS.	10.04.00
	NH	NH	CW			
D				CT	MARSHALLING CABINET ADDED	13.02.14

Designed	NH
Drawn	NH
Checked	CW
Approved	NGB
Date	16.03.00
Cad Reference	
10265-P3-020#NH01	

HIMA–SELLA LIMITED © HIMA-SELLA

Title : PLC CABINET – EXTERNAL G.A.
ICI SYNETIX ESD SYSTEM – No.3 AND No.7 PLANTS
FISHER–ROSEMOUNT – P.O. No. 99003994

Contract/ Drawing No	C10265H/P3	020	REV	D

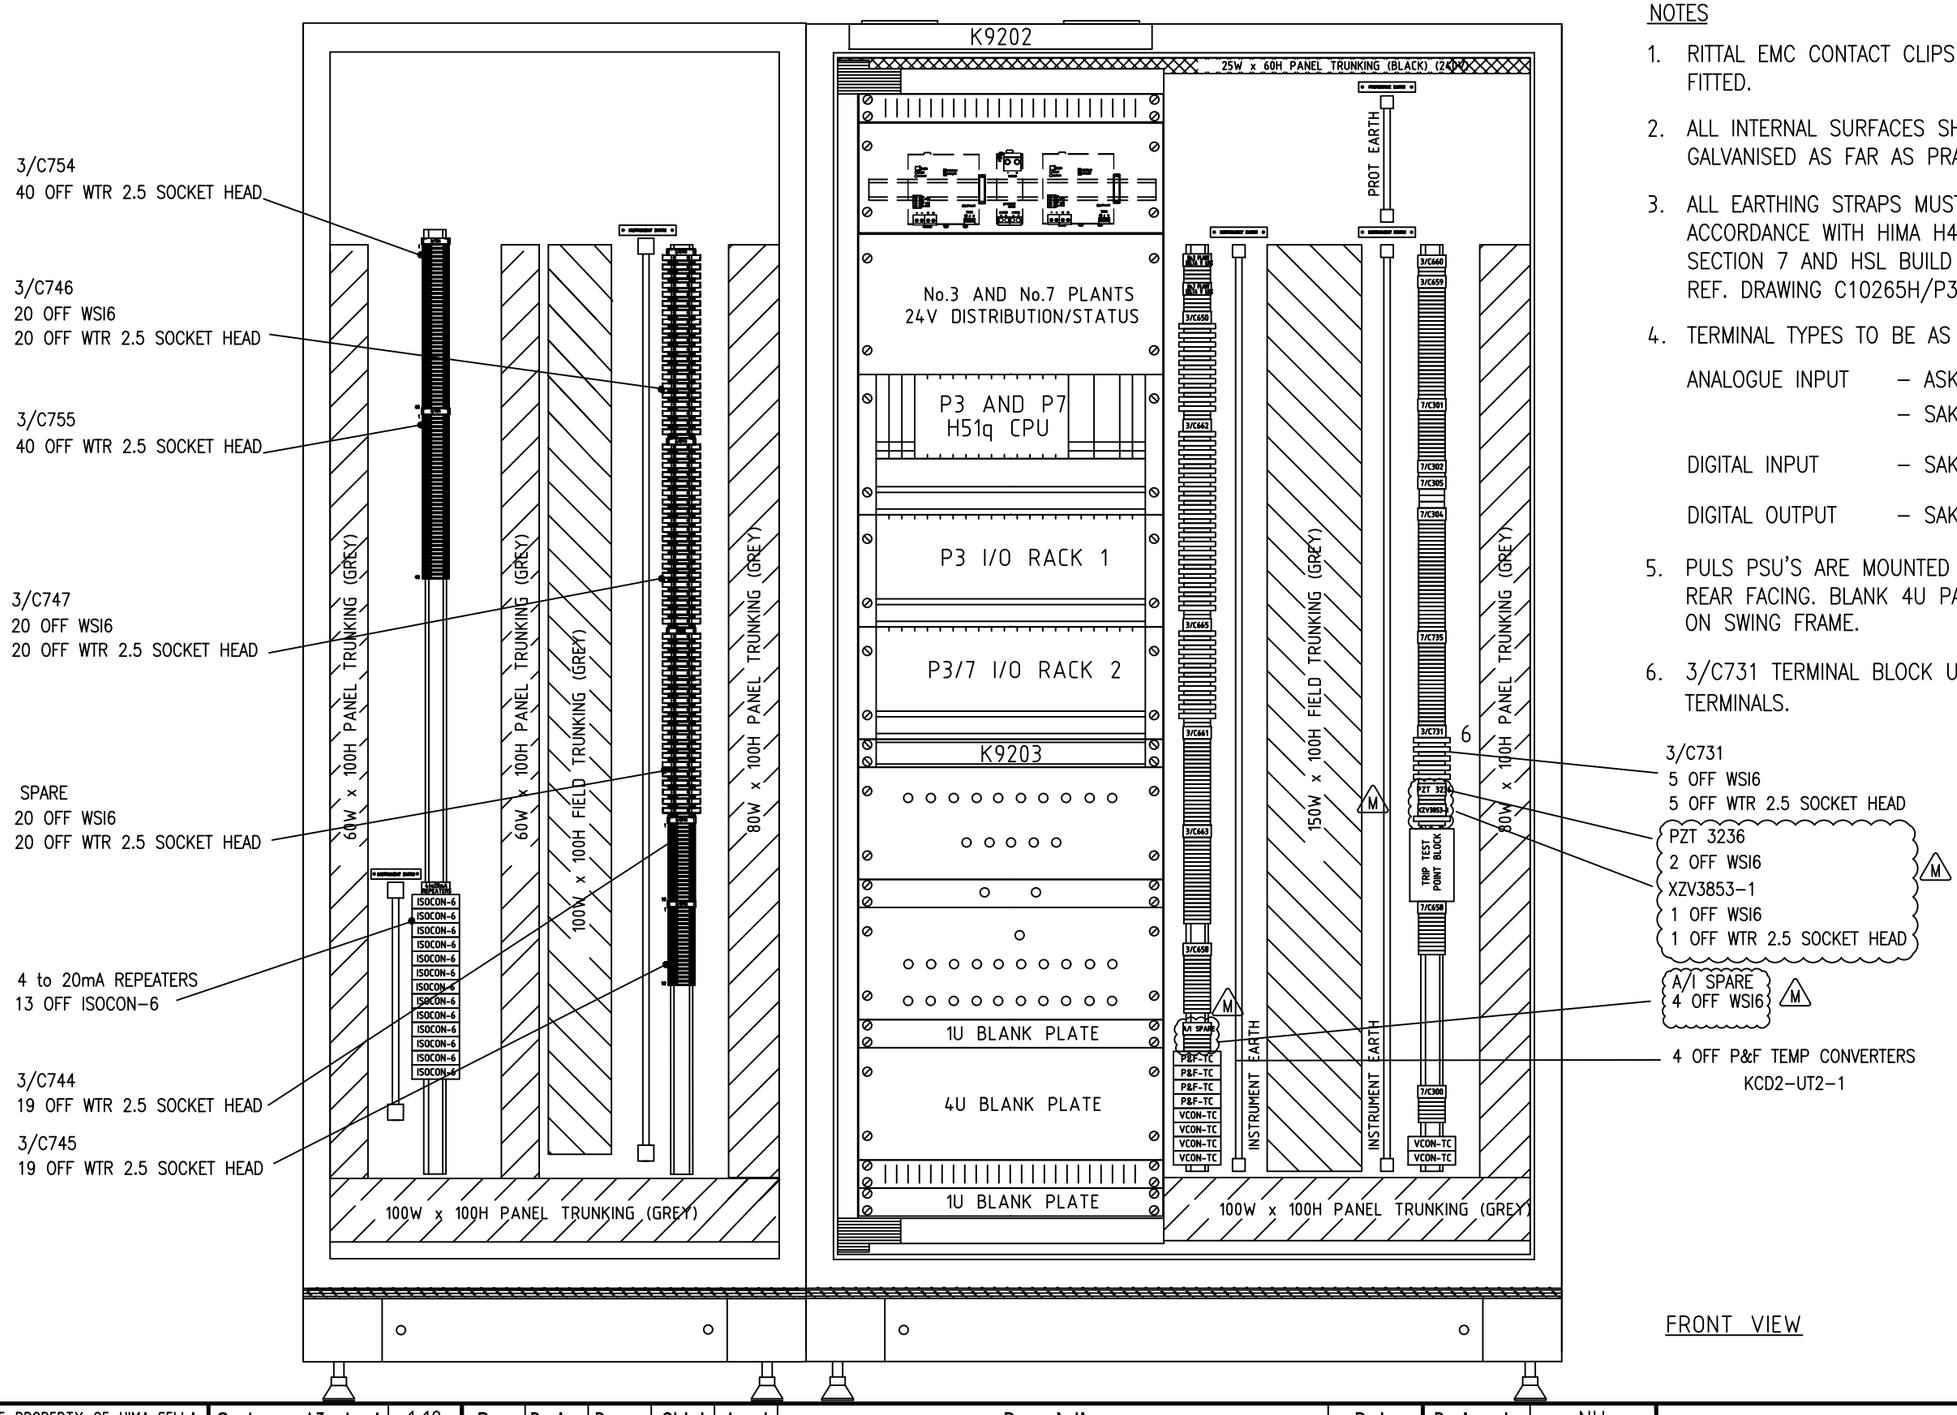

FRONT VIEW

NOTES

1. RITTAL EMC CONTACT CLIPS TO BE FITTED.
2. ALL INTERNAL SURFACES SHOULD BE GALVANISED AS FAR AS PRACTICABLE.
3. ALL EARTHING STRAPS MUST BE IN ACCORDANCE WITH HIMA H41/51 MANUAL SECTION 7 AND HSL BUILD PROCEDURES, REF. DRAWING C10265H/P3/024.
4. TERMINAL TYPES TO BE AS FOLLOWS:

   ANALOGUE INPUT – ASK1 FUSE TERMINAL
   – SAKR SOCKET HEAD TERMINAL

   DIGITAL INPUT – SAKR CHEESE HEAD TERMINAL

   DIGITAL OUTPUT – SAKR CHEESE HEAD TERMINAL

5. PULS PSU'S ARE MOUNTED ON DIN RAIL AND REAR FACING. BLANK 4U PANEL MOUNTED ON SWING FRAME.
6. 3/C731 TERMINAL BLOCK UPDATED TO SHOW FUSED TERMINALS.

THIS DRAWING IS THE PROPERTY OF HIMA-SELLA LIMITED AND IS LOANED IN CONFIDENCE FOR USE WITH OUR WORK. IT IS NOT TO BE REPRODUCED IN ANY MANNER, SUBMITTED TO OUTSIDE PARTIES FOR EXAMINATION OR USED DIRECTLY OR INDIRECTLY FOR PURPOSES OTHER THAN THOSE FOR WHICH IT WAS FURNISHED WITHOUT WRITTEN CONSENT.

Template Revision – For Office Records Only			
REV	AUTH	DATE	CAD TEMPLATE REF.
A	PRS	23.2.00	STDPLC021

DO NOT STAMP 'MASTER' UNTIL ALL WORK IS FULLY CADDED

Scale on A3 sheet	1:10
Dimensions	mm

Rev	Design	Drawn	Chkd	Appd	Description	Date
G	AD	DTB	AD	CT	ADDITIONAL AND REPLACEMENT HARDWARE	01.09.16
H	DP	HG	SP	CW	MODS TO 3 PLANT ESD SYSTEM AS PER C10265033V	28.03.19
J	DP	HG	CT	CT	PLANT 3/7 RACK & PSU UPGRADE AS PER C10265035V	01.05.19
K	DP	HF	MDI	CT	AS BUILT AS PER C10265035V	25.06.19
L	DP	DB	JP	CT	PLANT 3 ESD CABINET MODS C10265039V	15.04.21
M	.	.	.	CT	AS BUILT C10265039V	13.07.21

Designed	NH
Drawn	NH
Checked	CW
Approved	NGB
Date	16.03.00
Cad Reference	10265-P3-021#NH01

HIMA–SELLA LIMITED © HIMA-SELLA

Title : PLC CABINET - SWINGFRAME LAYOUT
ICI SYNETIX ESD SYSTEM - No.3 AND No.7 PLANTS
FISHER-ROSEMOUNT - P.O. No. 99003994

Contract/ Drawing No	C10265H/P3	021	REV	M

50 100 150 200 250 300 350 400

INTERNAL SIDE VIEW
RIGHT HAND SIDE

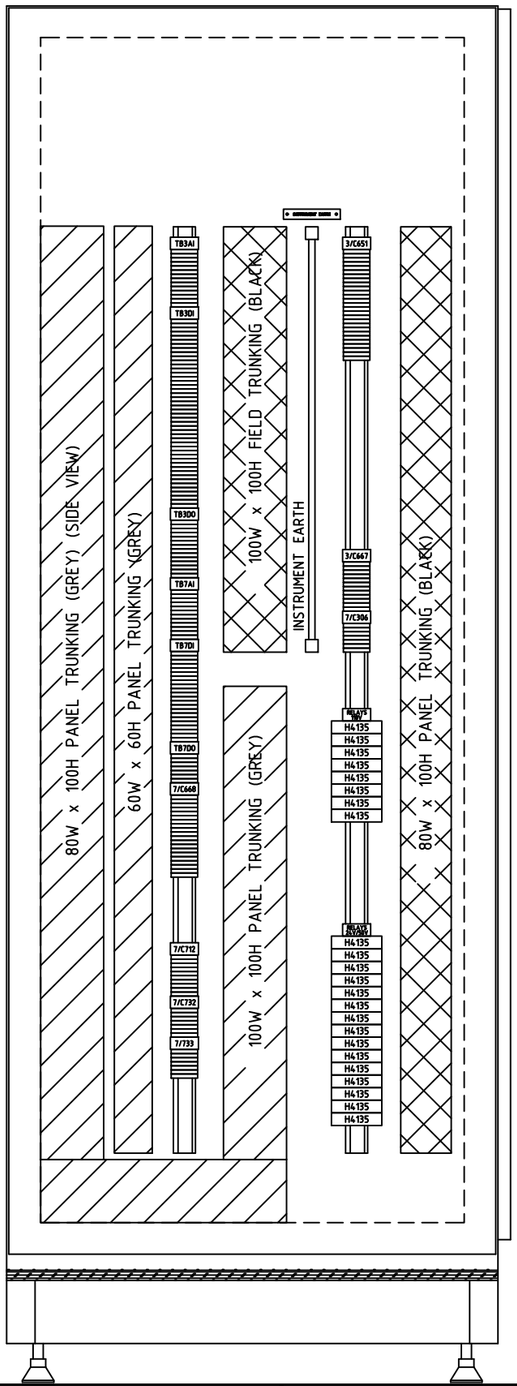

'A'

FRONT VIEW
OF BACKPLATE

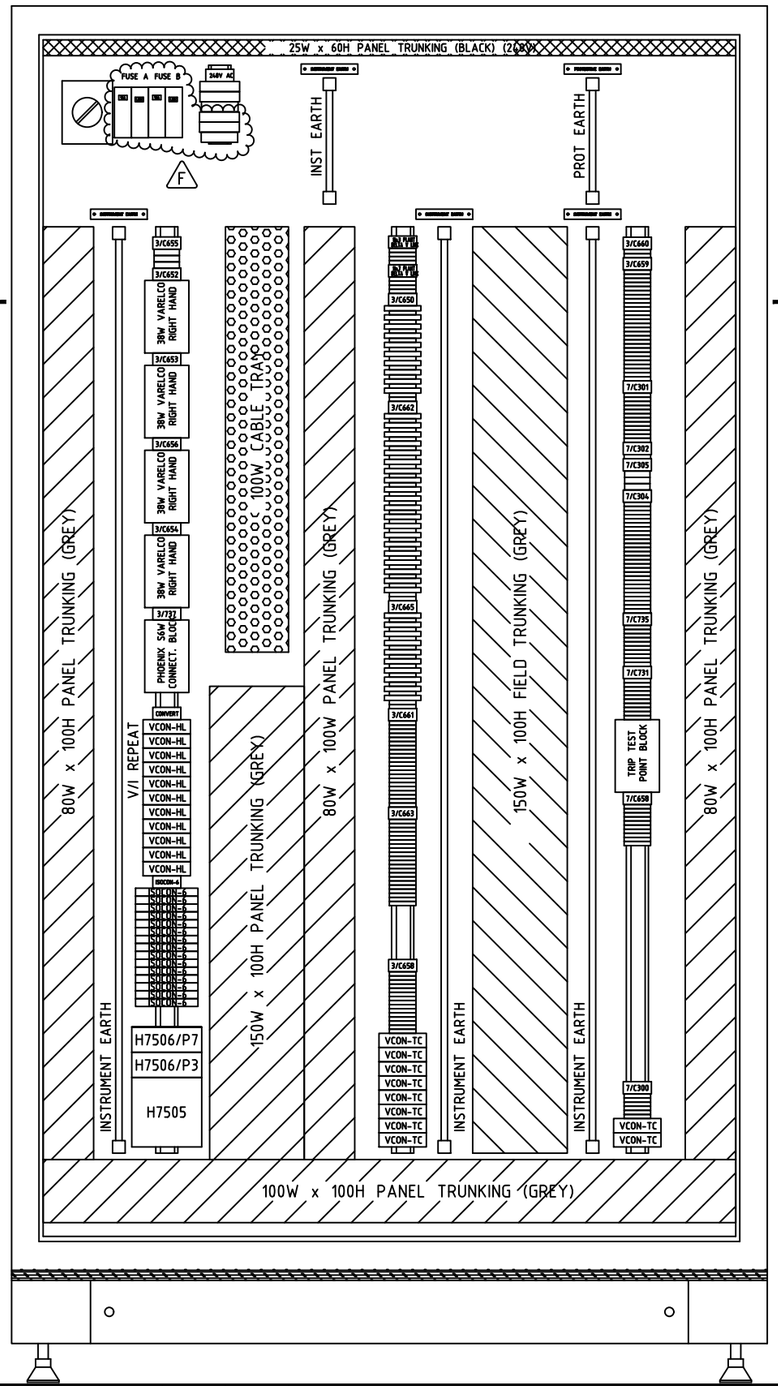

'A'

INTERNAL SIDE VIEW
LEFT HAND SIDE

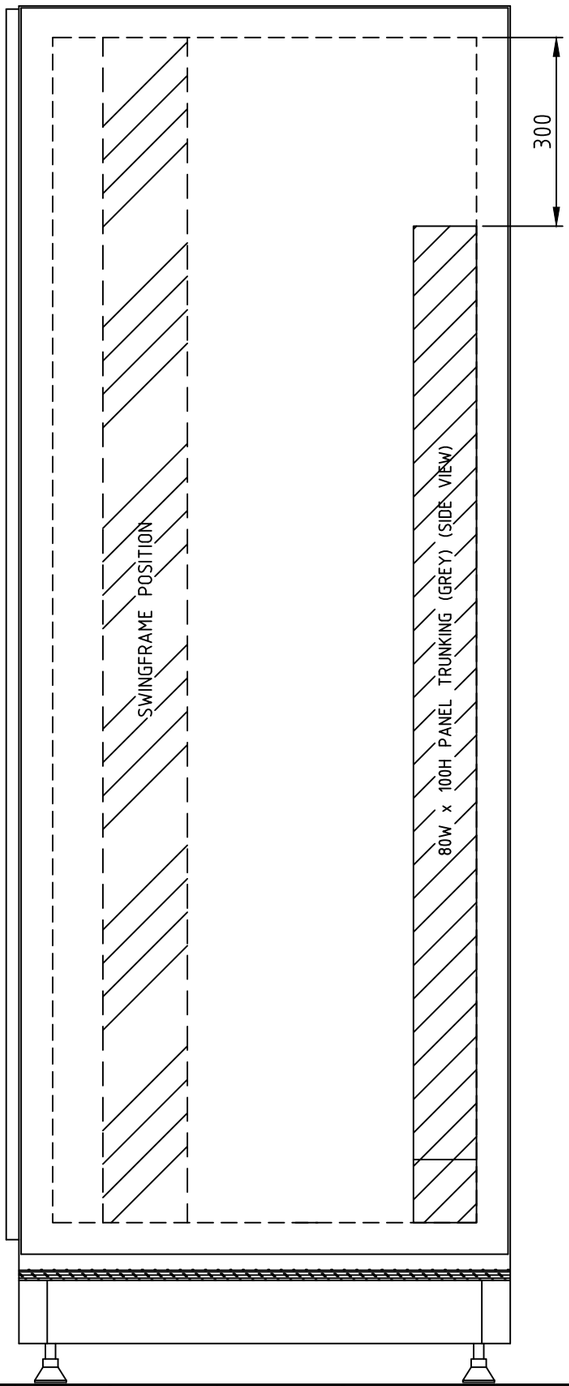

NOTES

1. SEE DRG C10265H/P3/023 FOR VIEW ON A-A.

THIS DRAWING IS THE PROPERTY OF HIMA-SELLA LIMITED AND IS LOANED IN CONFIDENCE FOR USE WITH OUR WORK. IT IS NOT TO BE REPRODUCED IN ANY MANNER, SUBMITTED TO OUTSIDE PARTIES FOR EXAMINATION OR USED DIRECTLY OR INDIRECTLY FOR PURPOSES OTHER THAN THOSE FOR WHICH IT WAS FURNISHED WITHOUT WRITTEN CONSENT.

Template Revision – For Office Records Only

REV	AUTH	DATE	CAD TEMPLATE REF.
A	PRS	23.2.00	STDPLC022

Scale on A3 sheet	1:10
Dimensions	mm

DO NOT STAMP 'MASTER' UNTIL ALL WORK IS FULLY CADDED

Rev	Design	Drawn	Chkd	Appd	Description	Date
P2	NH	NH	CW	NGB	UPDATED WITH CLIENTS COMMENTS.	10.04.00
P3	NH	NH	CW	NGB	UPDATED WITH CLIENTS COMMENTS.	28.04.00
C	NH	NH	CW	NGB	AS BUILT.	06.06.00
D	RE	GP	SA	CT	NEW TERMINALS ADDED	11.10.11
E	DP	HG	SP	CW	MODS TO 3 PLANT ESD SYSTEM AS PER C10265033V	21.03.19
F				CT	PLANT 3/7 RACK AND PSU UPGRADES AS PER C10265035V	01.05.19

Designed	NH
Drawn	NH
Checked	CW
Approved	NGB
Date	16.03.00
Cad Reference	10265-P3-022#NH01

HIMA–SELLA LIMITED © HIMA-SELLA

Title : PLC CABINET - BACKPLATE LAYOUT
ICI SYNETIX ESD SYSTEM - No.3 AND No.7 PLANTS
FISHER-ROSEMOUNT - P.O. No. 99003994

Contract/ Drawing No	C10265H/P3	022	REV	F

50 100 150 200 250 300 350 400

PLAN VIEW
SHOWING CUTOUTS FOR FAN K9202

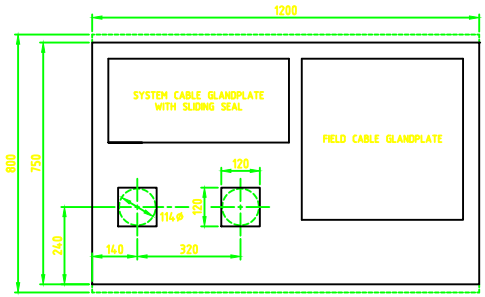

PLINTH FIXING DETAILS

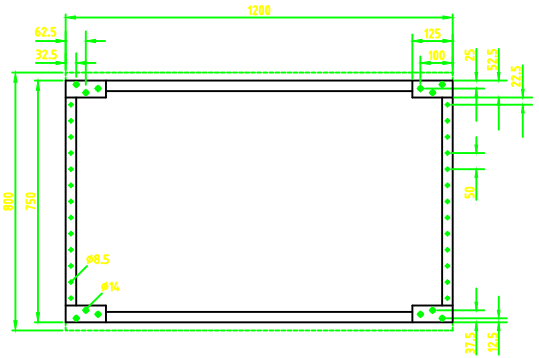

PLAN VIEW ON A-A

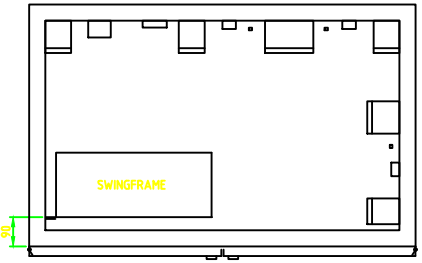

THIS DRAWING IS THE PROPERTY OF HIMA-SELLA LIMITED AND IS LOANED IN CONFIDENCE FOR USE WITH OUR WORK. IT IS NOT TO BE REPRODUCED IN ANY MANNER, SUBMITTED TO OUTSIDE PARTIES FOR EXAMINATION OR USED DIRECTLY OR INDIRECTLY FOR PURPOSES OTHER THAN THOSE FOR WHICH IT WAS FURNISHED WITHOUT WRITTEN CONSENT.

Template Revision - For Office Records Only

REV	AUTH	DATE	CAD TEMPLATE REF.
A	PRS	22.2.00	STDP11023

Scale on A3 sheet 1:10
Dimensions mm

DO NOT STAMP 'MASTER' UNTIL ALL WORK IS FULLY CADDED

Rev	Design	Drawn	Chkd	Appd	Description	Date
P2	NH	NH	CW	NGB	UPDATED WITH CLIENTS COMMENTS.	10.04.00
P3	NH	NH	CW	NGB	UPDATED WITH CLIENTS COMMENTS.	28.04.00
C				NGB	AS BUILT.	06.06.00

Designed	NH
Drawn	NH
Checked	CW
Approved	NGB
Date	16.03.00
Cad Reference	10265-P3-023ø NH01

HIMA-SELLA LIMITED

Title : PLAN VIEW / PLINTH FIXING DETAILS
ICI SYNETIX ESD SYSTEM - No.3 AND No.7 PLANTS
FISHER-ROSEMOUNT - P.O. No. 99003996

Contract/ Drawing No C10265H/P3 023 REV C

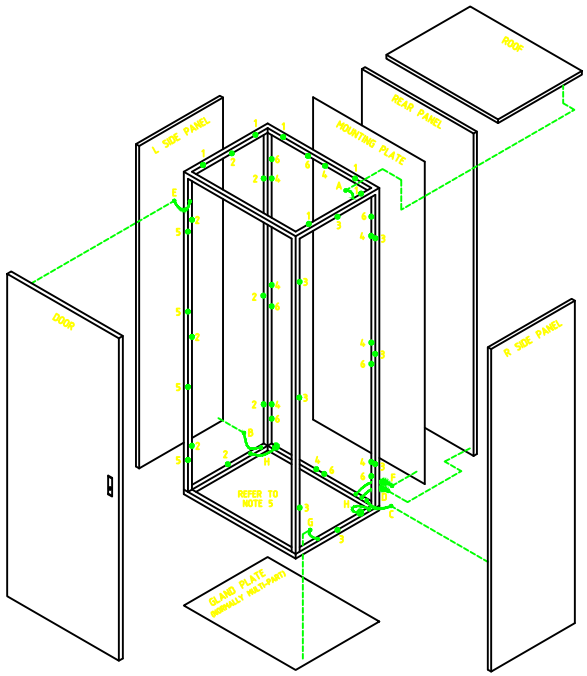

APPLICATION OF EARTH STRAPS FROM CABINET FRAME					
ITEM	MODEL No.	CSA	LGTH	APPLICATION	TYPICAL QTY
A	SZ 2568	16mm	300mm	ROOF PANEL	1
B	SZ 2568	16mm	300mm	LEFT SIDE PANEL	1
C	SZ 2568	16mm	300mm	RIGHT SIDE PANEL	1
D	SZ 2568	16mm	300mm	REAR PANEL	1
E	SZ 2568	16mm	300mm	DOOR	1
F	SZ 2568	16mm	300mm	MOUNTING PLATE	1
G	SZ 2568	16mm	300mm	GLAND PLATE	1
H	SZ 2569	25mm	300mm	EARTH BAR	2
NOT SHOWN	TO MANUFACTURER	25mm	500mm	SWING FRAME	1

APPLICATION OF EMC CONTACT CLIPS			
ITEM	MODEL No.	APPLICATION	TYPICAL QTY
1	PS 4312	ROOF PANEL	6
2	PS 4312	LEFT SIDE PANEL	8
3	PS 4312	RIGHT SIDE PANEL	8
4	PS 4312	REAR PANEL	8
5	PS 4332	DOOR	8
6	PS 4334	MOUNTING PLATE	8
7	PS 4313	GLAND PLATE	4
NOT SHOWN	PS 4337	BAYING PANELS	8

NOTES

1. ONE EMC CONTACT CLIP SHOULD BE INSTALLED AT APPROXIMATELY 400mm INTERVALS.
2. WHEN A SWING FRAME IS FITTED DO NOT INSTALL EMC CONTACT CLIPS DOWN THE LOCK SIDE OF THE FRAME.
3. ALL SURFACES WHERE EARTH STRAPS ARE TO BE FITTED MUST BE CLEAN METAL TO METAL CONTACT i.e. REMOVE ALL PAINT BEFORE MAKING THE CONNECTION. PAINT BARE METAL WITH CONDUCTIVE PAINT.
4. EMC CLIPS ONLY FITTED TO BACKPLATE WHEN IT IS IN STANDARD REARMOST POSITION. WHEN MOUNTED CENTRALLY USE A MINIMUM OF 2 STRAPS TOP & BOTTOM.
5. SUPPLY EMC CLIPS FOR GLANDPLATE LOOSE WITH INSTRUCTIONS FOR FITTING AT SITE.
6. POSITIONS OF EMC CLIPS ARE SHOWN FOR GUIDANCE ONLY. THE ACTUAL INSTALLATION SHOULD TAKE INTO ACCOUNT PRACTICALITY OF ACCESS.

THIS DRAWING IS THE PROPERTY OF HIMA-SELLA LIMITED AND IS LOANED IN CONFIDENCE FOR USE WITH OUR WORK. IT IS NOT TO BE REPRODUCED IN ANY MANNER, SUBMITTED TO OUTSIDE PARTIES FOR EXAMINATION OR USED DIRECTLY OR INDIRECTLY FOR PURPOSES OTHER THAN THOSE FOR WHICH IT WAS FURNISHED WITHOUT WRITTEN CONSENT.

Scale on A3 sheet 1:20
Dimensions mm

Rev	Design	Drawn	Chkd	Appd	Description	Date
C				NGB	AS BUILT.	06.06.00

Designed NH
Drawn NH
Checked CW
Approved NGB
Date 16.03.00
Cad Reference 10265-P3-024.dwgNH01

HIMA-SELLA LIMITED

Title : EMC CONTACT CLIP & EARTHING STRAP DETAILS
ICI SYNETIX ESD SYSTEM - No.3 AND No.7 PLANTS
FISHER-ROSEMOUNT - P.O. No. 99003996

Contract/Drawing No C10265H/P3 024 REV C

Template Revision - For Office Records Only

REV	AUTH	DATE	CAD TEMPLATE REF.
A	PRS	12.2.00	STDP1C024

DO NOT STAMP 'MASTER' UNTIL ALL WORK IS FULLY CADDED

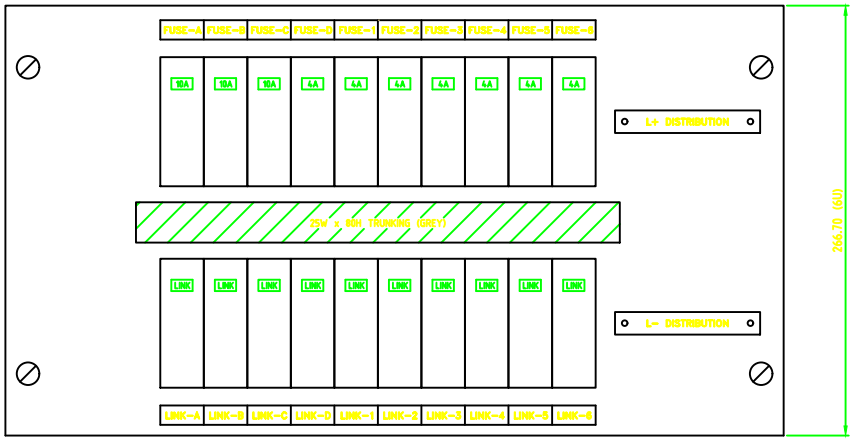

NOTES

1. FUSE HOLDERS TO BE GEC REDSPOT, SIZE A1, FRONT CONNECTED, BLACK.
2. LINK HOLDERS TO BE GEC REDSPOT, SIZE A1, FRONT CONNECTED, WHITE.
3. LABELS TO BE TRAFFOLYTE. (SEE DRG C10265H/P3/032 FOR DETAILS)

THIS DRAWING IS THE PROPERTY OF HIMA-SELLA LIMITED AND IS LOANED IN CONFIDENCE FOR USE WITH OUR WORK. IT IS NOT TO BE REPRODUCED IN ANY MANNER, SUBMITTED TO OUTSIDE PARTIES FOR EXAMINATION OR USED DIRECTLY OR INDIRECTLY FOR PURPOSES OTHER THAN THOSE FOR WHICH IT WAS FURNISHED WITHOUT WRITTEN CONSENT.

Scale on A3 sheet 1:2
Dimensions mm

Rev	Design	Drawn	Chkd	Appd	Description	Date
C				NGB	AS BUILT.	06.06.00

Designed NH
Drawn NH
Checked CW
Approved NGB
Date 12.04.00
Cad Reference 10265-P3-025#NH01

HIMA-SELLA LIMITED

Title : 24V DISTRIBUTION BOARD LAYOUT
ICI SYNETIX ESD SYSTEM - No.3 AND No.7 PLANTS
FISHER-ROSEMOUNT - P.O. No. 99003996

Contract/Drawing No C10265H/P3 025 REV C

Template Revision - For Office Records Only

REV	AUTH	DATE	CAD TEMPLATE REF.
A	PRS	12.2.00	STDP11025

DO NOT STAMP 'MASTER' UNTIL ALL WORK IS FULLY CADDED

50 100 150 200 250 300 350 400

No.3 PLANT ANNUNCIATOR LAYOUT DETAILS

ANNUNCIATORS 'NOT' IN PANEL BUT MOUTED ON A PLATE ON CONSOLE

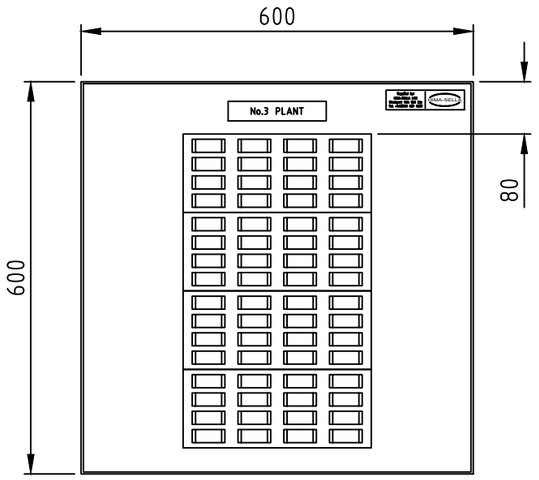

FRONT VIEW
(DOOR CLOSED)

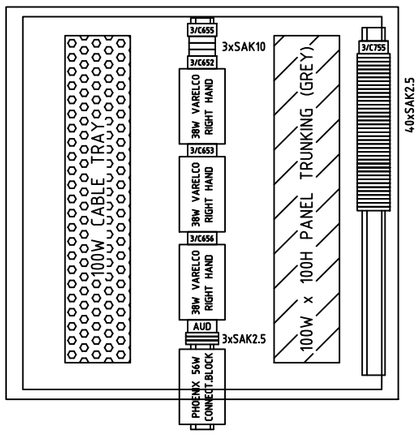

FRONT VIEW OF BACKPLATE

NOTES

1. ANNUNCIATOR SINGLE UNIT CUT-OUT SIZE: 280W x 112H.

No.3 PLANT ANNUNCIATOR WINDOW LABEL DETAILS

(SCALE 1:2)

01 FZA 03002 69% NITRIC ACID LOW FLOW TRIP	02 FZA 03004 SCRUBBER LIQUOR LOW FLOW TRIP	03 PZA 03923 HIGH PRESSURE IN F61 DISSOLVER	04 HZS 03351 OXYGEN OVERRIDE SWITCH ACTIVATED
05 ES 03738 OVERRIDE ENABLED ZINC	06 LZA 03110A 3F1 Cu DISSOLVER HIGH LEVEL TRIP	07 LZA 03110B 3F1 Cu DISSOLVER LOW LEVEL TRIP	08
09	10	11 PDZA 03078 3J3 SCRUBBER VENT FAN LOW D/P TRIP	12 HZS 03350 Cu DISSOLVING LOW FLOW TRIPS DEFEATED
13 QZA 03164 NORTH SITE EFFLUENT PH OUT OF LIMITS TRIP	14 FZA 03012 Cu NITRATE RECIRCULATION LOW FLOW TRIP	15 EZS 03412/13 3J4A & B COOLING WATER PUMPS FAILED	16 LZA 03110C 3F1 Cu DISSOLVER MID-LEVEL TRIP
17 LZA 03110D 3F1 Cu DISSOLVER RECIRCULATION TRIP	18 PZA 03087 Cu NITRATE RECYCLE HIGH PRESSURE TRIP	19 TZA 03730 3G2B DUST UNIT HIGH INLET TEMPERATURE TRIP	20 PZA 03734 3B2 HIGH EXHAUST PRESSURE TRIP
21 YSA 03228 3B3 DRYER BURNER TRIP	22 YSA 03229 3B4 CALCINER BURNER TRIP	23	24
25 TZA 03220 CALCINER HEATER EXIT HIGH TEMPERATURE TRIP	26	27	28
29 EZA 03402 3B2 CALCINER DRIVE STOPPED	30 EZA 03449 3J65 CALCINER PURGE FAN STOPPED	31 GZA 03568 3T7S SLIDE VALVE POWDER TO CALCINER OR IBC CLOSED	32 EZA 03448 3J63 CALCINER RECIRCULATION AIR FAN STOPPED
33 FZA 03622 SCRUBBER LIQUOR TO ACID MIXING POT LOW FLOW TRIP	34 FZA 03647 ZINC NITRATE RECIRCULATION LOW FLOW TRIP	35 TZA 03610A HIGH TEMPERATURE IN ZINC DISSOLVER F61	36
37	38 LZA 03148 3F16 ZINC NITRATE STORAGE TANK HIGH LEVEL TRIP	39 TZA 03610B LOW TEMPERATURE IN ZINC DISSOLVER F61	40 LZA 03609B F61 ZINC DISSOLVER MID-LEVEL INHIBIT
41 LZA 03613 F62 ZINC RUNDOWN TANK HIGH LEVEL TRIP	42	43 HZS 03615 MANUAL OXYGEN ADDITION STOP/START	44 EZS 03344/5 J13A AND J13B COOLING WATER PUMPS FAILED
45 LZA 03691 3F3 SCRUBBER LIQUOR TANK LOW LEVEL TRIP	46 FZA 03007 SCRUBBER LIQUOR TO 3E1 LOW FLOW TRIP	47 FZA 03008 REFLUX TO 3E1 LOW FLOW TRIP	48 FZA 03010 REFLUX TO 3E2 LOW FLOW TRIP
49 EZA 03713 BOC OXYGEN SUPPLY LOW TRIP	50 TZA03715 HIGH TEMP EXIT 3J23	51 TZA 03213 3B1 INLET HIGH TEMPERATURE	52 FZA 03006A OXYGEN LOW FLOW
53	54 LZS 03692 3F6 CU NITRATE STORAGE HIGH HIGH LEVEL TRIP	55 TZA 03234 A/B 3B3 EXIT HIGH TEMPERATURE	56 TZA 03714 BOC SUPPLY LOW TEMP TRIP
57 QZA 03581 3F1 CU DISSOLVER MIXED ACID DENSITY TRIP	58 TZA 03052A HIGH TEMPERATURE IN 3F1	59 TZA 03235 3G8 INLET HIGH TEMPERATURE	60 TZA03052B LOW TEMPERARURE IN 3F1
61	62 PZA 03079 3F1 CU DISSOLVER HIGH PRESSURE TRIP	63 PZA 03236 3B1 HIGH PRESSURE	64 ESA 03712 OVERRIDE ENABLED COPPER

J

NOTES

1. ALL WINDOWS TO BE COLOURED RED WITH THE EXCEPTION OF WINDOWS 5 & 64 WHICH SHALL BE BLUE
2. ALL TEXT TO BE 2.5mm HIGH AND CENTRED ON WINDOW.
3. TEXT TO BE FILLED WHITE.
4. WINDOWS 01-48 F.U. GROUP SEQUENCE 7.

THIS DRAWING IS THE PROPERTY OF HIMA-SELLA LIMITED AND IS LOANED IN CONFIDENCE FOR USE WITH OUR WORK. IT IS NOT TO BE REPRODUCED IN ANY MANNER, SUBMITTED TO OUTSIDE PARTIES FOR EXAMINATION OR USED DIRECTLY OR INDIRECTLY FOR PURPOSES OTHER THAN THOSE FOR WHICH IT WAS FURNISHED WITHOUT WRITTEN CONSENT.

Template Revision – For Office Records Only

REV	AUTH	DATE	CAD TEMPLATE REF.
A	PRS	9.2.00	A3-FRAME

Scale on A3 sheet	1:10
Dimensions	MM

DO NOT STAMP 'MASTER' UNTIL ALL WORK IS FULLY CADDED

Rev	Design	Drawn	Chkd	Appd	Description	Date
J	.	.	.	CT	PLANT 3 ESD CABINET MODS C10265039V	29.01.21
D	NH	NH	CW	NGB	SITE MODS	15.09.00
E	IM	AB	IM	NGB	TEXT CHANGES TO LABEL 3B2	11.08.11
F	CT	RE	PGB	NGB	AS BUILT PER C10265-006V	29.05.12
G	DP	MW	AD	CT	AS BUILT PER C10265-012V	29.10.14
H	DP	HG	SP	CT	PROJECT ARPG-80 MODS TO 3 PLANT ESD SYSTEM	19.03.19

Designed	NH
Drawn	NH
Checked	CW
Approved	NGB
Date	23.03.00
Cad Reference	10265-P3-026#RE02

HIMA-SELLA LIMITED © HIMA-SELLA

Title : ANNUNCIATOR LAYOUT – No.3 PLANT
ICI SYNETIX ESD SYSTEM – No.3 AND No.7 PLANTS
FISHER – ROSEMOUNT – P.O. No. 99003994

Contract/ Drawing No	C10265H/P3	026	REV	J

50 | 100 | 150 | 200 | 250 | 300 | 350 | 400

No.3 PLANT ANNUNCIATOR LAYOUT DETAILS

ANNUNCIATORS 'NOT' IN PANEL BUT MOUTED ON A PLATE ON CONSOLE

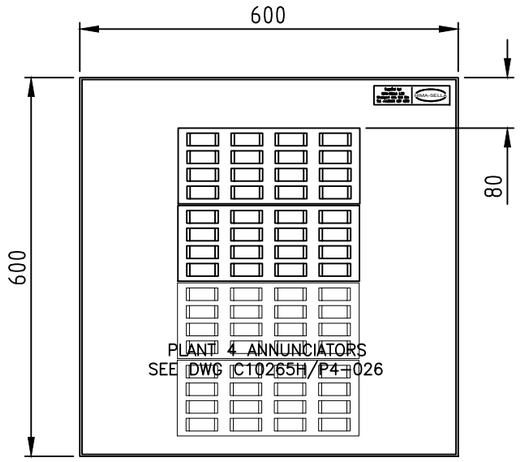

FRONT VIEW
(DOOR CLOSED)

NOTES

1. ANNUNCIATOR SINGLE UNIT CUT-OUT SIZE: 280W x 112H.

No.3 PLANT ANNUNCIATOR WINDOW LABEL DETAILS

(65) TZA 03052C Cu DISSOLVER HIGH HIGH TEMPERATURE TRIP	(66) TZA 03052D 3F1 DISSOLVER LOW LOW TEMPERATURE TRIP	(67) TZT 03919 LOW TEMPERATURE IN 3F1 RECIRCULATION	(68) TZT 03920 LOW TEMPERATURE IN 3F1 RECIRCULATION
(69) FZA 03006B OXYGEN TO 3F1 Cu DISSOLVER LOW LOW LOW FLOW TRIP	(70) FZT 03579 LOW RECIRCULATION FLOW AROUND 3F1	(71) LZT 03122 HIGH LEVEL IN F31 TRIP	(72) PZA 03696 HIGH PRESSURE TRIP IN 3F1
(73) TZT 03614 HIGH TEMPERATURE IN F61 DISSOLVER	(74) TZT 03614 LOW TEMPERATURE IN F61 DISSOLVER	(75) TZT 03743 LOW TEMPERATURE IN F61 DISSOLVER	(76) PZA 03358 HIGH PRESSURE
(77) FZT 03619 LOW OXYGEN FLOW F61 DISSOLVER	(78) FZT 03749 LOW RECIRCULATION FLOW E5 SCRUBBER	(79) FZT 03751 LOW RECIRCULATION FLOW E15 SCRUBBER	(80) FZT 03918 LOW RECIRCULATION AROUND F61 DISSOLVER
(81) LZT 03609A HIGH LEVEL IN F61 DISSOLVER	(82) LZA 03700 HIGH HIGH LEVEL 3F15 A	(83)	(84)
(85) FZT 03752 LOW OXYGEN FLOW F61 DISSOLVER	(86) FZT 03748 LOW RECIRCULATION FLOW E5 SCRUBBER	(87) FZT 03750 LOW RECIRCULATION FLOW E15 SCRUBBER	(88) FZT 03618B HIGH NITRIC ACID FLOW TO F61 DISSOLVER
(89) FZT 03618A LOW NITRIC ACID FLOW TO F61 DISSOLVER	(90) TZT 03744 HIGH TEMPERATURE IN F61 DISSOLVER	(91) TZT 03744 LOW TEMPERATURE IN F61 DISSOLVER	(92) LZS 03747 HIGH LEVEL IN 3F16 STORAGE TANK
(93) LZT 03746 HIGH LEVEL IN F62 RUN DOWN TANK	(94) QZT 03583 MIXED ACID TO F61 HIGH DENSITY	(95)	(96)

NOTES

1. ALL WINDOWS TO BE COLOURED RED EXCEPT OVERRIDE ENABLED WHICH SHALL BE BLUE
2. ALL TEXT TO BE 2.5mm HIGH AND CENTRED ON WINDOW.
3. TEXT TO BE FILLED WHITE.

THIS DRAWING IS THE PROPERTY OF HIMA-SELLA LIMITED AND IS LOANED IN CONFIDENCE FOR USE WITH OUR WORK. IT IS NOT TO BE REPRODUCED IN ANY MANNER, SUBMITTED TO OUTSIDE PARTIES FOR EXAMINATION OR USED DIRECTLY OR INDIRECTLY FOR PURPOSES OTHER THAN THOSE FOR WHICH IT WAS FURNISHED WITHOUT WRITTEN CONSENT.

Template Revision – For Office Records Only

REV	AUTH	DATE	CAD TEMPLATE REF.
A	PRS	9.2.00	A3-FRAME

Scale on A3 sheet	1:10
Dimensions	MM

DO NOT STAMP 'MASTER' UNTIL ALL WORK IS FULLY CADDED

Rev	Design	Drawn	Chkd	Appd	Description	Date
A				MI	PROJECT ARPG-80 MODS TO 3 PLANT ESD SYSTEM	20.03.19

Designed	DP
Drawn	MW
Checked	AD
Approved	CT
Date	29.10.14
Cad Reference	10265-P3-026A#RE02

HIMA–SELLA LIMITED © HIMA-SELLA

Title : ANNUNCIATOR LAYOUT – No.3 PLANT
ICI SYNETIX ESD SYSTEM – No.3 AND No.7 PLANTS
FISHER – ROSEMOUNT – P.O. No. 99003994

Contract/ Drawing No				
	C10265H/P3	026A	REV	A

50 100 150 200 250 300 350 400

No.7 PLANT ANNUNCIATOR LAYOUT DETAILS

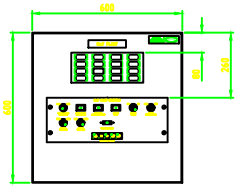

FRONT VIEW
(DOOR CLOSED)

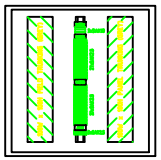

FRONT VIEW OF BACKPLATE

NOTES
1. ANNUNCIATOR SINGLE UNIT CUT-OUT SIZE: 280W x 112H.
2. No.7 PLANT KEYSWITCH/PUSHBUTTON CONTROL PLATE MOUNTED ON THE FRONT DOOR BELOW THE ANNUNCIATOR.

No.7 PLANT ANNUNCIATOR WINDOW LABEL DETAILS
(SCALE 1:2)

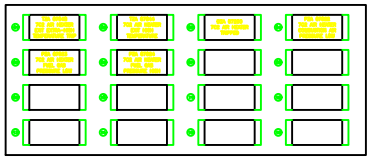

NOTES
1. ALL WINDOWS TO BE COLOURED RED.
2. ALL TEXT TO BE 2.5mm HIGH AND CENTRED ON WINDOW.
3. TEXT TO BE FILLED WHITE.
4. WINDOWS 01-16 FJU GROUP SEQUENCE 7.

THIS DRAWING IS THE PROPERTY OF HIMA-SELLA LIMITED AND IS LOANED IN CONFIDENCE FOR USE WITH OUR WORK. IT IS NOT TO BE REPRODUCED IN ANY MANNER, SUBMITTED TO OUTSIDE PARTIES FOR EXAMINATION OR USED DIRECTLY OR INDIRECTLY FOR PURPOSES OTHER THAN THOSE FOR WHICH IT WAS FURNISHED WITHOUT WRITTEN CONSENT.

Scale on A3 sheet 1:10
Dimensions mm

Rev	Design	Drawn	Chkd	Appd	Description	Date
B2	NH	NH	CW	RGB	UPDATED WITH CLIENTS COMMENTS.	07.04.0
C				RGB	AS BUILT.	06.06.0
D	NH		PH		AS BUILT	11.06.1

Designed NH
Drawn NH
Checked CW
Approved RGB
Date 23.07.00

Cad Reference
10265-P3-027.dwg(H01)

HIMA-SELLA LIMITED

Title : ANNUNCIATOR LAYOUT - No.7 PLANT
FOR SYNETIX ESD SYSTEM - No.3 AND No.7 PLANTS
FISHER-ROSEMOUNT - P.O. No. 99003991.

Contract/Drawing No C10265H/P3 027 REV D

Standard Tolerance - For Office Use Only Date

DEV	CHECK	DESIGN	CAD TEMPLATE DEV.
± 1	± 0.5	± 0.25	± 0.125

DO NOT STAMP 'MASTER' UNTIL ALL WORK IS FULLY CARDED

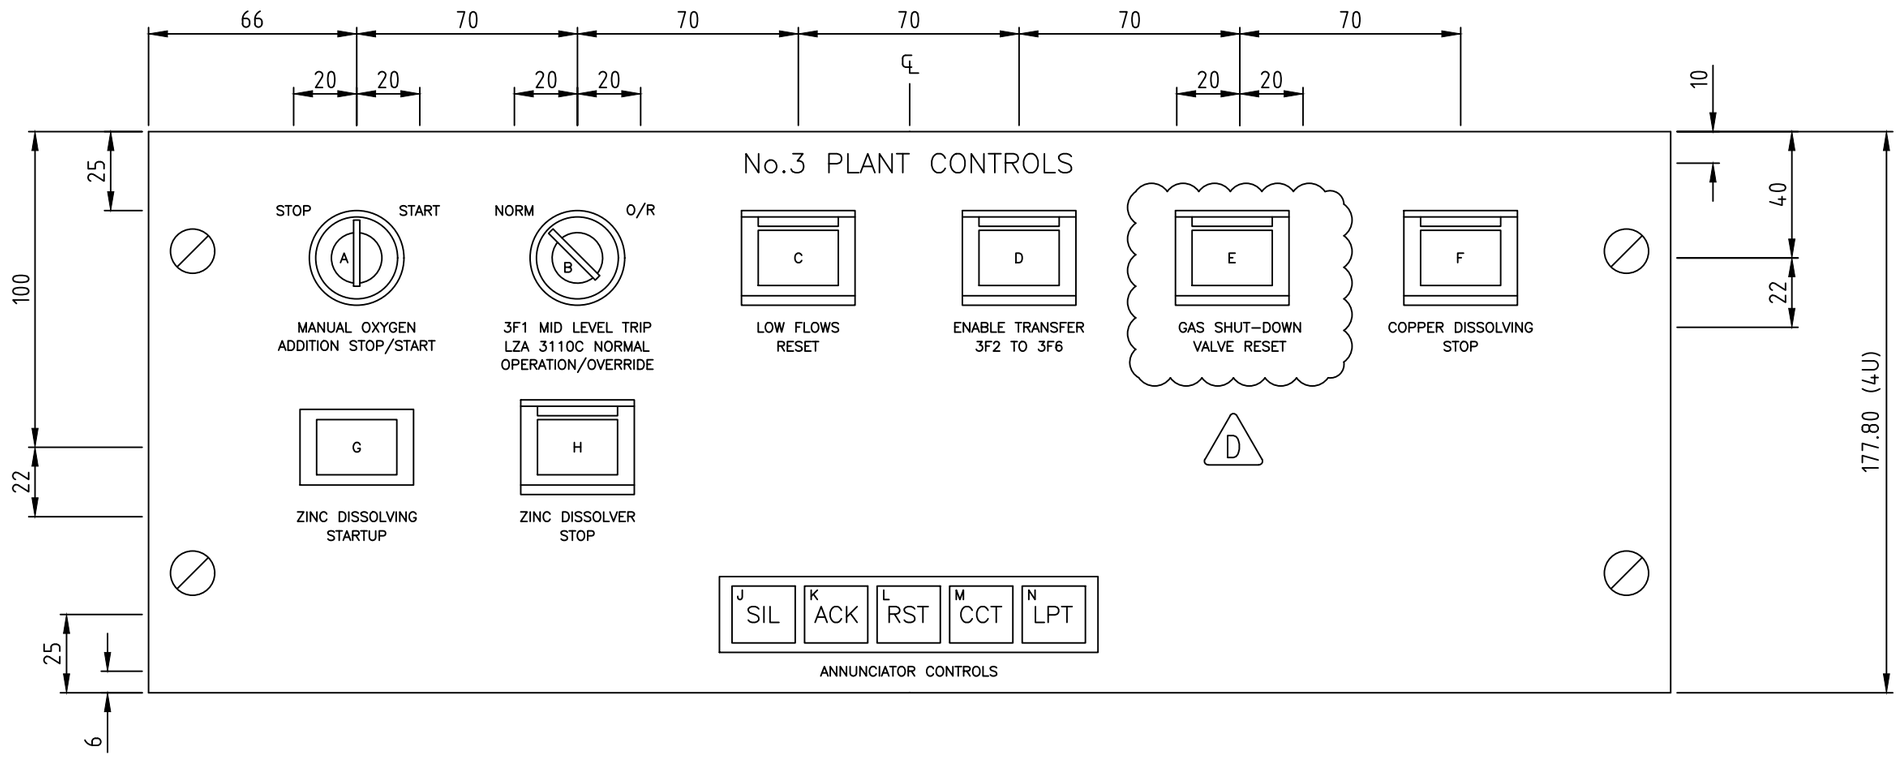

NOTES

1. KEYSWITCHES ARE TELEMECANIQUE.
2. PUSHBUTTONS ARE EAO.
3. TO BE MANUFACTURED FROM ALUMINIUM.
4. GENERAL TEXT TO BE ENGRAVED 3mm BLACK.
   PLATE NAME TEXT TO BE ENGRAVED 6mm BLACK.
5. ALL TEXT TO BE CENTRED.
6. ALL DIMENSIONS ARE TO CENTRES OF TEXT AND HOLES.
7. ITEM LETTERS REFER TO THE FISHER-ROSEMOUNT FDS LETTERING ALLOCATION. (FDS REV A1)

ITEM	CONTROL	TYPE
A	KEYSWITCH	3 POSITION - SPRING RETURN
B	KEYSWITCH	2 POSITION - STAY PUT
C	PUSHBUTTON	GREEN - SHIELDED - MOMENTARY
D	PUSHBUTTON	GREEN - SHIELDED - MOMENTARY
E	PUSHBUTTON	GREEN - SHIELDED - MOMENTARY
F	PUSHBUTTON	RED - SHIELDED - MAINTAINED
G	PUSHBUTTON	GREEN - FLUSH - MOMENTARY
H	PUSHBUTTON	RED - SHIELDED - MAINTAINED

D

CUT OUT DETAILS FOR ANNUNCIATOR CONTROL MODULE

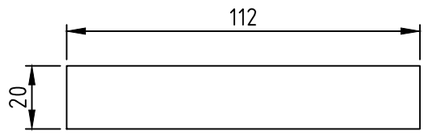

CUT OUT DETAILS FOR PUSHBUTTONS

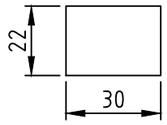

CUT OUT DETAILS FOR SWITCHES

THIS DRAWING IS THE PROPERTY OF HIMA-SELLA LIMITED AND IS LOANED IN CONFIDENCE FOR USE WITH OUR WORK. IT IS NOT TO BE REPRODUCED IN ANY MANNER, SUBMITTED TO OUTSIDE PARTIES FOR EXAMINATION OR USED DIRECTLY OR INDIRECTLY FOR PURPOSES OTHER THAN THOSE FOR WHICH IT WAS FURNISHED WITHOUT WRITTEN CONSENT.

Template Revision – For Office Records Only

REV	AUTH	DATE	CAD TEMPLATE REF.
A	PRS	9.2.00	A3-FRAME

Scale on A3 sheet	1:2
Dimensions	mm

DO NOT STAMP 'MASTER' UNTIL ALL WORK IS FULLY CADDED

Rev	Design	Drawn	Chkd	Appd	Description	Date
P2	NH	NH	CW	NGB	UPDATED WITH CLIENTS COMMENTS.	27.04.00
C	NH	NH	CW	NGB	AS BUILT.	06.06.00
D				CT	PLANT 3 ESD CABINET MODS FOR C10265039V	29.01.21

Designed	NH
Drawn	NH
Checked	CW
Approved	NGB
Date	27.03.00
Cad Reference	10265-P3-028#NH01

HIMA-SELLA LIMITED © HIMA-SELLA

Title : CONTROL PLATE LAYOUT - No.3 PLANT
ICI SYNETIX ESD SYSTEM - No.3 AND No.7 PLANTS
FISHER-ROSEMOUNT - P.O. No. 99003994

Contract/ Drawing No	C10265H/P3	028	REV	D

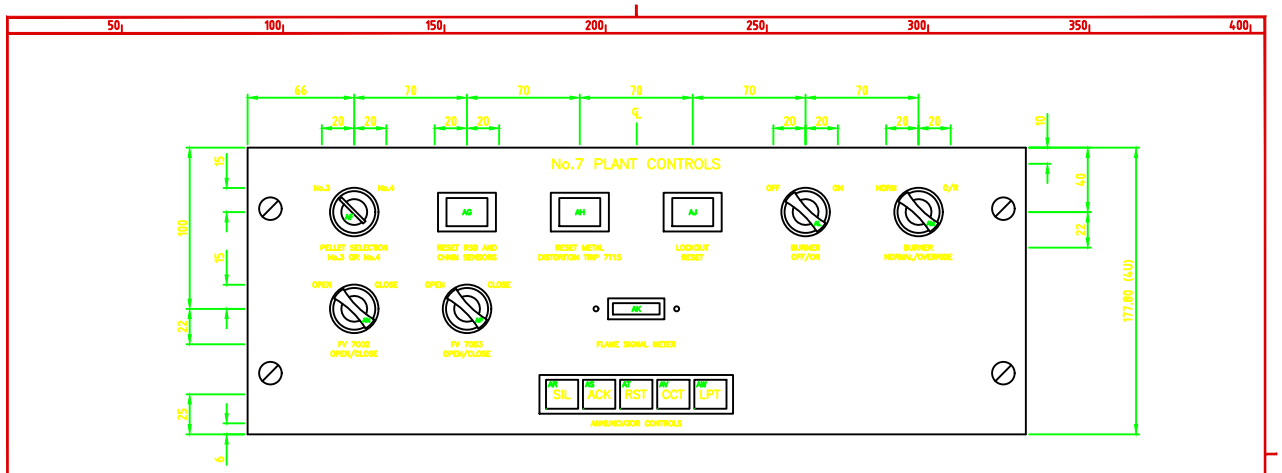

CUT OUT DETAILS FOR ANNUNCIATOR CONTROL MODULE

CUT OUT DETAILS FOR FLAME SIGNAL METER

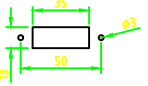

CUT OUT DETAILS FOR PUSHBUTTONS

CUT OUT DETAILS FOR SWITCHES

NOTES

1. KEY AND SELECTOR SWITCHES ARE TELEMECANIQUE.
2. PUSHBUTTONS ARE EAO.
3. TO BE MANUFACTURED FROM ALUMINIUM.
4. GENERAL TEXT TO BE ENGRAVED 3mm BLACK. PLATE NAME TEXT TO BE ENGRAVED 6mm BLACK.
5. ALL TEXT TO BE CENTRED.
6. ALL DIMENSIONS ARE TO CENTRES OF TEXT AND HOLES.
7. ITEM LETTERS REFER TO THE FISHER-ROSEMOUNT FDS LETTERING ALLOCATION. (FDS REV A1)

ITEM	CONTROL	TYPE
AF	KEYSWITCH	2 POSITION - STAY PUT
AG	PUSHBUTTON	YELLOW - FLUSH - MOMENTARY
AH	PUSHBUTTON	YELLOW - FLUSH - MOMENTARY
AJ	PUSHBUTTON	RED - ILLUMINATED - MOMENTARY
AK	METER	HORIZONTAL ANALOGUE
AL	SELECTOR SWITCH	2 POSITION - STAY PUT
AM	SELECTOR SWITCH	2 POSITION - STAY PUT
AN	SELECTOR SWITCH	2 POSITION - STAY PUT
AP	SELECTOR SWITCH	2 POSITION - STAY PUT

THIS DRAWING IS THE PROPERTY OF HIMA-SELLA LIMITED AND IS LOANED IN CONFIDENCE FOR USE WITH OUR WORK. IT IS NOT TO BE REPRODUCED IN ANY MANNER, SUBMITTED TO OUTSIDE PARTIES FOR EXAMINATION OR USED DIRECTLY OR INDIRECTLY FOR PURPOSES OTHER THAN THOSE FOR WHICH IT WAS FURNISHED WITHOUT WRITTEN CONSENT.

Scale on A3 sheet 1:2
Dimensions mm

Template Revision - For Office Records Only

REV	AUTH	DATE	CAD TEMPLATE REF.
A	PRS	3.7.00	A3-FRAME

DO NOT STAMP 'MASTER' UNTIL ALL WORK IS FULLY CADDED

Rev	Design	Drawn	Chkd	Appd	Description	Date
P2	NH	NH	CW	NGB	UPDATED WITH CLIENTS COMMENTS.	27.04.00
C				NGB	AS BUILT.	06.06.00

Designed	NH
Drawn	NH
Checked	CW
Approved	NGB
Date	27.03.00
Cad Reference	10265-P3-029.#NH01

HIMA-SELLA LIMITED

Title : CONTROL PLATE LAYOUT - No.7 PLANT
ICI SYNETIX ESD SYSTEM - No.3 AND No.7 PLANTS
FISHER-ROSEMOUNT - P.O. No. 99003994

Contract/ Drawing No C10265H/P3 029 REV C

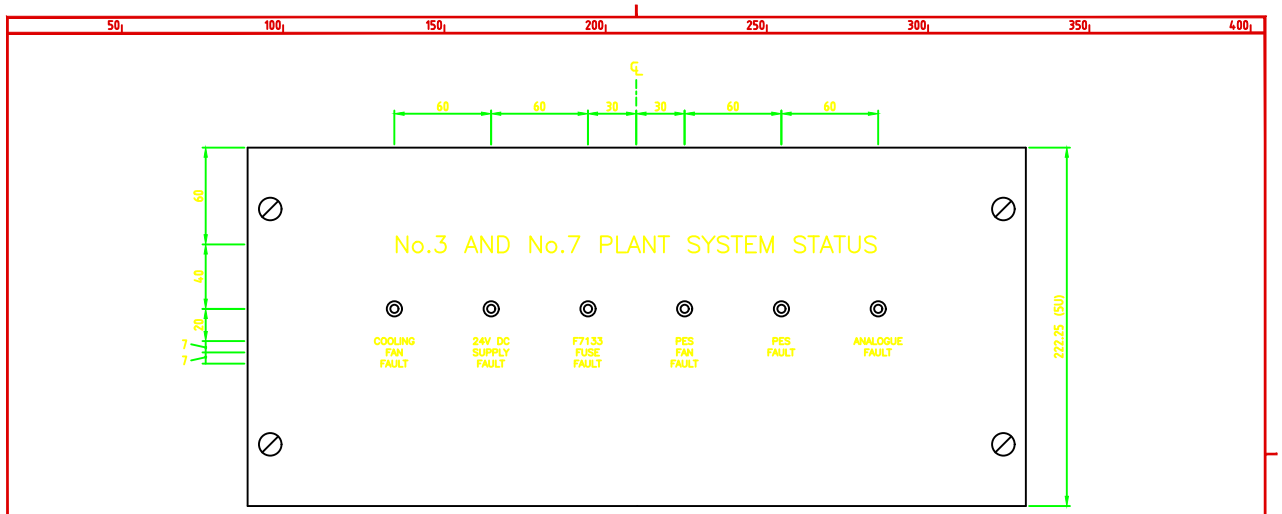

NOTES

1. TO BE MANUFACTURED FROM ALUMINIUM.
2. LED'S ARE 24Vdc YELLOW WITH INTEGRAL RESISTOR.
3. GENERAL TEXT TO BE 4mm BLACK.
   PLATE NAME TEXT TO BE 10mm BLACK.
4. ALL TEXT TO BE CENTRED.
5. ALL DIMENSIONS ARE TO CENTRES OF TEXT AND HOLES.

CUT OUT DETAILS FOR LED's

THIS DRAWING IS THE PROPERTY OF HIMA-SELLA LIMITED AND IS LOANED IN CONFIDENCE FOR USE WITH OUR WORK. IT IS NOT TO BE REPRODUCED IN ANY MANNER, SUBMITTED TO OUTSIDE PARTIES FOR EXAMINATION OR USED DIRECTLY OR INDIRECTLY FOR PURPOSES OTHER THAN THOSE FOR WHICH IT WAS FURNISHED WITHOUT WRITTEN CONSENT.

Scale on A3 sheet 1:2
Dimensions mm

Template Revision - For Office Records Only

REV	AUTH	DATE	CAD TEMPLATE REF.
A	PRS	3.2.00	A3-FRAME

DO NOT STAMP 'MASTER' UNTIL ALL WORK IS FULLY CADDED

Rev	Design	Drawn	Chkd	Appd	Description	Date
P2	NH	NH	CW	NGB	UPDATED WITH CLIENTS COMMENTS.	27.03.00
C				NGB	AS BUILT.	06.06.00

Designed	NH
Drawn	NH
Checked	CW
Approved	NGB
Date	28.03.00
Cad Reference	10265-P3-030.dwgNH01

HIMA-SELLA LIMITED

Title : SYSTEM STATUS PLATE LAYOUT
ICI SYNETIX ESD SYSTEM - No.3 AND No.7 PLANTS
FISHER-ROSEMOUNT - P.O. No. 99003994

Contract/ Drawing No C10265H/P3 030 REV C

50 | 100 | 150 | 200 | 250 | 300 | 350 | 400

1	2	3	4	5	6	7	8	9	10	11	12	13	14	15	16	17	18
F7126 POWER SUPPLY MODULE		F7126 POWER SUPPLY MODULE		F7126 POWER SUPPLY MODULE		F7131 PSU MONITOR & BUFFER BATTERIES	F8650X CENTRAL MODULE (CPU 1) G		F8621A CO-PROCESSOR MODULE					F8650X CENTRAL MODULE (CPU 2) G		F8621A CO-PROCESSOR MODULE	
HIMA-SELLA H51q-HS B5233-1 CENTRAL RACK																	

1	2	3	4	5	6	7	8	9	10	11	12	13	14	15	16
F6217 ANALOGUE INPUT	F6217 ANALOGUE INPUT	F6217 ANALOGUE INPUT	F6217 ANALOGUE INPUT	F6217 ANALOGUE INPUT	F6217 ANALOGUE INPUT	F3236 16-FOLD INPUT	F3236 16-FOLD INPUT	F3236 16-FOLD INPUT	F3236 16-FOLD INPUT	F3236 16-FOLD INPUT	F3322 16-FOLD OUTPUT	F3322 16-FOLD OUTPUT	F3322 16-FOLD OUTPUT	F3322 16-FOLD OUTPUT	F3322 16-FOLD OUTPUT
HIMA-SELLA B9302 (11**) No.3 PLANT INPUTS											No.3 PLANT OUTPUTS				

1	2	3	4	5	6	7	8	9	10	11	12	13	14	15	16
F3322 16-FOLD OUTPUT	F3330 8-FOLD OUTPUT	F3330 8-FOLD OUTPUT	F3330 8-FOLD OUTPUT	F3330 8-FOLD OUTPUT	F3322 16-FOLD OUTPUT	F6217 ANALOGUE INPUT		F3236 16-FOLD INPUT		F3322 16-FOLD OUTPUT			F3330 8-FOLD OUTPUT		
HIMA-SELLA B9302 (12**) No.3 PLANT OUTPUTS						No.7 PLANT INPUTS/OUTPUTS									

19	20	21

17	18	19	20	21
F7553 COUPLING MODULE	F7133 4-FOLD PWR DIST	F7133 4-FOLD PWR DIST	F7133 4-FOLD PWR DIST	F7133 4-FOLD PWR DIST
RACK 11**				

17	18	19	20	21
F7553 COUPLING MODULE	F7133 4-FOLD PWR DIST	F7133 4-FOLD PWR DIST	F7133 4-FOLD PWR DIST	F7133 4-FOLD PWR DIST
RACK 12**				

THIS DRAWING IS THE PROPERTY OF HIMA-SELLA LIMITED AND IS LOANED IN CONFIDENCE FOR USE WITH OUR WORK. IT IS NOT TO BE REPRODUCED IN ANY MANNER, SUBMITTED TO OUTSIDE PARTIES FOR EXAMINATION OR USED DIRECTLY OR INDIRECTLY FOR PURPOSES OTHER THAN THOSE FOR WHICH IT WAS FURNISHED WITHOUT WRITTEN CONSENT.

Template Revision – For Office Records Only

REV	AUTH	DATE	CAD TEMPLATE REF.
A	PRS	9.2.00	A3-FRAME

Scale on A3 sheet	N/A
Dimensions	N/A

DO NOT STAMP 'MASTER' UNTIL ALL WORK IS FULLY CADDED

Rev	Design	Drawn	Chkd	Appd	Description	Date
P2	NH	NH	CW	NGB	GENERALLY.UPDATED	18.05.00
C	NH	NH	CW	NGB	AS.BUILT	06.06.00
D	IM	AB	AD	MRS	REPLACEMENT.PSU.FOR.C13017V	28.09.10
E	IM	AB	AD	MRS	SITE-MODS	11.08.11
F	CJG	CJG	AD	CT	ZINC.DISSOLVER.PHR.&.MMN.IMPROVEMENTS	24.02.14
G				CT	PLANT.3/7.RACK.&.PSU.UPGRADE.AS.PER.C10265035V	24.05.19

Designed	NH
Drawn	NH
Checked	CW
Approved	NGB
Date	05.04.00
Cad Reference	10265-P3-031#CW01

HIMA-SELLA LIMITED © HIMA-SELLA

Title : HIMA PES AND HSD PSU 1U LABEL STRIPS
ICI SYNETIX ESD SYSTEM - No.3 AND No.7 PLANTS
FISHER-ROSEMOUNT - P.O. No. 99003994

Contract/ Drawing No	C10265H/P3	031	REV	G

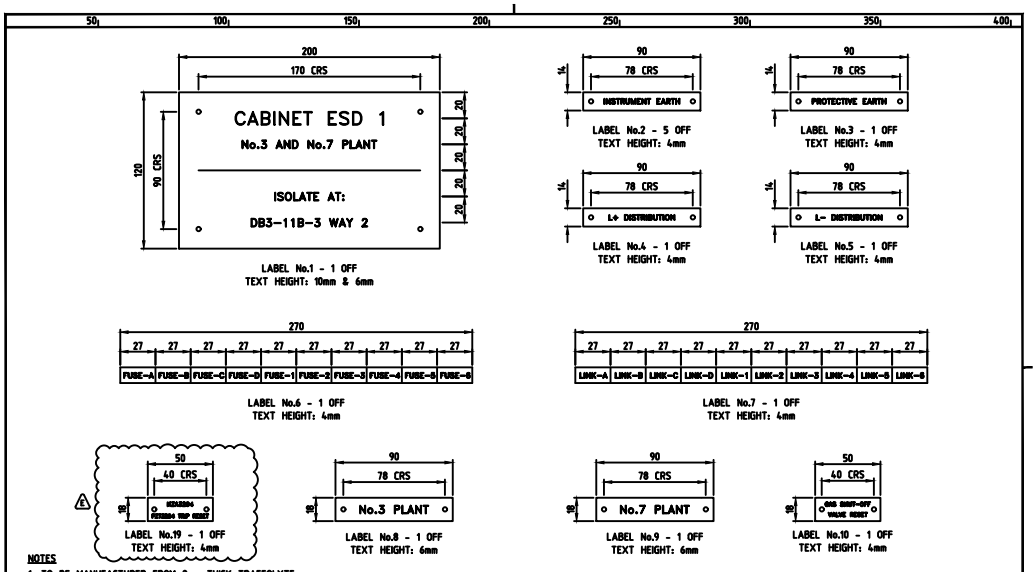

NOTES

1. TO BE MANUFACTURED FROM 2mm THICK TRAFFOLYTE.
2. WH/BK/WH WITH TEXT AS SPECIFIED.
3. TEXT TO BE CENTRED ON LABEL.
4. ALL HOLES TO BE 3.4mm DIAMETER.

THIS DRAWING IS THE PROPERTY OF HIMA-SELLA LIMITED AND IS LOANED IN CONFIDENCE FOR USE WITH OUR WORK. IT IS NOT TO BE REPRODUCED IN ANY MANNER, SUBMITTED TO OUTSIDE PARTIES FOR EXAMINATION OR USED DIRECTLY OR INDIRECTLY FOR PURPOSES OTHER THAN THOSE FOR WHICH IT WAS FURNISHED WITHOUT WRITTEN CONSENT.

Template Binding - For Office Records Only

REV	AUTH	DATE	CAD TEMPLATE REF.
A	PRS	9.2.00	A3-FRAME

Scale on A3 sheet 1:2
Dimensions mm

DO NOT STAMP 'MASTERS' UNTIL ALL WORK IS FULLY CADDED

Rev	Design	Drawn	Chkd	Appd	Description	Date
C	NH	NH	CW	NGB	AS BUILT.	06.06.00
D	DP	AL	AD	CT	PLANT 3 ESD CABINET MODS C10265039V	09.06.21
E				DP	AS BUILT C10265047V	01.07.25

Designed	NH
Drawn	NH
Checked	CW
Approved	NGB
Date	13.04.00
Cad Reference	10265-P3-032.dwgNH01

HIMA-SELLA LIMITED

Title : LABEL DETAILS
ICI SYNETIX ESD SYSTEM - No.3 AND No.7 PLANTS
FISHER-ROSEMOUNT - P.O. No. 99003994

Contract/Drawing No C10265H/P3 | 032 | REV E

LABEL No.10 - 1 OFF
TEXT HEIGHT: 5mm

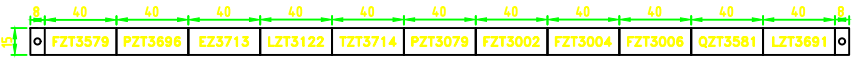

LABEL No.11 - 1 OFF
TEXT HEIGHT:5mm

LABEL No.13 - 1 OFF
TEXT HEIGHT: 5mm

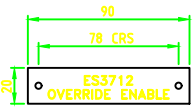

LABEL No.14 - 1 OFF
TEXT HEIGHT: 5mm

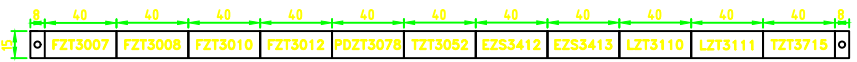

LABEL No.12 - 1 OFF
TEXT HEIGHT: 5mm

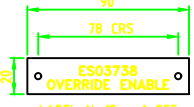

LABEL No.15 - 1 OFF
TEXT HEIGHT: 5mm

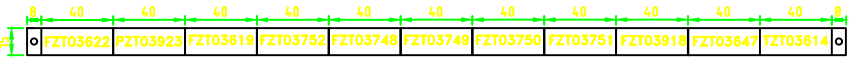

LABEL No.16 - 1 OFF
TEXT HEIGHT:5mm

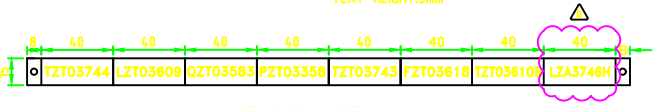

LABEL No.17 - 1 OFF
TEXT HEIGHT: 5mm

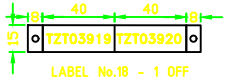

LABEL No.18 - 1 OFF
TEXT HEIGHT: 5mm

NOTES

1. TO BE MANUFACTURED FROM 2mm THICK TRAFFOLYTE.
2. WH/BK/WH WITH TEXT AS SPECIFIED.
3. TEXT TO BE CENTRED ON LABEL.
4. ALL HOLES TO BE 3.4mm DIAMETER.

THIS DRAWING IS THE PROPERTY OF HIMA-SELLA LIMITED AND IS LOANED IN CONFIDENCE FOR USE WITH OUR WORK. IT IS NOT TO BE REPRODUCED IN ANY MANNER, SUBMITTED TO OUTSIDE PARTIES FOR EXAMINATION OR USED DIRECTLY OR INDIRECTLY FOR PURPOSES OTHER THAN THOSE FOR WHICH IT WAS FURNISHED WITHOUT WRITTEN CONSENT.

Scale on A3 sheet 1:2
Dimensions MM

Rev	Design	Drawn	Chkd	Appd	Description	Date
A	CT	RE	PGB	NGB	AS BUILT PER C10265-006V	29.05.12
B	CG	CG	AD	CJG	ZINC DISSOLVER PHR & MMN IMPROVEMENTS	26.02.14
C	DP	HG	AD	CW	PROJECT ARPG-80 MODS TO 3 PLANT ESD SYSTEM	20.03.19
D				DP	AS BUILT C10265047V	01.07.25

Designed	IM
Drawn	AB
Checked	IM
Approved	MRS
Date	08.10.11
Cad Reference	10265-P3-032A.WB01

Template Revision - For Office Records Only

REV	AUTH	DATE	CAD TEMPLATE REF.
A	PRS	9.2.00	A3-FRAME

DO NOT STAMP 'MASTER' UNTIL ALL WORK IS FULLY CADDED

HIMA-SELLA LIMITED © HIMA-SELLA

TITle : LABEL DETAILS
ICI SYNETIX ESD SYSTEM - No.3 AND No.7 PLANTS
FISHER-ROSEMOUNT - P.O. No. 99003994

Contract/ Drawing No C10265H/P3 032A REV D

KEYSWITCH PLATE LAYOUT
FOR MODS 2011

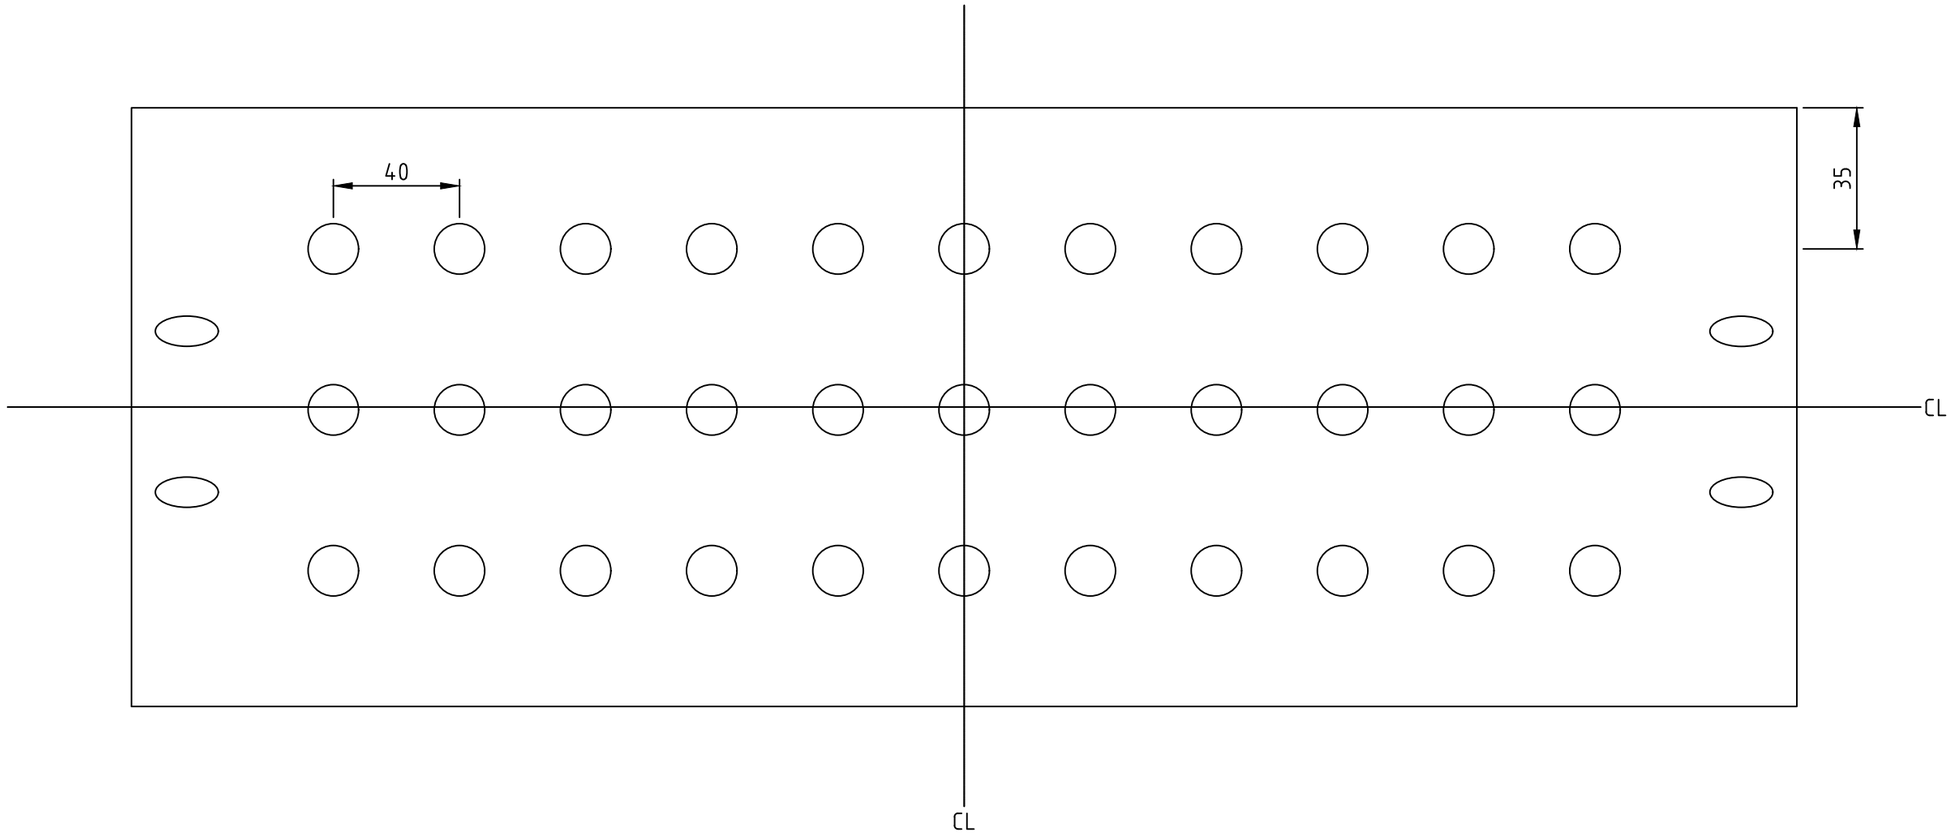

NOTES

1. ONLY 22 HOLES TO BE FITTED WITH KEYSWITCHES. THE REST ARE BLANKED OUT
2. 16mm Ø HOLES FOR KEYSWITCHES
3. 25mm Sq BEZEL

THIS DRAWING IS THE PROPERTY OF HIMA-SELLA LIMITED AND IS LOANED IN CONFIDENCE FOR USE WITH OUR WORK. IT IS NOT TO BE REPRODUCED IN ANY MANNER, SUBMITTED TO OUTSIDE PARTIES FOR EXAMINATION OR USED DIRECTLY OR INDIRECTLY FOR PURPOSES OTHER THAN THOSE FOR WHICH IT WAS FURNISHED WITHOUT WRITTEN CONSENT.

Template Revision – For Office Records Only

REV	AUTH	DATE	CAD TEMPLATE REF.
A	PRS	9.2.00	A3-FRAME

Scale on A3 sheet	1:2
Dimensions	mm

DO NOT STAMP 'MASTER' UNTIL ALL WORK IS FULLY CADDED

Rev	Design	Drawn	Chkd	Appd	Description	Date
.						

Designed	IM
Drawn	
Checked	IM
Approved	NGB
Date	11.08.11
Cad Reference	
10265-P3-033#AB01	

HIMA–SELLA LIMITED © HIMA-SELLA

Title : KEYSWITCH PLATE LAYOUT DETAILS
ICI SYNETIX ESD SYSTEM - No.3 AND No.7 PLANTS
FISHER-ROSEMOUNT - P.O. No. 99003994

Contract/ Drawing No	C10265H/P3	033	REV	0

KEYSWITCH PLATE LAYOUT
FOR MODS 2014

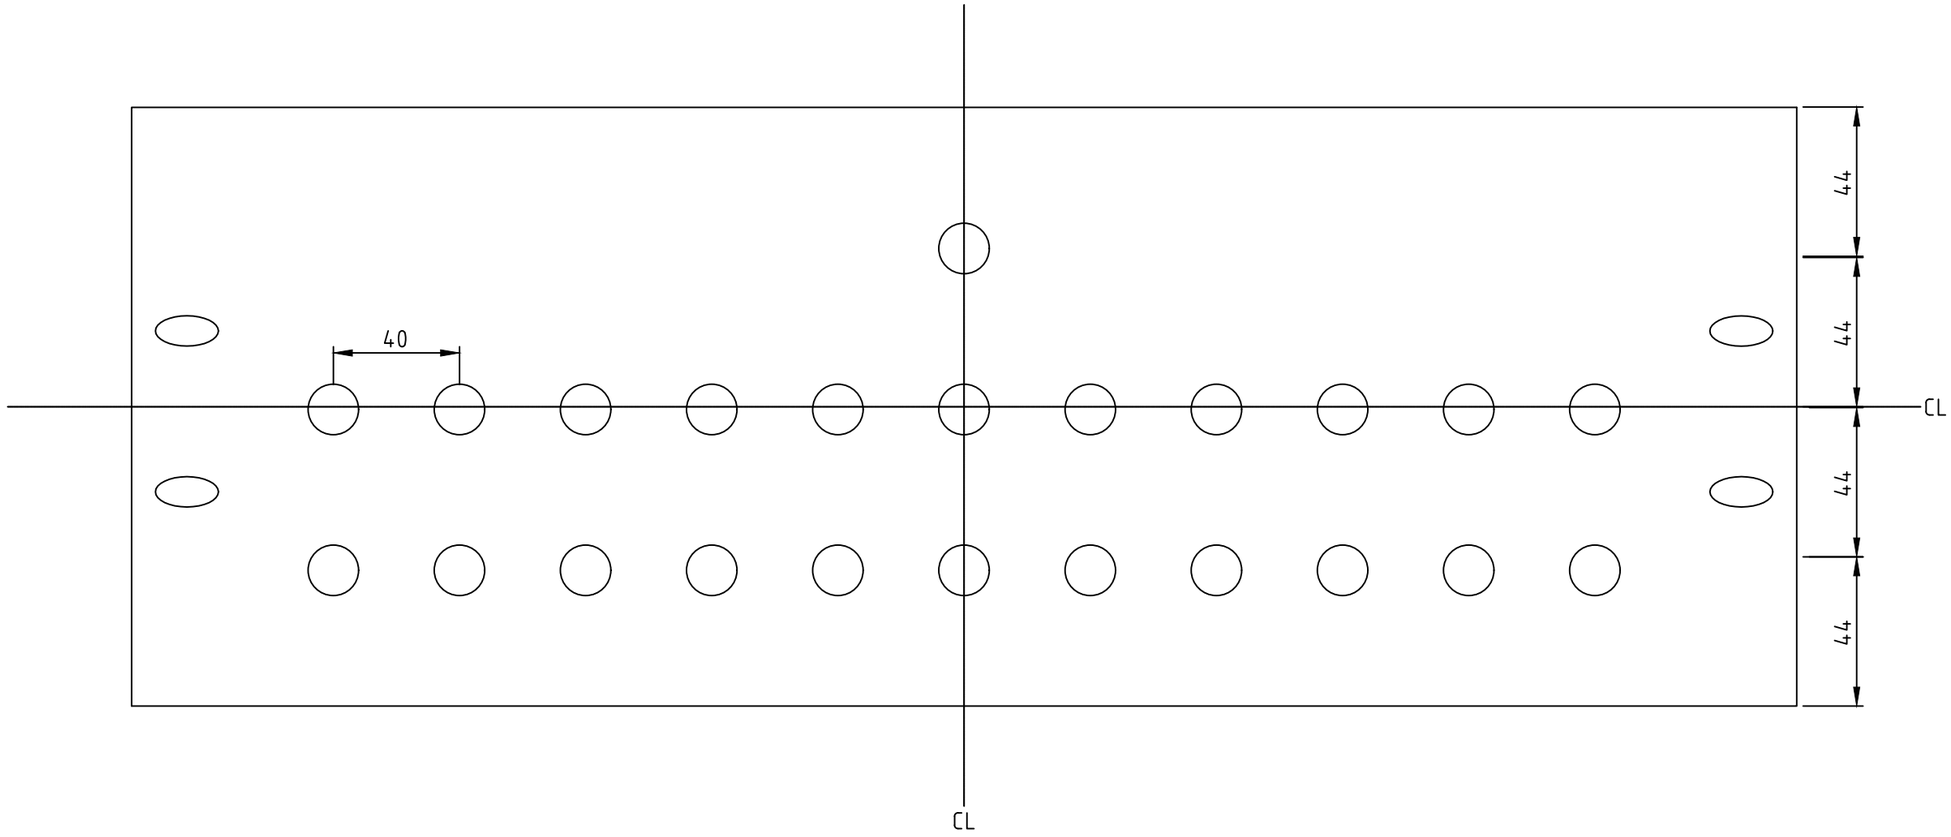

NOTES

1. ONLY 19 HOLES TO BE FITTED WITH KEYSWITCHES. THE REST ARE BLANKED OUT
2. 16mm Ø HOLES FOR KEYSWITCHES
3. 25mm Sq BEZEL

THIS DRAWING IS THE PROPERTY OF HIMA-SELLA LIMITED AND IS LOANED IN CONFIDENCE FOR USE WITH OUR WORK. IT IS NOT TO BE REPRODUCED IN ANY MANNER, SUBMITTED TO OUTSIDE PARTIES FOR EXAMINATION OR USED DIRECTLY OR INDIRECTLY FOR PURPOSES OTHER THAN THOSE FOR WHICH IT WAS FURNISHED WITHOUT WRITTEN CONSENT.

Template Revision – For Office Records Only

REV	AUTH	DATE	CAD TEMPLATE REF.
A	PRS	9.2.00	A3-FRAME

Scale on A3 sheet	1:2
Dimensions	mm

DO NOT STAMP 'MASTER' UNTIL ALL WORK IS FULLY CADDED

Rev	Design	Drawn	Chkd	Appd	Description	Date
.						

Designed	
Drawn	
Checked	
Approved	CT
Date	17.02.14
Cad Reference	
10265-P3-033#AB01	

HIMA–SELLA LIMITED © HIMA-SELLA

Title : KEYSWITCH PLATE LAYOUT DETAILS
ICI SYNETIX ESD SYSTEM - No.3 AND No.7 PLANTS
FISHER-ROSEMOUNT - P.O. No. 99003994

Contract/ Drawing No	C10265	034	REV	0

Xref C:\NEWDOCS\STDPLOTSTAMPFOOT.dwg

50 100 150 200 250 300 350 400

230Vac SUPPLY 'A'

E N L

CLIENT SCOPE FERRITE RINGS FOR EMC SUPPRESSION

Gr/Ye Bu Br

SCOPE INTERFACE

EK4/35 SAK4/35 SAK4/35

1.5mmSq

NA1 LA1

20A ISOLATOR 'A'

NA2 LA2

AC- FUSE 'A' 6A

NA3 LA3

NA2 LA2

AC- FUSE 'B' 6A

NA4 LA4

F

PULS PSU'S 230Vac/24Vdc

E L N

PSU A

PULS QS40.244 24Vdc/40A

PSU A L+ PSU A L-

+ − + −

DUAL REDUNDANCY

PULS YR80.242 REDUNDANCY MODULE

+ OUTPUT −

E L N

PSU B

PULS QS40.244 24Vdc/40A

PSU B L+ PSU B L-

F

AL- AL+ BL-

6.0mmSq TRI-RATED BLACK WIRED AS RING

24Vdc DISTRIBUTION FOR L− SAFECLIP LINKS

INSTRUMENT EARTH

16mmSq GREEN/ YELLOW

BL-

LINK-A LINK-B LINK-C LINK-D LINK-1 LINK-2 LINK-3 LINK-4 LINK-5 LINK-6

AL- BL- CL- DL- 1L- 2L- 3L- 4L- 5L- 6L-

PLC POWER PLC POWER PLC POWER COOLING FANS F7133 POWER F7133 POWER FAULT/SYS STATUS

1.5mmSq TRI-RATED BLACK

2.5mmSq TRI-RATED BLACK

1.0mmSq TRI-RATED BLACK WIRED AS RING

2.5mmSq TRI-RATED BLACK

7/C305-2 No.7 PLANT ANNUN SUPPLY

3/C655-2 No.3 PLANT ANNUN SUPPLY

040.053 XG.21:1 040.095 XG.22:1 040.138 XG.23:1 K9202/2 K9203/2 043.260 XG.11 047.260 XG.11

REF DRG 025

24Vdc DISTRIBUTION FOR L+ RED SPOT FUSES

BL+

FUSE-A 10A FUSE-B 10A FUSE-C 10A FUSE-D 4A FUSE-1 4A FUSE-2 4A FUSE-3 4A FUSE-4 4A FUSE-5 4A FUSE-6 4A

6.0mmSq TRI-RATED RED WIRED AS RING

AL+ BL+ CL+ DL+ 1L+ 2L+ 3L+ 4L+ 5L+ 6L+

6.0mmSq TRI-RATED RED WIRED AS RING

REF DRG 025

1.5mmSq TRI-RATED RED

2.5mmSq TRI-RATED RED

2.5mmSq TRI-RATED RED WIRED AS RING

1.0mmSq TRI-RATED RED WIRED AS RING

2.5mmSq TRI-RATED RED

PLC POWER PLC POWER PLC POWER COOLING FANS F7133 POWER F7133 POWER FAULT/SYS STATUS

7/C305-1 No.7 PLANT ANNUN SUPPLY

3/C655-1 No.3 PLANT ANNUN SUPPLY

040.048 XG.21:2 040.090 XG.22:2 040.133 XG.23:2 K9202/1 K9203/1 043.060 1118-1121 047.060 1218-1221

NOTES: 1. L- CONNECTIONS MUST BE SEPARATE AND SINGLE WHEN CONNECTED IN A RING.

THIS DRAWING IS THE PROPERTY OF HIMA-SELLA LIMITED AND IS LOANED IN CONFIDENCE FOR USE WITH OUR WORK. IT IS NOT TO BE REPRODUCED IN ANY MANNER, SUBMITTED TO OUTSIDE PARTIES FOR EXAMINATION OR USED DIRECTLY OR INDIRECTLY FOR PURPOSES OTHER THAN THOSE FOR WHICH IT WAS FURNISHED WITHOUT WRITTEN CONSENT.

Scale on A3 sheet	N/A
Dimensions	N/A

Rev	Design	Drawn	Chkd	Appd	Description	Date
C	NH	NH	CW	NGB	AS BUILT.	06.06.00
D	AD	WJB	AD	MRS	REPLACEMENT P.S.U FOR C13017V	28.09.10
E	DP	HG	CT	CT	PLANT 3/7 RACK AND PSU UPGRADE AS PER C10265035V	10.05.19
F				CT	AS BUILT AS PER C10265035V	27.06.19

Designed	NH
Drawn	NH
Checked	CW
Approved	NGB
Date	04.04.00
Cad Reference	10265-P3-PWRDIST#NH01

Template Revision – For Office Records Only

REV	AUTH	DATE	CAD TEMPLATE REF.
A	PRS	11.2.00	PWRDIST

DO NOT STAMP 'MASTER' UNTIL ALL WORK IS FULLY CADDED

HIMA–SELLA LIMITED © HIMA-SELLA

Title : POWER DISTRIBUTION - 230Vac/24Vdc
ICI SYNETIX ESD SYSTEM - No.3 AND No.7 PLANTS
FISHER-ROSEMOUNT - P.O. No. 99003994

Contract/ Drawing No C10265H/P3 035 REV F

50 100 150 200 250 300 350 400

POWER SUPPLY RACK – PULS QS40.244 & YR80.242 – 230Vac – 24Vdc (FRONT VIEW)

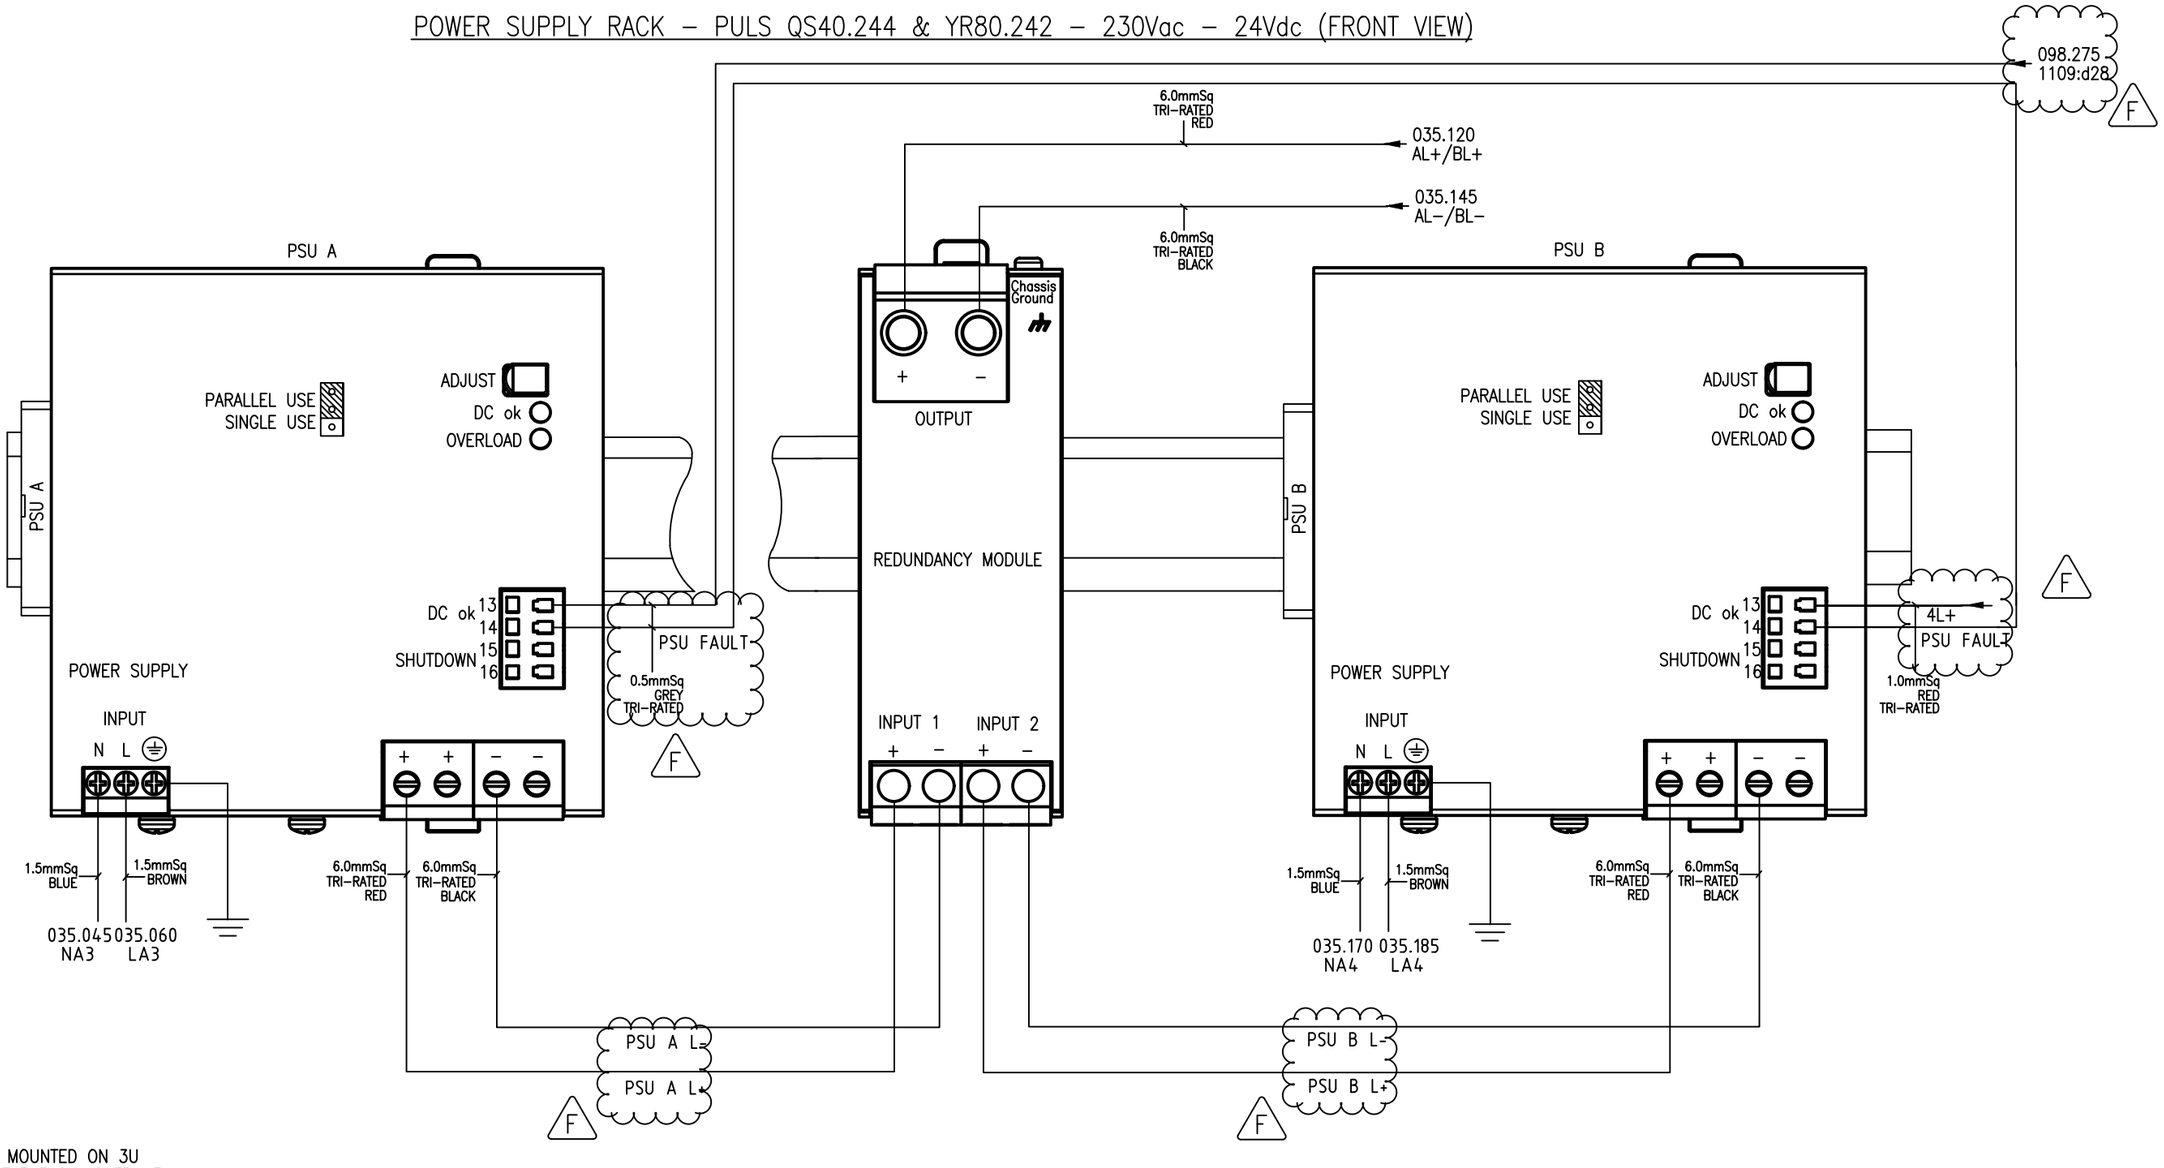

NOTE

1. INSTALLED ON DIN RAIL MOUNTED ON 3U PLATE ON BACK SIDE OF THE SWING FRAME.

PULS PSU JUMPER SETTINGS

JUMPERS ON PULS QS40.244 POWER SUPPLIES TO BE MOVED TO THE "PARALLEL USE" POSITION.

THIS DRAWING IS THE PROPERTY OF HIMA-SELLA LIMITED AND IS LOANED IN CONFIDENCE FOR USE WITH OUR WORK. IT IS NOT TO BE REPRODUCED IN ANY MANNER, SUBMITTED TO OUTSIDE PARTIES FOR EXAMINATION OR USED DIRECTLY OR INDIRECTLY FOR PURPOSES OTHER THAN THOSE FOR WHICH IT WAS FURNISHED WITHOUT WRITTEN CONSENT.

Scale on A3 sheet	N/A
Dimensions	N/A

Rev	Design	Drawn	Chkd	Appd	Description	Date
C	NH	NH	CW	NGB	AS BUILT.	06.06.00
D	AD	WJB	AD	MRS	REPLACEMENT P.S.U FOR C13017V	28.09.10
E	DP	HG	CT	CT	PLANT 3/7 RACK AND PSU UPGRADE AS PER C10265035V	01.05.19
F				CT	AS BUILT AS PER C10265035V	27.06.19

Designed	NH
Drawn	NH
Checked	CW
Approved	NGB
Date	04.04.00
Cad Reference	
10265-P3-PWRDIST#NH01	

Template Revision – For Office Records Only

REV	AUTH	DATE	CAD TEMPLATE REF.
A	PRS	11.2.00	PWRDIST

DO NOT STAMP 'MASTER' UNTIL ALL WORK IS FULLY CADDED

HIMA–SELLA LIMITED © HIMA-SELLA

Title : PSU ALARM & JUMPER SETTINGS
ICI SYNETIX ESD SYSTEM - No.3 AND No.7 PLANTS
FISHER-ROSEMOUNT - P.O. No. 99003994

Contract/ Drawing No: C10265H/P3 039 REV F

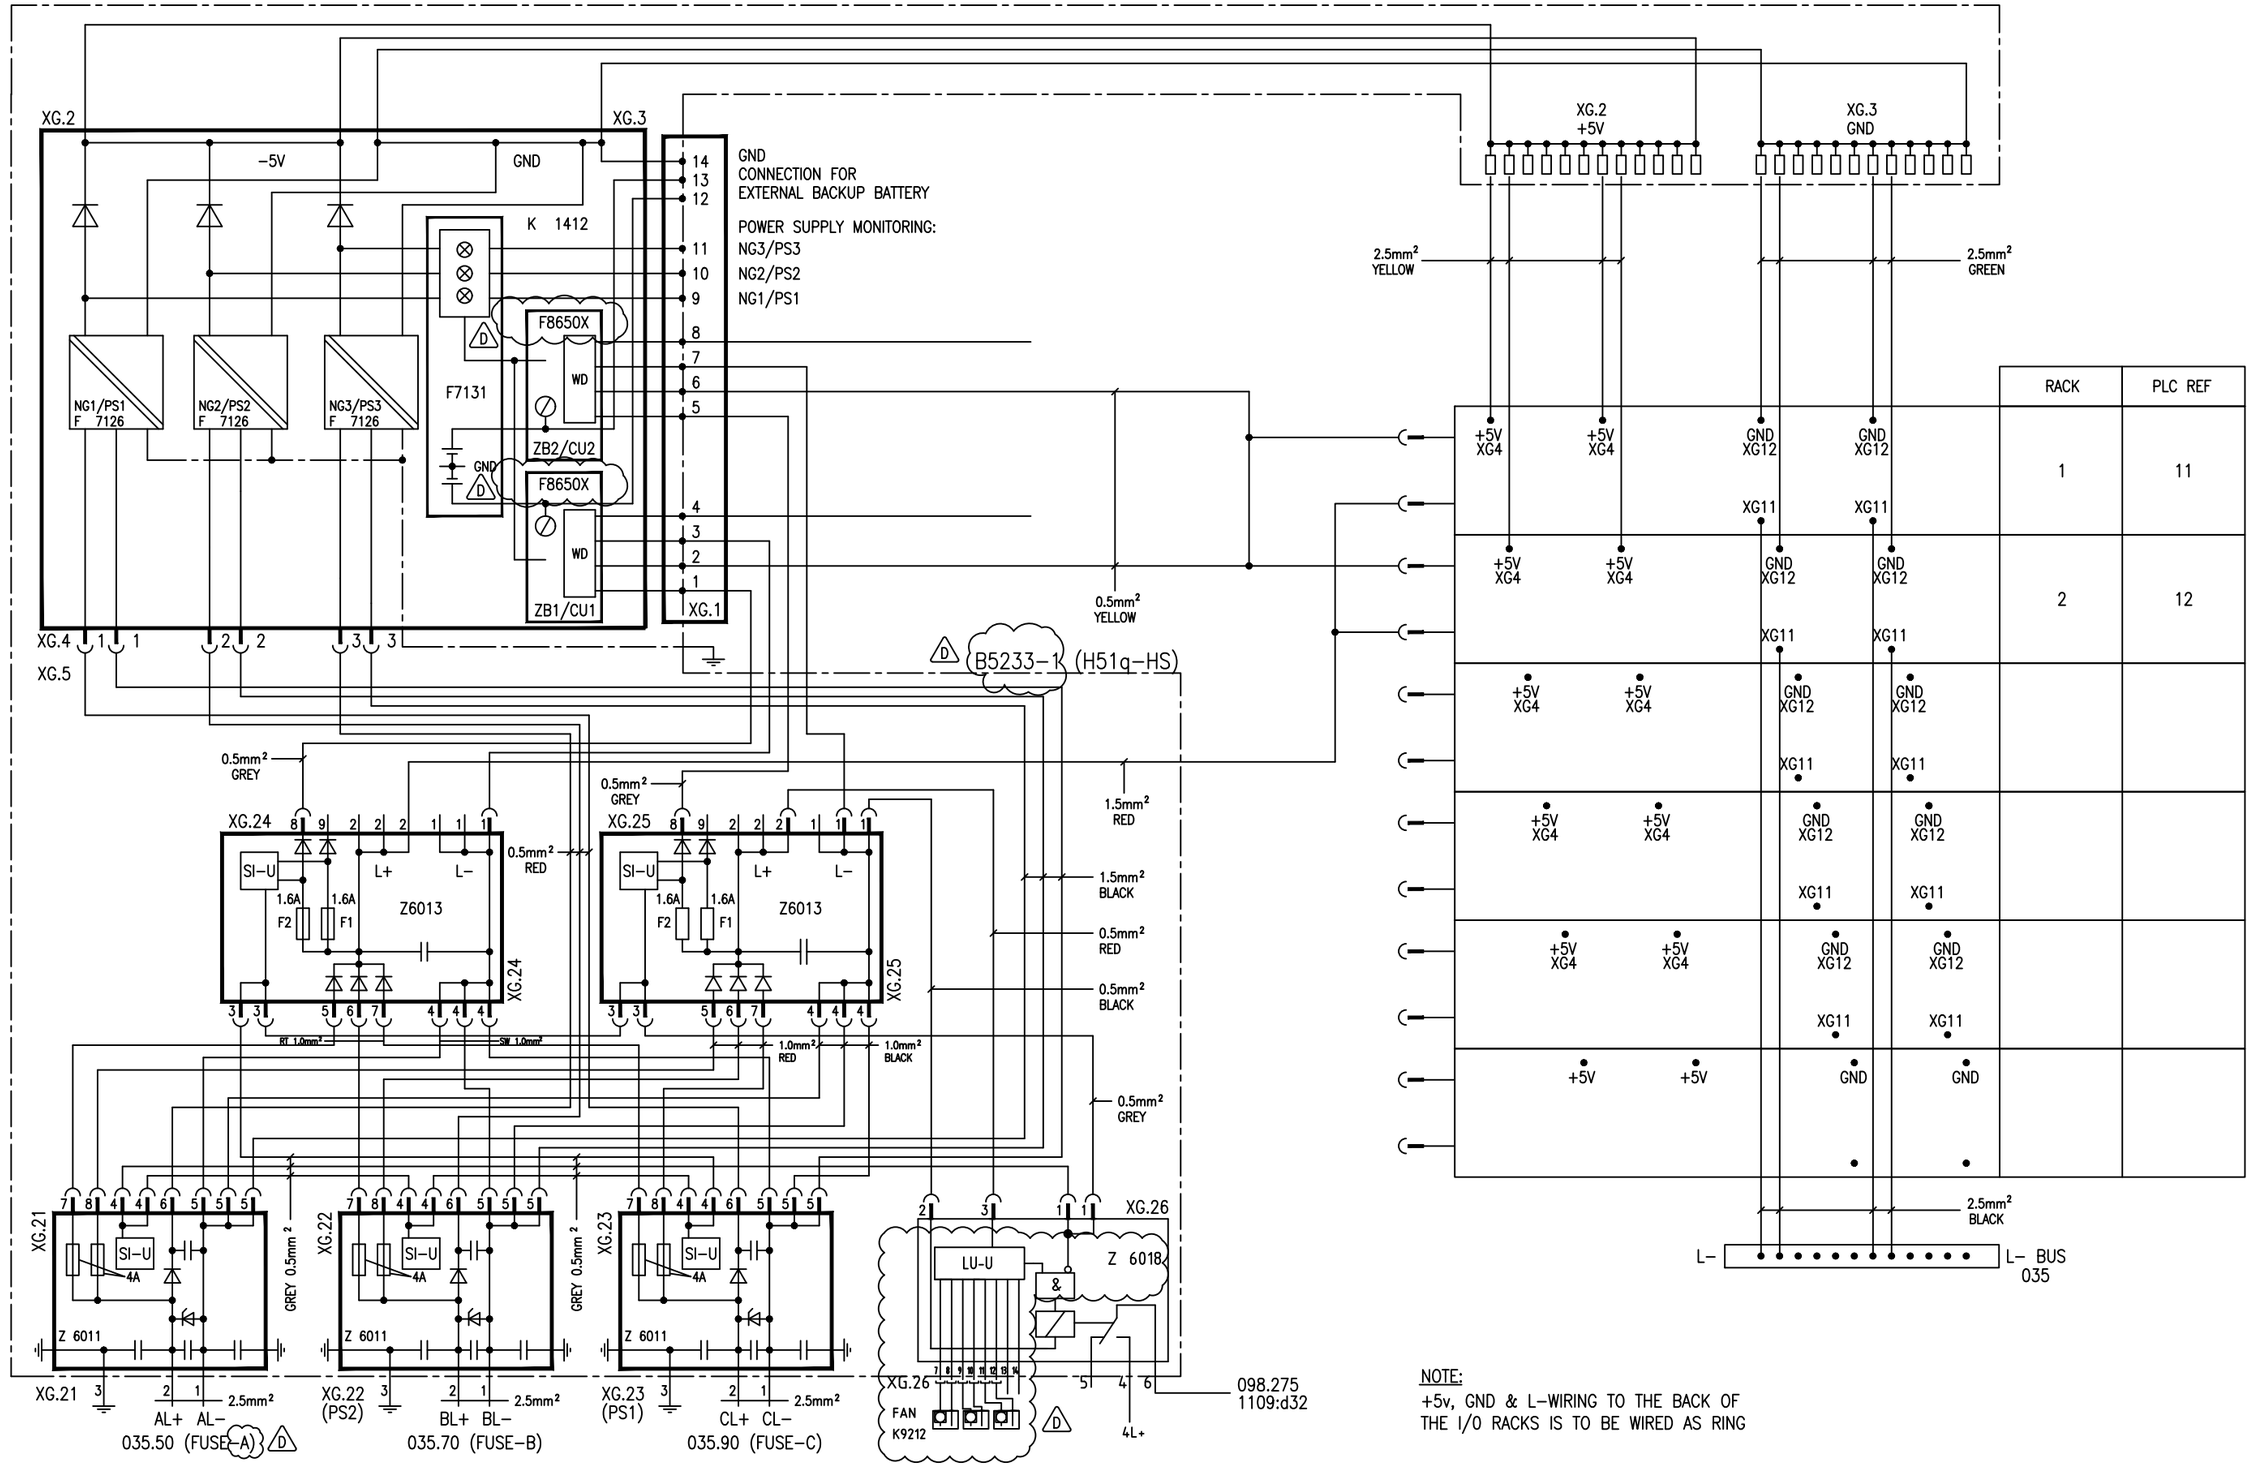

NOTE:
+5v, GND & L−WIRING TO THE BACK OF
THE I/O RACKS IS TO BE WIRED AS RING

Rev	Design	Drawn	Chkd	Appd	Description	Date
C	NH	NH	CW	NGB	AS BUILT.	06.06.00
D				CT	PLANT 3/7 RACK UPGRADE AS PER C10265035V	01.05.19
						. .
						. .
						. .

Designed	NH
Drawn	NH
Checked	CW
Approved	NGB
Date	04.04.00
A3 Scale	N/A
Dims	N/A

THIS DRAWING IS THE PROPERTY OF HIMA−SELLA LIMITED AND IS LOANED IN CONFIDENCE FOR USE WITH OUR WORK. IT IS NOT TO BE REPRODUCED IN ANY MANNER, SUBMITTED TO OUTSIDE PARTIES FOR EXAMINATION OR USED DIRECTLY OR INDIRECTLY FOR PURPOSES OTHER THAN THOSE FOR WHICH IT WAS FURNISHED WITHOUT WRITTEN CONSENT.

DO NOT STAMP 'MASTER' UNTIL ALL WORK IS FULLY CADDED

TEMPLATE DETAILS : 51P3COM−042−REV0

TITLEBOX : HS−A3

HIMA−SELLA LIMITED © HIMA-SELLA

Title : MAIN SCHEMATIC FOR POWER AND WATCHDOG
ICI SYSTEM ESD SYSTEM−No.3 AND No.7 PLANTS
FISHER−ROSEMOUNT−P.O. No. 99003994

Contract/ Drawing No: C10265H/P3 | 040 | REV D

PROJECT/DIRECTORY NAME : C10265H−P3−040

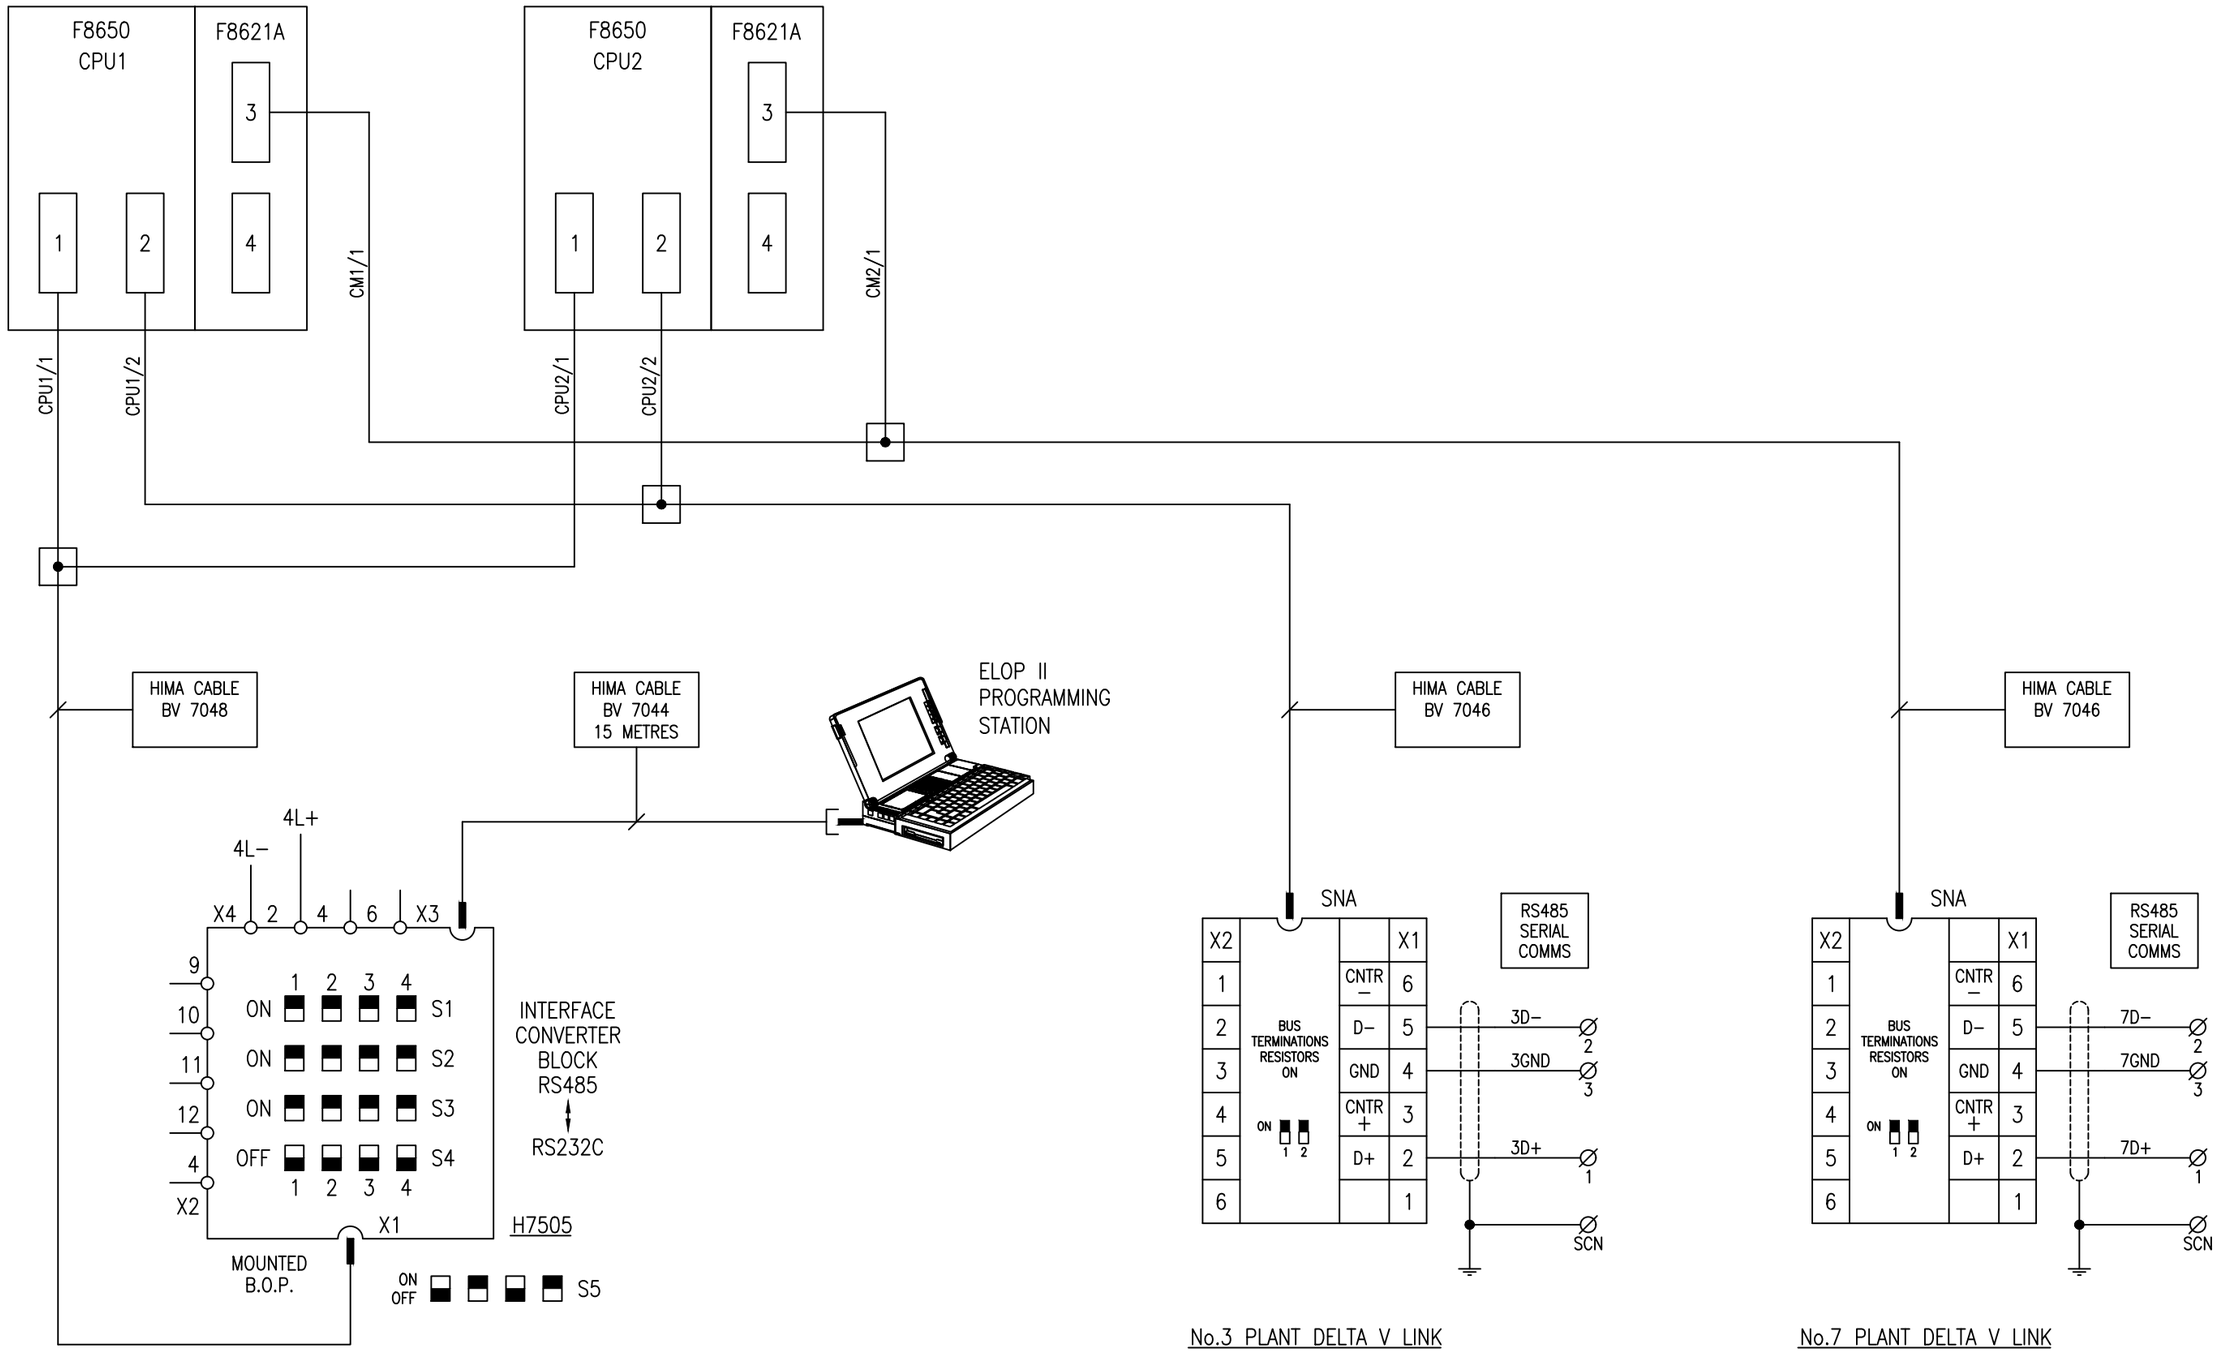

THIS DRAWING IS THE PROPERTY OF HIMA–SELLA LIMITED AND IS LOANED IN CONFIDENCE FOR USE WITH OUR WORK. IT IS NOT TO BE REPRODUCED IN ANY MANNER, SUBMITTED TO OUTSIDE PARTIES FOR EXAMINATION OR USED DIRECTLY OR INDIRECTLY FOR PURPOSES OTHER THAN THOSE FOR WHICH IT WAS FURNISHED WITHOUT WRITTEN CONSENT.

DO NOT STAMP 'MASTER' UNTIL ALL WORK IS FULLY CADDED

TEMPLATE DETAILS : 51COM043 REV 0

TITLEBOX : HS–A3

Rev	Design	Drawn	Chkd	Appd	Description	Date
C	NH	NH	CW	NGB	AS BUILT.	06.06.00
						. .
						. .
						. .
						. .

Designed	NH
Drawn	NH
Checked	CW
Approved	NGB
Date	05.04.00
A3 Scale	N/A
Dims	N/A

HIMA–SELLA LIMITED © HIMA-SELLA

Title : H51q–HS COMMUNICATION CONNECTION DETAILS
ICI SYNETIX ESD SYSTEM – No.3 AND No.7 PLANTS
FISHER–ROSEMOUNT–P.O. No. 99003994

Contract/ Drawing No	C10265H/P3	041	REV	C

PROJECT/DIRECTORY NAME : C10265H/P3

4U PLATE

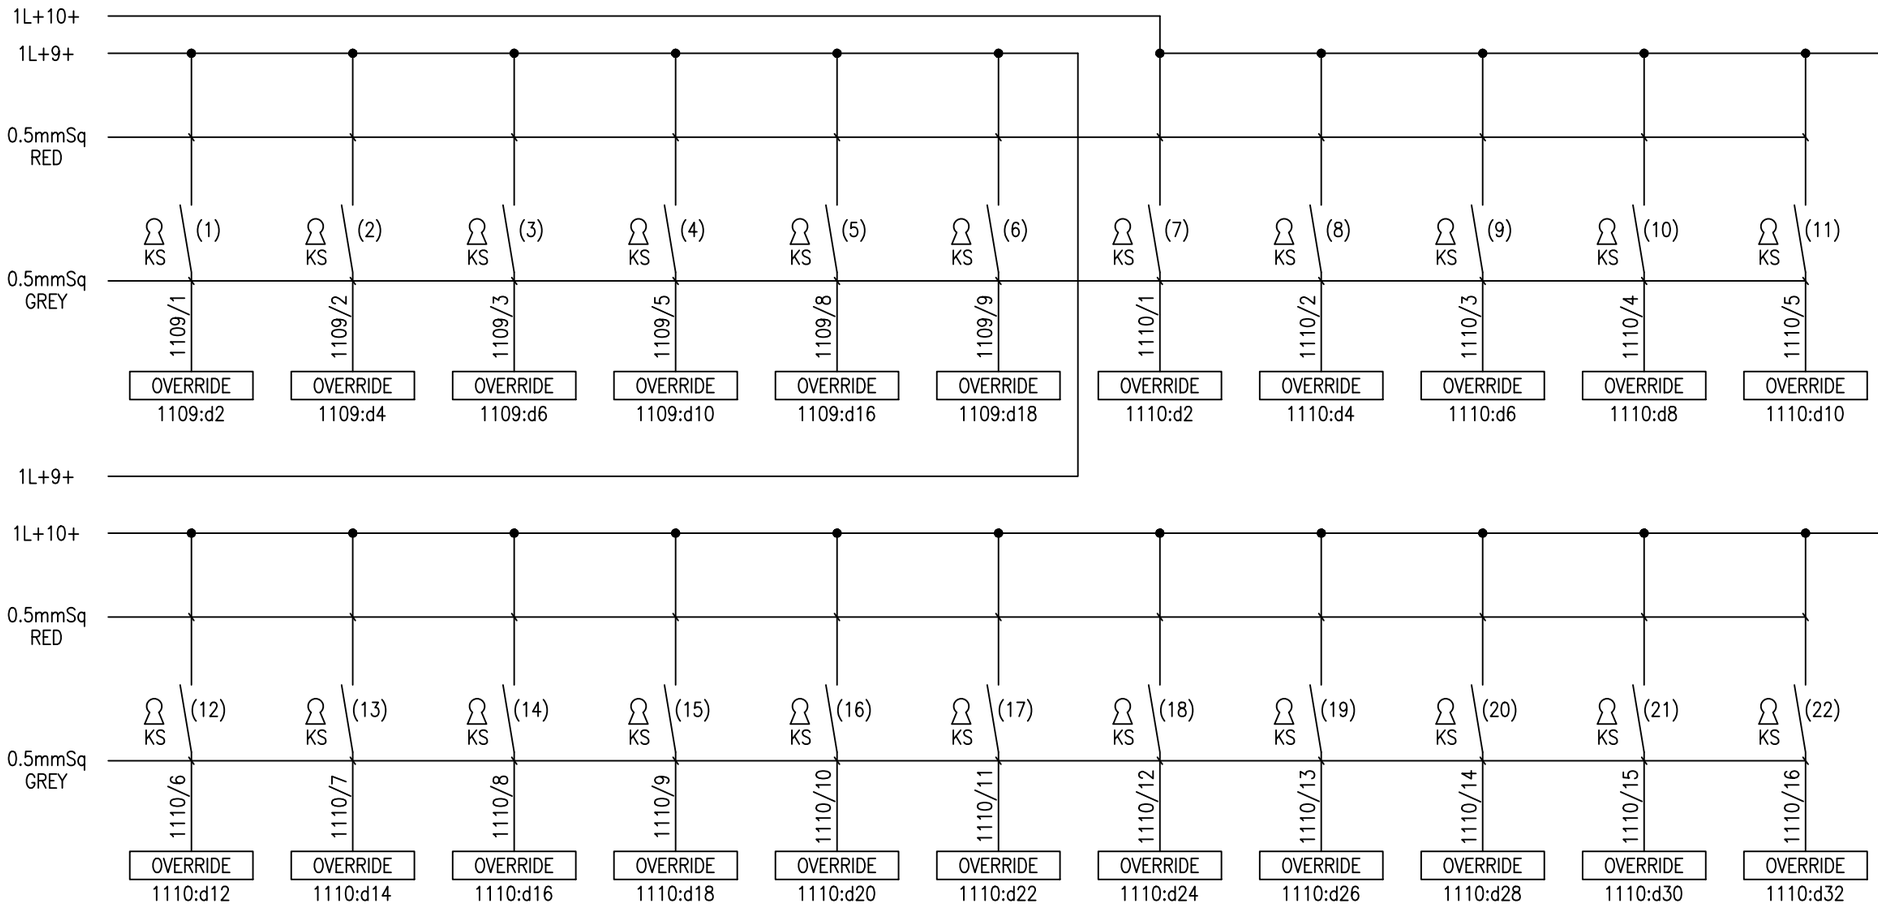

1U PLATE

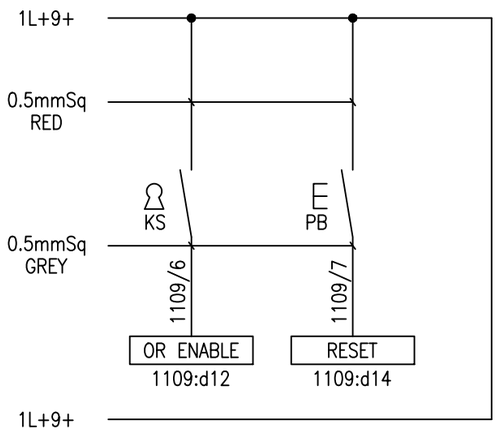

THIS DRAWING IS THE PROPERTY OF HIMA–SELLA LIMITED AND IS LOANED IN CONFIDENCE FOR USE WITH OUR WORK. IT IS NOT TO BE REPRODUCED IN ANY MANNER, SUBMITTED TO OUTSIDE PARTIES FOR EXAMINATION OR USED DIRECTLY OR INDIRECTLY FOR PURPOSES OTHER THAN THOSE FOR WHICH IT WAS FURNISHED WITHOUT WRITTEN CONSENT.

DO NOT STAMP 'MASTER' UNTIL ALL WORK IS FULLY CADDED

Rev	Design	Drawn	Chkd	Appd	Description	Date
	..	..	..		. . .	. .
						. .
						. .
						. .
						. .

Designed	
Drawn	
Checked	
Approved	
Date	12.08.11
A3 Scale	N/A
Dims	N/A

HIMA–SELLA LIMITED © HIMA-SELLA

Title : 4U PLATE AND 1U PLATE LAYOUT DETAILS
ICI SYNETIX ESD SYSTEM – No.3 AND No.7 PLANTS
FISHER–ROSEMOUNT – P.O. No. 99003994

Contract/ Drawing No: C10265/P3 | 042 | REV 0

TEMPLATE DETAILS : 51P6COM–045–REV0
TITLEBOX : HS–A3

PROJECT/DIRECTORY NAME : C10265H

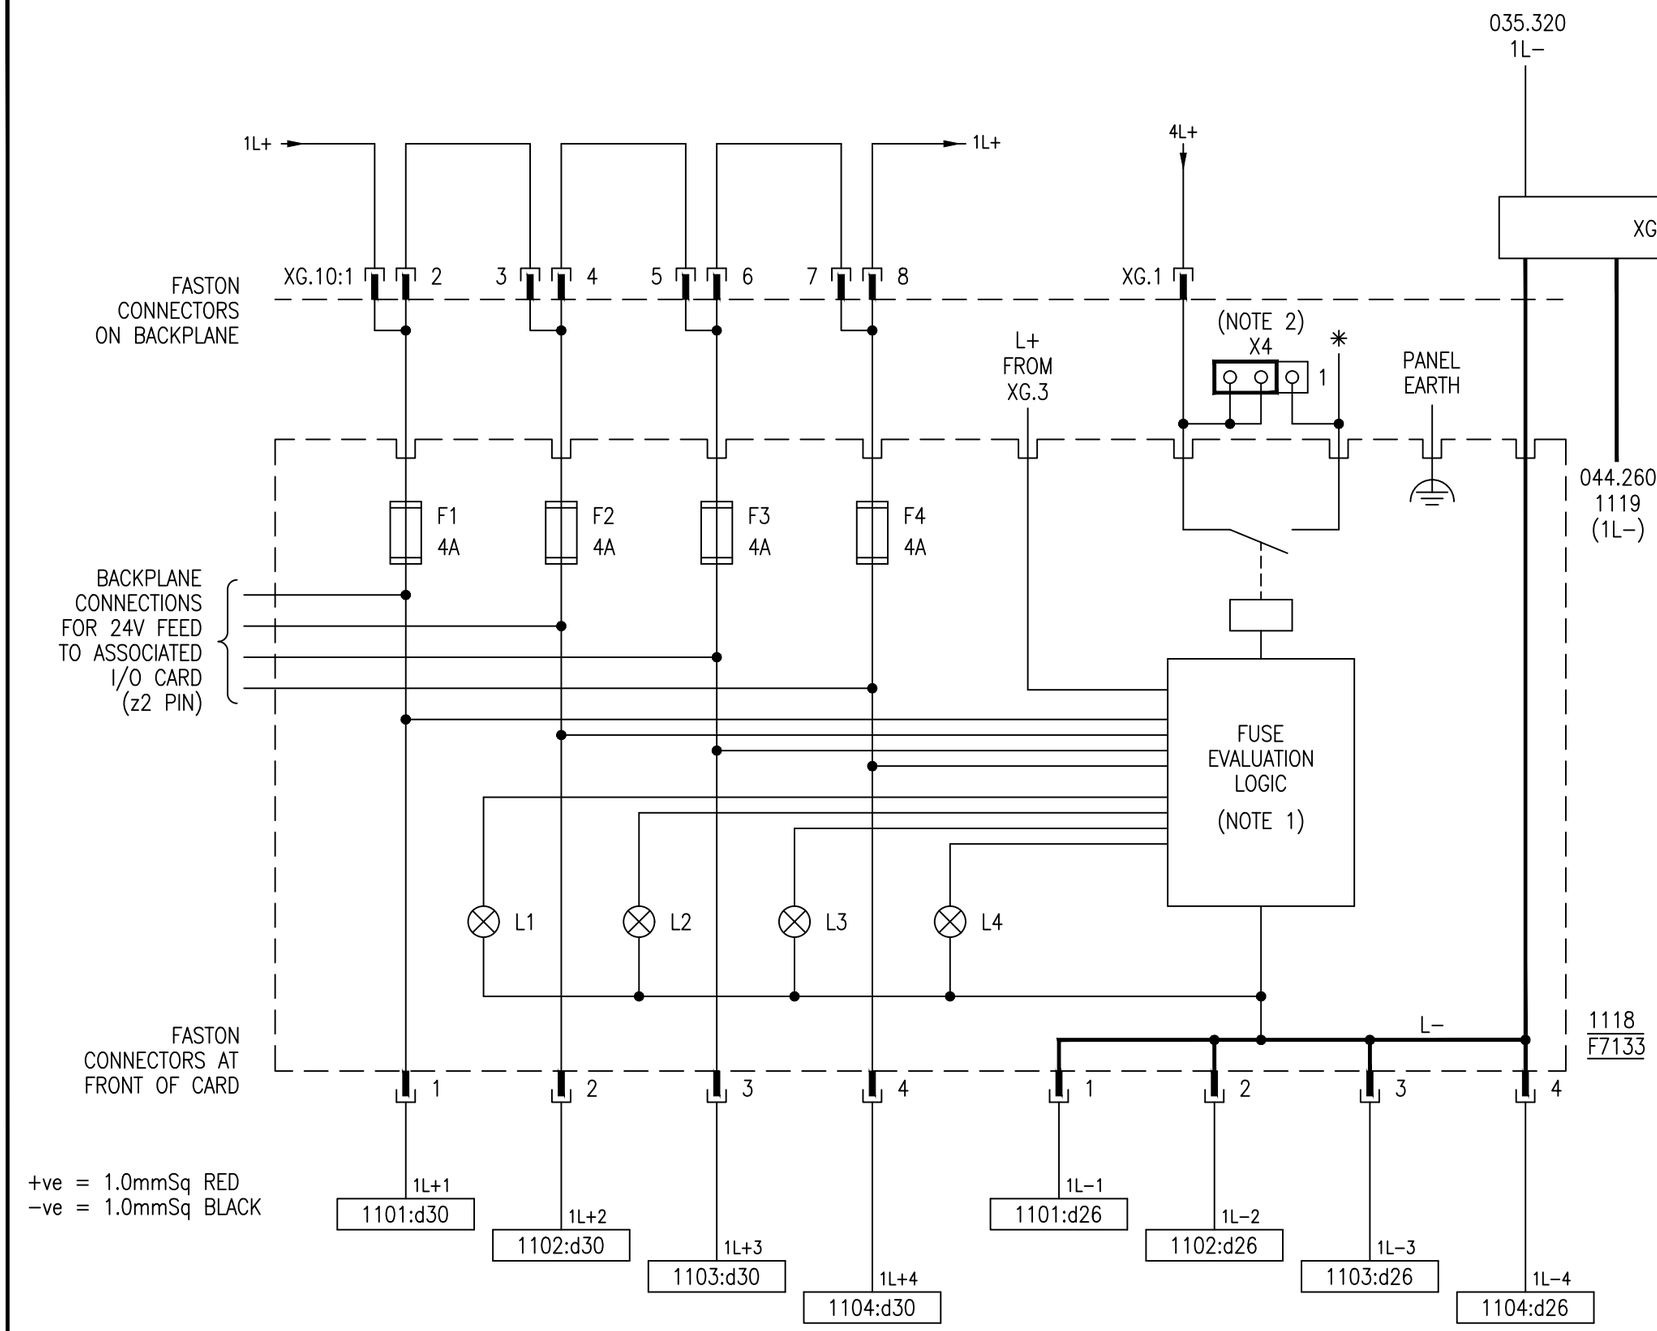

NOTES

1. IF F1–F4 FAILS, CORRESPONDING LED WILL FLASH. LOSS OF INCOMING 24Vdc WILL EXTINGUISH LED(s). RELAY WILL DE–ENERGISE IN THESE INSTANCES.

2. MOVE LINK X1–X4 (CARD POSITIONS 21–18) TO POSITION 1 IF NO F7133 FITTED.
   ✳ DENOTES BACKPLANE LINK TO ADJACENT F7133 CARD FUSE FAILURE CIRCUIT.

THIS DRAWING IS THE PROPERTY OF HIMA–SELLA LIMITED AND IS LOANED IN CONFIDENCE FOR USE WITH OUR WORK. IT IS NOT TO BE REPRODUCED IN ANY MANNER, SUBMITTED TO OUTSIDE PARTIES FOR EXAMINATION OR USED DIRECTLY OR INDIRECTLY FOR PURPOSES OTHER THAN THOSE FOR WHICH IT WAS FURNISHED WITHOUT WRITTEN CONSENT.

DO NOT STAMP 'MASTER' UNTIL ALL WORK IS FULLY CADDED

Rev	Design	Drawn	Chkd	Appd	Description	Date
C	NH	NH	CW	NGB	AS BUILT.	06.06.00
						. .
						. .
						. .
						. .

Designed	NH
Drawn	NH
Checked	CW
Approved	NGB
Date	27.03.00
A3 Scale	N/A
Dims	N/A

HIMA–SELLA LIMITED © HIMA-SELLA

Title : F7133 24Vdc DISTRIBUTION CARD 1118
ICI SYNETIX ESD SYSTEM – No.3 AND No.7 PLANTS
FISHER–ROSEMOUNT – P.O. No. 99003994

Contract/ Drawing No: C10265/P3 | 043 | REV C

TEMPLATE DETAILS : 51P6COM–045–REV0
TITLEBOX : HS–A3

PROJECT/DIRECTORY NAME : C10265H

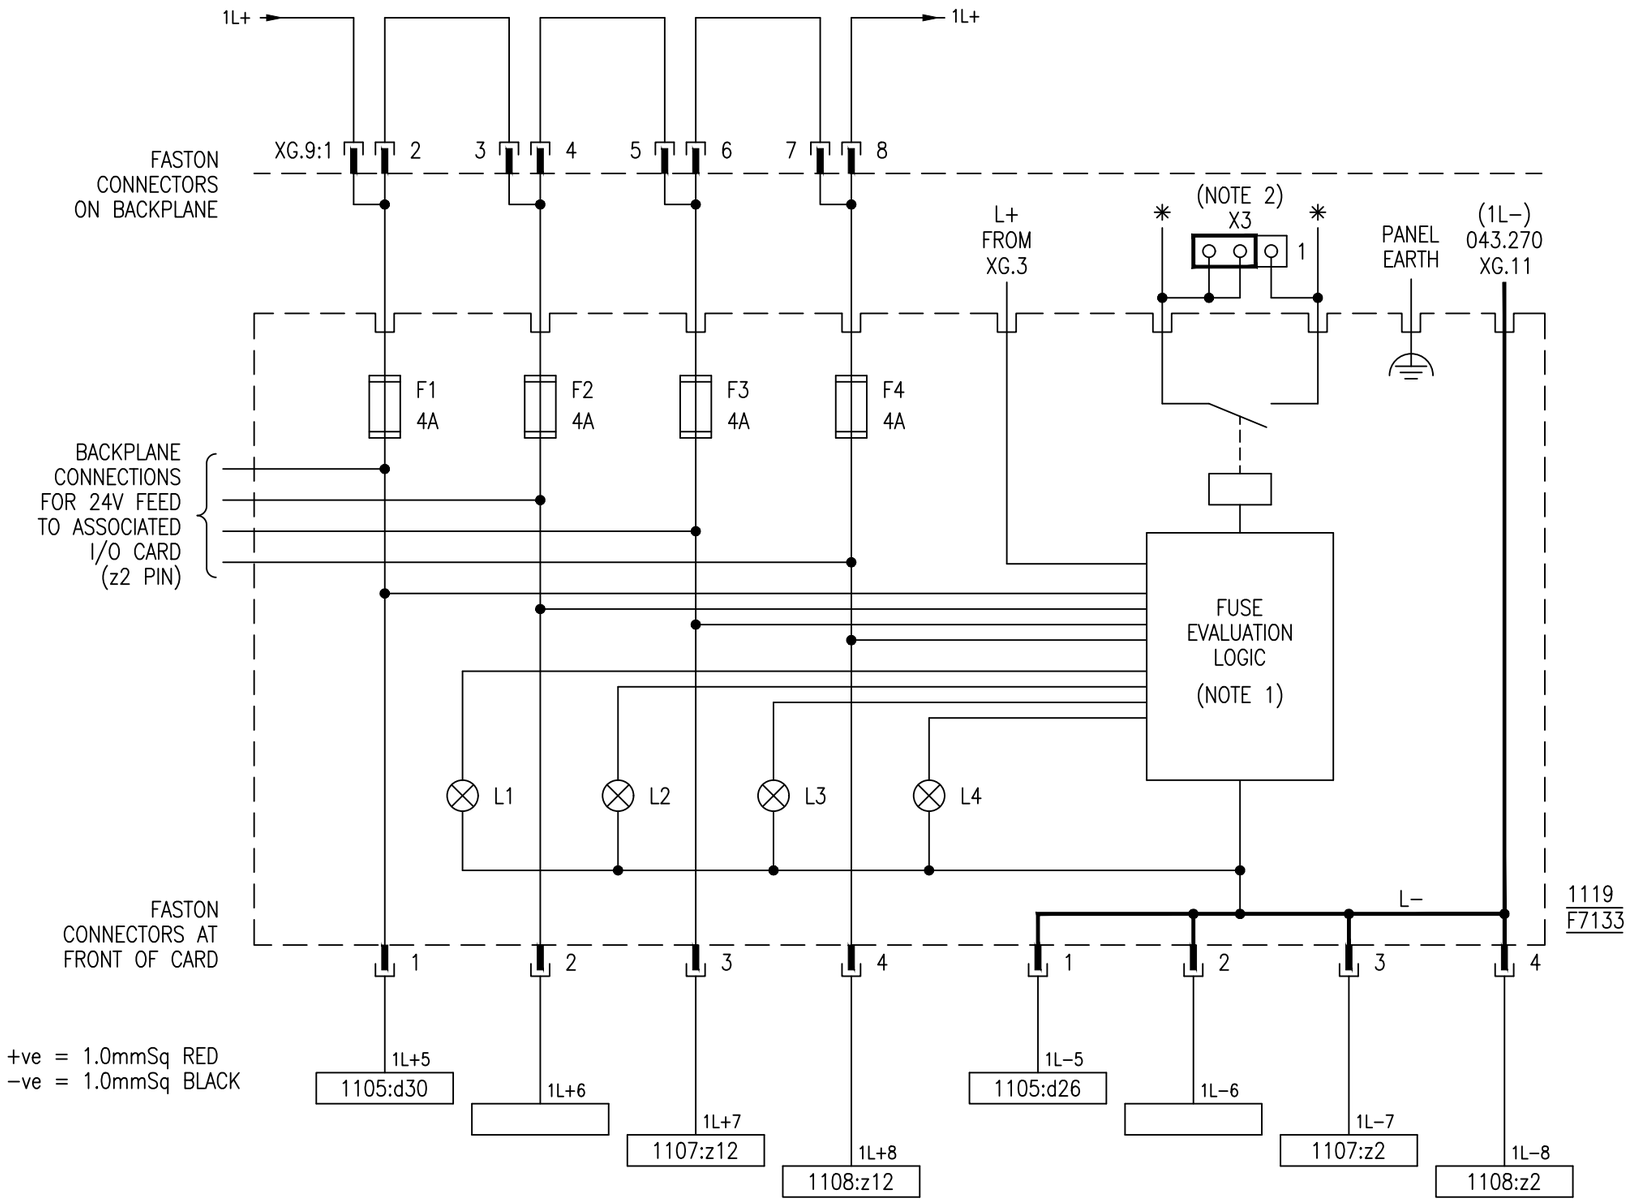

NOTES

1. IF F1–F4 FAILS, CORRESPONDING LED WILL FLASH. LOSS OF INCOMING 24Vdc WILL EXTINGUISH LED(s). RELAY WILL DE–ENERGISE IN THESE INSTANCES.

2. MOVE LINK X1–X4 (CARD POSITIONS 21–18) TO POSITION 1 IF NO F7133 FITTED.
   ✳ DENOTES BACKPLANE LINK TO ADJACENT F7133 CARD FUSE FAILURE CIRCUIT.

THIS DRAWING IS THE PROPERTY OF HIMA–SELLA LIMITED AND IS LOANED IN CONFIDENCE FOR USE WITH OUR WORK. IT IS NOT TO BE REPRODUCED IN ANY MANNER, SUBMITTED TO OUTSIDE PARTIES FOR EXAMINATION OR USED DIRECTLY OR INDIRECTLY FOR PURPOSES OTHER THAN THOSE FOR WHICH IT WAS FURNISHED WITHOUT WRITTEN CONSENT.

DO NOT STAMP 'MASTER' UNTIL ALL WORK IS FULLY CADDED

Rev	Design	Drawn	Chkd	Appd	Description	Date
C	NH	NH	CW	NGB	AS BUILT.	06.06.00
D	IM		IM		SITE MODS	11.08.11
						. .
						. .
						. .

Designed	NH
Drawn	NH
Checked	CW
Approved	NGB
Date	27.03.00
A3 Scale	N/A
Dims	N/A

HIMA–SELLA LIMITED © HIMA-SELLA

Title : F7133 24Vdc DISTRIBUTION CARD 1119
ICI SYNETIX ESD SYSTEM – No.3 AND No.7 PLANTS
FISHER–ROSEMOUNT – P.O. No. 99003994

Contract/ Drawing No: C10265/P3 | 044 | REV D

TEMPLATE DETAILS : 51P6COM–045–REV0
TITLEBOX : HS–A3

PROJECT/DIRECTORY NAME : C10265H

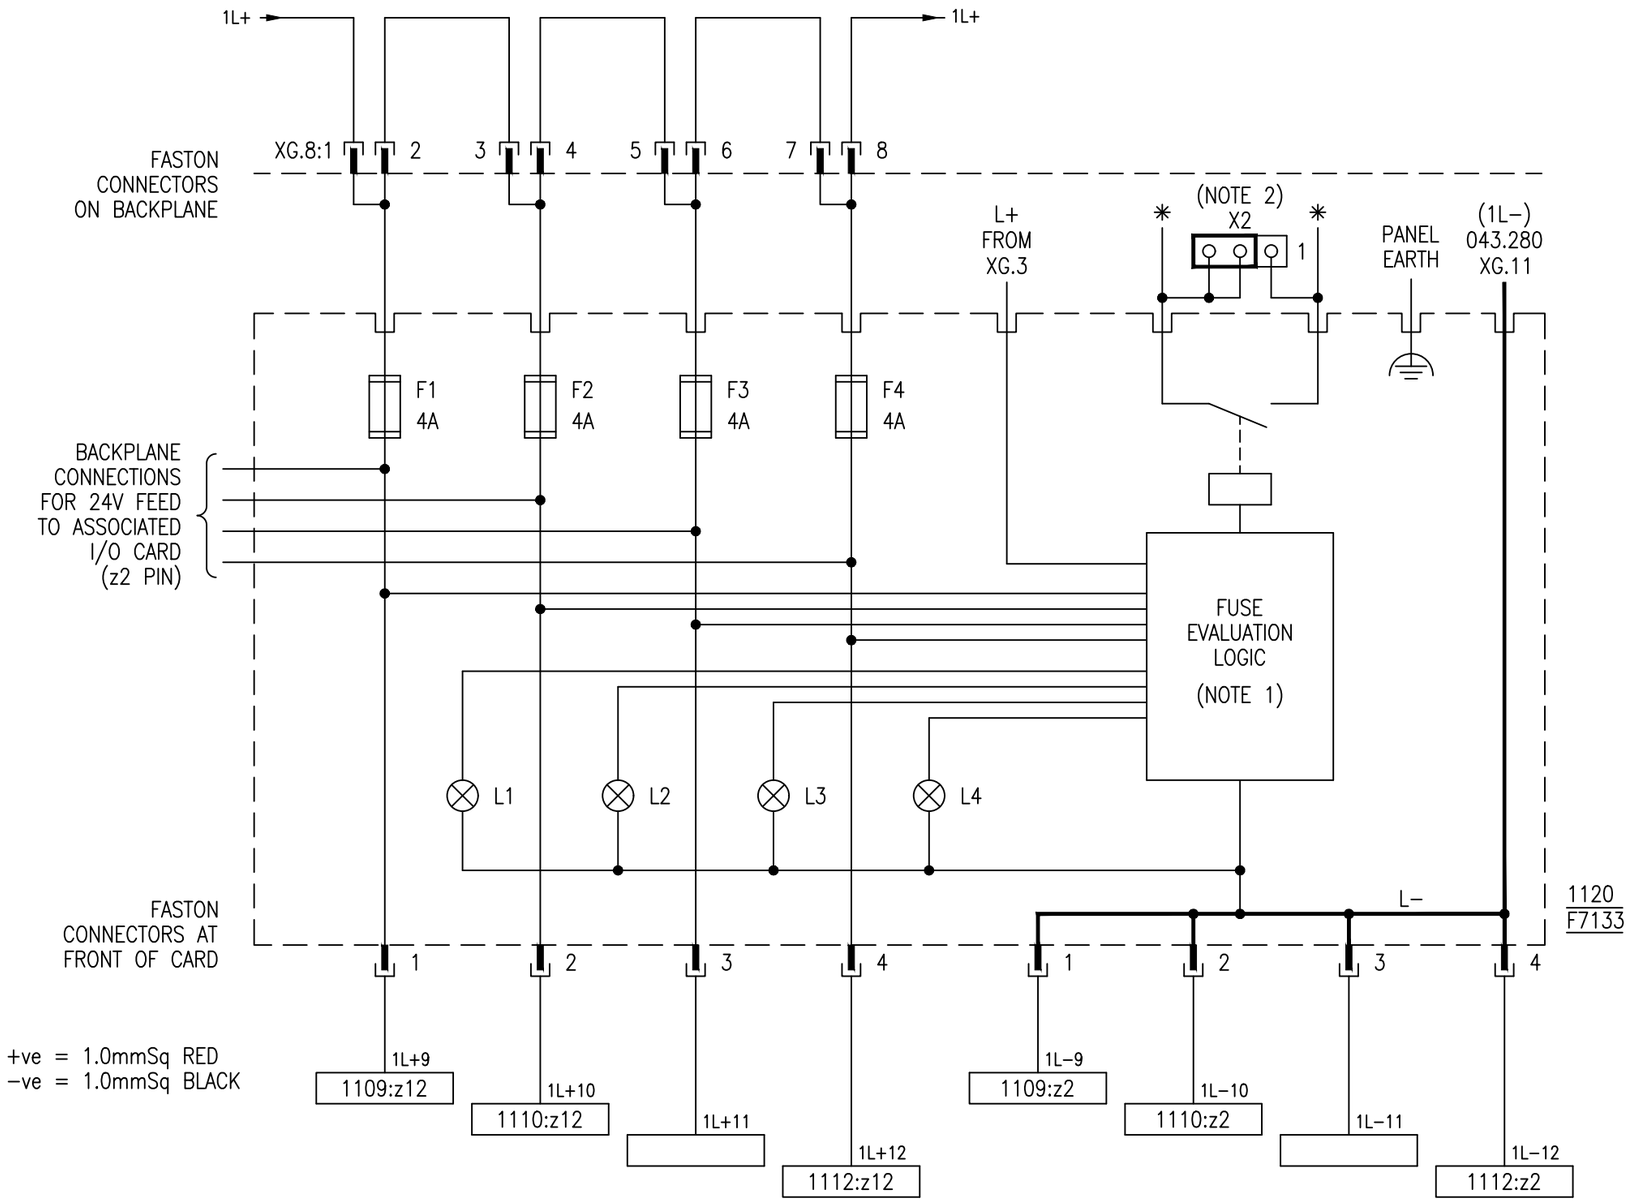

NOTES

1. IF F1–F4 FAILS, CORRESPONDING LED WILL FLASH. LOSS OF INCOMING 24Vdc WILL EXTINGUISH LED(s). RELAY WILL DE–ENERGISE IN THESE INSTANCES.

2. MOVE LINK X1–X4 (CARD POSITIONS 21–18) TO POSITION 1 IF NO F7133 FITTED.
   ✳ DENOTES BACKPLANE LINK TO ADJACENT F7133 CARD FUSE FAILURE CIRCUIT.

THIS DRAWING IS THE PROPERTY OF HIMA–SELLA LIMITED AND IS LOANED IN CONFIDENCE FOR USE WITH OUR WORK. IT IS NOT TO BE REPRODUCED IN ANY MANNER, SUBMITTED TO OUTSIDE PARTIES FOR EXAMINATION OR USED DIRECTLY OR INDIRECTLY FOR PURPOSES OTHER THAN THOSE FOR WHICH IT WAS FURNISHED WITHOUT WRITTEN CONSENT.

DO NOT STAMP 'MASTER' UNTIL ALL WORK IS FULLY CADDED

Rev	Design	Drawn	Chkd	Appd	Description	Date
C	NH	NH	CW	NGB	AS BUILT.	06.06.00
D	IM		IM		SITE MODS	11.08.11
						. .
						. .
						. .

Designed	NH
Drawn	NH
Checked	CW
Approved	NGB
Date	27.03.00
A3 Scale	N/A
Dims	N/A

HIMA–SELLA LIMITED © HIMA-SELLA

Title : F7133 24Vdc DISTRIBUTION CARD 1120
ICI SYNETIX ESD SYSTEM – No.3 AND No.7 PLANTS
FISHER–ROSEMOUNT – P.O. No. 99003994

Contract/ Drawing No: C10265/P3 | 045 | REV D

TEMPLATE DETAILS : 51P6COM–045–REV0
TITLEBOX : HS–A3

PROJECT/DIRECTORY NAME : C10265H

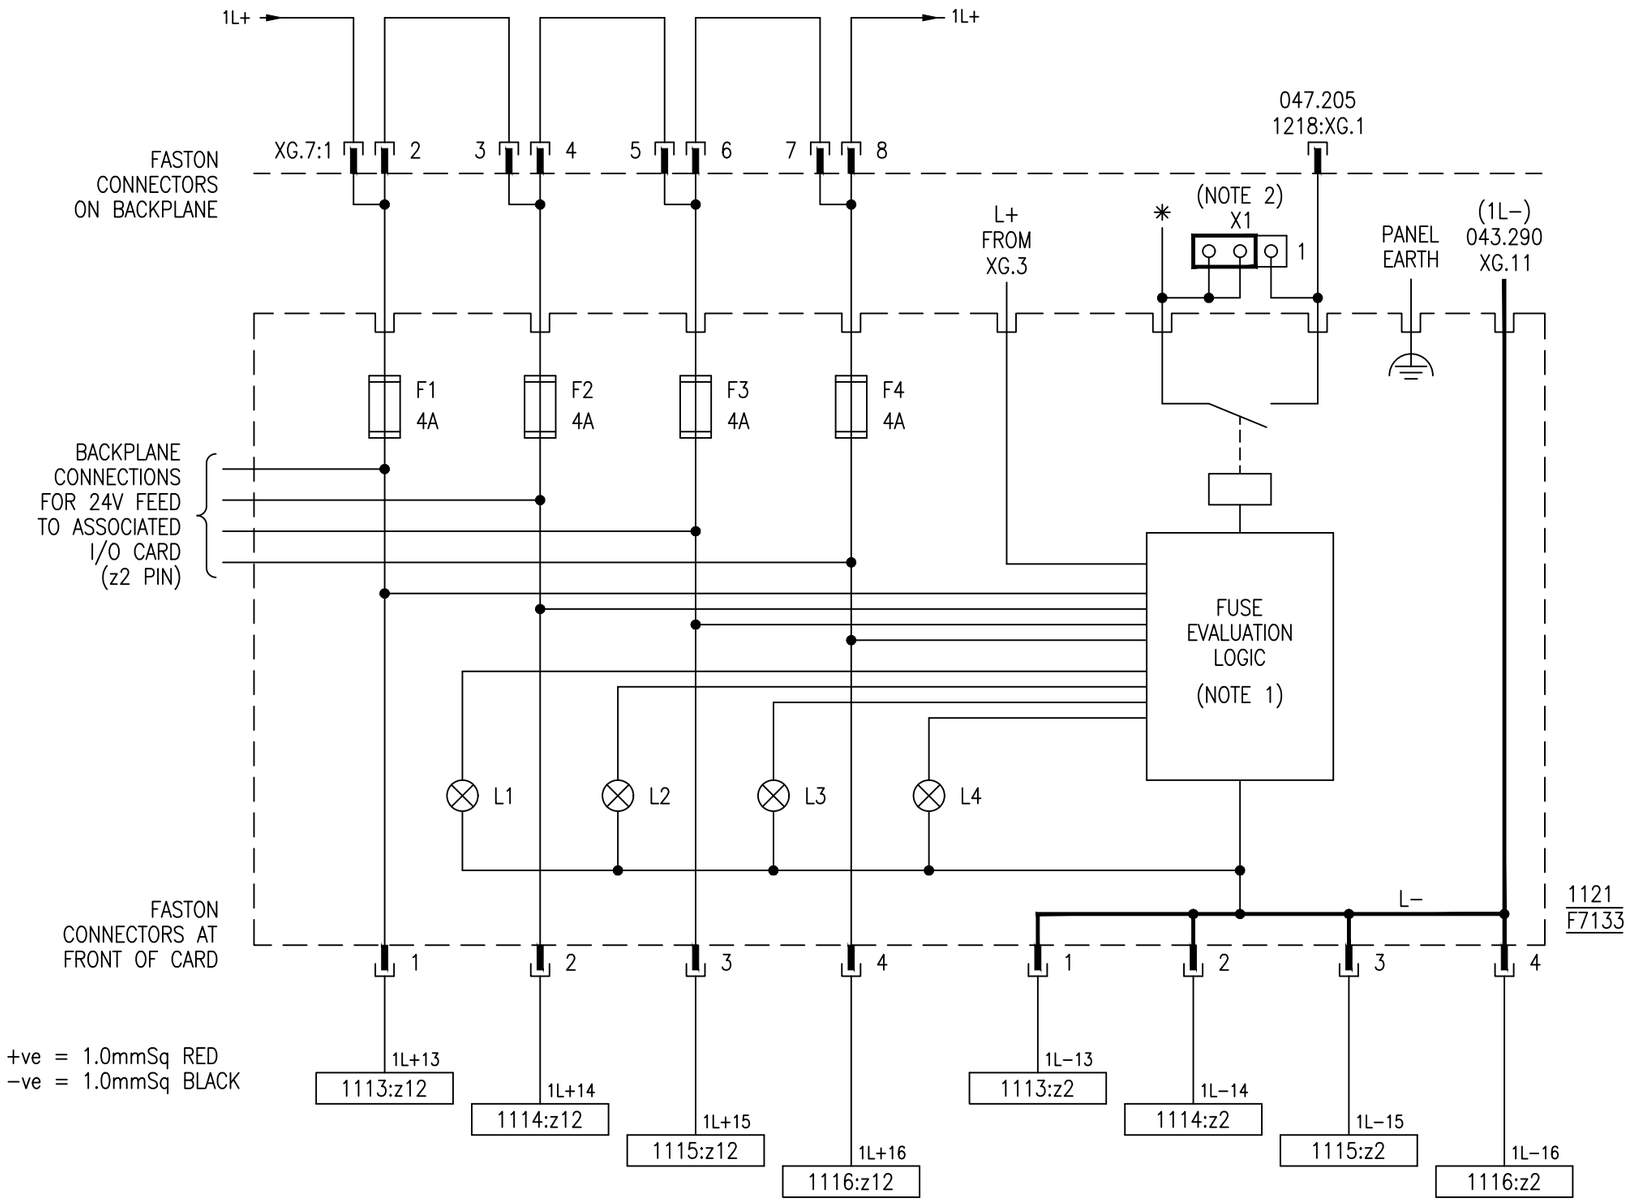

NOTES

1. IF F1–F4 FAILS, CORRESPONDING LED WILL FLASH. LOSS OF INCOMING 24Vdc WILL EXTINGUISH LED(s). RELAY WILL DE–ENERGISE IN THESE INSTANCES.

2. MOVE LINK X1–X4 (CARD POSITIONS 21–18) TO POSITION 1 IF NO F7133 FITTED.
   ✳ DENOTES BACKPLANE LINK TO ADJACENT F7133 CARD FUSE FAILURE CIRCUIT.

THIS DRAWING IS THE PROPERTY OF HIMA–SELLA LIMITED AND IS LOANED IN CONFIDENCE FOR USE WITH OUR WORK. IT IS NOT TO BE REPRODUCED IN ANY MANNER, SUBMITTED TO OUTSIDE PARTIES FOR EXAMINATION OR USED DIRECTLY OR INDIRECTLY FOR PURPOSES OTHER THAN THOSE FOR WHICH IT WAS FURNISHED WITHOUT WRITTEN CONSENT.

DO NOT STAMP 'MASTER' UNTIL ALL WORK IS FULLY CADDED

Rev	Design	Drawn	Chkd	Appd	Description	Date
C	NH	NH	CW	NGB	AS BUILT.	06.06.00
D	IM		IM			11.08.11
						. .
						. .
						. .

Designed	NH
Drawn	NH
Checked	CW
Approved	NGB
Date	27.03.00
A3 Scale	N/A
Dims	N/A

HIMA–SELLA LIMITED © HIMA-SELLA

Title : F7133 24Vdc DISTRIBUTION CARD 1121
ICI SYNETIX ESD SYSTEM – No.3 AND No.7 PLANTS
FISHER–ROSEMOUNT – P.O. No. 99003994

Contract/ Drawing No: C10265/P3 | 046 | REV D

TEMPLATE DETAILS : 51P6COM–045–REV0 | TITLEBOX : HS–A3

PROJECT/DIRECTORY NAME : C10265H

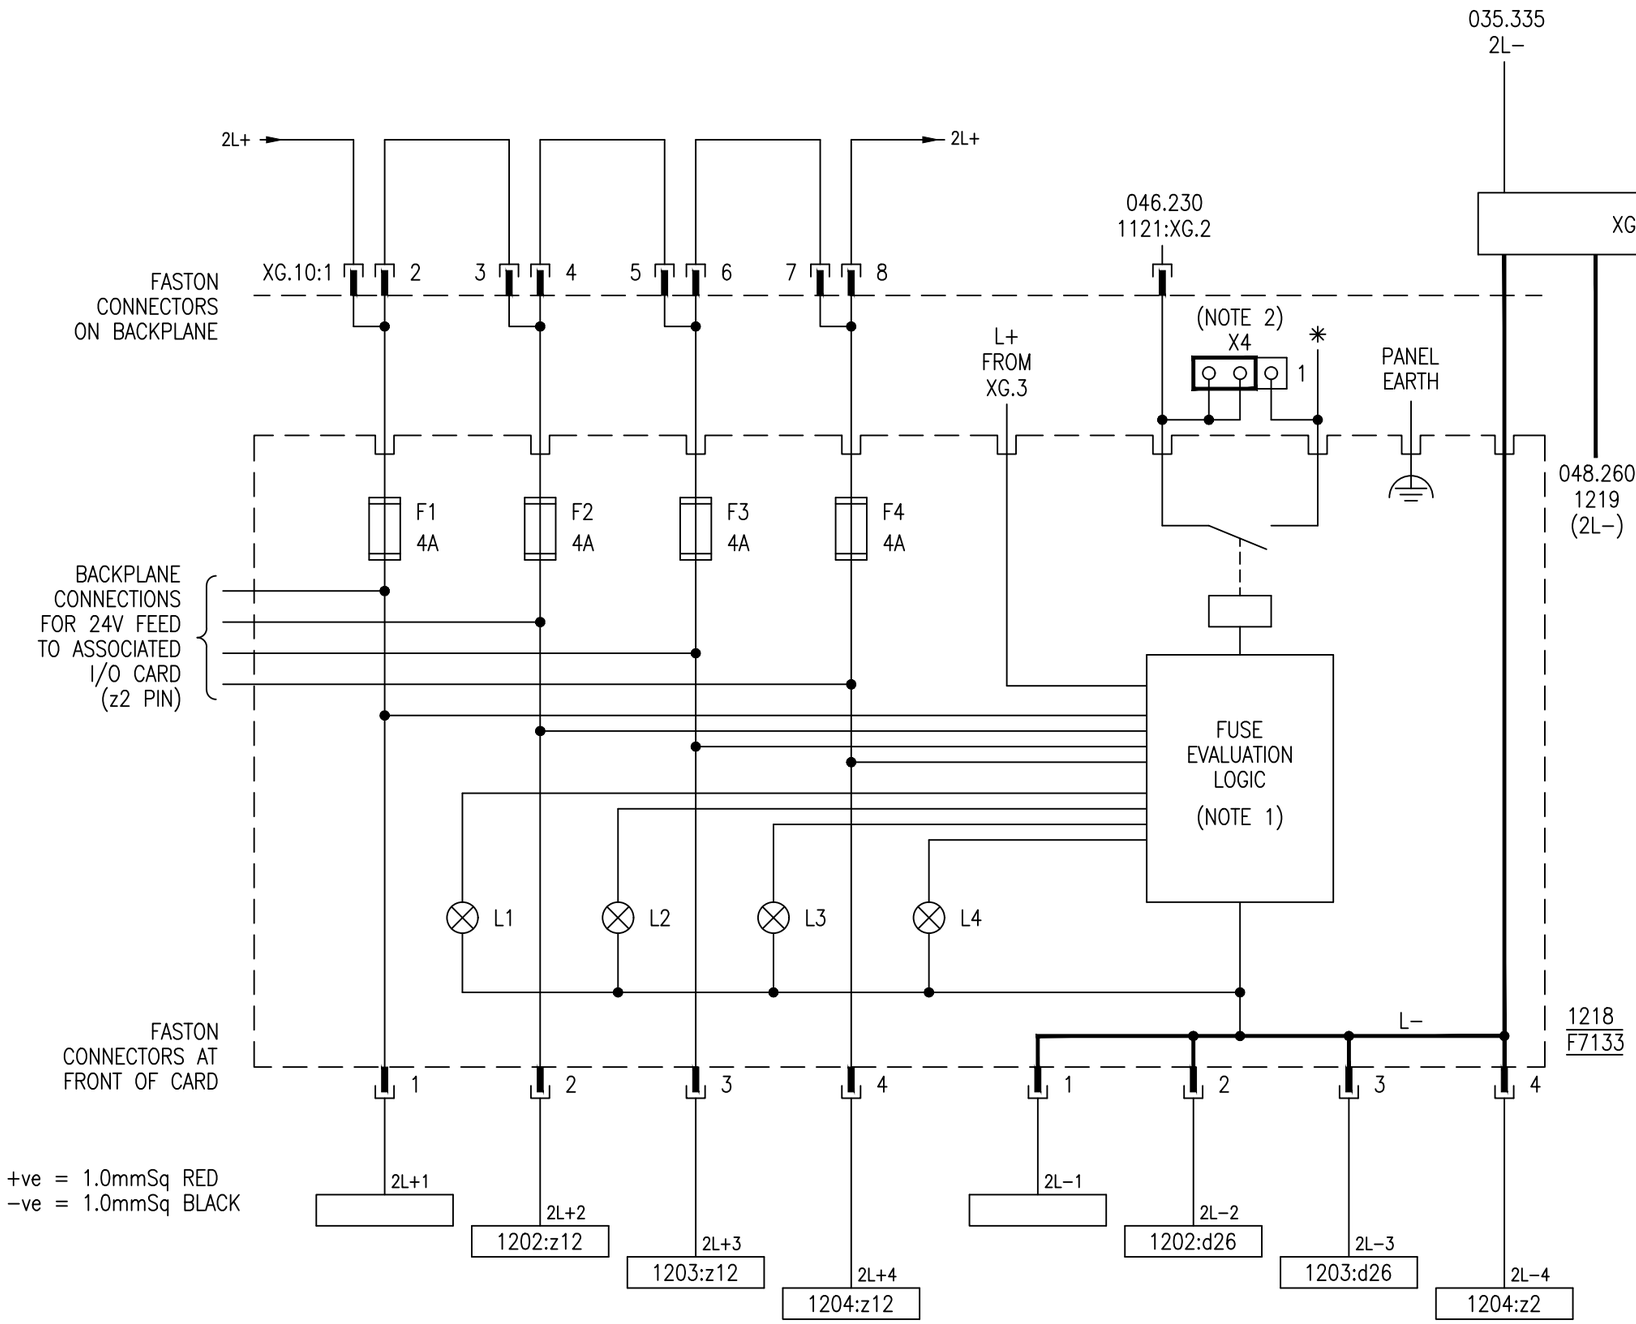

NOTES

1. IF F1–F4 FAILS, CORRESPONDING LED WILL FLASH. LOSS OF INCOMING 24Vdc WILL EXTINGUISH LED(s). RELAY WILL DE–ENERGISE IN THESE INSTANCES.

2. MOVE LINK X1–X4 (CARD POSITIONS 21–18) TO POSITION 1 IF NO F7133 FITTED.
   ✳ DENOTES BACKPLANE LINK TO ADJACENT F7133 CARD FUSE FAILURE CIRCUIT.

THIS DRAWING IS THE PROPERTY OF HIMA–SELLA LIMITED AND IS LOANED IN CONFIDENCE FOR USE WITH OUR WORK. IT IS NOT TO BE REPRODUCED IN ANY MANNER, SUBMITTED TO OUTSIDE PARTIES FOR EXAMINATION OR USED DIRECTLY OR INDIRECTLY FOR PURPOSES OTHER THAN THOSE FOR WHICH IT WAS FURNISHED WITHOUT WRITTEN CONSENT.

DO NOT STAMP 'MASTER' UNTIL ALL WORK IS FULLY CADDED

Rev	Design	Drawn	Chkd	Appd	Description	Date
C	NH	NH	CW	NGB	AS BUILT.	06.06.00
D	IM		IM		SITE MODS	11.08.11
						. .
						. .
						. .

Designed	NH
Drawn	NH
Checked	CW
Approved	NGB
Date	27.03.00
A3 Scale	N/A
Dims	N/A

HIMA–SELLA LIMITED © HIMA-SELLA

Title : F7133 24Vdc DISTRIBUTION CARD 1218
ICI SYNETIX ESD SYSTEM – No.3 AND No.7 PLANTS
FISHER–ROSEMOUNT – P.O. No. 99003994

Contract/ Drawing No: C10265/P3 | 047 | REV D

TEMPLATE DETAILS : 51P6COM–045–REV0 | TITLEBOX : HS–A3

PROJECT/DIRECTORY NAME : C10265H

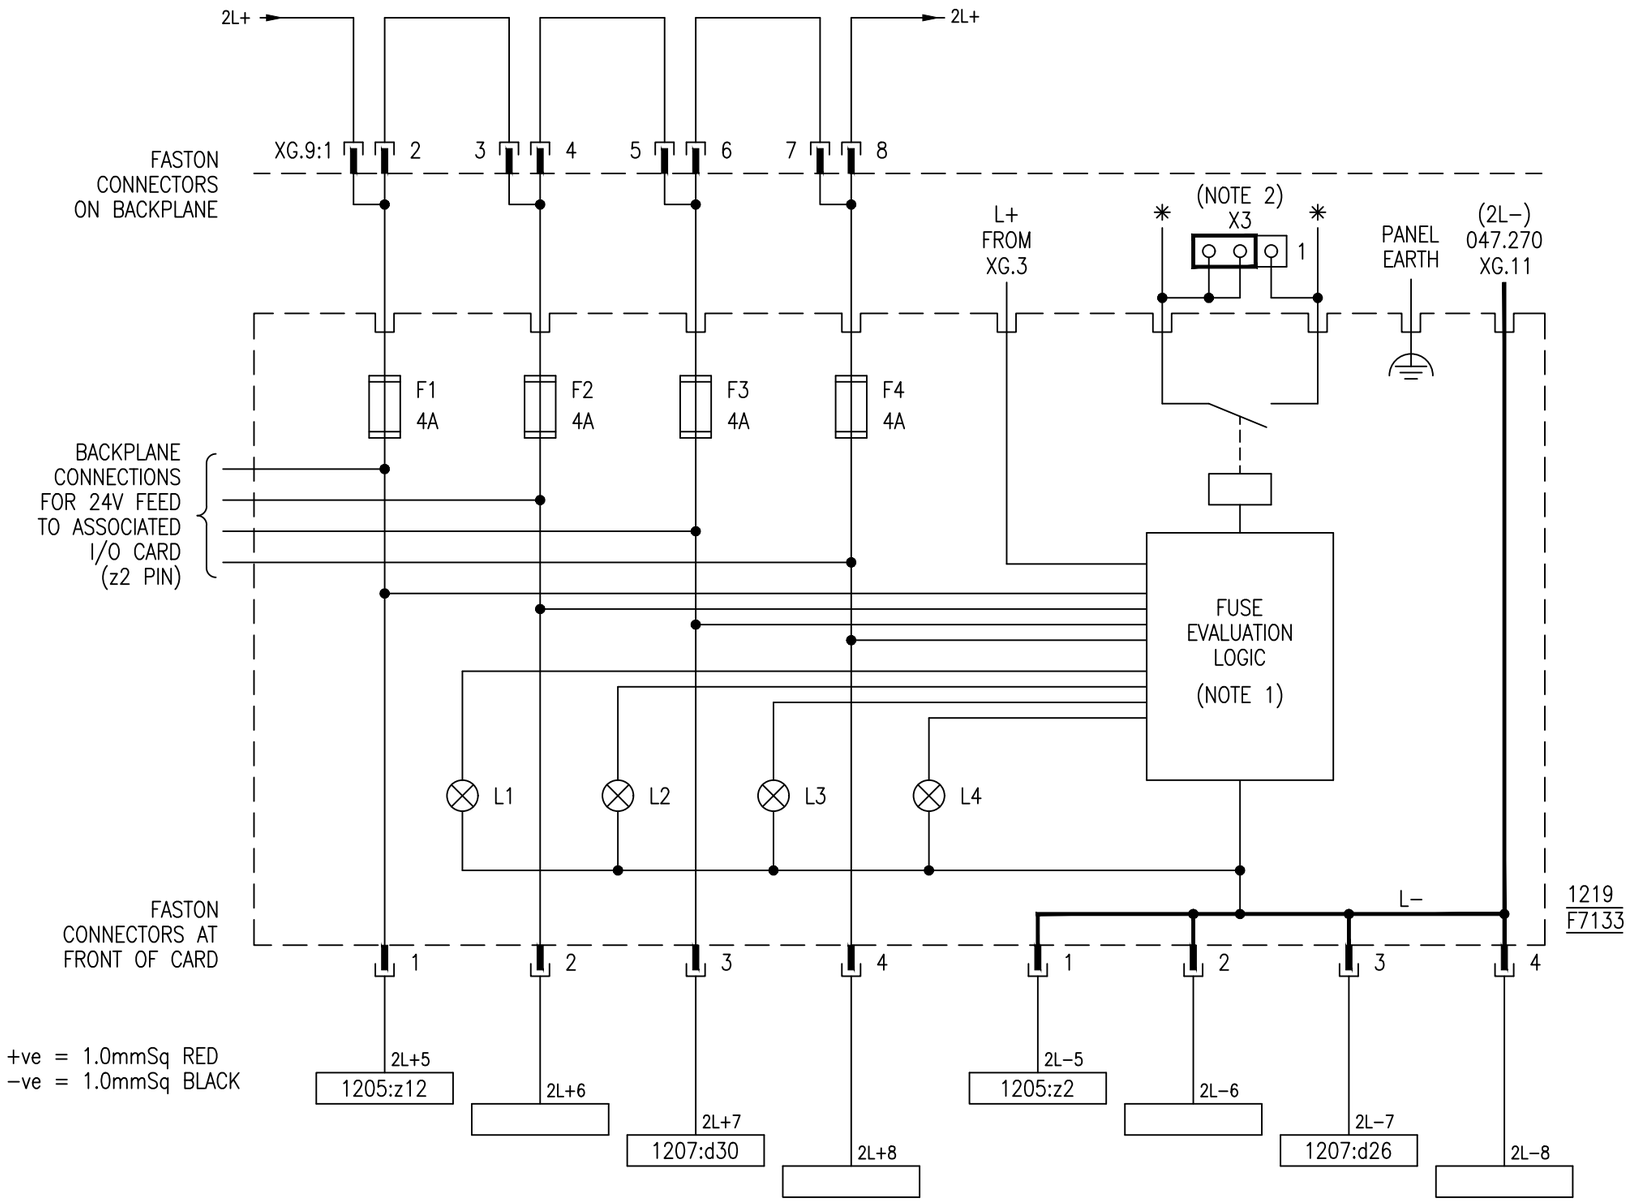

NOTES

1. IF F1–F4 FAILS, CORRESPONDING LED WILL FLASH. LOSS OF INCOMING 24Vdc WILL EXTINGUISH LED(s). RELAY WILL DE–ENERGISE IN THESE INSTANCES.

2. MOVE LINK X1–X4 (CARD POSITIONS 21–18) TO POSITION 1 IF NO F7133 FITTED.
   ✳ DENOTES BACKPLANE LINK TO ADJACENT F7133 CARD FUSE FAILURE CIRCUIT.

THIS DRAWING IS THE PROPERTY OF HIMA–SELLA LIMITED AND IS LOANED IN CONFIDENCE FOR USE WITH OUR WORK. IT IS NOT TO BE REPRODUCED IN ANY MANNER, SUBMITTED TO OUTSIDE PARTIES FOR EXAMINATION OR USED DIRECTLY OR INDIRECTLY FOR PURPOSES OTHER THAN THOSE FOR WHICH IT WAS FURNISHED WITHOUT WRITTEN CONSENT.

DO NOT STAMP 'MASTER' UNTIL ALL WORK IS FULLY CADDED

Rev	Design	Drawn	Chkd	Appd	Description	Date
C	NH	NH	CW	NGB	AS BUILT.	06.06.00
D	IM		IM			11.08.11
						. .
						. .
						. .

Designed	NH
Drawn	NH
Checked	CW
Approved	NGB
Date	27.03.00
A3 Scale	N/A
Dims	N/A

HIMA–SELLA LIMITED © HIMA-SELLA

Title : F7133 24Vdc DISTRIBUTION CARD 1219
ICI SYNETIX ESD SYSTEM – No.3 AND No.7 PLANTS
FISHER–ROSEMOUNT – P.O. No. 99003994

Contract/ Drawing No: C10265/P3 | 048 | REV D

TEMPLATE DETAILS : 51P6COM–045–REV0
TITLEBOX : HS–A3
PROJECT/DIRECTORY NAME : C10265H

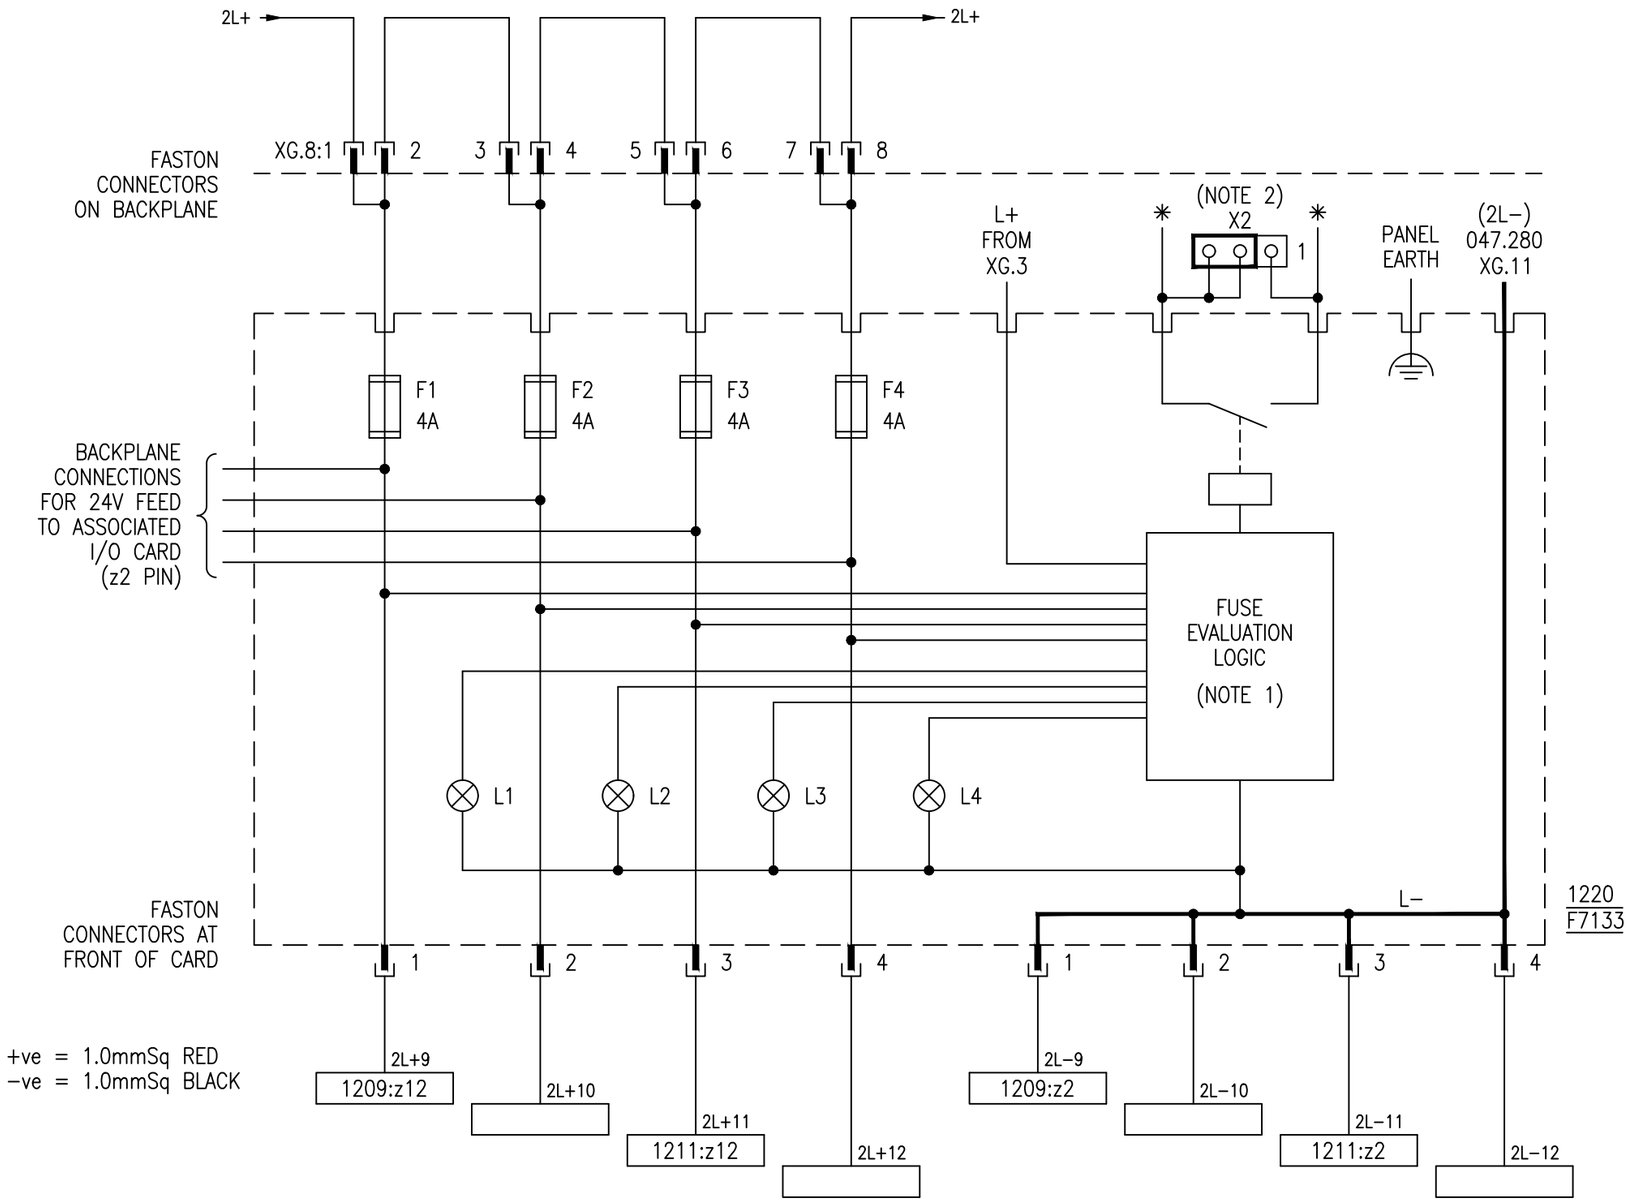

NOTES

1. IF F1–F4 FAILS, CORRESPONDING LED WILL FLASH. LOSS OF INCOMING 24Vdc WILL EXTINGUISH LED(s). RELAY WILL DE–ENERGISE IN THESE INSTANCES.

2. MOVE LINK X1–X4 (CARD POSITIONS 21–18) TO POSITION 1 IF NO F7133 FITTED.
   ✳ DENOTES BACKPLANE LINK TO ADJACENT F7133 CARD FUSE FAILURE CIRCUIT.

THIS DRAWING IS THE PROPERTY OF HIMA–SELLA LIMITED AND IS LOANED IN CONFIDENCE FOR USE WITH OUR WORK. IT IS NOT TO BE REPRODUCED IN ANY MANNER, SUBMITTED TO OUTSIDE PARTIES FOR EXAMINATION OR USED DIRECTLY OR INDIRECTLY FOR PURPOSES OTHER THAN THOSE FOR WHICH IT WAS FURNISHED WITHOUT WRITTEN CONSENT.

DO NOT STAMP 'MASTER' UNTIL ALL WORK IS FULLY CADDED

TEMPLATE DETAILS : 51P6COM–045–REV0

TITLEBOX : HS–A3

Rev	Design	Drawn	Chkd	Appd	Description	Date
C	NH	NH	CW	NGB	AS BUILT.	06.06.00
D	IM		IM			11.08.11
						. .
						. .
						. .

Designed	NH
Drawn	NH
Checked	CW
Approved	NGB
Date	27.03.00
A3 Scale	N/A
Dims	N/A

HIMA–SELLA LIMITED © HIMA-SELLA

Title : F7133 24Vdc DISTRIBUTION CARD 1220
ICI SYNETIX ESD SYSTEM – No.3 AND No.7 PLANTS
FISHER–ROSEMOUNT – P.O. No. 99003994

Contract/ Drawing No: C10265/P3 | 049 | REV D

PROJECT/DIRECTORY NAME : C10265H

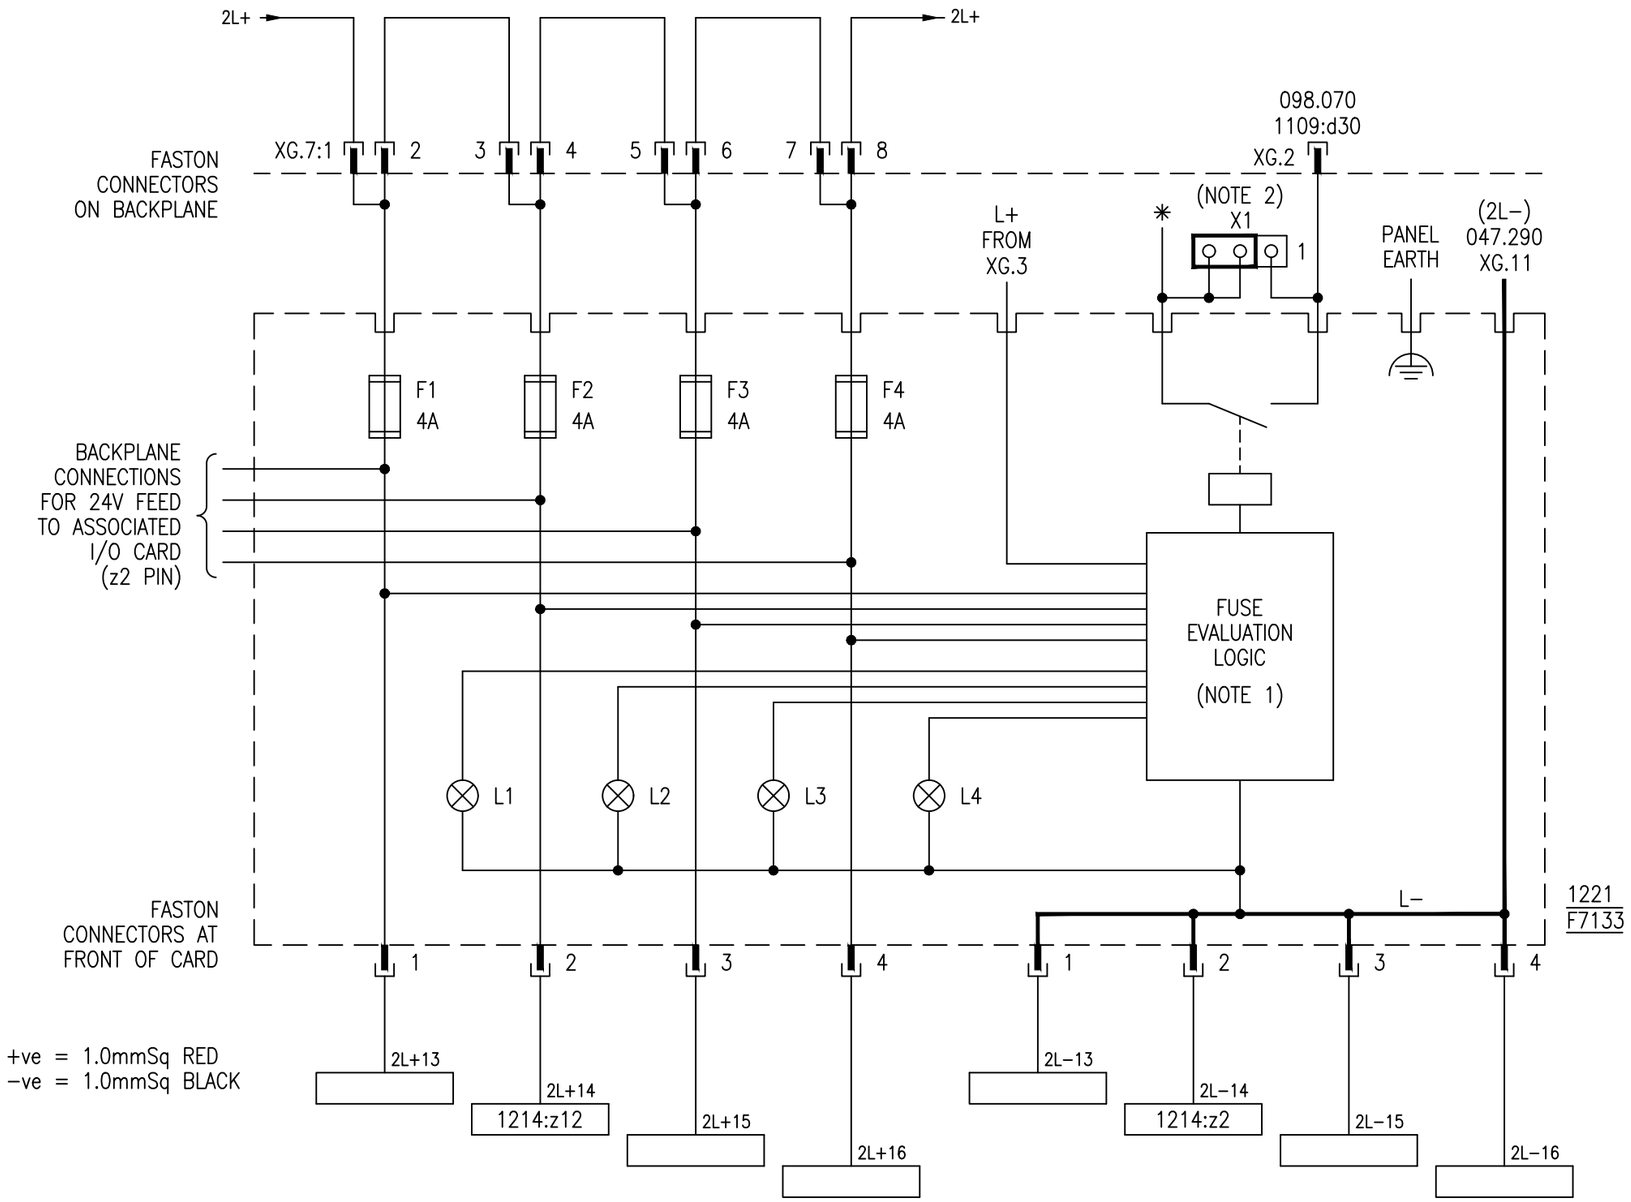

NOTES

1. IF F1–F4 FAILS, CORRESPONDING LED WILL FLASH. LOSS OF INCOMING 24Vdc WILL EXTINGUISH LED(s). RELAY WILL DE–ENERGISE IN THESE INSTANCES.

2. MOVE LINK X1–X4 (CARD POSITIONS 21–18) TO POSITION 1 IF NO F7133 FITTED.
   ✳ DENOTES BACKPLANE LINK TO ADJACENT F7133 CARD FUSE FAILURE CIRCUIT.

THIS DRAWING IS THE PROPERTY OF HIMA–SELLA LIMITED AND IS LOANED IN CONFIDENCE FOR USE WITH OUR WORK. IT IS NOT TO BE REPRODUCED IN ANY MANNER, SUBMITTED TO OUTSIDE PARTIES FOR EXAMINATION OR USED DIRECTLY OR INDIRECTLY FOR PURPOSES OTHER THAN THOSE FOR WHICH IT WAS FURNISHED WITHOUT WRITTEN CONSENT.

DO NOT STAMP 'MASTER' UNTIL ALL WORK IS FULLY CADDED

Rev	Design	Drawn	Chkd	Appd	Description	Date
C	NH	NH	CW	NGB	AS BUILT.	06.06.00
						. .
						. .
						. .
						. .

Designed	NH
Drawn	NH
Checked	CW
Approved	NGB
Date	27.03.00
A3 Scale	N/A
Dims	N/A

HIMA–SELLA LIMITED © HIMA-SELLA

Title : F7133 24Vdc DISTRIBUTION CARD 1221
ICI SYNETIX ESD SYSTEM – No.3 AND No.7 PLANTS
FISHER–ROSEMOUNT – P.O. No. 99003994

Contract/ Drawing No: C10265/P3 | 050 | REV C

TEMPLATE DETAILS : 51P6COM–045–REV0
TITLEBOX : HS–A3

PROJECT/DIRECTORY NAME : C10265H

50 | 100 | 150 | 200 | 250 | 300 | 350 | 400

CABLE & TERMINALS	FIELD	ANNUN/CONSOLE	INPUT O/R	INPUT NON-I.S.	DELTA V MODBUS	LOGIC	DELTA V MODBUS	OUTPUT NON-I.S.	OUTPUT I.S.	PROCESS DEVICE TAG No.	CABLE & TERMINALS
3/C654 4 & 11	03HZS03350 LOW FLOWS RESET LOOP TYPE DI1	C P/B CONTROL ROOM		DIGITAL I/P F3236		T1 OFF 2 mins					
		W12									
3/C654 8 & 11	03HZS03354 COPPER DISSOLVING STOP LOOP TYPE DI1	F P/B CONTROL ROOM		DIGITAL I/P F3236	03HZA03350						
		W01									
3/C650 1 & 2	Nitric Acid 03FZT03002 LOOP TYPE AI1			ANALOG I/P F6217	03FZA03002						
		W02									
3/C650 3 & 4	Scrubber Liquor 03FZT03004 LOOP TYPE AI1			ANALOG I/P F6217	03FZA03004						
		W51 & 52									
3/C731 1 & 2	Oxygen 03FZT03006 LOOP TYPE AI1			ANALOG I/P F6217	03FZA03006A						
		W57									
3/C668 13 & 14	Flow Density 03QZT03581 LOOP TYPE AI1			ANALOG I/P F6217	03QZA03581						
		W45									
3/C668 3 & 4	LEVEL IN 3F3 03LZT03691 LOOP TYPE AI2			ANALOG I/P F6217	03LZA03691						
		W46									
3/C668 5 & 6	Recirculation Flow 03FZT03007 LOOP TYPE AI2			ANALOG I/P F6217	03FZA03007						
		W47									
3/C668 7 & 8	Recirculation Flow 03FZT03008 LOOP TYPE AI2			ANALOG I/P F6217	03FZA03008						
		W48									
3/C668 9 & 10	Recirculation Flow 03FZT03010 LOOP TYPE AI2			ANALOG I/P F6217	03FZA03010						
		W14									
3/C650 17 & 18	Recirculation Flow 03FZT03012 LOOP TYPE AI2			ANALOG I/P F6217	03FZA03012						
		W11									
3/C650 9 & 10	Vent Fan D.P. 03PDZT03078 LOOP TYPE AI2			ANALOG I/P F6217	03PDZA03078	3C 052.150					
		W05									
3/C731 3 & 4	Recirculation Temp 03TZT03052 LOOP TYPE AI1			ANALOG I/P F6217	03TZA03052A HIGH 03TZA03052B LOW	03TZA03052C 03TZA03052D	HIHI 3M 053.140 LOLO 3N 053.140				
		W08									
3/C651 11 & 12	3J4A Pump Running 03EZS03412 LOOP TYPE DI1			DIGITAL I/P F3236	03EZS03412	OR DV3_6					
3/C651 13 & 14	3J4B Pump Running 03EZS03413 LOOP TYPE DI1			DIGITAL I/P F3236	03EZS03413						
		W15									
		W06									
3/C650 11 & 12	3F1 Dissolver Level 03LZT03110 LOOP TYPE AI2			ANALOG I/P F6217	03LZA03110A HIGH		LOW 3E 053.165 MID 3F 053.165				
		W16									
	03HZS03110 3F1 MID LEVEL TRIP LZA-3110C NORMAL OPERATION/OVERRIDE LOOP TYPE DI1	B Ω K/S CONTROL ROOM		DIGITAL I/P F3236	MID 03LZA03110C 03HZA03559	OR DV3_7					

3A 052.225	OR	DV3_1					
3P 053.140	AND	DV3_2					
	OR	DV3_3					
	AND	DV3_4					
3L 053.140	LOLO 03FZA03006B		1-5V	V TO I ISOCON 6	4-20mA	03ZRT03581	3/C735 1 & 2
			1-5V	V TO I	4-20mA	03FZRT03007	3/C661 15 & 16
			1-5V	V TO I	4-20mA	03FZRT03008	3/C661 17 & 18
			1-5V	V TO I	4-20mA	03FZRT0310	3/C661 19 & 20
			1-5V	V TO I	4-20mA	03FZRT03012	3/C661 1 & 2
3B 052.170	AND	DV3_5	1-5V	V TO I	4-20mA	03PDZRT03078	3/C661 3 & 4
			1-5V	V TO I	4-20mA	03LZRT03110	3/C651 5 & 6

NOTES

1. FOR TYPICAL LOOP TYPES SEE DRGS C10265H/070 & 071
2. ALL ANNUNCIATOR OUTPUTS TYPICAL LOOP TYPE DO3

THIS DRAWING IS THE PROPERTY OF HIMA-SELLA LIMITED AND IS LOANED IN CONFIDENCE FOR USE WITH OUR WORK. IT IS NOT TO BE REPRODUCED IN ANY MANNER, SUBMITTED TO OUTSIDE PARTIES FOR EXAMINATION OR USED DIRECTLY OR INDIRECTLY FOR PURPOSES OTHER THAN THOSE FOR WHICH IT WAS FURNISHED WITHOUT WRITTEN CONSENT.

Scale on A3 sheet	N/A
Dimensions	N/A

Template Revision – For Office Records Only			
REV	AUTH	DATE	CAD TEMPLATE REF.
B	MB	7.4.10	A3-FRAME

DO NOT STAMP 'MASTER' UNTIL ALL WORK IS FULLY CADDED

Rev	Design	Drawn	Chkd	Appd	Description	Date
P3	NH	NH	CW	NGB	CLIENTS COMMENTS.	20.04.00
P4	NH	NH	CW	NGB	UPDATED WITH CLIENTS COMMENTS	17.05.00
C	NH	NH	CW	NGB	AS BUILT.	06.06.00
D	CP	EJC	CW	NGB	SITE MODS	15.09.00
E	PS	PS	CW	NGB	NEW DENSITY METER	09.10.03
F	MB	MB	AD	MRS	REDRAWN WITH FOUR INSTRUMENTS ADDED.	11.08.09
G	IM	AB	IM	MRS	SITE MODS	11.08.11
H					DRAWING CHANGES	12.10.11

Designed	NH
Drawn	NH
Checked	CW
Approved	NGB
Date	21.02.00
Cad Reference	10265-P3-051#MB08

HIMA–SELLA LIMITED © HIMA-SELLA

Title : FLD - No.3 PLANT COPPER DISSOLVING AREA
ICI SYNETIX ESD SYSTEM - No.3 AND No.7 PLANTS
FISHER-ROSEMOUNT - P.O. No. 99003994

Contract/ Drawing No	C10265H/P3	051	REV	H

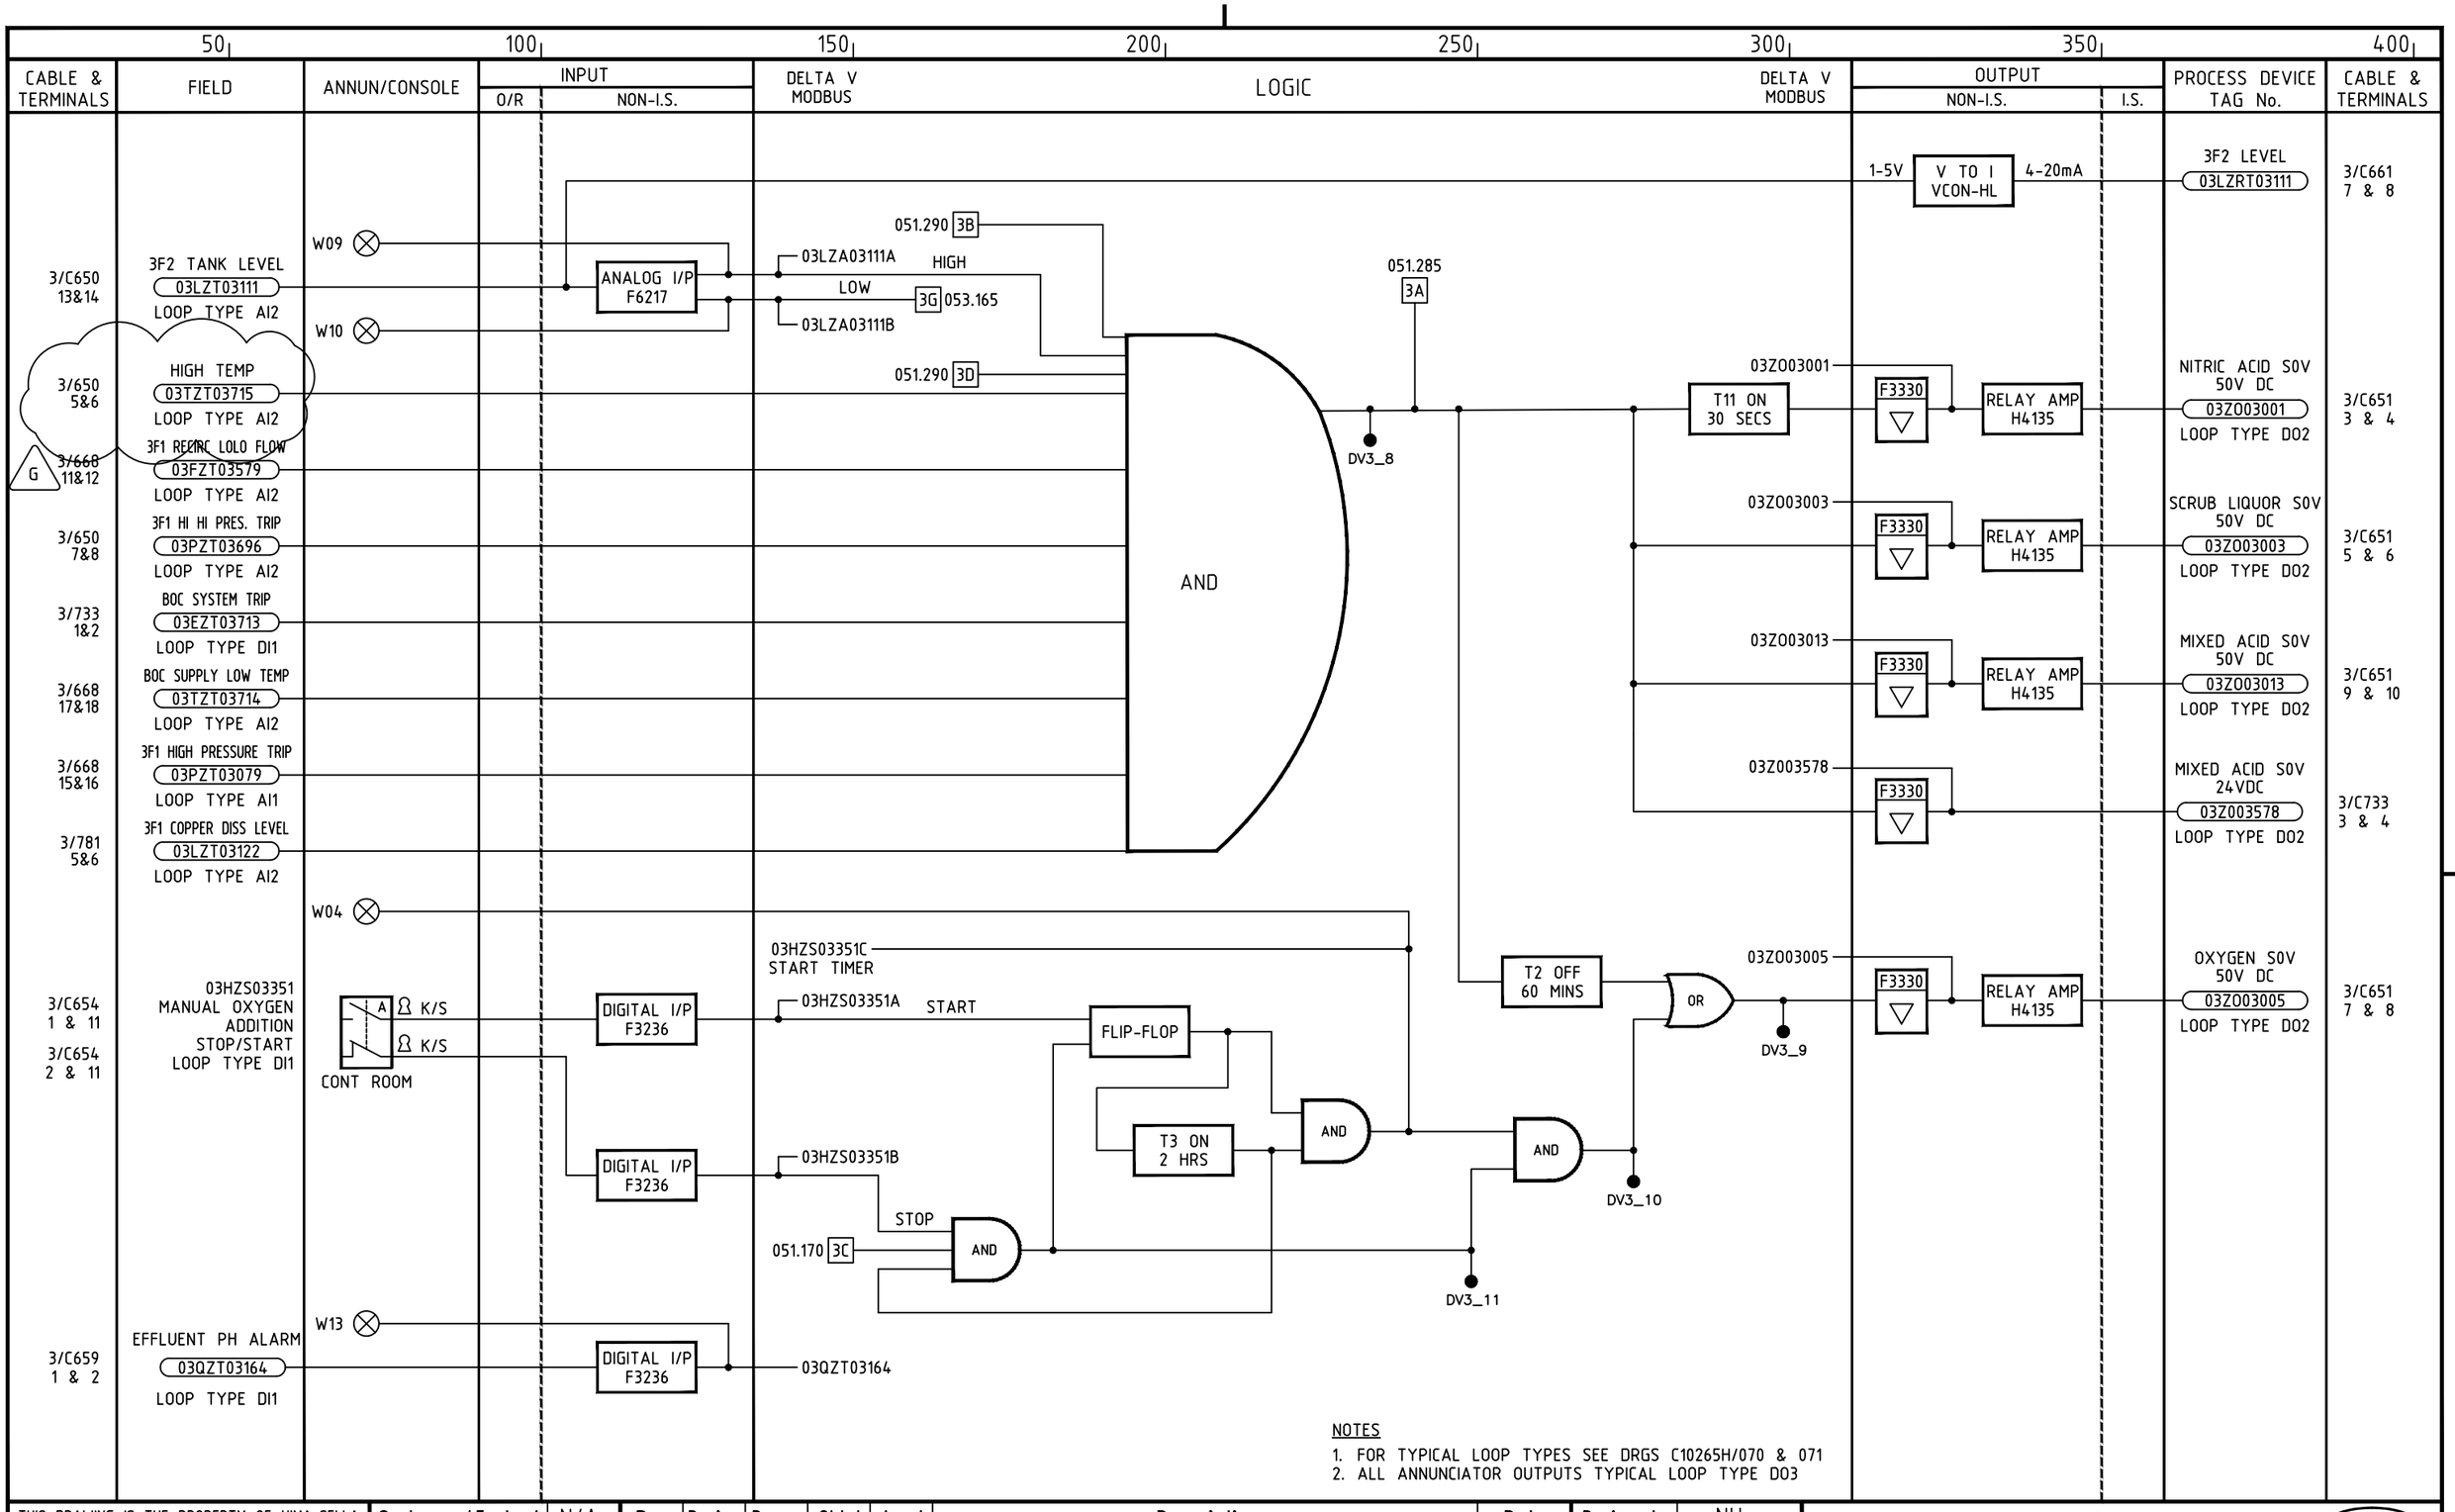

NOTES

1. FOR TYPICAL LOOP TYPES SEE DRGS C10265H/070 & 071
2. ALL ANNUNCIATOR OUTPUTS TYPICAL LOOP TYPE DO3

THIS DRAWING IS THE PROPERTY OF HIMA-SELLA LIMITED AND IS LOANED IN CONFIDENCE FOR USE WITH OUR WORK. IT IS NOT TO BE REPRODUCED IN ANY MANNER, SUBMITTED TO OUTSIDE PARTIES FOR EXAMINATION OR USED DIRECTLY OR INDIRECTLY FOR PURPOSES OTHER THAN THOSE FOR WHICH IT WAS FURNISHED WITHOUT WRITTEN CONSENT.

Scale on A3 sheet	N/A
Dimensions	N/A

Template Revision – For Office Records Only

REV	AUTH	DATE	CAD TEMPLATE REF.
A	PRS	9.2.00	A3-FRAME

DO NOT STAMP 'MASTER' UNTIL ALL WORK IS FULLY CADDED

Rev	Design	Drawn	Chkd	Appd	Description	Date
G	..	..	..	NGB	AS BUILT PER C10265-006V	29.05.12
P4	NH	NH	CW	NGB	UPDATED WITH CLIENTS COMMENTS	17.05.00
C	NH	NH	CW	NGB	AS BUILT	06.06.00
D	NH	NH	CW	NGB	SITE MODS	15.09.00
E	IM	AB	IM	MRS	TEXT ADDED	11.08.11
F	IM	AB	IM	MRS	TEXT CORRECTED	11.10.11

Designed	NH
Drawn	NH
Checked	CW
Approved	NGB
Date	21.02.00
Cad Reference	10265-P3-052#WJB01

HIMA–SELLA LIMITED © HIMA-SELLA

Title : FLD - No.3 PLANT COPPER DISSOLVING AREA
ICI SYNETIX ESD SYSTEM - No.3 AND No.7 PLANTS
FISHER-ROSEMOUNT - P.O. No. 99003994

Contract/ Drawing No	C10265H/P3	052	REV	G

CABLE & TERMINALS	FIELD	ANNUN/CONSOLE	INPUT O/R	INPUT NON-I.S.	DELTA V MODBUS	LOGIC	DELTA V MODBUS	OUTPUT NON-I.S.	OUTPUT I.S.	PROCESS DEVICE TAG No.	CABLE & TERMINALS
3/C654 6 & 11 3/C654 7 & 11	03HZS03352 TRANSFER FROM 3F1 & 3F2 LOOP TYPE DI1	W07 E K/S K/S CONT ROOM		DIGITAL I/P F3236 DIGITAL I/P F3236	03LZA03110B 051.290 3E 3F1 03HZS03352A 03HZS03352B 3F2 052.160 3G	AND DV3_12 OR DV3_13 AND DV3_14	03EZ003414 03EZ003415	F3330 RELAY AMP H4135 F3330 RELAY AMP H4135		50V AC 03EZ003414 LOOP TYPE DO2 50V AC 03EZ003415 LOOP TYPE DO2	3/C651 15 & 16 3/C651 17 & 18
3/C654 5 & 11	03HZS03111 ENABLE TRANSFER 3F2 TO 3F6 LOOP TYPE DI1	D P/B CONT ROOM		DIGITAL I/P F3236	03HZS03111	OR DV3_16 AND DV3_15	03Z003111	F3330 RELAY AMP H4135		50V DC 03Z003111 LOOP TYPE DO2	3/C651 1 & 2
3/C660 1 & 2	03PZSH03087 LOOP TYPE DI1	W17 W18		DIGITAL I/P F3236	051.290 3F 03LZA03110D 03PZSH03087	AND DV3_17	03Z003427	F3330 RELAY AMP H4135		50V AC 03Z003427 LOOP TYPE DO2	3/C651 19 & 20
	RESET 03Z003599 LOOP TYPE DI1				03FZA03066B 051.255 3L 051.255 3P 03TZT03052C 051.255 3M 03TZT03052D 051.255 3N 051.255 3P	OR AND OR				MIXED ACID SOV 24V DC 03Z003599	3/C732 1 & 2

NOTES
1. FOR TYPICAL LOOP TYPES SEE DRGS C10265H/070 & 071
2. ALL ANNUNCIATOR OUTPUTS TYPICAL LOOP TYPE DO3

THIS DRAWING IS THE PROPERTY OF HIMA-SELLA LIMITED AND IS LOANED IN CONFIDENCE FOR USE WITH OUR WORK. IT IS NOT TO BE REPRODUCED IN ANY MANNER, SUBMITTED TO OUTSIDE PARTIES FOR EXAMINATION OR USED DIRECTLY OR INDIRECTLY FOR PURPOSES OTHER THAN THOSE FOR WHICH IT WAS FURNISHED WITHOUT WRITTEN CONSENT.

Scale on A3 sheet	N/A
Dimensions	N/A

Template Revision – For Office Records Only

REV	AUTH	DATE	CAD TEMPLATE REF.
A	PRS	9.2.00	A3-FRAME

DO NOT STAMP 'MASTER' UNTIL ALL WORK IS FULLY CADDED

Rev	Design	Drawn	Chkd	Appd	Description	Date
P2	NH	NH	CW	NGB	CLIENTS COMMENTS.	09.03.00
P3	NH	NH	CW	NGB	CLIENTS COMMENTS.	20.04.00
P4	NH	NH	CW	NGB	UPDATED WITH CLIENTS COMMENTS.	17.05.00
C	NH	NH	CW	NGB	AS BUILT.	06.06.00
D	IM	AB	IM	MRS	TEXT CHANGES	11.08.11
E					TEXT CHANGES CORRECTED	10.10.11

Designed	NH
Drawn	NH
Checked	CW
Approved	NGB
Date	21.02.00
Cad Reference	10265-P3-053#WJB02

HIMA–SELLA LIMITED © HIMA-SELLA

Title : FLD - No.3 PLANT COPPER DISSOLVING AREA
ICI SYNETIX ESD SYSTEM - No.3 AND No.7 PLANTS
FISHER-ROSEMOUNT - P.O. No. 99003994

Contract/ Drawing No	C10265H/P3	053	REV	E

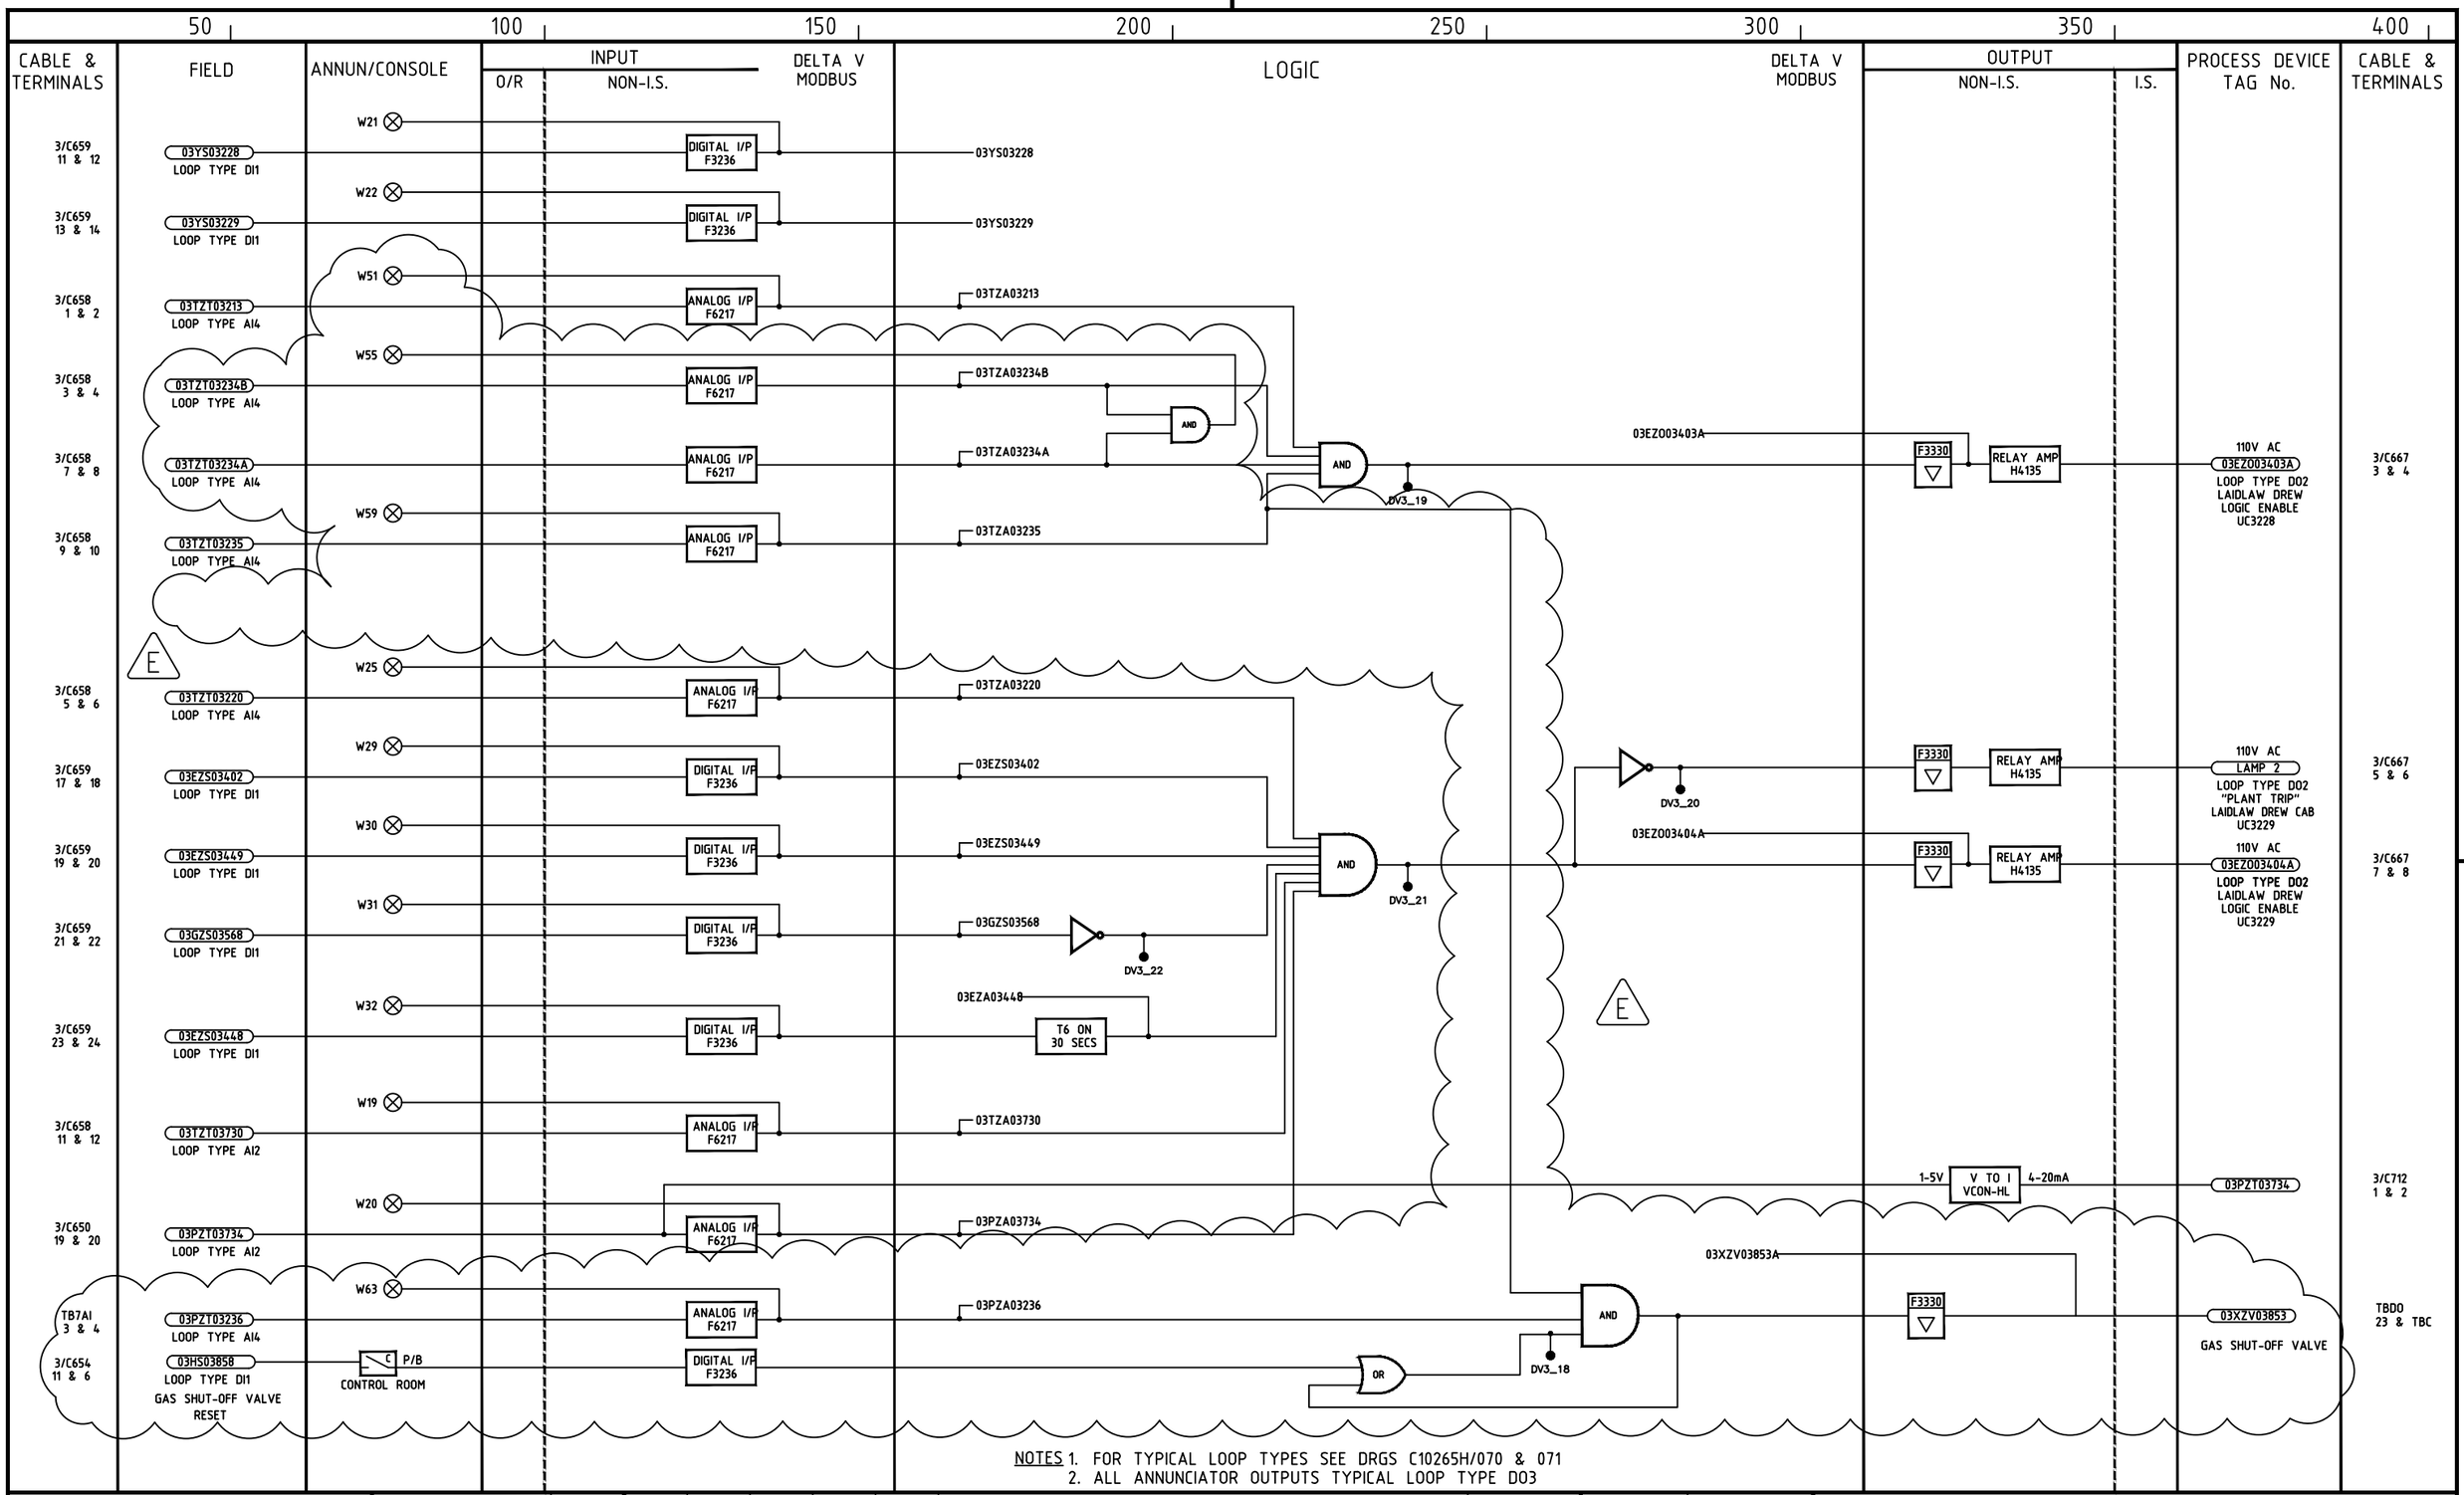

NOTES 1. FOR TYPICAL LOOP TYPES SEE DRGS C10265H/070 & 071
2. ALL ANNUNCIATOR OUTPUTS TYPICAL LOOP TYPE DO3

THIS DRAWING IS THE PROPERTY OF HIMA-SELLA LIMITED AND IS LOANED IN CONFIDENCE FOR USE WITH OUR WORK. IT IS NOT TO BE REPRODUCED IN ANY MANNER, SUBMITTED TO OUTSIDE PARTIES FOR EXAMINATION OR USED DIRECTLY OR INDIRECTLY FOR PURPOSES OTHER THAN THOSE FOR WHICH IT WAS FURNISHED WITHOUT WRITTEN CONSENT.

Scale on A3 sheet	N/A
Dimensions	N/A

Template Revision – For Office Records Only			
REV	AUTH	DATE	CAD TEMPLATE REF.
B	MB	7.4.10	A3-FRAME

DO NOT STAMP 'MASTER' UNTIL ALL WORK IS FULLY CADDED

Rev	Design	Drawn	Chkd	Appd	Description	Date
P2	NH	NH	CW	NGB	CLIENTS COMMENTS.	20.04.00
P3	NH	NH	CW	NGB	UPDATED WITH CLIENTS COMMENTS.	17.05.00
C	NH	NH	CW	NGB	AS BUILT.	06.06.00
D	MB	MB	CW	NGB	03TZT03730 & 03PZT03734 ADDED.	12.08.10
E				CT	PLANT 3 ESD CABINET MODS C10265039V	21.01.21

Designed	NH
Drawn	NH
Checked	CW
Approved	NGB
Date	21.02.00
Cad Reference	10265-P3-054

HIMA–SELLA LIMITED © HIMA-SELLA

Title : FLD - No.3 PLANT CALCINER AND DRIER
ICI SYNETIX SCHEDULE - No.3 AND No.7 PLANTS
FISHER-ROSEMOUNTP.O. No. 99003994

Contract/ Drawing No	C10265H-P3	054	REV	E

CABLE & TERMINALS	FIELD	ANNUN/CONSOLE	INPUT O/R	INPUT NON-I.S.	DELTA V MODBUS	LOGIC	DELTA V MODBUS	OUTPUT NON-I.S.	OUTPUT I.S.	PROCESS DEVICE TAG No.	CABLE & TERMINALS
	HIGH PRESSURE IN F61 03PZT03358 LOOP TYPE AI2	W76		ANALOG I/P F6217	03PZA03358						
	LOW RE-CIRC FLOW F61 03FZT03918 LOOP TYPE AI2	W 80		ANALOG I/P F6217	03FZA03918	T13 OFF 30 SEC → DV3_47					
	LOW OXYGEN FLOW 03FZT03619 LOOP TYPE AI2	W 77		ANALOG I/P F6217	03FZA03619						
	LOW RE-CIRC FLOW E15 03FZT03751 LOOP TYPE AI2	W 79		ANALOG I/P F6217	03LZA03751						
	LOW RE-CIRC FLOW E5 03FZT03749 LOOP TYPE AI2	W 78		ANALOG I/P F6217	03FZA03749						
	HIGH LEVEL IN F61 03LZT03609 LOOP TYPE AI2	W 81		ANALOG I/P F6217	03LZA0369A						
	HIGH OR LOW TEMP 03TZT03614 LOOP TYPE AI2	W 73		ANALOG I/P F6217	HIGH 03TZA0314A LOW 03TZA0314B						
	ZINC DISSOLVER SIFRESET PB 03EZS03355A LOOP TYPE DI1	W 74		DIGITAL I/P F3236							
	SHUT DOWN PB 03HZS03576 LOOP TYPE DI1			DIGITAL I/P F6236							
	LOW TEMP F61 03TZT03743 LOOP TYPE AI2	W 75		ANALOG I/P F6217	03TZA03743						
	ZINC DISSOLVER RESET PB 03EZS03355 LOOP TYPE DI1			DIGITAL I/P F3236							
	HI LEVEL IN 3F15 03LZS03700 LOOP TYPE DI1	W 82		DIGITAL I/P F3236	03LZS03700 (B)						

FROM SHT 055A (03PZA03358)

AND → DV3_35

OR → DV3_39

AND → DV3_40

OR → DV3_41

TO SHT 056

F3330 ▽ → MIXED ACID VALVE 24V DC 03XZV03591 LOOP TYPE DO2 → 3/C732 5 & 6

F3330 ▽ → F61 DUMP VALVE 24V DC 03XZV03742 LOOP TYPE DO2 → 3/C732 5 & 6

NOTES

1. FOR TYPICAL LOOP TYPES SEE DRGS C10265H/070 & 071
2. ALL ANNUNCIATOR OUTPUTS TYPICAL LOOP TYPE DO3

THIS DRAWING IS THE PROPERTY OF HIMA-SELLA LIMITED AND IS LOANED IN CONFIDENCE FOR USE WITH OUR WORK. IT IS NOT TO BE REPRODUCED IN ANY MANNER, SUBMITTED TO OUTSIDE PARTIES FOR EXAMINATION OR USED DIRECTLY OR INDIRECTLY FOR PURPOSES OTHER THAN THOSE FOR WHICH IT WAS FURNISHED WITHOUT WRITTEN CONSENT.

Scale on A3 sheet	N/A
Dimensions	N/A

Template Revision – For Office Records Only

REV	AUTH	DATE	CAD TEMPLATE REF.
A	PRS	9.2.00	A3-FRAME

DO NOT STAMP 'MASTER' UNTIL ALL WORK IS FULLY CADDED

Rev	Design	Drawn	Chkd	Appd	Description	Date
A	DP	HG	SP	CW	MODS TO 3 PLANT ESD SYSTEM AS PER C10265033V	20.03.19
B				MDI	MODS TO 3 PLANT AS PER C10265033V. POST FAT	05.04.19

Designed	DP
Drawn	WJB
Checked	RPB
Approved	CT
Date	30.05.14
Cad Reference	10265-P3-055B#NH01

HIMA–SELLA LIMITED © HIMA-SELLA

Title : FLD - No.3 PLANT ZINC DISSOLVING AREA
ICI SYNETIX ESD SYSTEM - No.3 AND No.7 PLANTS
FISHER-ROSEMOUNT - P.O. No. 99003994

Contract/ Drawing No	C10265H/P3	055B	REV	B

CABLE & TERMINALS	FIELD	ANNUN/CONSOLE	INPUT O/R	INPUT NON-I.S.	DELTA V MODBUS	LOGIC	DELTA V MODBUS	OUTPUT NON-I.S.	OUTPUT I.S.	PROCESS DEVICE TAG No.	CABLE & TERMINALS

FROM SHT 055B

HIGH LEVEL IN F62
03LZT03613
LOOP TYPE AI2
W41
ANALOG I/P F6217
03LZA03613

HIGH ACID FLOW
03FZT03618
LOOP TYPE AI2
W NEW
ANALOG I/P F6217
03FZA03618

LOW RE-CIRC FLOW E5
03FZT03748
LOOP TYPE AI2
W NEW
ANALOG I/P F6217
03FZA03748

LOW RE-CIRC FLOW E15
03FZT03750
LOOP TYPE AI2
W NEW
ANALOG I/P F6217
03FZA03750

LOW RE-CIRC FLOW F61
03FZT03647
LOOP TYPE AI2
W34
ANALOG I/P F6217
03FZA03747

LOW OXYGEN TEMP
03TZT03714
LOOP TYPE AI2
W NEW
ANALOG I/P F6217
03TZA03714

OXYGEN TRIP SIGNAL
03EZT03713
LOOP TYPE DI1
DIGITAL I/P F6236
03EZA03713 (A)

HIGH LEVEL IN 3F16
03LZS03747
LOOP TYPE DI1
W NEW
DIGITAL I/P F6236
03LZA03747

ZINC DISSOLVER TEMP
03TZT03610
LOOP TYPE AI2
ANALOG I/P F6217
HIGH 03TZA03610A
LOW 03TZA03610B

LOW OXYGEN FLOW
03FZT03752
LOOP TYPE AI2
W NEW
ANALOG I/P F6217
03FZA03752

HIGH OR LOW TEMP F61
03TZT03744
LOOP TYPE AI2
W 37
ANALOG I/P F6217
HIGH 03TZA03744A
LOW 03TZA03744B

HIGH LEVEL IN F62
03LZS03746
LOOP TYPE DI1
W NEW
ANALOG I/P F6217
03LZA03746

HIGH PRESSURE IN F61
03PZT03923
LOOP TYPE AI2
W NEW
DIGITAL I/P F6236
03PZA03923

ZINC DISSOLVER RESET PB
03EZS03355
LOOP TYPE DI1
DIGITAL I/P F3236

OR → DV3_43

AND → DV3_42

AND → DV3_44

OR → DV3_45

F3330 → MIXED ACID VALVE 24V DC
03XZV03740
LOOP TYPE DO2

F3330 → HIGH LEVEL SHUT OFF 24V DC
03XZV03915
LOOP TYPE DO2

F3330 → MIXED ACID VALVE 24V DC
03XZV03741
LOOP TYPE DO2

NOTES
1. FOR TYPICAL LOOP TYPES SEE DRGS C10265H/070 & 071
2. ALL ANNUNCIATOR OUTPUTS TYPICAL LOOP TYPE DO3

THIS DRAWING IS THE PROPERTY OF HIMA-SELLA LIMITED AND IS LOANED IN CONFIDENCE FOR USE WITH OUR WORK. IT IS NOT TO BE REPRODUCED IN ANY MANNER, SUBMITTED TO OUTSIDE PARTIES FOR EXAMINATION OR USED DIRECTLY OR INDIRECTLY FOR PURPOSES OTHER THAN THOSE FOR WHICH IT WAS FURNISHED WITHOUT WRITTEN CONSENT.

Template Revision – For Office Records Only

REV	AUTH	DATE	CAD TEMPLATE REF.
A	PRS	9.2.00	A3-FRAME

DO NOT STAMP 'MASTER' UNTIL ALL WORK IS FULLY CADDED

Scale on A3 sheet: N/A
Dimensions: N/A

Rev	Design	Drawn	Chkd	Appd	Description	Date
A				MDI	MODS TO 3 PLANT ESD SYSTEM AS PER C10265033V	20.03.19

Designed	DP
Drawn	WJB
Checked	RB
Approved	CT
Date	30.05.14
Cad Reference	10265-P3-056#NH01

HIMA–SELLA LIMITED © HIMA-SELLA

Title : FLD - No.3 PLANT ZINC DISSOLVING AREA
ICI SYNETIX ESD SYSTEM - No.3 AND No.7 PLANTS
FISHER-ROSEMOUNT - P.O. No. 99003994

Contract/ Drawing No: C10265H/P3 | 056A | REV | A

50 | 100 | 150 | 200 | 250 | 300 | 350 | 400

CABLE & TERMINALS	FIELD	ANNUN/CONSOLE	INPUT O/R	INPUT NON-I.S.	DELTA V MODBUS	LOGIC	DELTA V MODBUS	OUTPUT NON-I.S.	OUTPUT I.S.	PROCESS DEVICE TAG No.	CABLE & TERMINALS
7/C302 1 & 2	07EZO07300 LOOP TYPE DI1	E		DIGITAL I/P F3236							
7/C300 1 & 2	07TZT07044 LOOP TYPE AI4	W02		ANALOG I/P F6217	07TZA07044A 07TZA07044B	HIGH EXTRA HIGH AND DV7_1	07TZO07044 AND DV7_3	F3330 RELAY AMP H4135		110V AC 07TZO07044 BMS ENABLE LOOP TYPE DO2	7/C306 1 & 2
7/C300 3 & 4	07TZT07048 LOOP TYPE AI4	W01		ANALOG I/P F6217	07TZA07048A 07TZA07048B	HIGH EXTRA HIGH AND DV7_2	07TZO07048	F3330 RELAY AMP H4135		110V AC 07TZO07048 BMS TRIP LOOP TYPE DO2	7/C306 3 & 4
7/C301 1 & 2	07BZS07200 LOOP TYPE DI1	W03		DIGITAL I/P F3236	07BZS07200						
7/C301 3 & 4	07PZS07022 LOOP TYPE DI1	W04		DIGITAL I/P F3236	07PZS07022						
7/C301 5 & 6	07PZS07023 LOOP TYPE DI1	W05		DIGITAL I/P F3236	07PZS07023						
7/C301 7 & 8	07PZS07024 LOOP TYPE DI1	W06		DIGITAL I/P F3236	07PZS07024						

NOTES

1. FOR TYPICAL LOOP TYPES SEE DRGS C10265H/070 & 071
2. ALL ANNUNCIATOR OUTPUTS TYPICAL LOOP TYPE DO3

THIS DRAWING IS THE PROPERTY OF HIMA-SELLA LIMITED AND IS LOANED IN CONFIDENCE FOR USE WITH OUR WORK. IT IS NOT TO BE REPRODUCED IN ANY MANNER, SUBMITTED TO OUTSIDE PARTIES FOR EXAMINATION OR USED DIRECTLY OR INDIRECTLY FOR PURPOSES OTHER THAN THOSE FOR WHICH IT WAS FURNISHED WITHOUT WRITTEN CONSENT.

Scale on A3 sheet	N/A
Dimensions	N/A

Template Revision – For Office Records Only

REV	AUTH	DATE	CAD TEMPLATE REF.
A	PRS	9.2.00	A3-FRAME

DO NOT STAMP 'MASTER' UNTIL ALL WORK IS FULLY CADDED

Rev	Design	Drawn	Chkd	Appd	Description	Date
P2	NH	NH	CW	NGB	CLIENTS COMMENTS.	20.04.00
P3	NH	NH	CW	NGB	UPDATED WITH CLIENTS COMMENTS.	17.05.00
C	NH	NH	CW	NGB	AS BUILT.	06.06.00
D	DP	HG	SP	CW	MODS TO 3 PLANT ESD SYSTEM AS PER C10265033V	26.03.19
E				MDI	MODS TO 3 PLANT AS PER C10265033V - POST FAT	05.04.19

Designed	NH
Drawn	NH
Checked	CW
Approved	NGB
Date	09.03.00
Cad Reference	10265-P3-057#NH01

HIMA–SELLA LIMITED © HIMA-SELLA

Title : FLD - No.7 PLANT
ICI SYNETIX ESD SYSTEM - No.3 AND No.7 PLANTS
FISHER-ROSEMOUNT - P.O. No. 99003994

Contract/ Drawing No	C10265H/P3	057	REV	E

50 100 150 200 250 300 350 400

TESTABLE DIGITAL NON I.S. OUTPUT - VFC VIA RELAY DO1

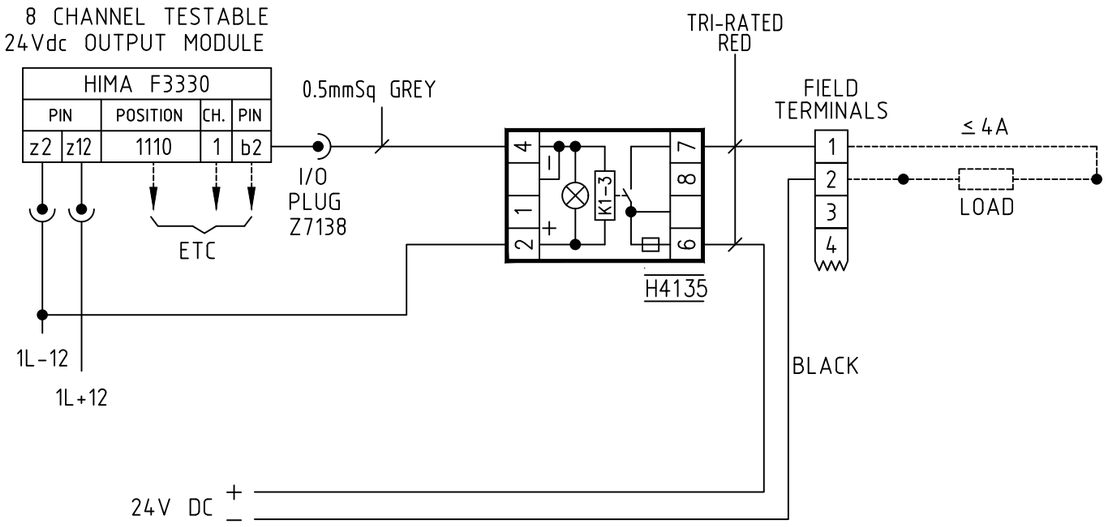

TESTABLE DIGITAL NON I.S. OUTPUT - VFC VIA RELAY DO2

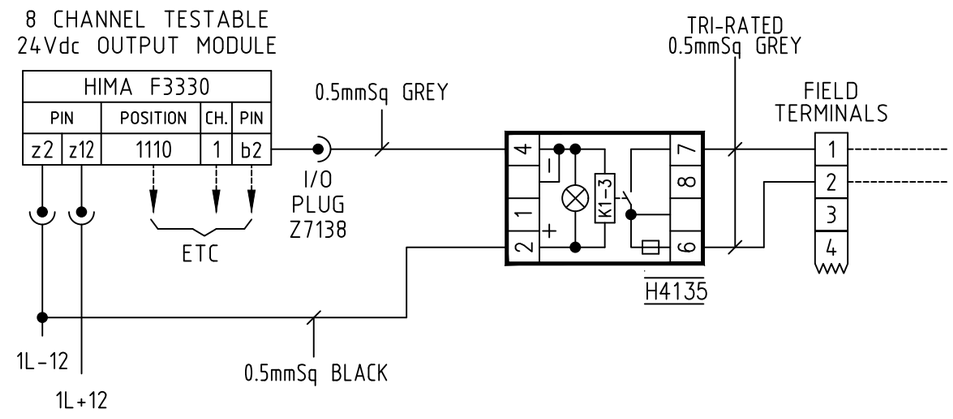

NON TESTABLE DIGITAL OUTPUT DO3

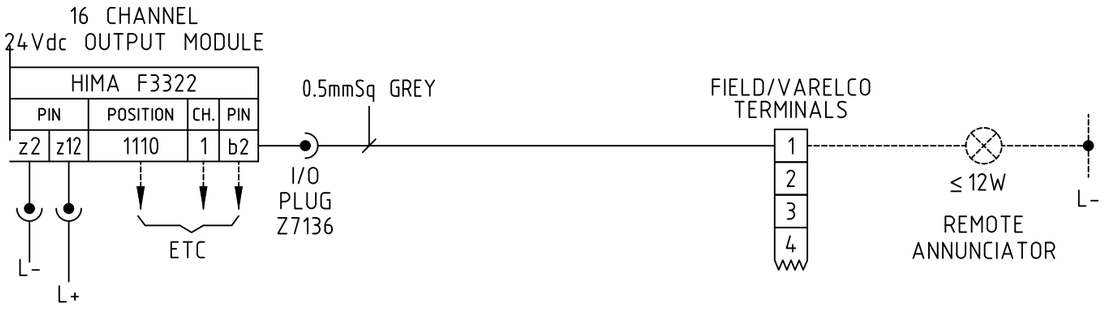

NON TESTABLE DIGITAL OUTPUT DO4

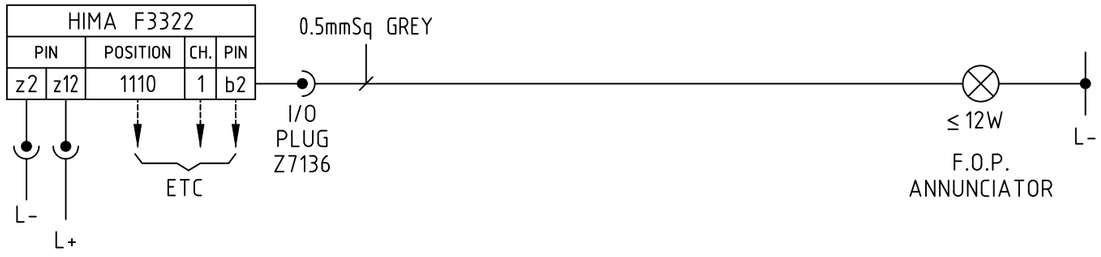

NOTES

1) REFER TO WIRING DETAILS FOR SPECIFIC LOOP INFORMATION, CHANNEL, POSITION, PIN.
2) 50Vac SUPPLY FOR SOLENOID VALVES OUTPUTS IN ESD SYSTEM BY OTHERS
3) L- FOR REMOTE AND FRONT OF PANEL ANNUNCIATORS IS DERIVED FROM THE 24Vdc SUPPLY. VIA 2 CORE CABLES (PLANT 3, 4 BY HSL PLANT 7 BY OTHERS)

THIS DRAWING IS THE PROPERTY OF HIMA-SELLA LIMITED AND IS LOANED IN CONFIDENCE FOR USE WITH OUR WORK. IT IS NOT TO BE REPRODUCED IN ANY MANNER, SUBMITTED TO OUTSIDE PARTIES FOR EXAMINATION OR USED DIRECTLY OR INDIRECTLY FOR PURPOSES OTHER THAN THOSE FOR WHICH IT WAS FURNISHED WITHOUT WRITTEN CONSENT.

Template Revision – For Office Records Only

REV	AUTH	DATE	CAD TEMPLATE REF.
B	MB	7.4.10	A3-FRAME

Scale on A3 sheet	N/A
Dimensions	N/A

DO NOT STAMP 'MASTER' UNTIL ALL WORK IS FULLY CADDED

Rev	Design	Drawn	Chkd	Appd	Description	Date
C	NH	NH	CW	NGB	AS BUILT.	06.06.00
.					. . .	. .

Designed	NH
Drawn	NH
Checked	CW
Approved	NGB
Date	23.03.00
Cad Reference	10265-P3-071

HIMA–SELLA LIMITED © HIMA-SELLA

Title : TYPICAL LOOP DRAWING - OUTPUTS
ICI SYNETIX SCHEDULE - No.3 AND No.7 PLANTS
FISHER-ROSEMOUNTP.O. No. 99003994

Contract/ Drawing No	C10265H-P3	071	REV	C

50 100 150 200 250 300 350 400

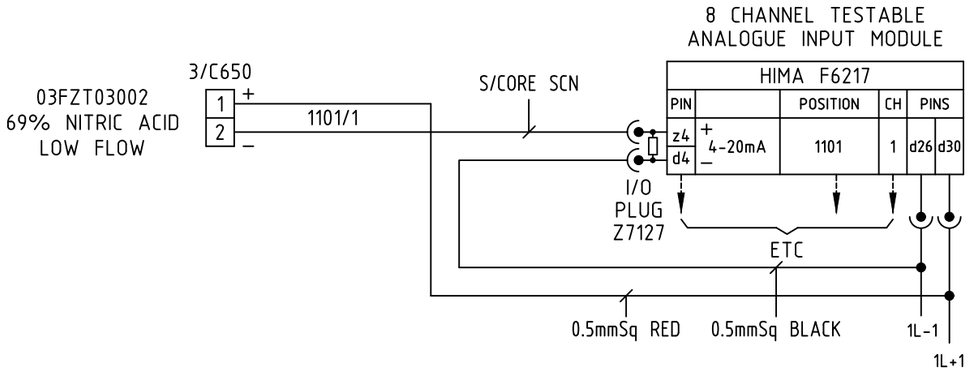

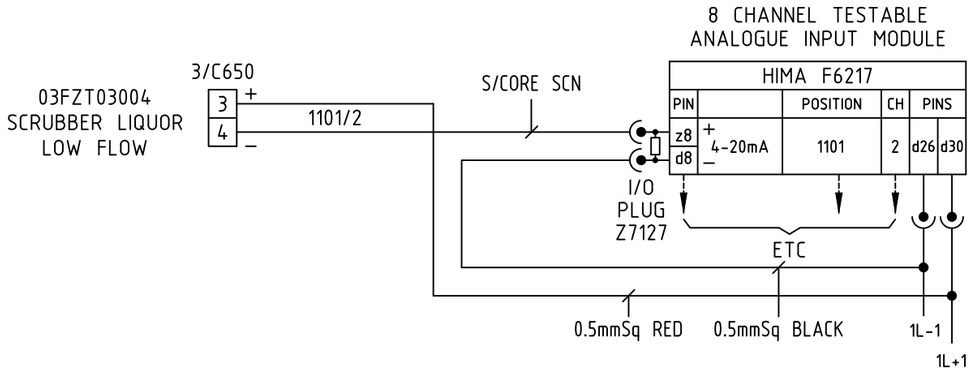

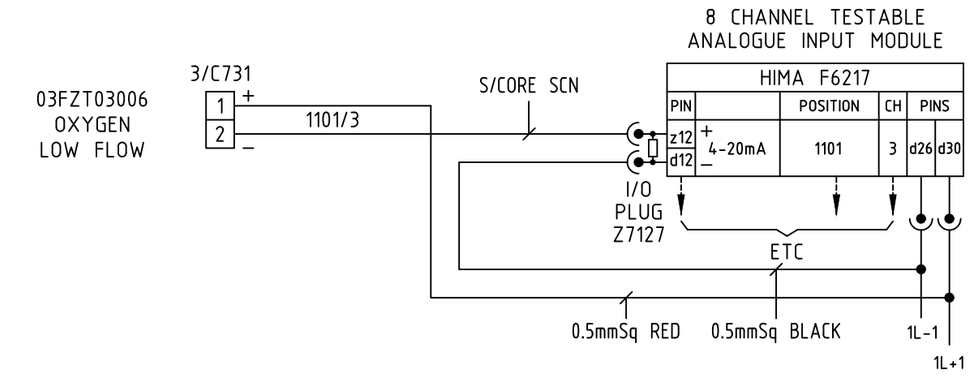

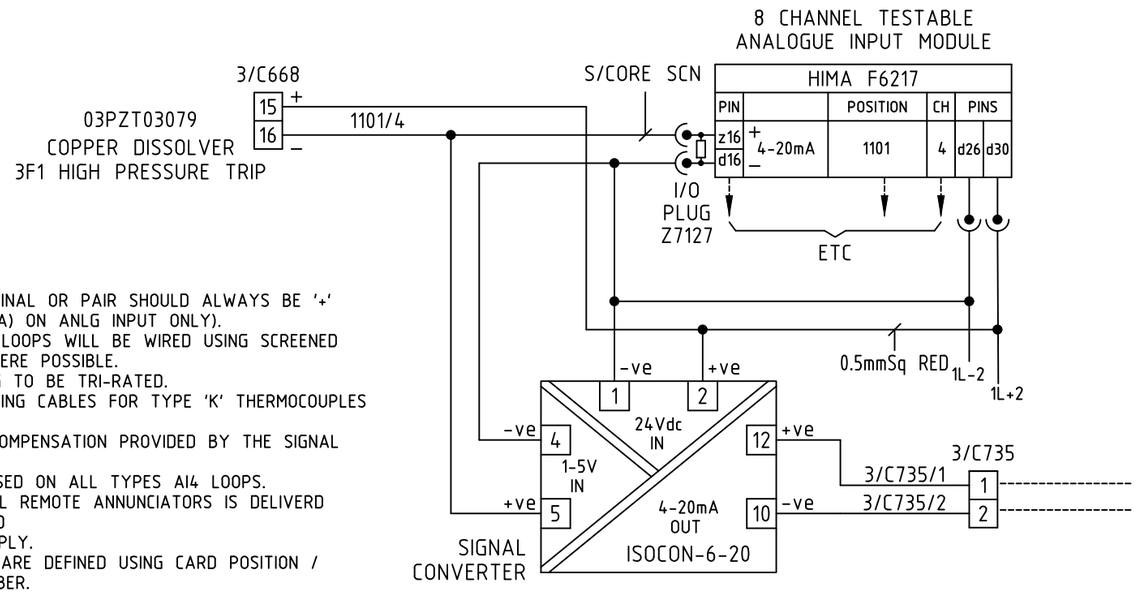

NOTES
1. FIRST TERMINAL OR PAIR SHOULD ALWAYS BE '+' (ASK1 (50mA) ON ANLG INPUT ONLY).
2. ANALOGUE LOOPS WILL BE WIRED USING SCREENED CABLES WHERE POSSIBLE.
3. ALL WIRING TO BE TRI-RATED.
4. COMPENSATING CABLES FOR TYPE 'K' THERMOCOUPLES WITH COLD JUNCTION COMPENSATION PROVIDED BY THE SIGNAL CONVERTER WILL BE USED ON ALL TYPES AI4 LOOPS.
5. L- FOR ALL REMOTE ANNUNCIATORS IS DELIVERD FROM THE ESD 24VDC SUPPLY.
6. WIRE No.s ARE DEFINED USING CARD POSITION / CHANNEL NUMBER.

THIS DRAWING IS THE PROPERTY OF HIMA-SELLA LIMITED AND IS LOANED IN CONFIDENCE FOR USE WITH OUR WORK. IT IS NOT TO BE REPRODUCED IN ANY MANNER, SUBMITTED TO OUTSIDE PARTIES FOR EXAMINATION OR USED DIRECTLY OR INDIRECTLY FOR PURPOSES OTHER THAN THOSE FOR WHICH IT WAS FURNISHED WITHOUT WRITTEN CONSENT.

Template Revision – For Office Records Only

REV	AUTH	DATE	CAD TEMPLATE REF.
B	MB	7.4.10	A3-FRAME

Scale on A3 sheet	N/A
Dimensions	N/A

DO NOT STAMP 'MASTER' UNTIL ALL WORK IS FULLY CADDED

Rev	Design	Drawn	Chkd	Appd	Description	Date
C	NA	NA	CW	NGB	AS BUILT.	06.06.00
D	IM	AB	IM	MRS	TEXT ADDED	11.08.11
E					TEXT CORRECTED	10.10.11

Designed	NH
Drawn	NH
Checked	CW
Approved	NGB
Date	28.03.00
Cad Reference	10265-P3-075

HIMA–SELLA LIMITED © HIMA-SELLA

Title : LOOP DRAWING - INPUTS
ICI SYNETIX SCHEDULE - No.3 AND No.7 PLANTS
FISHER-ROSEMOUNTP.O. No. 99003994

Contract/ Drawing No	C10265H-P3	075	REV	E

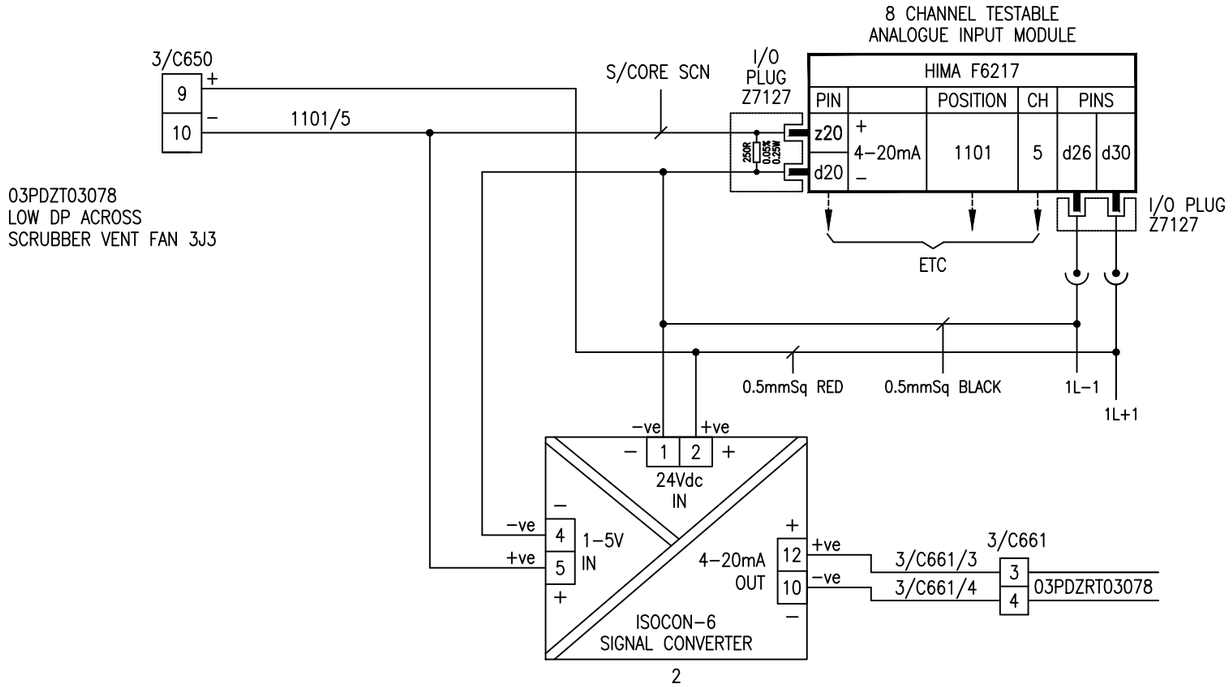

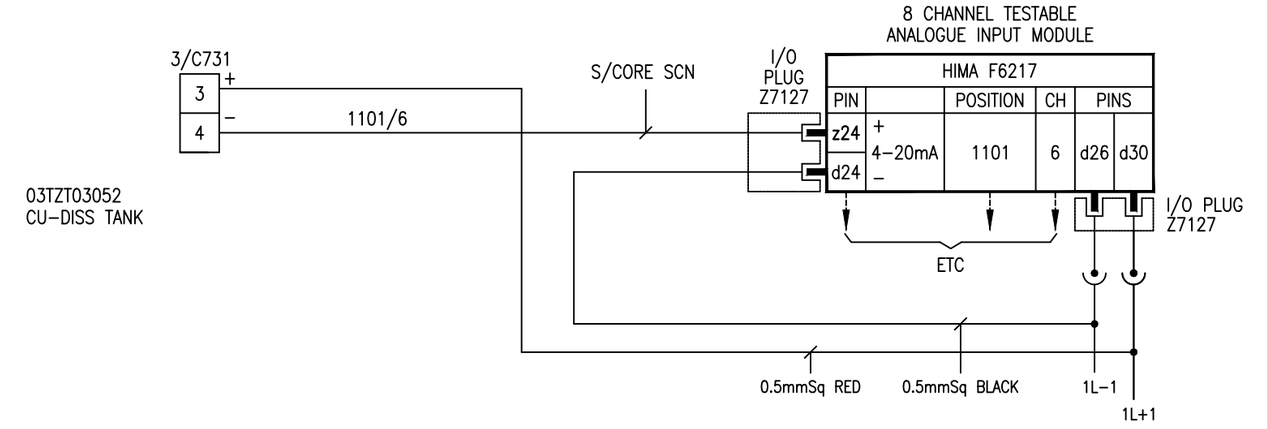

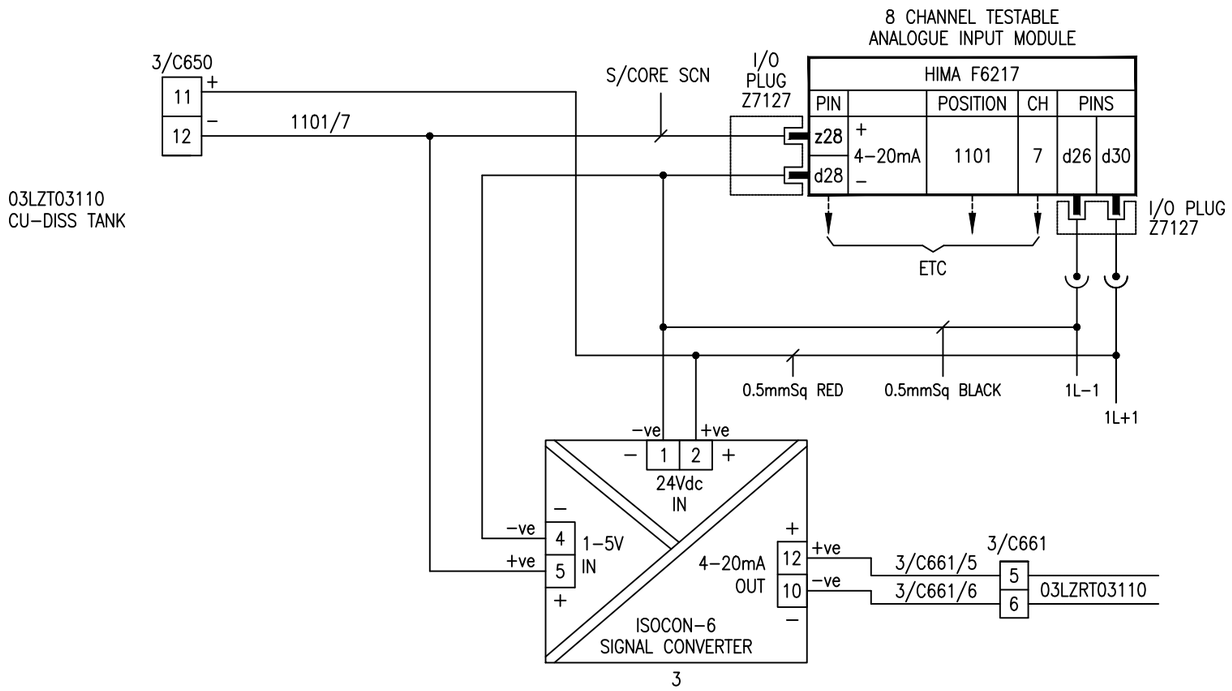

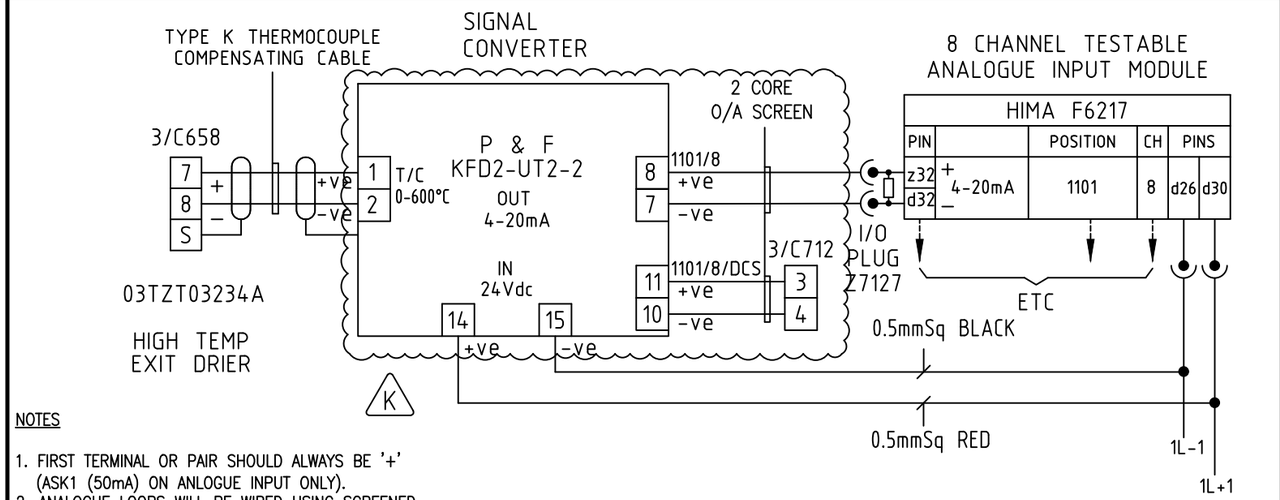

NOTES

1. FIRST TERMINAL OR PAIR SHOULD ALWAYS BE '+' (ASK1 (50mA) ON ANLOGUE INPUT ONLY).
2. ANALOGUE LOOPS WILL BE WIRED USING SCREENED CABLES WHERE POSSIBLE.
3. ALL WIRING TO BE TRI−RATED.
4. COMPENSATING CABLES FOR TYPE 'K' THERMOCOUPLES WITH COLD JUNCTION. COMPENSATION PROVIDED BY THE SIGNAL CONVERTER WILL BE USED ON ALL TYPES AI4 LOOPS.
5. L− FOR ALL REMOTE ANNUNCIATORS IS DELIVERED FROM THE ESD 24VDC SUPPLY.
6. WIRE No.s ARE DEFINED USING CARD POSITION / CHANNEL NUMBER.

THIS DRAWING IS THE PROPERTY OF HIMA-SELLA LIMITED AND IS LOANED IN CONFIDENCE FOR USE WITH OUR WORK. IT IS NOT TO BE REPRODUCED IN ANY MANNER, SUBMITTED TO OUTSIDE PARTIES FOR EXAMINATION OR USED DIRECTLY OR INDIRECTLY FOR PURPOSES OTHER THAN THOSE FOR WHICH IT WAS FURNISHED WITHOUT WRITTEN CONSENT.

Template Revision – For Office Records Only			
REV	AUTH	DATE	CAD TEMPLATE REF.
B	MB	7.4.10	A3-FRAME

Scale on A3 sheet	N/A
Dimensions	N/A

DO NOT STAMP 'MASTER' UNTIL ALL WORK IS FULLY CADDED

Rev	Design	Drawn	Chkd	Appd	Description	Date
C	NA	NA	CW	NGB	AS BUILT.	06.06.00
D	IM	AB	IM	NGB	TEXT ADDED	11.08.11
E	IM	AB	AD	MRS	TEXT CORRECTED	10.10.11
F	CJG	CJG	AD	CT	ZINC DISSOLVER PHR & MMN IMPROVEMENTS	20.02.14
G	DP	DB	EEM	CT	PLANT 3 ESD CABINET MODS C10265039V	29.01.21
H	DP	DB	JP	CT	PLANT 3 ESD CABINET MODS C10265039V	18.03.21
J	DP	AL	AD	CT	AS BUILT C10265039V	18.03.21
K				DP	C10265049V MODIFICATIONS	02.10.24

Designed	NH
Drawn	NH
Checked	CW
Approved	NGB
Date	28.03.00
Cad Reference	10265-P3-076

HIMA−SELLA LIMITED © HIMA-SELLA

Title : LOOP DRAWING - INPUTS
ICI SYNETIX SCHEDULE - No.3 AND No.7 PLANTS
FISHER-ROSEMOUNTP.O. No. 99003994

Contract/ Drawing No	C10265H-P3	076	REV	K

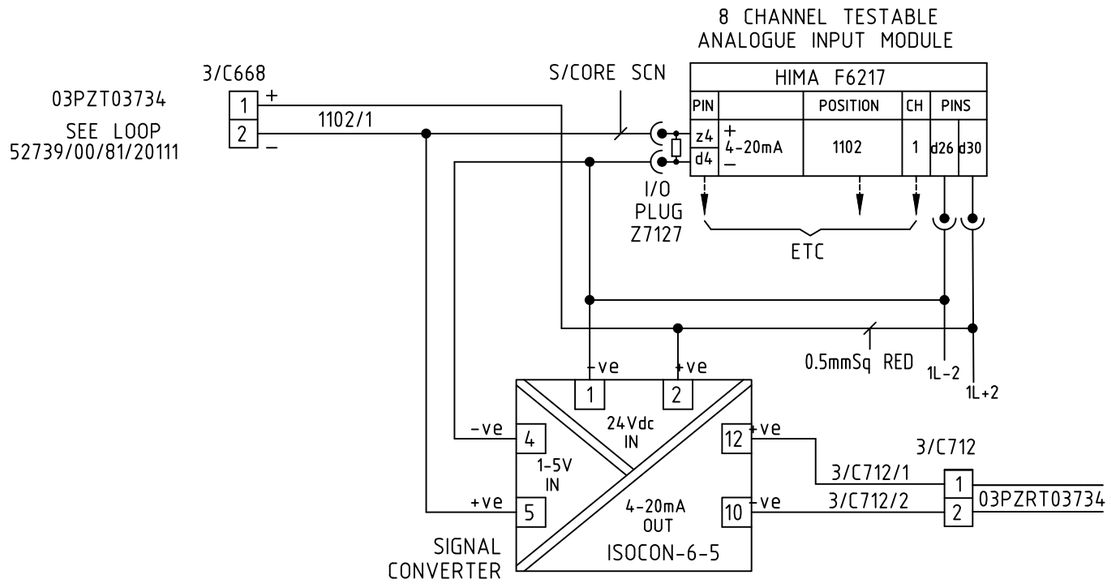

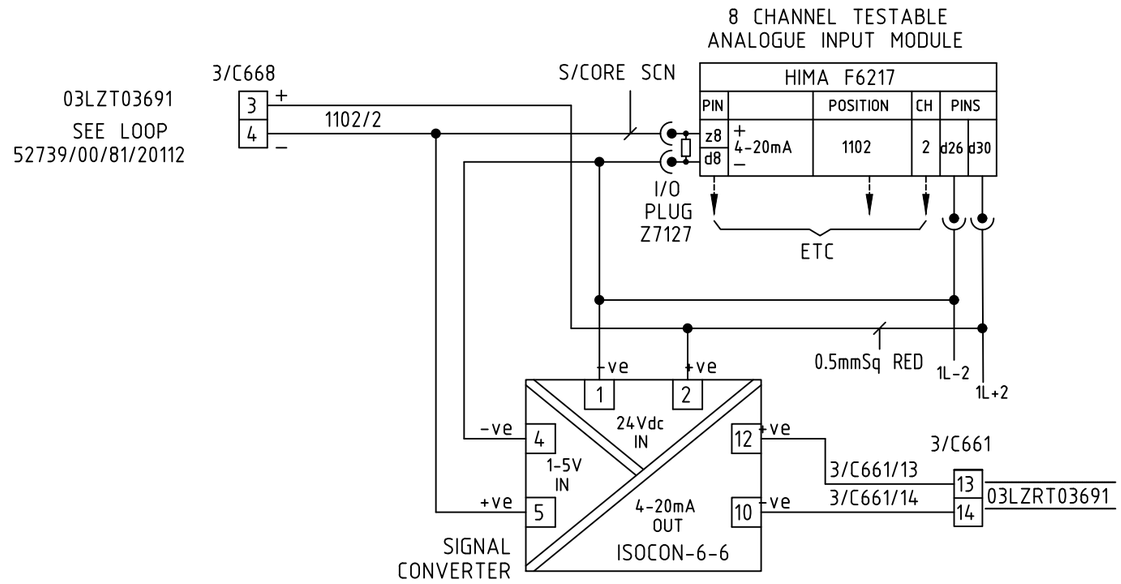

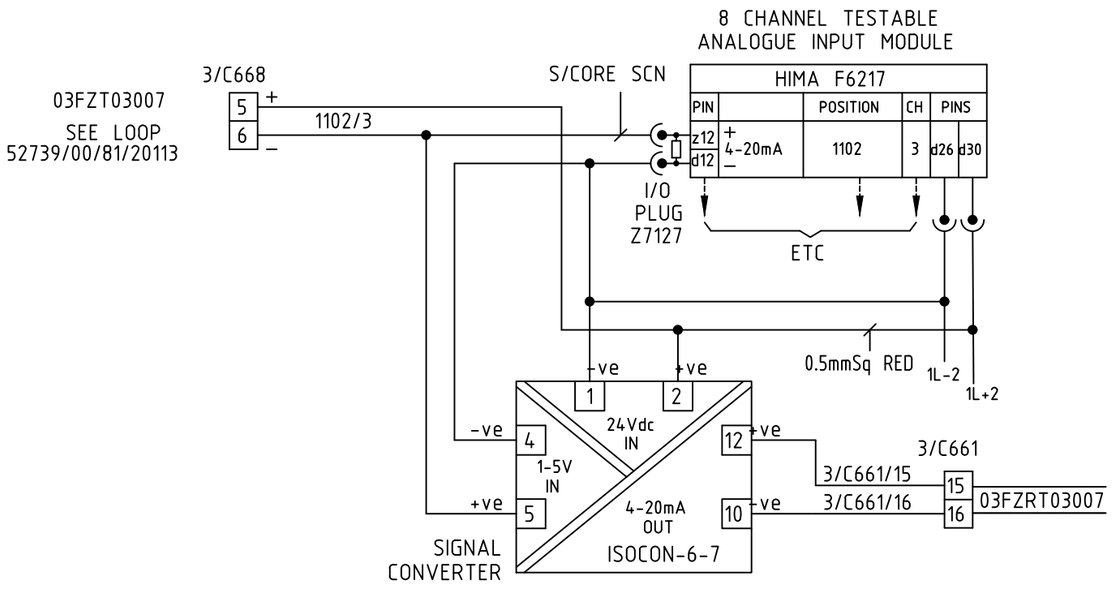

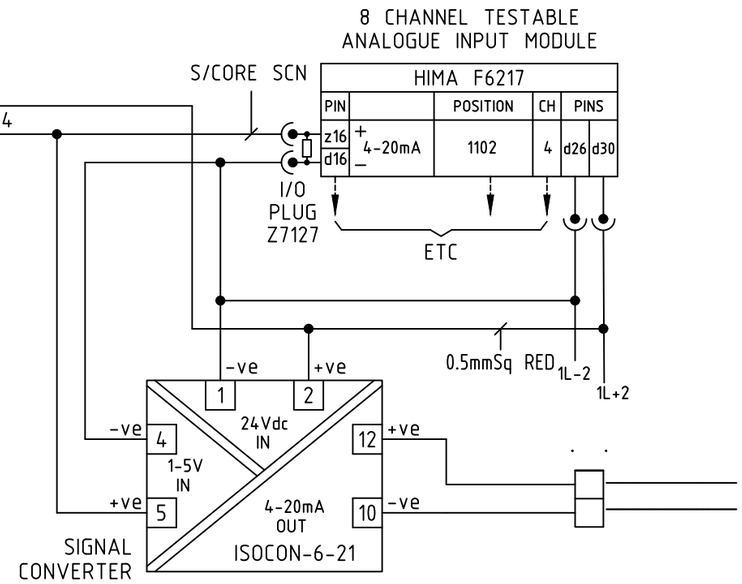

NOTES
1. FIRST TERMINAL OR PAIR SHOULD ALWAYS BE '+'
   (ASK1 (50mA) ON ANLG INPUT ONLY).
2. ANALOGUE LOOPS WILL BE WIRED USING SCREENED
   CABLES WHERE POSSIBLE.
3. ALL WIRING TO BE TRI-RATED.
4. COMPENSATING CABLES FOR TYPE 'K' THERMOCOUPLES WITH COLD
   JUNCTION COMPENSATION PROVIDED BY THE SIGNAL CONVERTER
   WILL BE USED ON ALL TYPES AI4 LOOPS.
5. L- FOR ALL REMOTE ANNUNCIATORS IS DELIVERD FROM THE ESD
   24VDC SUPPLY.
6. WIRE No.s ARE DEFINED USING CARD POSITION / CHANNEL NUMBER.

THIS DRAWING IS THE PROPERTY OF HIMA-SELLA LIMITED AND IS LOANED IN CONFIDENCE FOR USE WITH OUR WORK. IT IS NOT TO BE REPRODUCED IN ANY MANNER, SUBMITTED TO OUTSIDE PARTIES FOR EXAMINATION OR USED DIRECTLY OR INDIRECTLY FOR PURPOSES OTHER THAN THOSE FOR WHICH IT WAS FURNISHED WITHOUT WRITTEN CONSENT.

Scale on A3 sheet	N/A
Dimensions	N/A

Template Revision – For Office Records Only

REV	AUTH	DATE	CAD TEMPLATE REF.
B	MB	7.4.10	A3-FRAME

DO NOT STAMP 'MASTER' UNTIL ALL WORK IS FULLY CADDED

Rev	Design	Drawn	Chkd	Appd	Description	Date
C	NA	NA	CW	NGB	AS BUILT.	06.06.00
D					NEW INPUTS ADDED.	07.08.09
E	IM		IM		SITE MODS	11.08.11

Designed	NH
Drawn	NH
Checked	CW
Approved	NGB
Date	28.03.00
Cad Reference	10265-P3-077

HIMA–SELLA LIMITED © HIMA-SELLA

Title : LOOP DRAWING - INPUTS
ICI SYNETIX SCHEDULE - No.3 AND No.7 PLANTS
FISHER-ROSEMOUNTP.O. No. 99003994

Contract/ Drawing No	C10265H-P3	077	REV	E

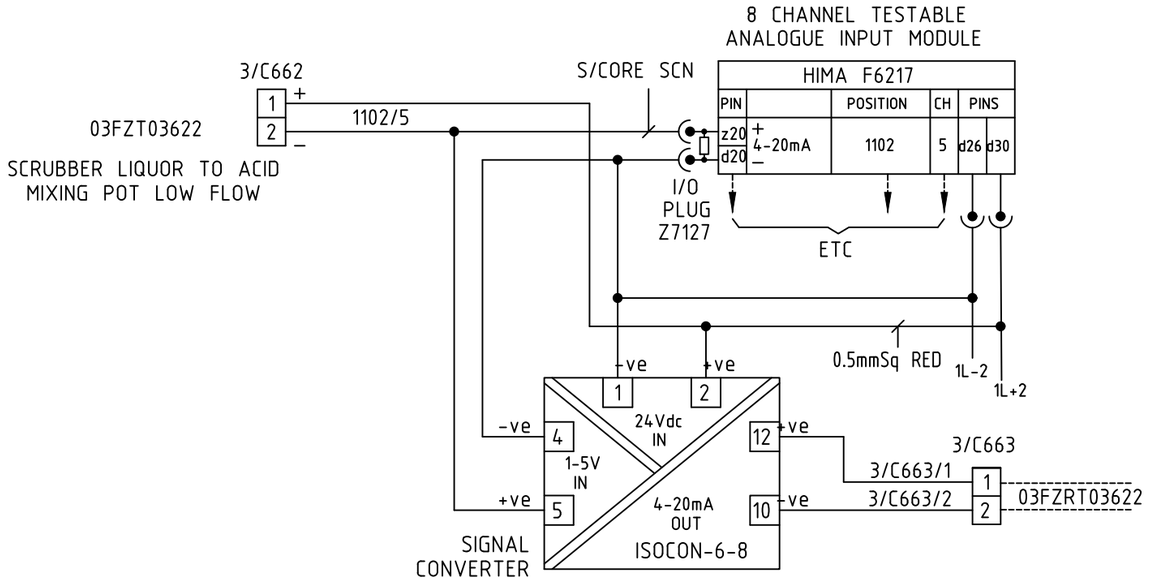

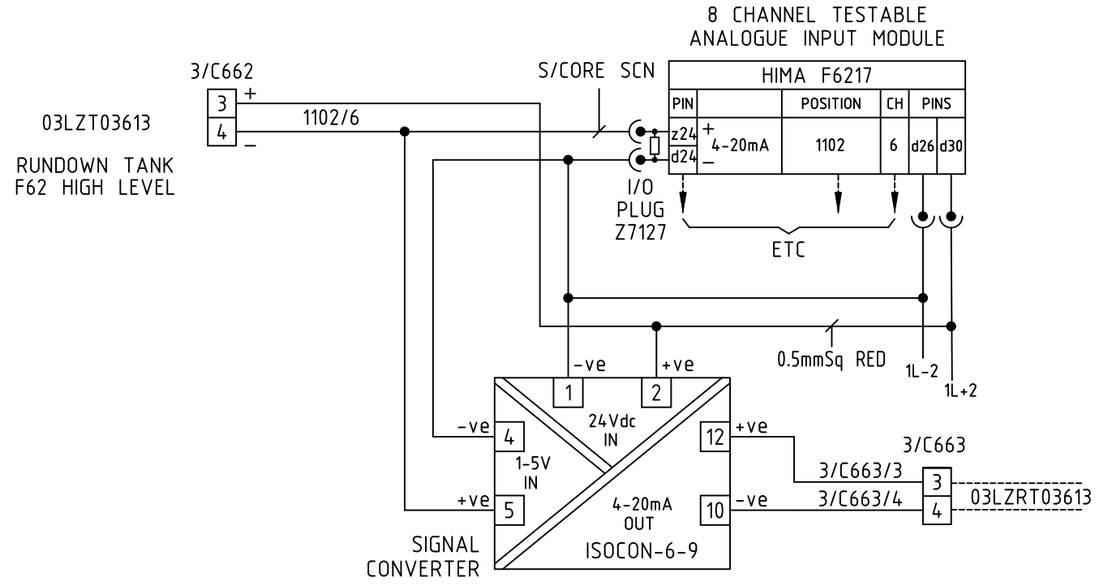

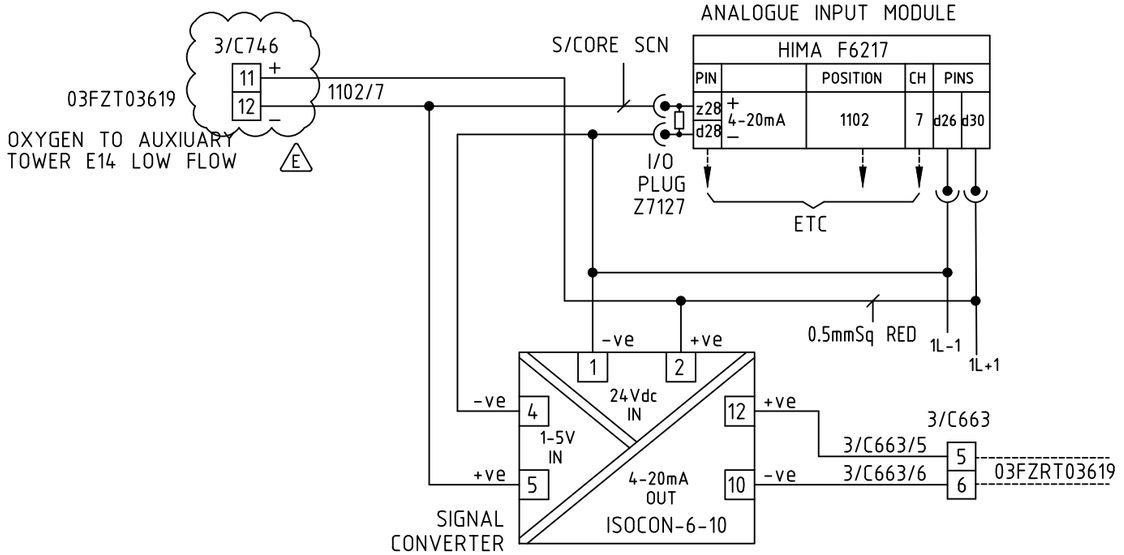

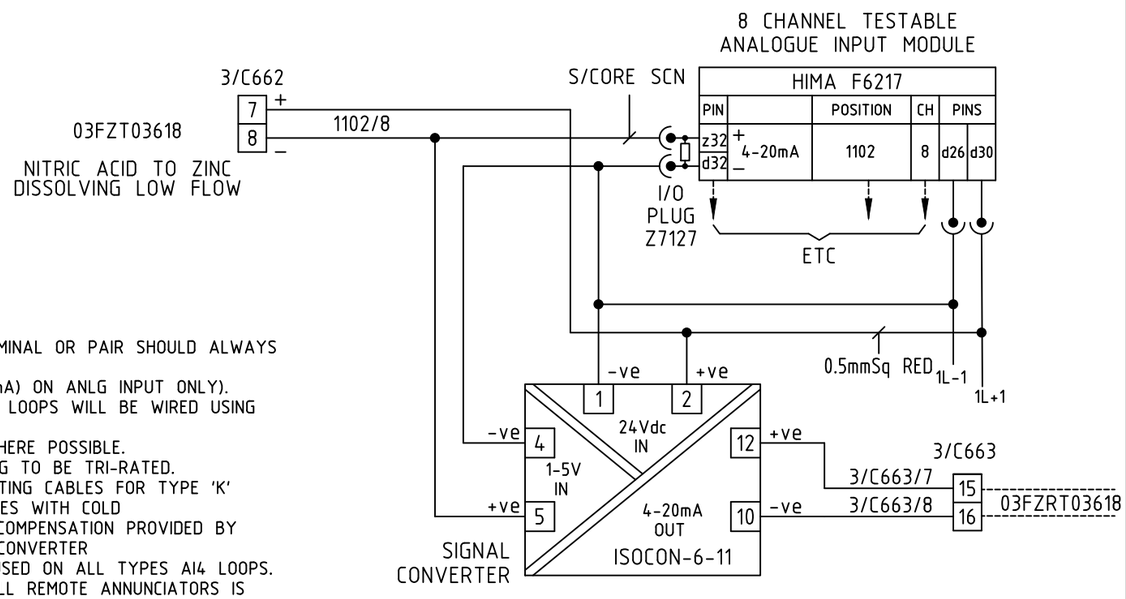

NOTES
1. FIRST TERMINAL OR PAIR SHOULD ALWAYS BE '+'
   (ASK1 (50mA) ON ANLG INPUT ONLY).
2. ANALOGUE LOOPS WILL BE WIRED USING SCREENED
   CABLES WHERE POSSIBLE.
3. ALL WIRING TO BE TRI-RATED.
4. COMPENSATING CABLES FOR TYPE 'K' THERMOCOUPLES WITH COLD
   JUNCTION COMPENSATION PROVIDED BY THE SIGNAL CONVERTER
   WILL BE USED ON ALL TYPES AI4 LOOPS.
5. L- FOR ALL REMOTE ANNUNCIATORS IS DELIVERD FROM THE ESD
   24VDC SUPPLY.
6. WIRE No.s ARE DEFINED USING CARD POSITION / CHANNEL NUMBER.

THIS DRAWING IS THE PROPERTY OF HIMA-SELLA LIMITED AND IS LOANED IN CONFIDENCE FOR USE WITH OUR WORK. IT IS NOT TO BE REPRODUCED IN ANY MANNER, SUBMITTED TO OUTSIDE PARTIES FOR EXAMINATION OR USED DIRECTLY OR INDIRECTLY FOR PURPOSES OTHER THAN THOSE FOR WHICH IT WAS FURNISHED WITHOUT WRITTEN CONSENT.

Template Revision – For Office Records Only

REV	AUTH	DATE	CAD TEMPLATE REF.
B	MB	7.4.10	A3-FRAME

Scale on A3 sheet	N/A
Dimensions	N/A

DO NOT STAMP 'MASTER' UNTIL ALL WORK IS FULLY CADDED

Rev	Design	Drawn	Chkd	Appd	Description	Date
C	NA	NA	CW	NGB	AS BUILT.	06.06.00
D	IM	AB	IM	MRS	SITE MODS	11.08.11
E	..	..	.	CT	ZINC DISSOLVER PHR & MMN IMPROVEMENTS	30.05.14

Designed	NH
Drawn	NH
Checked	CW
Approved	NGB
Date	28.03.00
Cad Reference	10265-P3-078

HIMA–SELLA LIMITED © HIMA-SELLA

Title : LOOP DRAWING - INPUTS
ICI SYNETIX SCHEDULE - No.3 AND No.7 PLANTS
FISHER-ROSEMOUNTP.O. No. 99003994

Contract/ Drawing No	C10265H-P3	078	REV	E

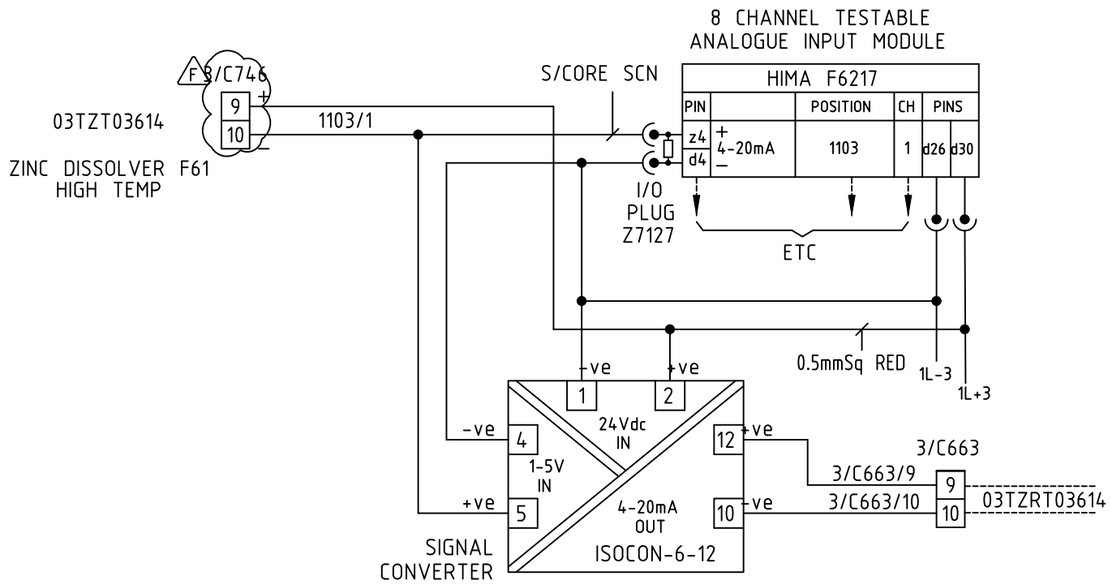

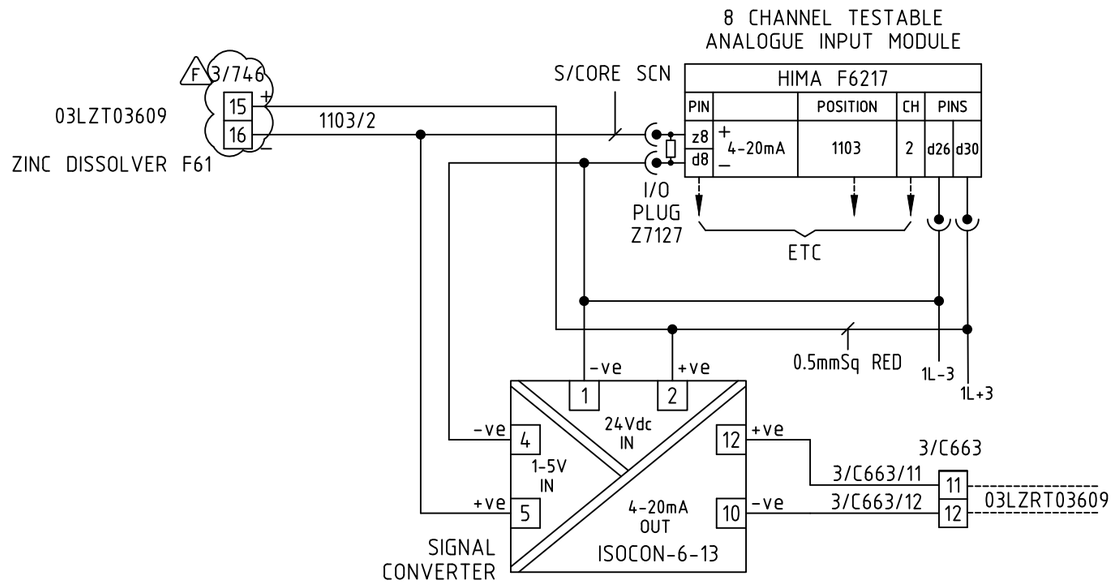

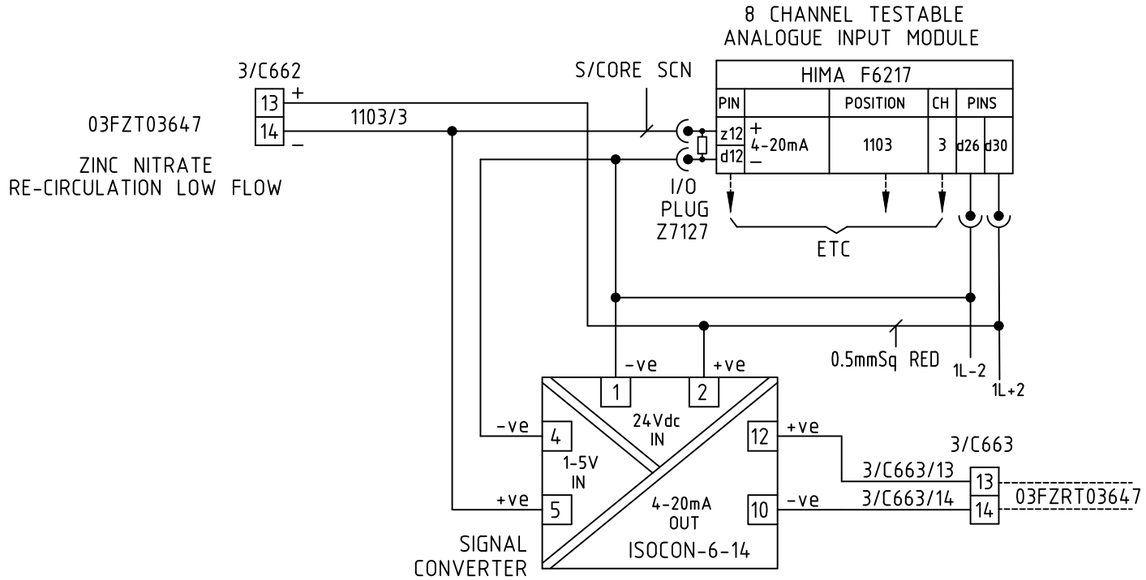

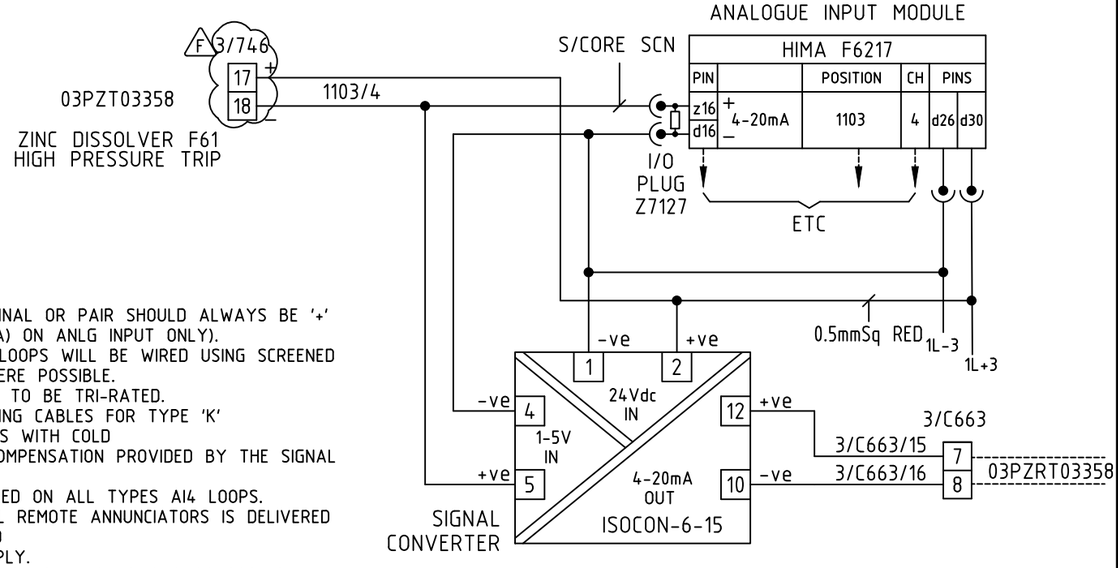

NOTES
1. FIRST TERMINAL OR PAIR SHOULD ALWAYS BE '+' (ASK1 (50mA) ON ANLG INPUT ONLY).
2. ANALOGUE LOOPS WILL BE WIRED USING SCREENED CABLES WHERE POSSIBLE.
3. ALL WIRING TO BE TRI-RATED.
4. COMPENSATING CABLES FOR TYPE 'K' THERMOCOUPLES WITH COLD JUNCTION COMPENSATION PROVIDED BY THE SIGNAL CONVERTER WILL BE USED ON ALL TYPES AI4 LOOPS.
5. L- FOR ALL REMOTE ANNUNCIATORS IS DELIVERED FROM THE ESD 24VDC SUPPLY.
6. WIRE No.s ARE DEFINED USING CARD POSITION / CHANNEL NUMBER.

THIS DRAWING IS THE PROPERTY OF HIMA-SELLA LIMITED AND IS LOANED IN CONFIDENCE FOR USE WITH OUR WORK. IT IS NOT TO BE REPRODUCED IN ANY MANNER, SUBMITTED TO OUTSIDE PARTIES FOR EXAMINATION OR USED DIRECTLY OR INDIRECTLY FOR PURPOSES OTHER THAN THOSE FOR WHICH IT WAS FURNISHED WITHOUT WRITTEN CONSENT.

Template Revision – For Office Records Only			
REV	AUTH	DATE	CAD TEMPLATE REF.
B	MB	7.4.10	A3-FRAME

Scale on A3 sheet	N/A
Dimensions	N/A

DO NOT STAMP 'MASTER' UNTIL ALL WORK IS FULLY CADDED

Rev	Design	Drawn	Chkd	Appd	Description	Date
C	NA	NA	CW	NGB	AS BUILT.	06.06.00
D	IM	AB	IM	MRS	TEXT CHANGES	11.08.11
E	IM	AB	IM	MRS	TEXT CORRECTED	10.10.11
F	.	.	.	CT	ZINC DISSOLVER PHR & MMN IMPROVEMENTS	30.05.14

Designed	NH
Drawn	NH
Checked	CW
Approved	NGB
Date	28.03.00
Cad Reference	10265-P3-079

HIMA–SELLA LIMITED © HIMA-SELLA

Title : LOOP DRAWING - INPUTS
ICI SYNETIX SCHEDULE - No.3 AND No.7 PLANTS
FISHER-ROSEMOUNTP.O. No. 99003994

Contract/ Drawing No	C10265H-P3	079	REV	F

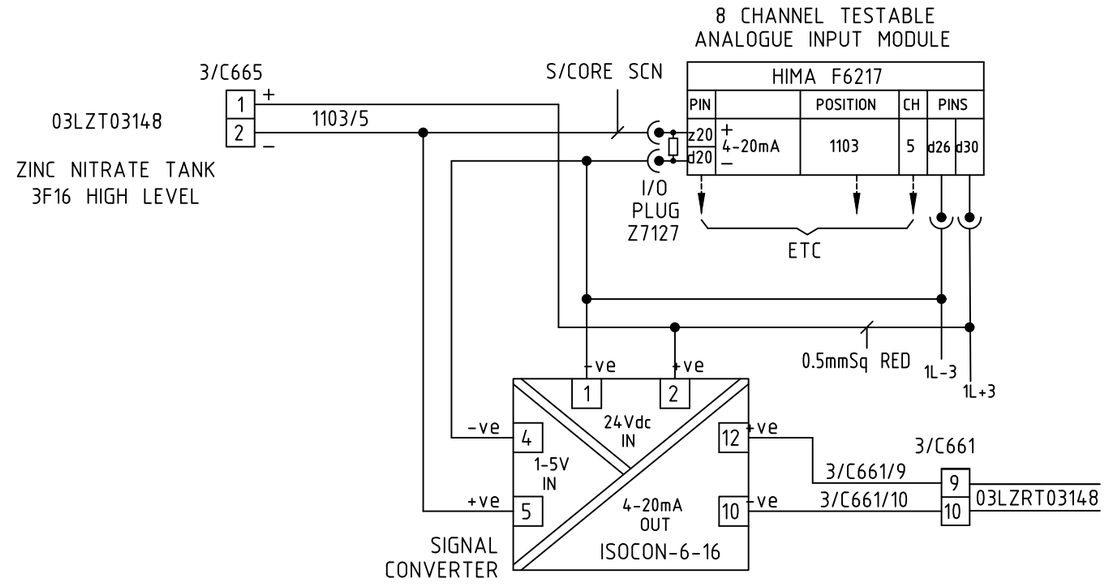

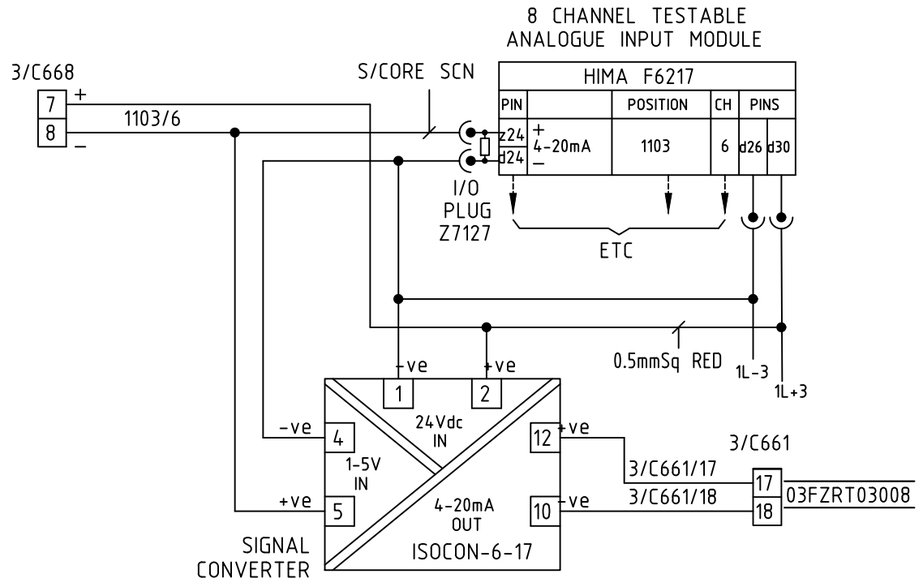

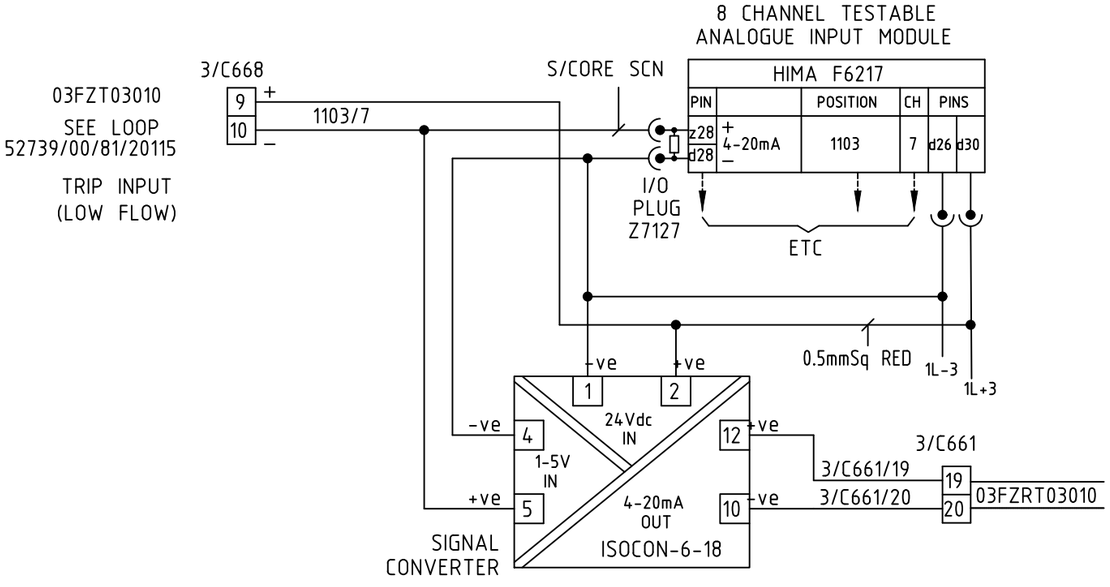

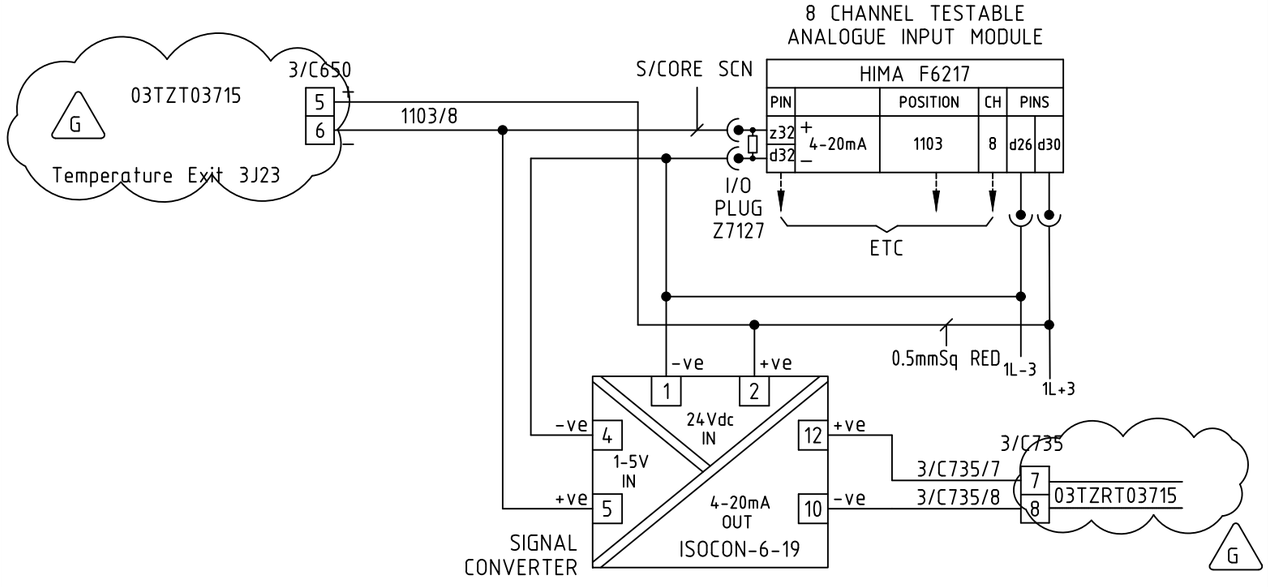

THIS DRAWING IS THE PROPERTY OF HIMA-SELLA LIMITED AND IS LOANED IN CONFIDENCE FOR USE WITH OUR WORK. IT IS NOT TO BE REPRODUCED IN ANY MANNER, SUBMITTED TO OUTSIDE PARTIES FOR EXAMINATION OR USED DIRECTLY OR INDIRECTLY FOR PURPOSES OTHER THAN THOSE FOR WHICH IT WAS FURNISHED WITHOUT WRITTEN CONSENT.

Scale on A3 sheet	N/A
Dimensions	N/A

Template Revision – For Office Records Only			
REV	AUTH	DATE	CAD TEMPLATE REF.
B	MB	7.4.10	A3-FRAME

DO NOT STAMP 'MASTER' UNTIL ALL WORK IS FULLY CADDED

Rev	Design	Drawn	Chkd	Appd	Description	Date
C	NA	NA	CW	NGB	AS BUILT.	06.06.00
D	SH	SH	MB	MB	NEW INPUTS ADDED.	13.08.09
E	IM	AB	IM	MHS	SITE MODS	11.08.11
F	IM	AB	IM	MRS	TEXT ADDED	10.10.11
G					AS BUILT PER C10265-006V	29.05.12

Designed	NH
Drawn	NH
Checked	CW
Approved	NGB
Date	28.03.00
Cad Reference	10265-P3-080

HIMA–SELLA LIMITED © HIMA-SELLA

Title : LOOP DRAWING - INPUTS
ICI SYNETIX SCHEDULE - No.3 AND No.7 PLANTS
FISHER-ROSEMOUNTP.O. No. 99003994

Contract/ Drawing No	C10265H-P3	080	REV	G

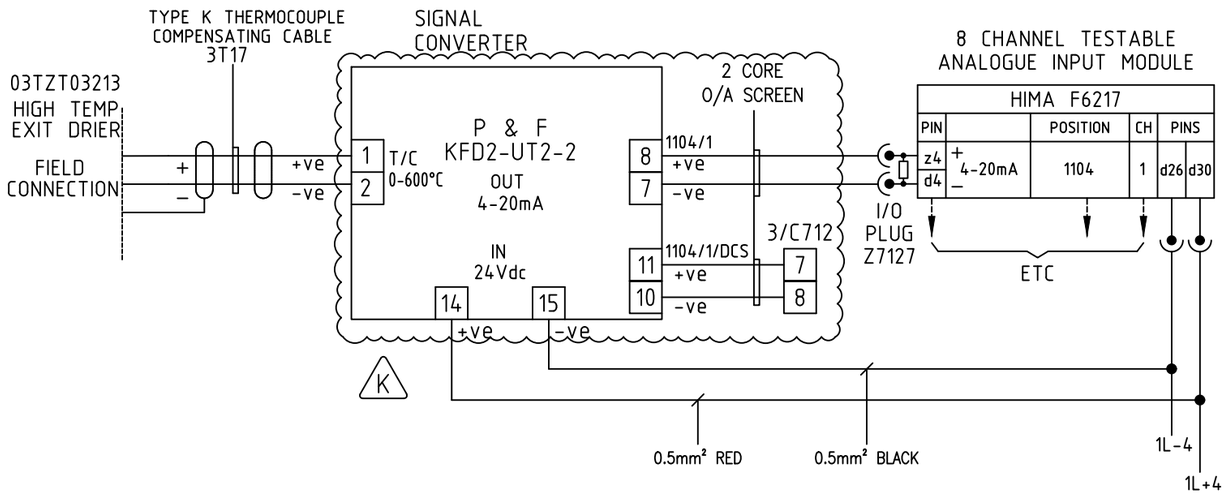

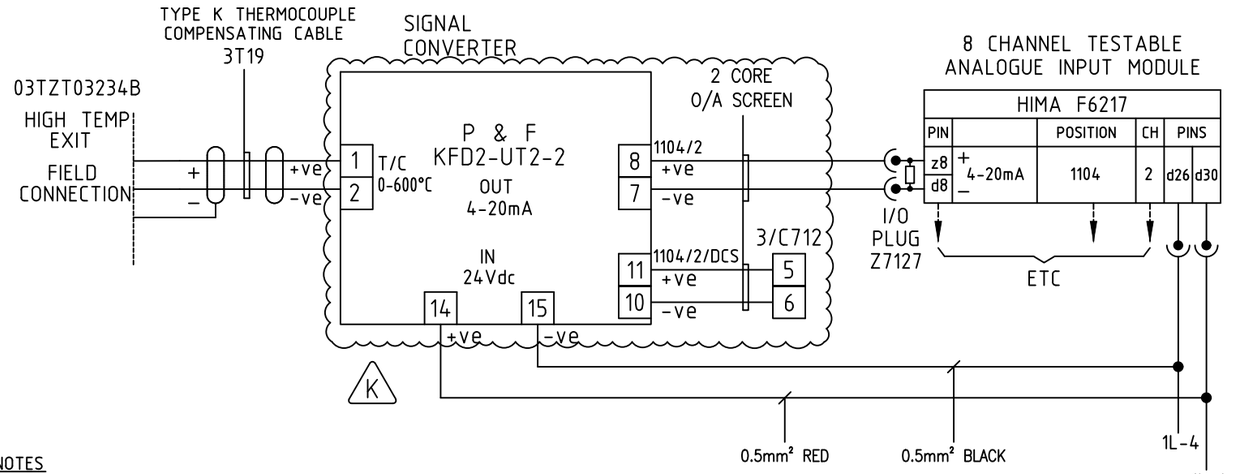

NOTES
1. FIRST TERMINAL OR PAIR SHOULD ALWAYS BE '+' (ASK1 (50mA) ON ANLG INPUT ONLY).
2. ANALOGUE LOOPS WILL BE WIRED USING SCREENED CABLES WHERE POSSIBLE.
3. ALL WIRING TO BE TRI-RATED.
4. COMPENSATING CABLES FOR TYPE 'K' THERMOCOUPLES WITH COLD JUNCTION COMPENSATION PROVIDED BY THE SIGNAL CONVERTER WILL BE USED ON ALL TYPES AI4 LOOPS.
5. L- FOR ALL REMOTE ANNUNCIATORS IS DELIVERD FROM THE ESD 24VDC SUPPLY.
6. WIRE No.s ARE DEFINED USING CARD POSITION / CHANNEL NUMBER.

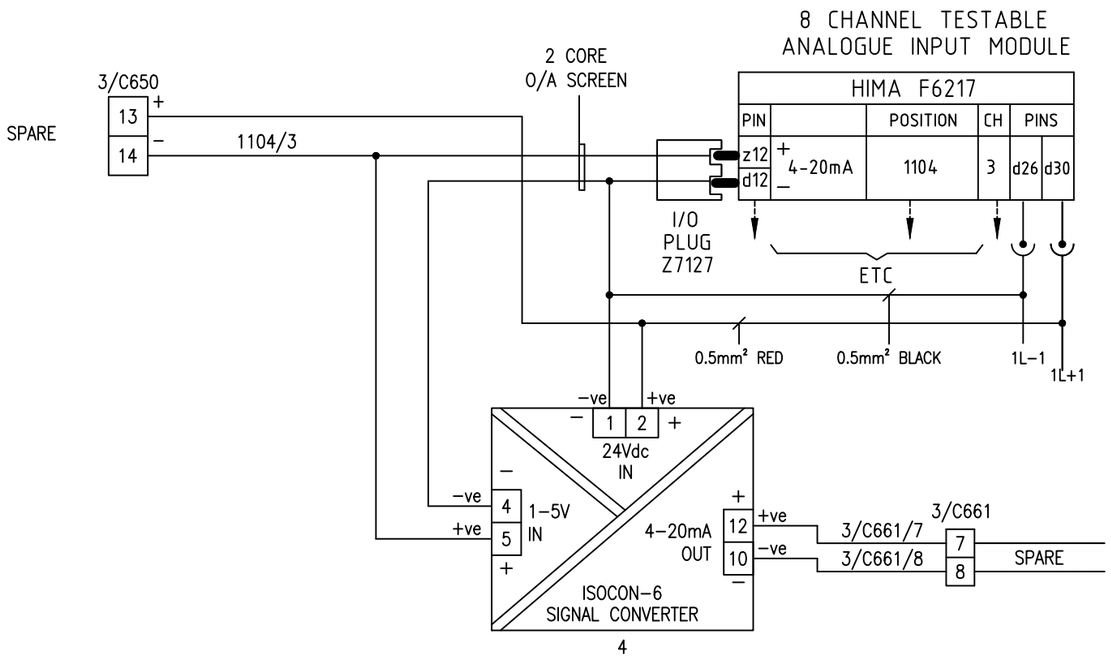

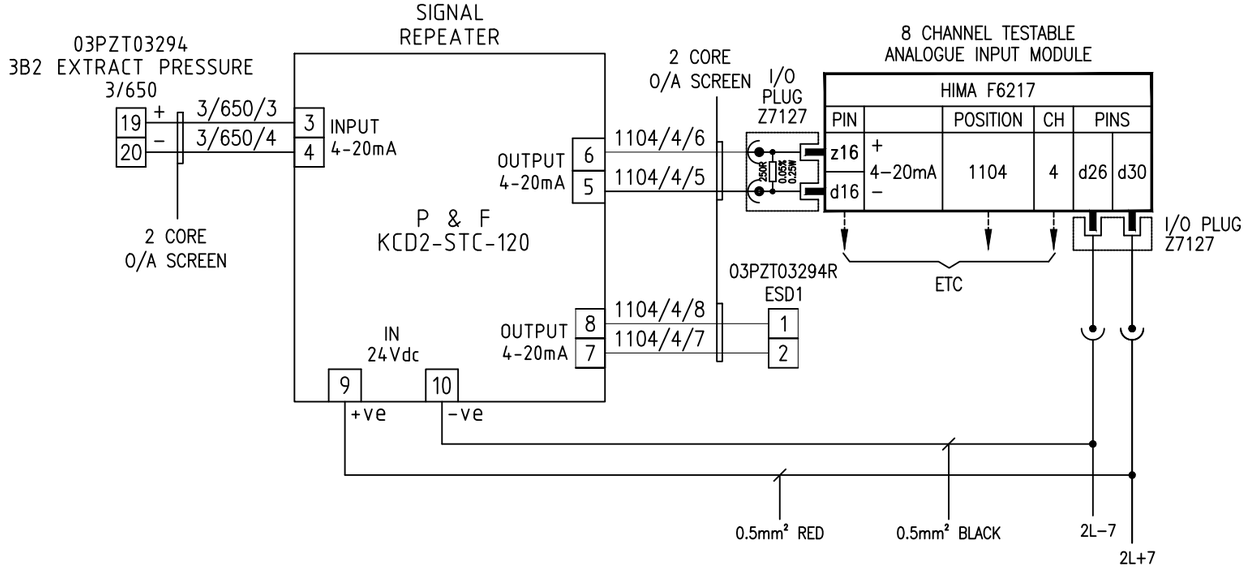

THIS DRAWING IS THE PROPERTY OF HIMA-SELLA LIMITED AND IS LOANED IN CONFIDENCE FOR USE WITH OUR WORK. IT IS NOT TO BE REPRODUCED IN ANY MANNER, SUBMITTED TO OUTSIDE PARTIES FOR EXAMINATION OR USED DIRECTLY OR INDIRECTLY FOR PURPOSES OTHER THAN THOSE FOR WHICH IT WAS FURNISHED WITHOUT WRITTEN CONSENT.

Template Revision – For Office Records Only

REV	AUTH	DATE	CAD TEMPLATE REF.
B	MB	7.4.10	A3-FRAME

Scale on A3 sheet	N/A
Dimensions	N/A

DO NOT STAMP 'MASTER' UNTIL ALL WORK IS FULLY CADDED

Rev	Design	Drawn	Chkd	Appd	Description	Date
C	NA	NA	CW	NGB	AS BUILT.	06.06.00
D	IM	WJB	IM	MRS	SITE MODS	11.08.11
E	DP	DB	EEM	CT	PLANT 3 ESD CABINET MODS C10265039V	29.01.21
F	DP	DB	JP	CT	PLANT 3 ESD CABINET MODS C10265039V	18.03.21
G	DP	AL	AD	CT	AS BUILT C10265039V	13.07.21
H	JP	TC	AD	DP	PLANT 3 CALCINER MODS C10265047V	16.08.24
J	JP	TC	AD	DP	CLIENT COMMENTS C10265047V	24.09.24
K				DP	C10265049V MODIFICATIONS	02.10.24

Designed	NH
Drawn	NH
Checked	CW
Approved	NGB
Date	28.03.00
Cad Reference	10265-P3-081

HIMA–SELLA LIMITED © HIMA-SELLA

Title : LOOP DRAWING - INPUTS
ICI SYNETIX SCHEDULE - No.3 AND No.7 PLANTS
FISHER-ROSEMOUNTP.O. No. 99003994

Contract/ Drawing No	C10265H-P3	081	REV	K

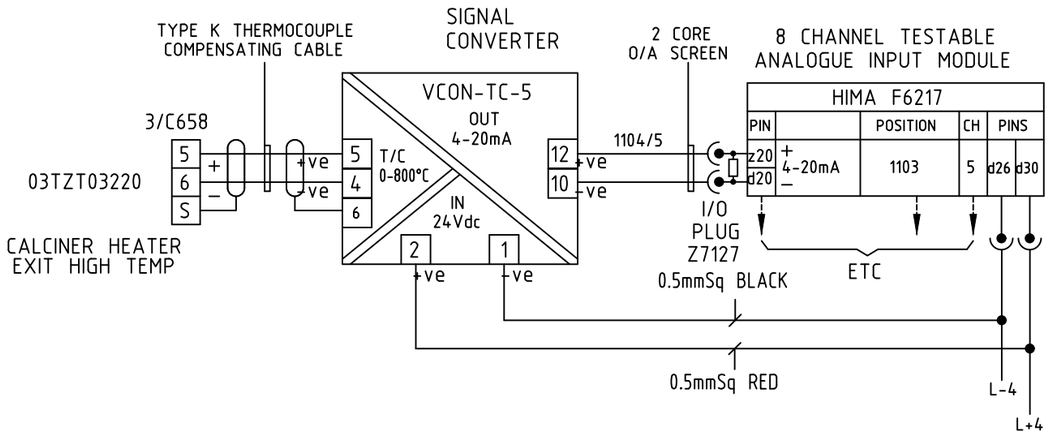

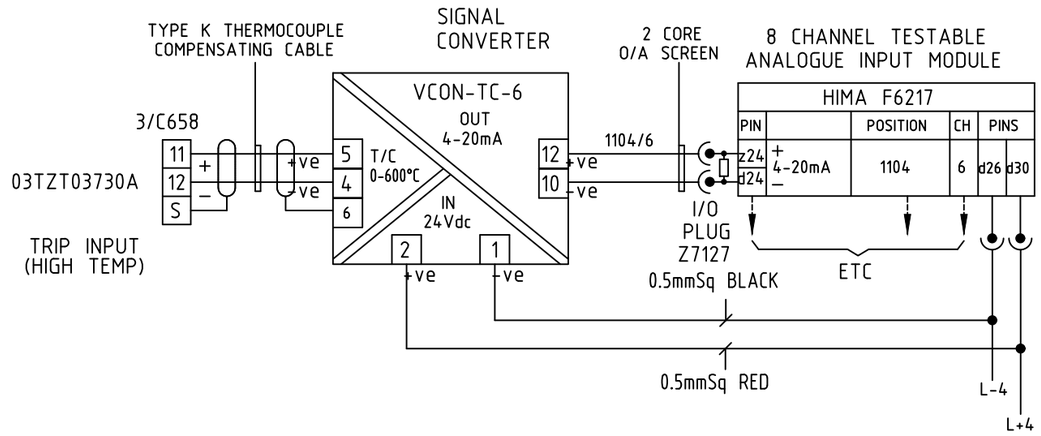

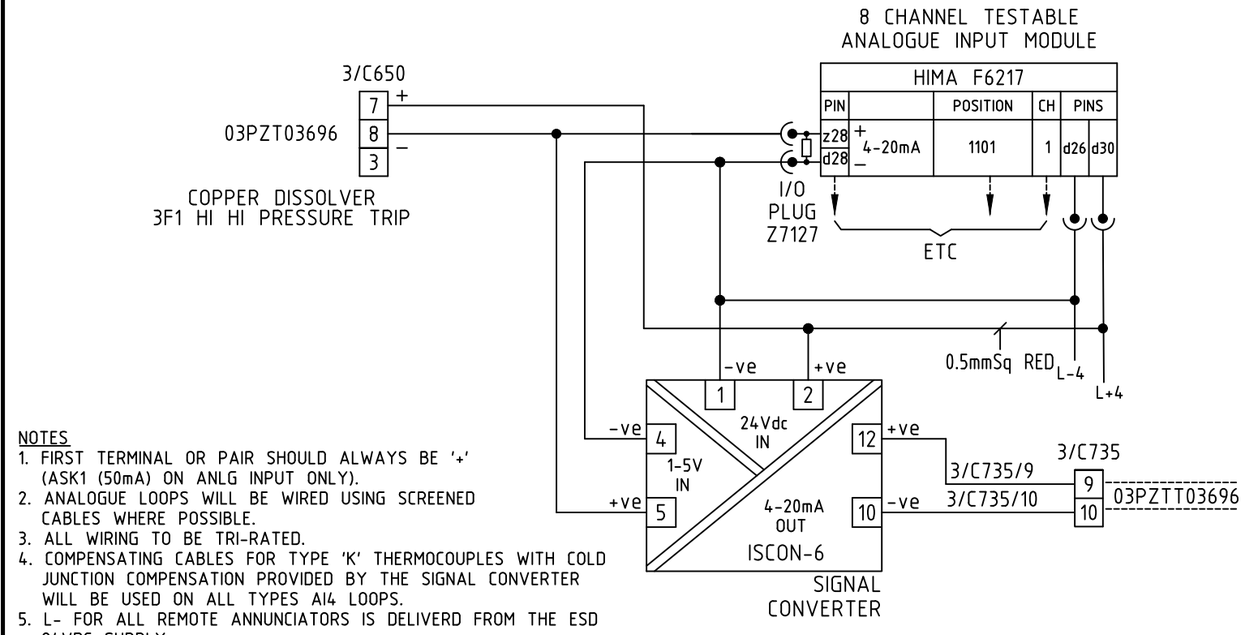

NOTES
1. FIRST TERMINAL OR PAIR SHOULD ALWAYS BE '+' (ASK1 (50mA) ON ANLG INPUT ONLY).
2. ANALOGUE LOOPS WILL BE WIRED USING SCREENED CABLES WHERE POSSIBLE.
3. ALL WIRING TO BE TRI-RATED.
4. COMPENSATING CABLES FOR TYPE 'K' THERMOCOUPLES WITH COLD JUNCTION COMPENSATION PROVIDED BY THE SIGNAL CONVERTER WILL BE USED ON ALL TYPES AI4 LOOPS.
5. L- FOR ALL REMOTE ANNUNCIATORS IS DELIVERD FROM THE ESD 24VDC SUPPLY.
6. WIRE No.s ARE DEFINED USING CARD POSITION / CHANNEL NUMBER.

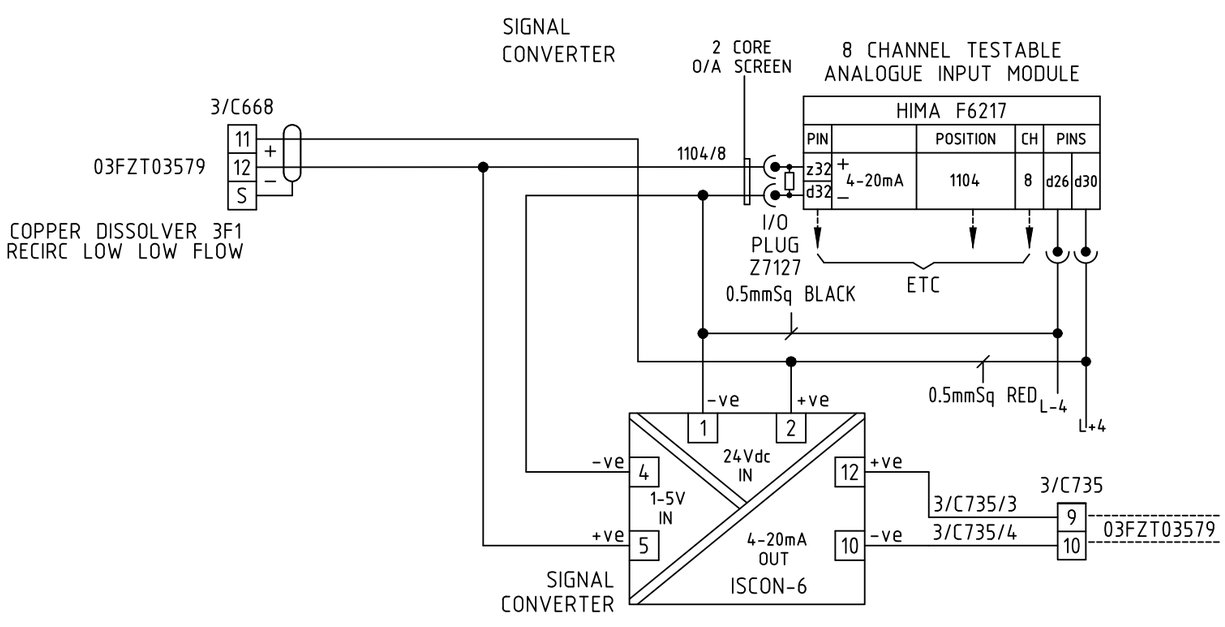

THIS DRAWING IS THE PROPERTY OF HIMA-SELLA LIMITED AND IS LOANED IN CONFIDENCE FOR USE WITH OUR WORK. IT IS NOT TO BE REPRODUCED IN ANY MANNER, SUBMITTED TO OUTSIDE PARTIES FOR EXAMINATION OR USED DIRECTLY OR INDIRECTLY FOR PURPOSES OTHER THAN THOSE FOR WHICH IT WAS FURNISHED WITHOUT WRITTEN CONSENT.

Scale on A3 sheet	N/A
Dimensions	N/A

Template Revision – For Office Records Only

REV	AUTH	DATE	CAD TEMPLATE REF.
B	MB	7.4.10	A3-FRAME

DO NOT STAMP 'MASTER' UNTIL ALL WORK IS FULLY CADDED

Rev	Design	Drawn	Chkd	Appd	Description	Date
C	NA	NA	CW	NGB	AS BUILT.	06.06.00
D	MB	RL	CT	MHS	TZT03730 ADDED.	10.08.09
E	IM	AB	IM	MHS	SITE MODS	11.08.11
F					LOOP TYPE CORRECTED	10.10.11

Designed	NH
Drawn	NH
Checked	CW
Approved	NGB
Date	28.03.00
Cad Reference	10265-P3-082

HIMA–SELLA LIMITED © HIMA-SELLA

Title : LOOP DRAWING - INPUTS
ICI SYNETIX SCHEDULE - No.3 AND No.7 PLANTS
FISHER-ROSEMOUNTP.O. No. 99003994

Contract/ Drawing No	C10265H-P3	082	REV	F

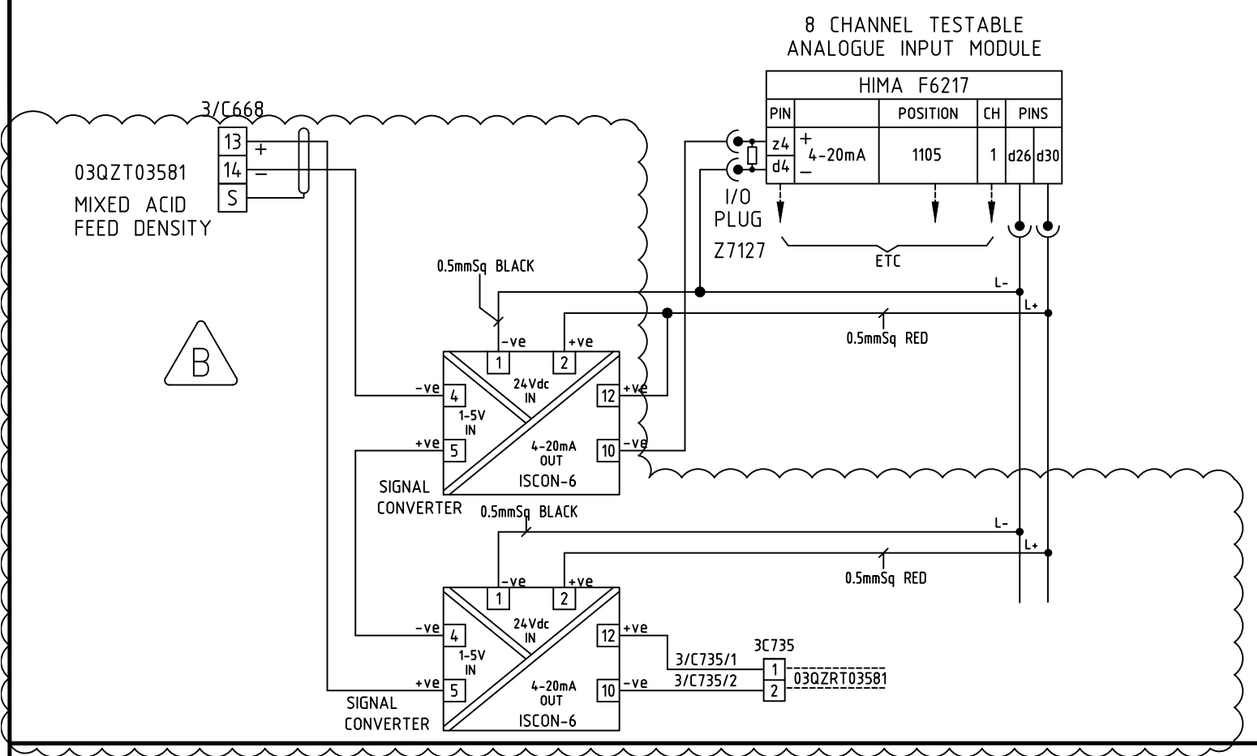

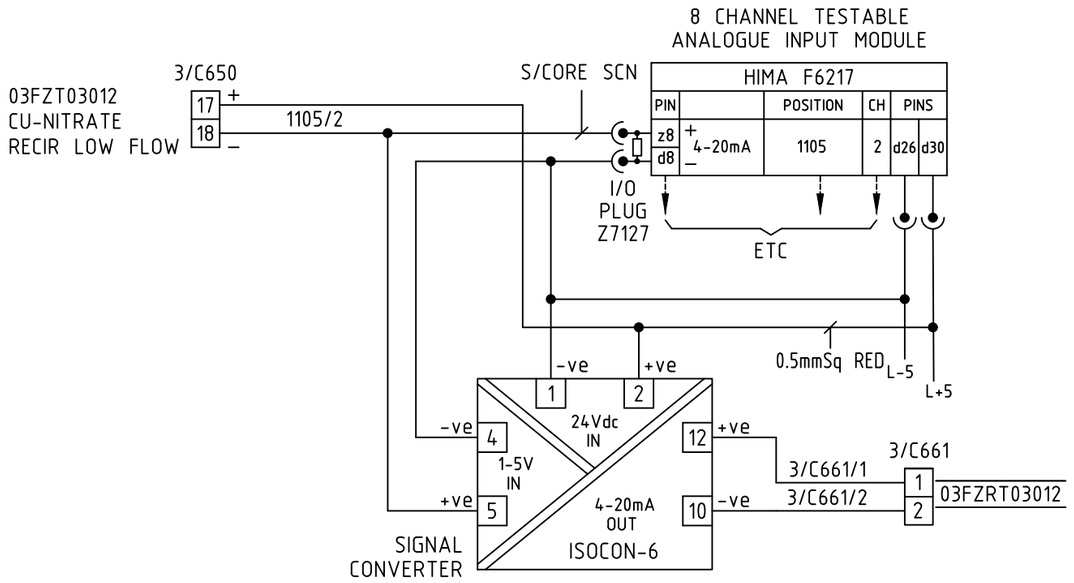

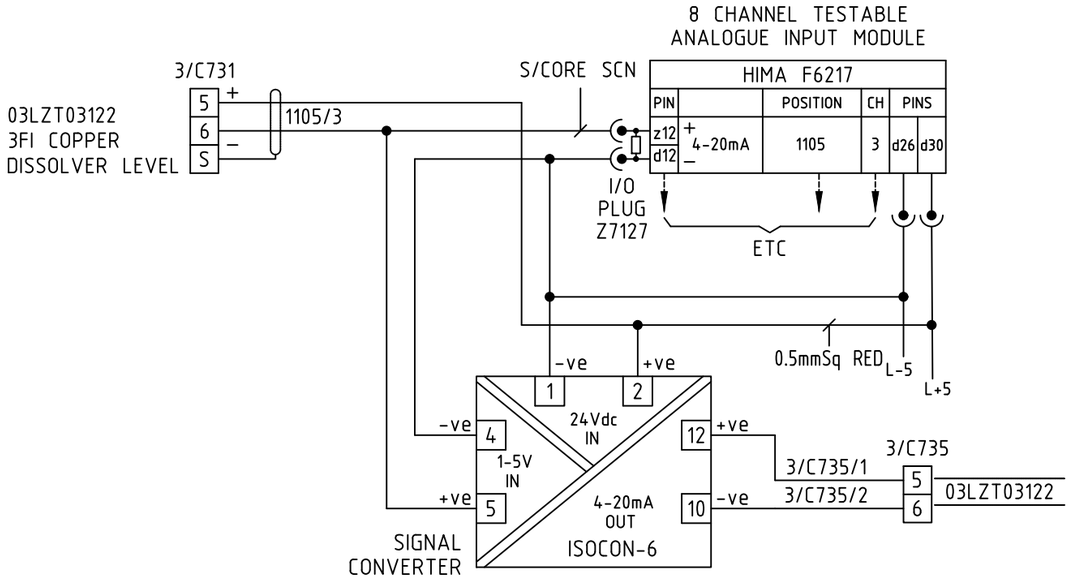

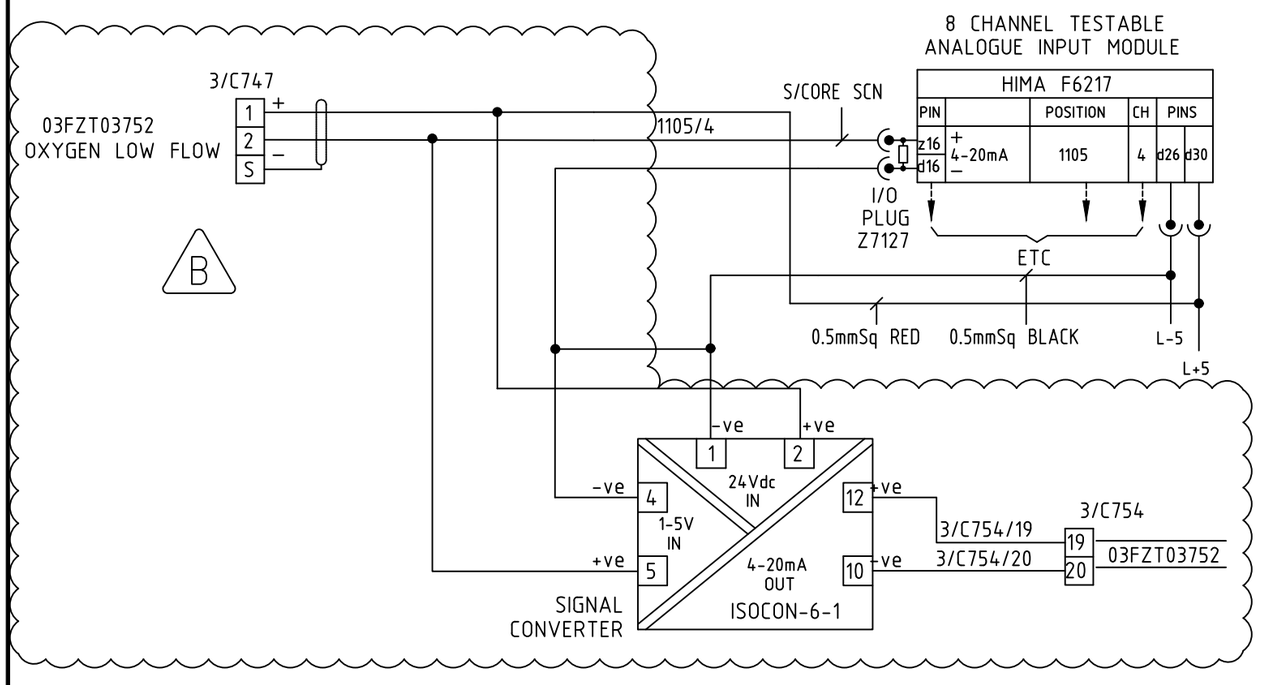

THIS DRAWING IS THE PROPERTY OF HIMA-SELLA LIMITED AND IS LOANED IN CONFIDENCE FOR USE WITH OUR WORK. IT IS NOT TO BE REPRODUCED IN ANY MANNER, SUBMITTED TO OUTSIDE PARTIES FOR EXAMINATION OR USED DIRECTLY OR INDIRECTLY FOR PURPOSES OTHER THAN THOSE FOR WHICH IT WAS FURNISHED WITHOUT WRITTEN CONSENT.

Template Revision – For Office Records Only

REV	AUTH	DATE	CAD TEMPLATE REF.
0	AB	18.07.11	A3-FRAME

Scale on A3 sheet	N/A
Dimensions	N/A

DO NOT STAMP 'MASTER' UNTIL ALL WORK IS FULLY CADDED

Rev	Design	Drawn	Chkd	Appd	Description	Date
A	IM	AB	IM	MRS	LOOP TYPE CORRECTED	07.10.11
B				CT	ZINC DISSOLVER PHR & MMN IMPROVEMENTS	30.05.14

Designed	IM
Drawn	AB
Checked	IM
Approved	MHS
Date	11.08.11
Cad Reference	10265-P3-083

HIMA–SELLA LIMITED © HIMA-SELLA

Title : LOOP DRAWING - INPUTS
ICI SYNETIX SCHEDULE - No.3 AND No.7 PLANTS
FISHER-ROSEMOUNTP.O. No. 99003994

Contract/ Drawing No	C10265H-P3	083	REV	B

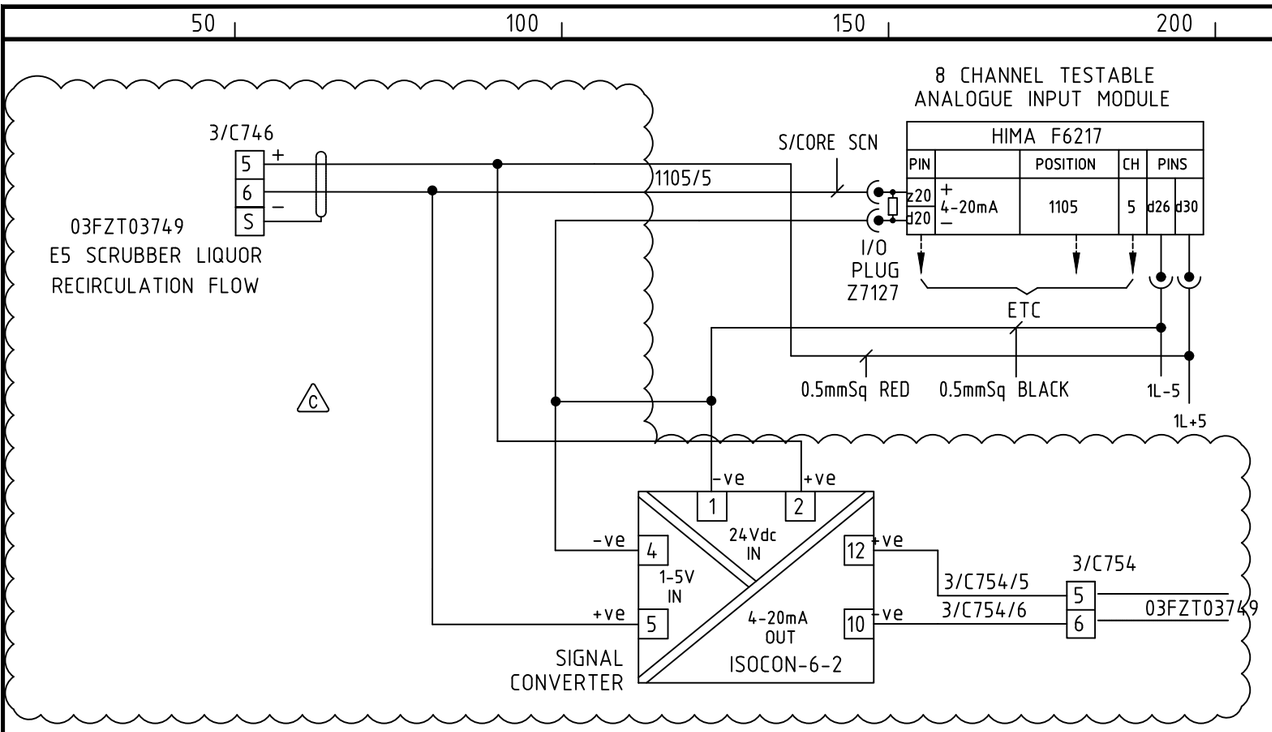

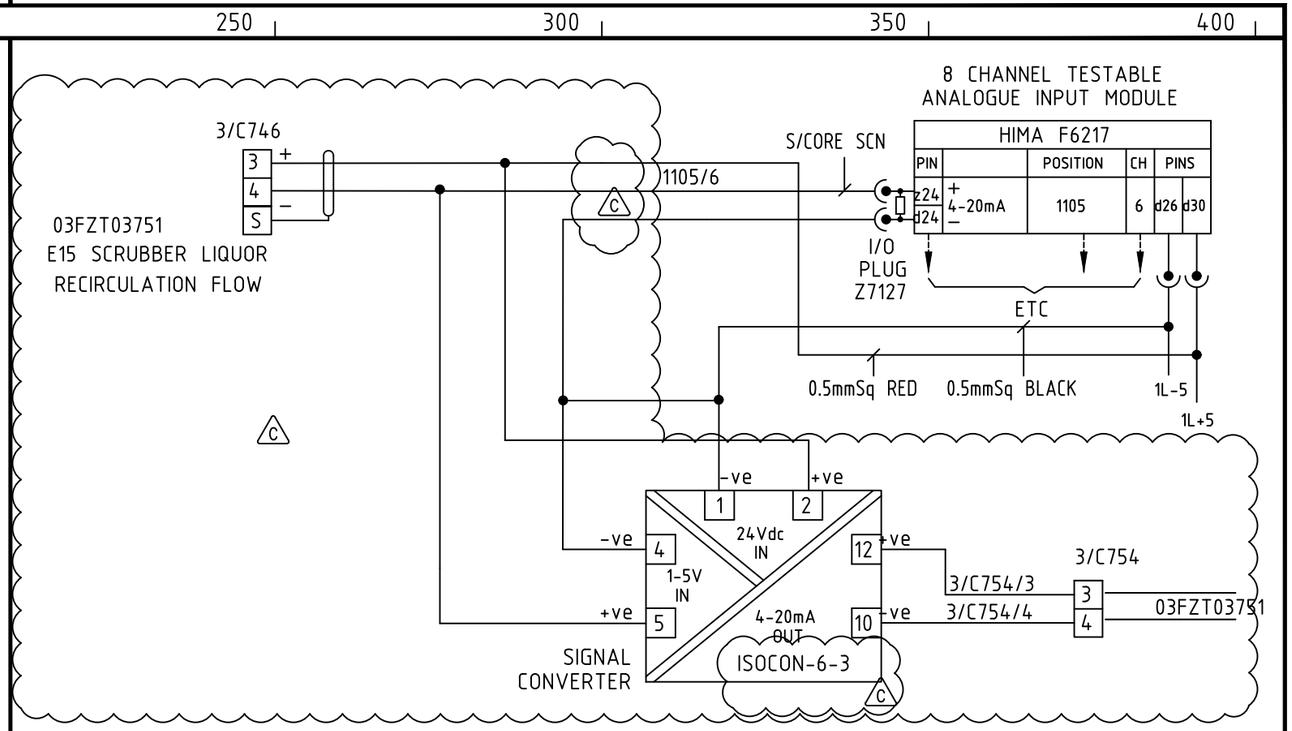

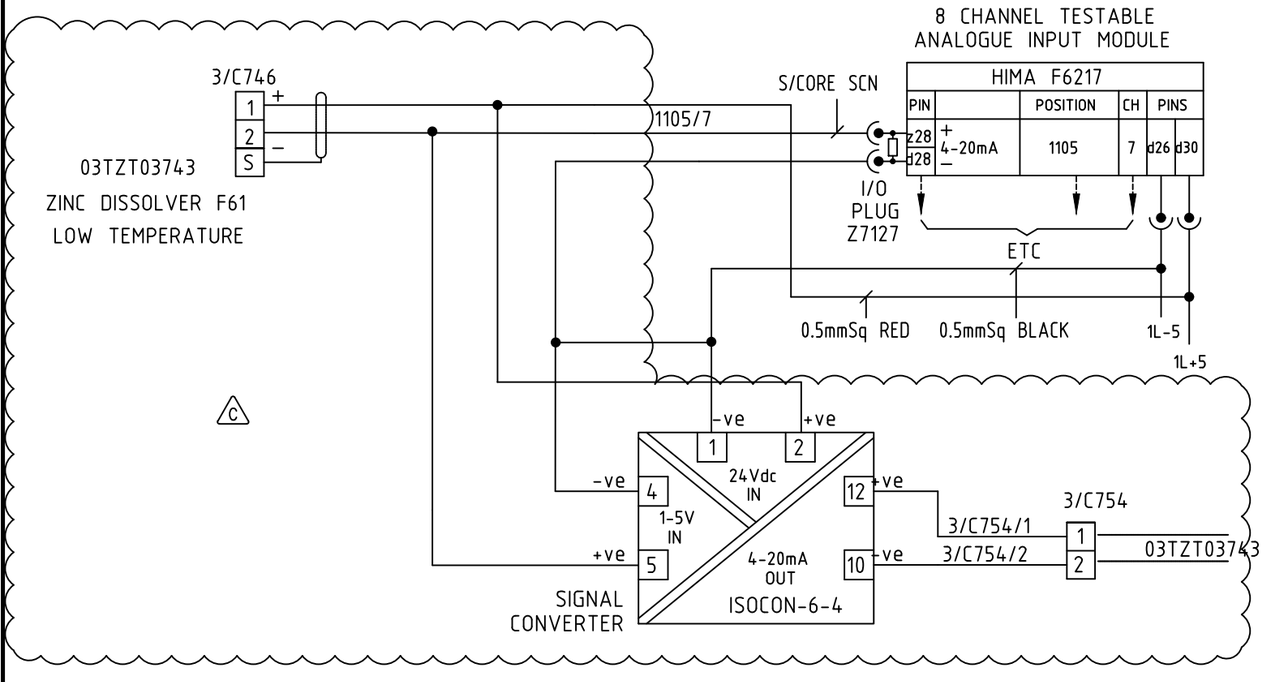

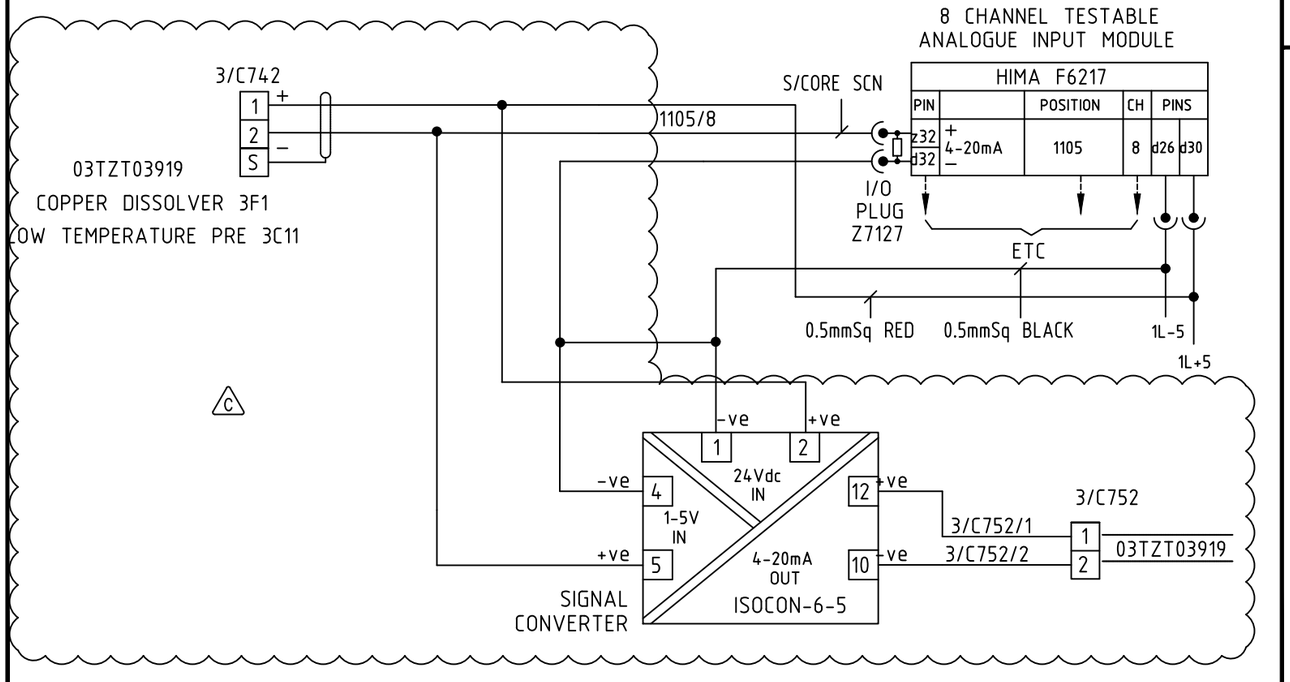

THIS DRAWING IS THE PROPERTY OF HIMA-SELLA LIMITED AND IS LOANED IN CONFIDENCE FOR USE WITH OUR WORK. IT IS NOT TO BE REPRODUCED IN ANY MANNER, SUBMITTED TO OUTSIDE PARTIES FOR EXAMINATION OR USED DIRECTLY OR INDIRECTLY FOR PURPOSES OTHER THAN THOSE FOR WHICH IT WAS FURNISHED WITHOUT WRITTEN CONSENT.

Template Revision – For Office Records Only

REV	AUTH	DATE	CAD TEMPLATE REF.
0	AB	18.07.11	A3-FRAME

Scale on A3 sheet	N/A
Dimensions	N/A

DO NOT STAMP 'MASTER' UNTIL ALL WORK IS FULLY CADDED

Rev	Design	Drawn	Chkd	Appd	Description	Date
A	IM	AB	AD	NGB	PIN NUMBERS CORRECTED	06.10.11
B	CJG	CJG	AD	CT	ZINC DISSOLVER PHR & MMN IMPROVEMENTS	20.02.14
C				CT	AS BUILT ON SITE	24.04.14

Designed	IM
Drawn	AB
Checked	IM
Approved	MRS
Date	11.08.11
Cad Reference	10265-P3-084

HIMA-SELLA LIMITED © HIMA-SELLA

Title : LOOP DRAWING – INPUTS
ICI SYNETIX SCHEDULE – No.3 AND No.7 PLANTS
FISHER-ROSEMOUNT P.O. No. 99003994

Contract/ Drawing No	C10265H-P3	084	REV	C

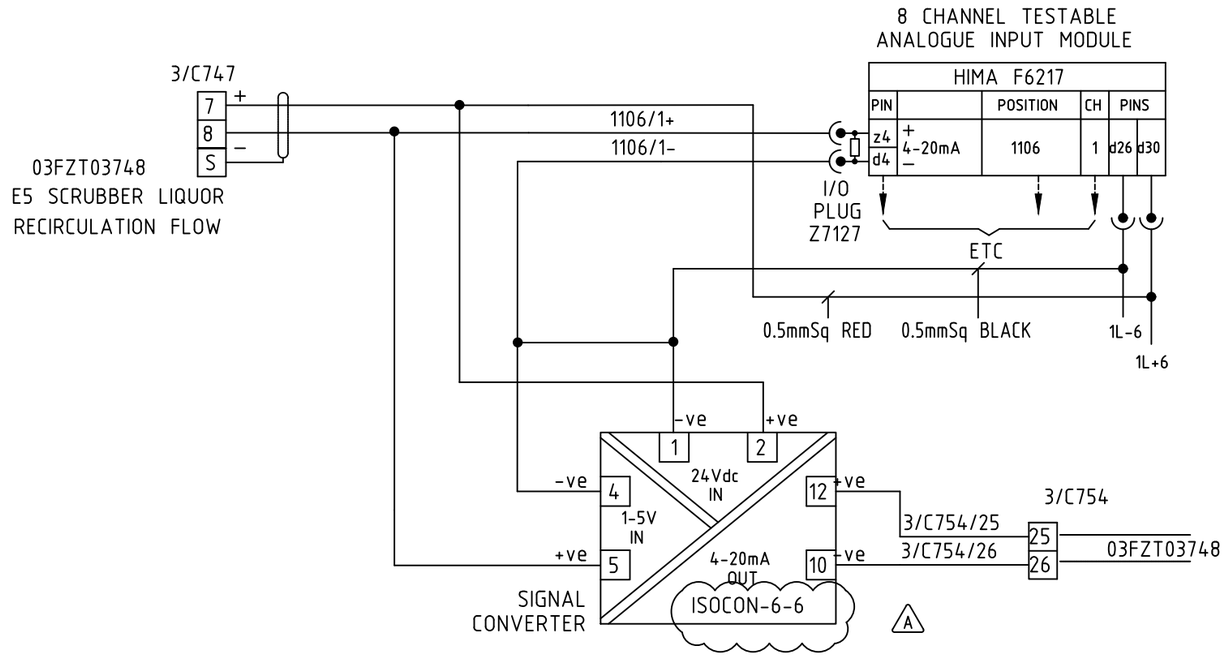

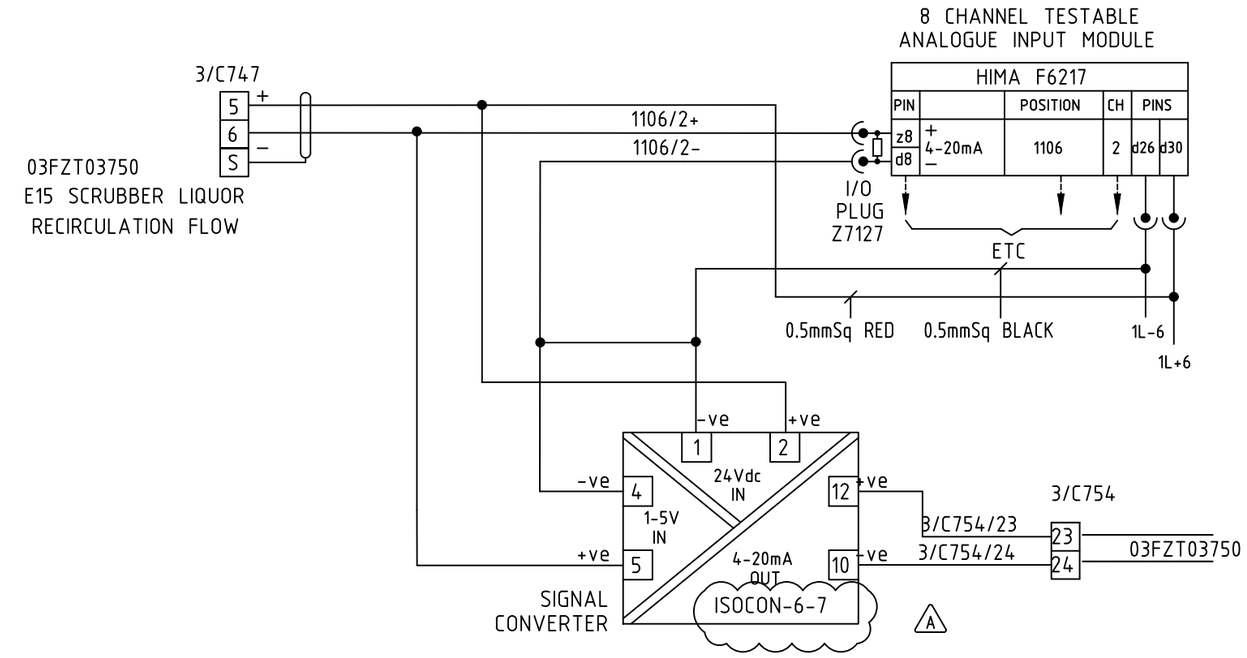

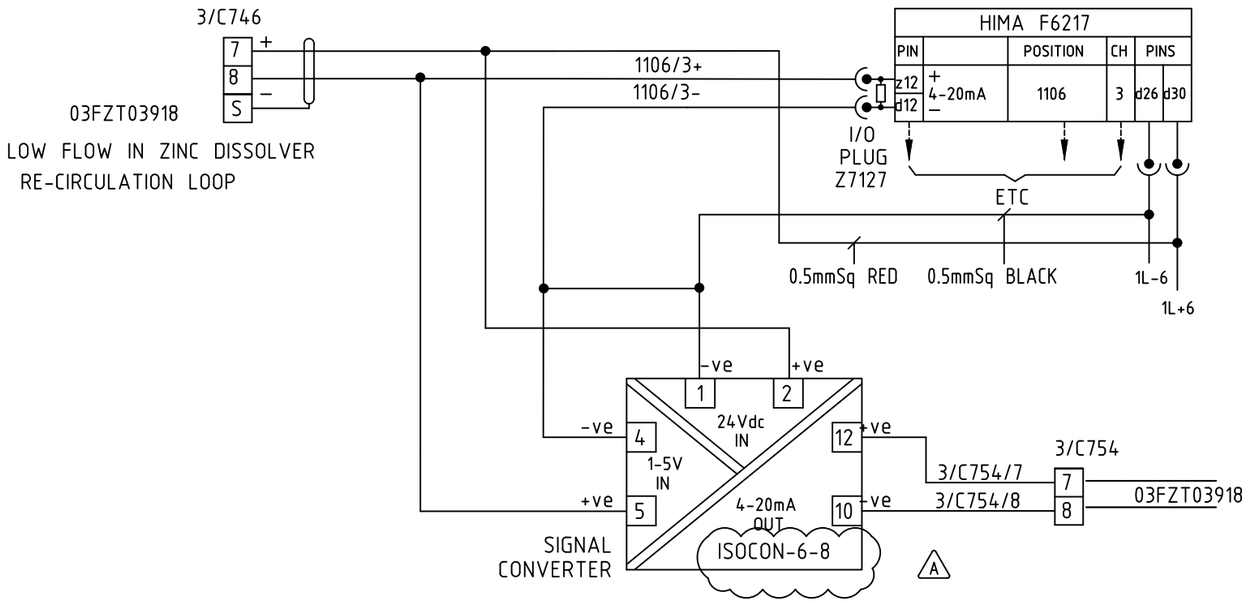

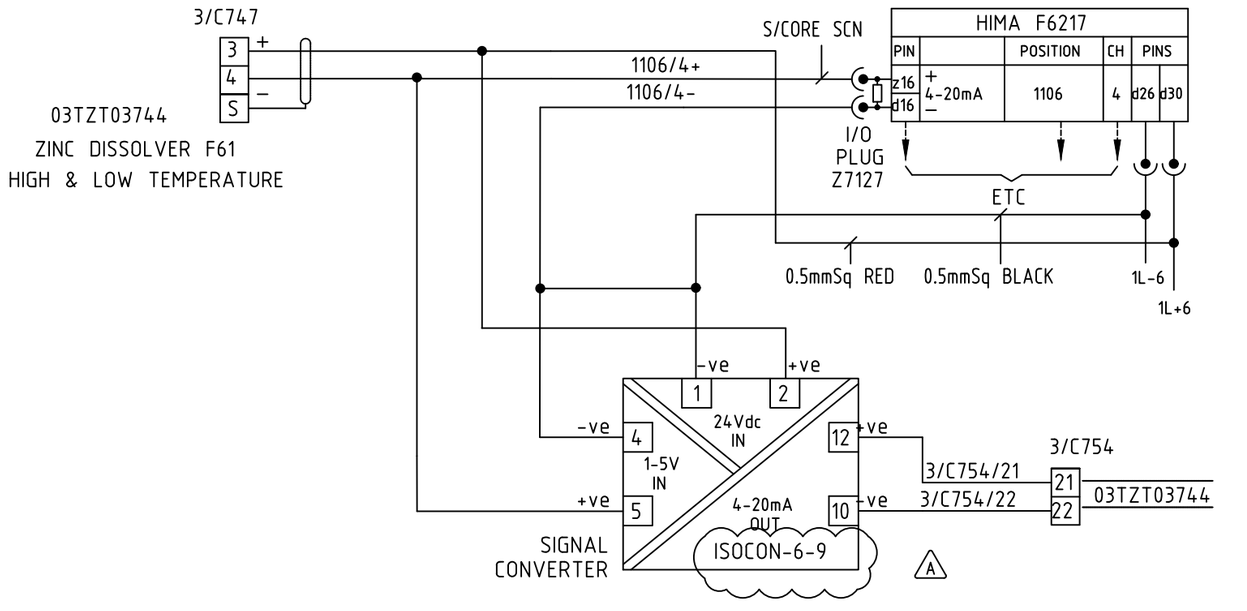

THIS DRAWING IS THE PROPERTY OF HIMA-SELLA LIMITED AND IS LOANED IN CONFIDENCE FOR USE WITH OUR WORK. IT IS NOT TO BE REPRODUCED IN ANY MANNER, SUBMITTED TO OUTSIDE PARTIES FOR EXAMINATION OR USED DIRECTLY OR INDIRECTLY FOR PURPOSES OTHER THAN THOSE FOR WHICH IT WAS FURNISHED WITHOUT WRITTEN CONSENT.

Template Revision – For Office Records Only			
REV	AUTH	DATE	CAD TEMPLATE REF.
0	AB	18.07.11	A3-FRAME

Scale on A3 sheet	N/A
Dimensions	N/A

DO NOT STAMP 'MASTER' UNTIL ALL WORK IS FULLY CADDED

Rev	Design	Drawn	Chkd	Appd	Description	Date
A				CT	ISOCON NUMBERS ADDED	08.05.14

Designed	CJG
Drawn	CJG
Checked	AD
Approved	CT
Date	20.02.14
Cad Reference	10265–P3–085

HIMA–SELLA LIMITED © HIMA-SELLA

Title : LOOP DRAWING - INPUTS
ICI SYNETIX SCHEDULE – No.3 AND No.7 PLANTS
FISHER–ROSEMOUNTP.O. No. 99003994

Contract/ Drawing No	C10265H–P3	085	REV	A

50 100 150 200 250 300 350 400

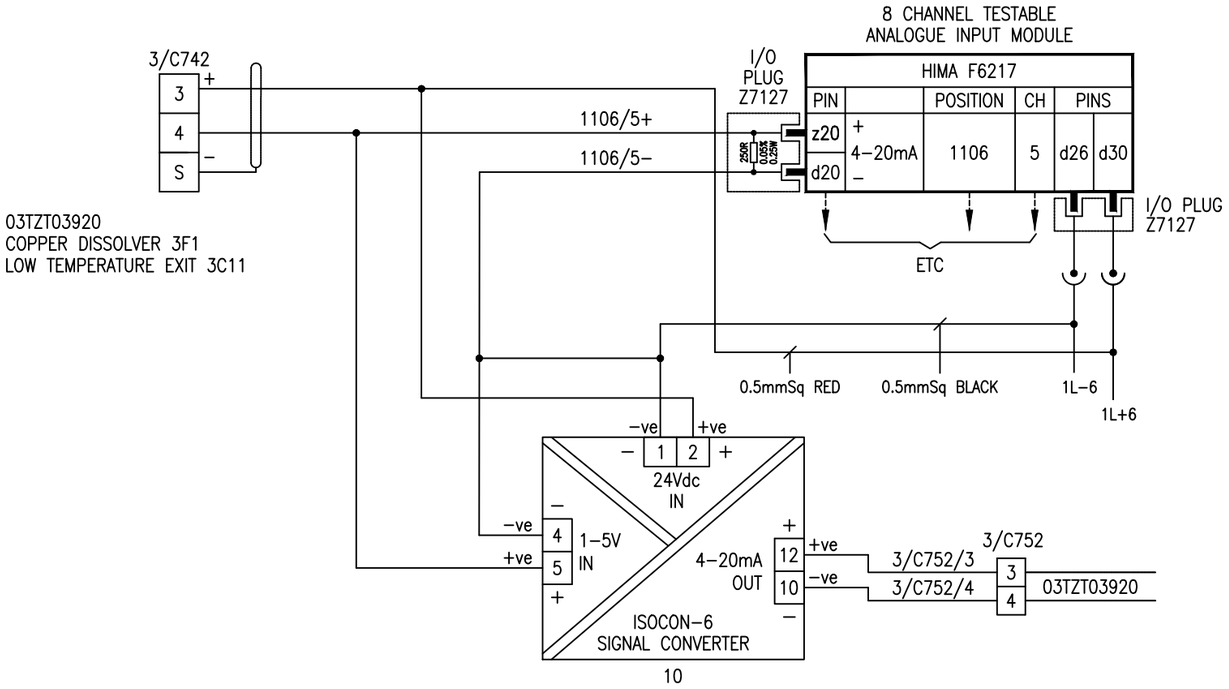

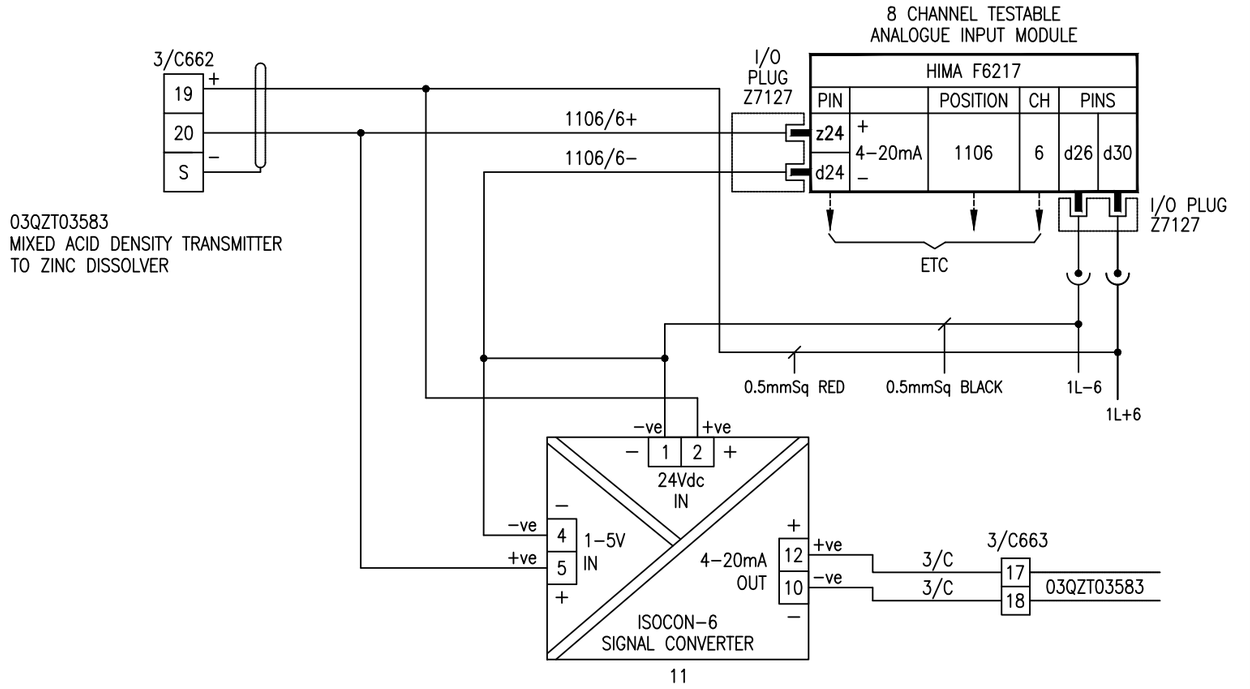

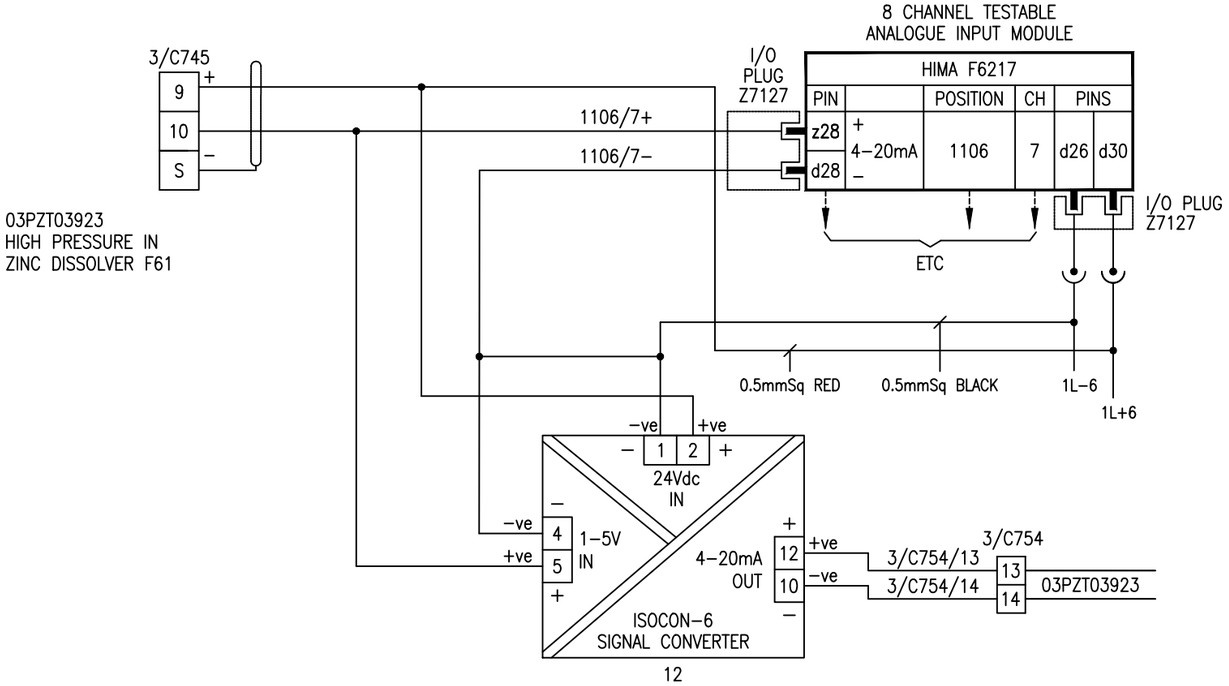

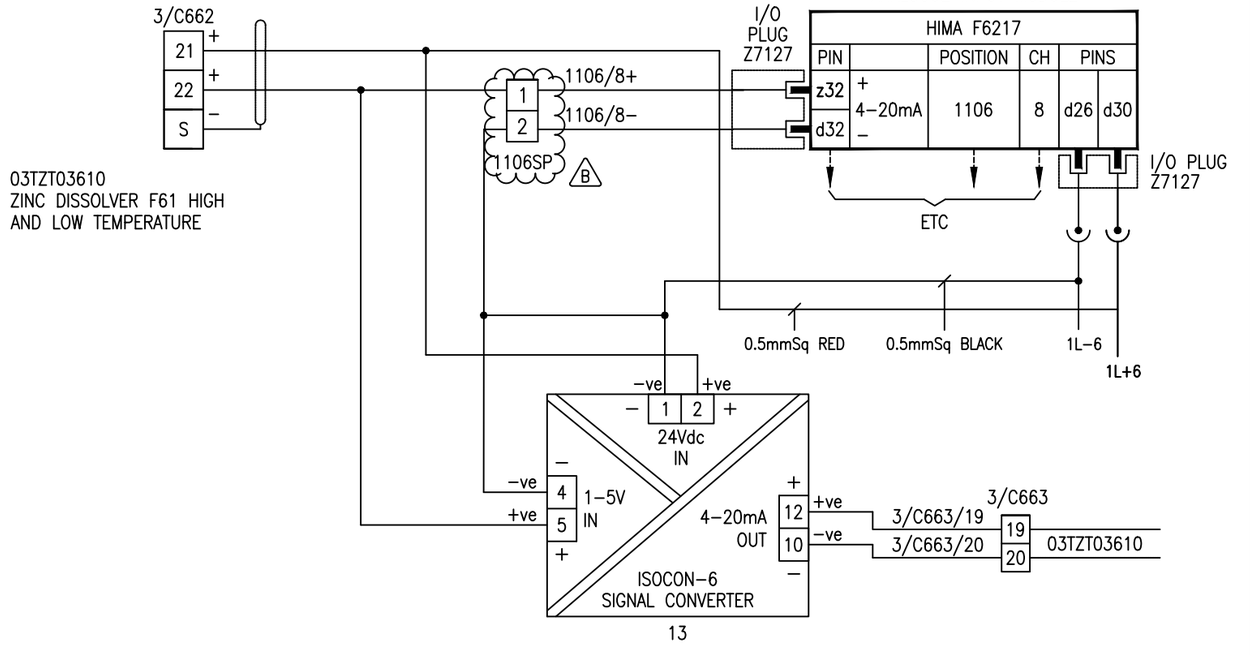

THIS DRAWING IS THE PROPERTY OF HIMA-SELLA LIMITED AND IS LOANED IN CONFIDENCE FOR USE WITH OUR WORK. IT IS NOT TO BE REPRODUCED IN ANY MANNER, SUBMITTED TO OUTSIDE PARTIES FOR EXAMINATION OR USED DIRECTLY OR INDIRECTLY FOR PURPOSES OTHER THAN THOSE FOR WHICH IT WAS FURNISHED WITHOUT WRITTEN CONSENT.

Scale on A3 sheet	N/A
Dimensions	N/A

Template Revision – For Office Records Only

REV	AUTH	DATE	CAD TEMPLATE REF.
0	AB	18.07.11	A3-FRAME

DO NOT STAMP 'MASTER' UNTIL ALL WORK IS FULLY CADDED

Rev	Design	Drawn	Chkd	Appd	Description	Date
A	DP	HG	SP	CW	MODS TO 3 PLANT ESD SYSTEM AS PER C10265033V	20.03.19
B				DP	AS BUILT - C10265033V	01.05.19

Designed	DP
Drawn	WJB
Checked	RB
Approved	CT
Date	30.05.14
Cad Reference	10265-P3-085

HIMA–SELLA LIMITED © HIMA-SELLA

Title : LOOP DRAWING - INPUTS
ICI SYNETIX SCHEDULE - No.3 AND No.7 PLANTS
FISHER-ROSEMOUNTP.O. No. 99003994

Contract/ Drawing No	C10265H-P3	086	REV	B

50 100 150 200 250 300 350 400

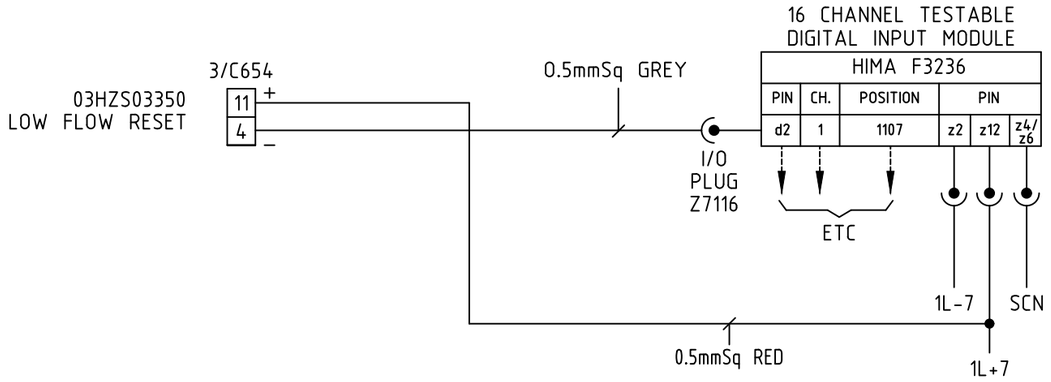

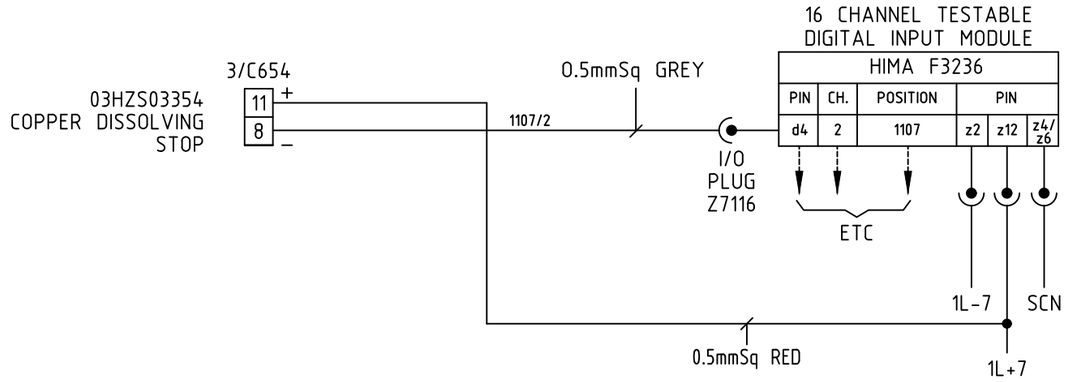

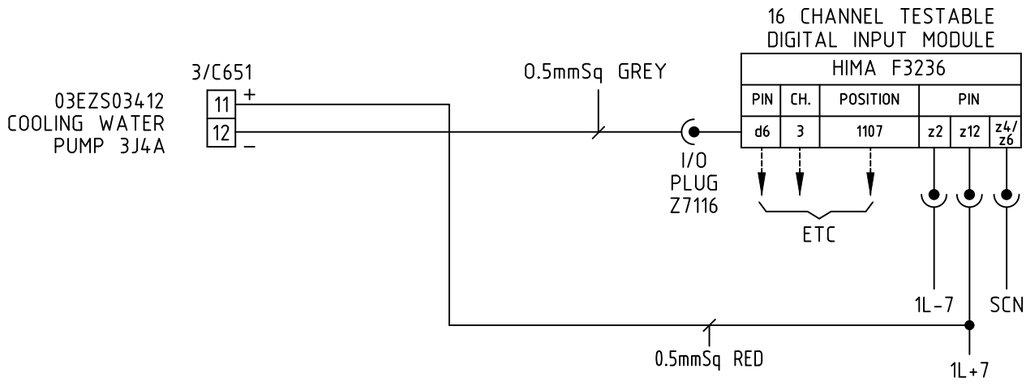

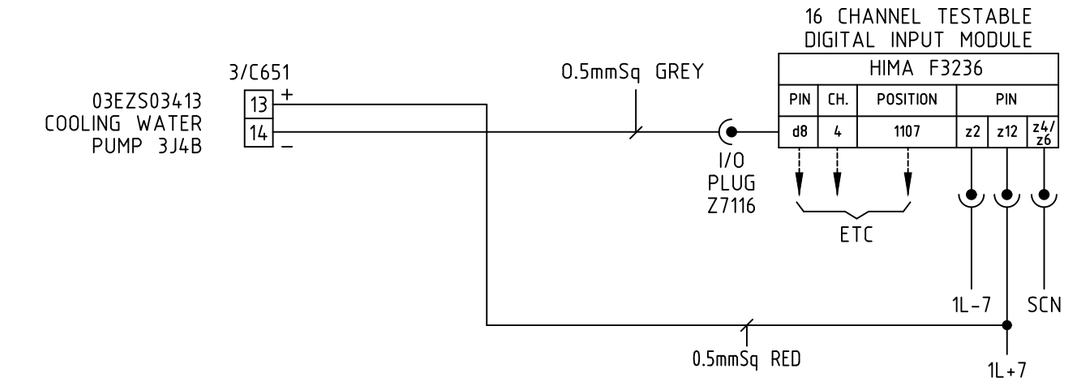

NOTES
1. FIRST TERMINAL OF PAIR SHOULD ALWAYS BE '+' (ASK1 (50mA) ON ANALOGUE INPUTS ONLY).
2. ANALOGUE LOOPS WILL BE WIRED USING SCREENED CABLES WHERE POSSIBLE.
3. ALL WIRING TO BE TRI-RATED.
4. COMPENSATING CABLES FOR TYPE 'K' THERMOCOUPLES WITH COLD JUNCTION.
   COMPENSATION PROVIDED BY THE SIGNAL CONVERTOR WILL BE USED ON ALL TYPE AI4 LOOPS.
5. L- FOR ALL REMOTE ANNUNCIATORS IS DERIVED FROM THE ESD 24Vdc SUPPLY.
6. WIRE No.s ARE DEFINED USING CARD POSITION/CHANNEL NUMBER.

THIS DRAWING IS THE PROPERTY OF HIMA-SELLA LIMITED AND IS LOANED IN CONFIDENCE FOR USE WITH OUR WORK. IT IS NOT TO BE REPRODUCED IN ANY MANNER, SUBMITTED TO OUTSIDE PARTIES FOR EXAMINATION OR USED DIRECTLY OR INDIRECTLY FOR PURPOSES OTHER THAN THOSE FOR WHICH IT WAS FURNISHED WITHOUT WRITTEN CONSENT.

Template Revision – For Office Records Only

REV	AUTH	DATE	CAD TEMPLATE REF.
B	MB	7.4.10	A3-FRAME

Scale on A3 sheet	N/A
Dimensions	N/A

DO NOT STAMP 'MASTER' UNTIL ALL WORK IS FULLY CADDED

Rev	Design	Drawn	Chkd	Appd	Description	Date
C	NH	NH	CW	NGB	AS BUILT.	06.06.00
D	IM	AB	IM	MHS	TEXT ADDED	11.08.11
E					CHANNEL NUMBERS CORRECTED	06.10.11

Designed	NH
Drawn	NH
Checked	CW
Approved	NGB
Date	29.03.00
Cad Reference	10265-P3-087

HIMA–SELLA LIMITED © HIMA-SELLA

Title : LOOP DRAWING - INPUTS
ICI SYNETIX SCHEDULE - No.3 AND No.7 PLANTS
FISHER-ROSEMOUNTP.O. No. 99003994

Contract/ Drawing No	C10265H-P3	087	REV	E

50 100 150 200 250 300 350 400

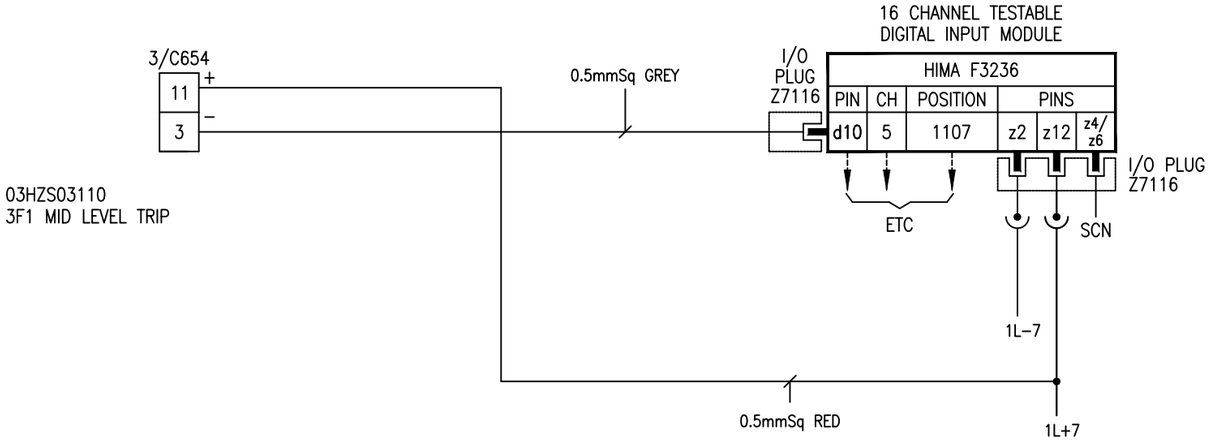

03HZS03110
3F1 MID LEVEL TRIP

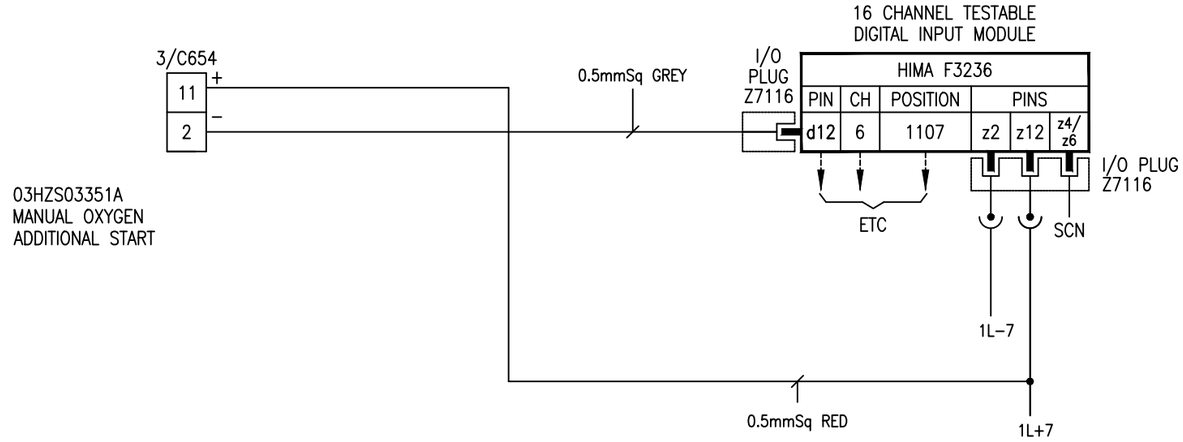

03HZS03351A
MANUAL OXYGEN
ADDITIONAL START

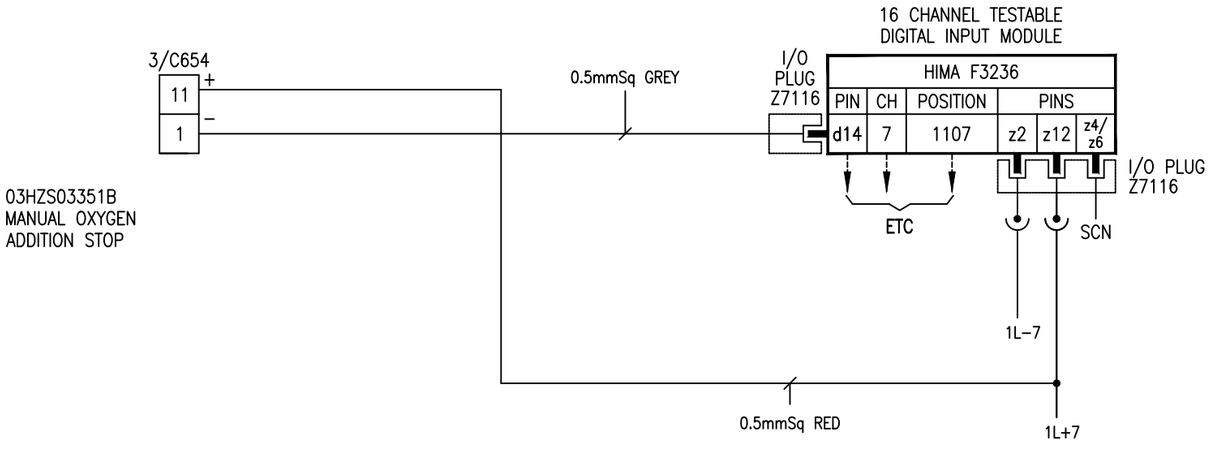

03HZS03351B
MANUAL OXYGEN
ADDITION STOP

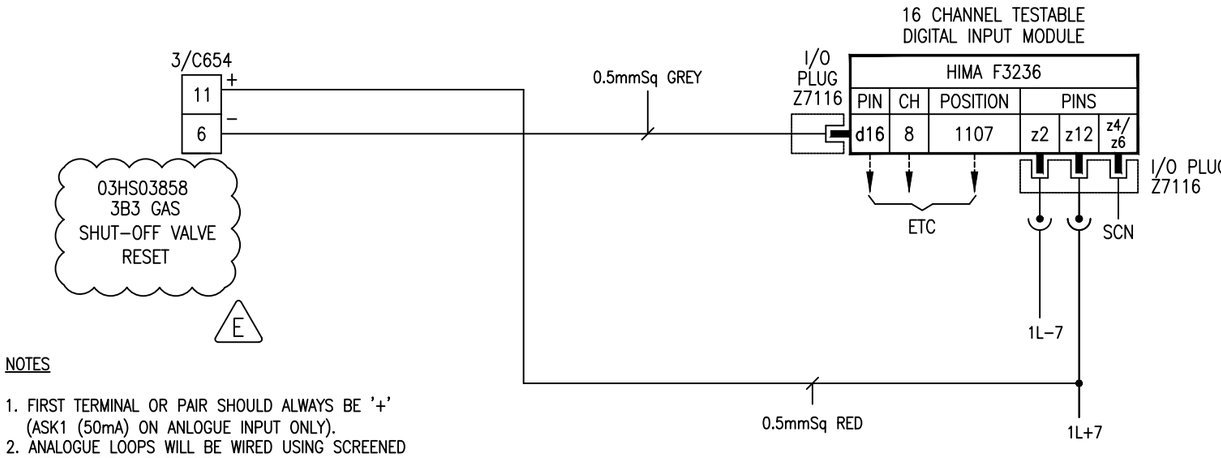

03HS03858
3B3 GAS
SHUT–OFF VALVE
RESET

E

NOTES

1. FIRST TERMINAL OR PAIR SHOULD ALWAYS BE '+' (ASK1 (50mA) ON ANLOGUE INPUT ONLY).
2. ANALOGUE LOOPS WILL BE WIRED USING SCREENED CABLES WHERE POSSIBLE.
3. ALL WIRING TO BE TRI–RATED.
4. COMPENSATING CABLES FOR TYPE 'K' THERMOCOUPLES WITH COLD JUNCTION. COMPENSATION PROVIDED BY THE SIGNAL CONVERTER WILL BE USED ON ALL TYPES AI4 LOOPS.
5. L– FOR ALL REMOTE ANNUNCIATORS IS DELIVERED FROM THE ESD 24VDC SUPPLY.
6. WIRE No.s ARE DEFINED USING CARD POSITION / CHANNEL NUMBER.

THIS DRAWING IS THE PROPERTY OF HIMA-SELLA LIMITED AND IS LOANED IN CONFIDENCE FOR USE WITH OUR WORK. IT IS NOT TO BE REPRODUCED IN ANY MANNER, SUBMITTED TO OUTSIDE PARTIES FOR EXAMINATION OR USED DIRECTLY OR INDIRECTLY FOR PURPOSES OTHER THAN THOSE FOR WHICH IT WAS FURNISHED WITHOUT WRITTEN CONSENT.

Template Revision – For Office Records Only

REV	AUTH	DATE	CAD TEMPLATE REF.
B	MB	7.4.10	A3-FRAME

Scale on A3 sheet	N/A
Dimensions	N/A

DO NOT STAMP 'MASTER' UNTIL ALL WORK IS FULLY CADDED

Rev	Design	Drawn	Chkd	Appd	Description	Date
C	NH	NH	CW	NGB	AS BUILT.	06.06.00
D	IM	WJB	AD	CT	ZINC DISSOLVER PHR & MMN IMPROVEMENTS	. .
E				CT	PLANT 3 ESD CABINET MODS C10265039V	29.01.21

Designed	NH
Drawn	NH
Checked	CW
Approved	NGB
Date	29.03.00
Cad Reference	10265-P3-088

HIMA–SELLA LIMITED © HIMA-SELLA

Title : LOOP DRAWING - INPUTS
ICI SYNETIX SCHEDULE - No.3 AND No.7 PLANTS
FISHER-ROSEMOUNTP.O. No. 99003994

Contract/ Drawing No	C10265H-P3	088	REV	E

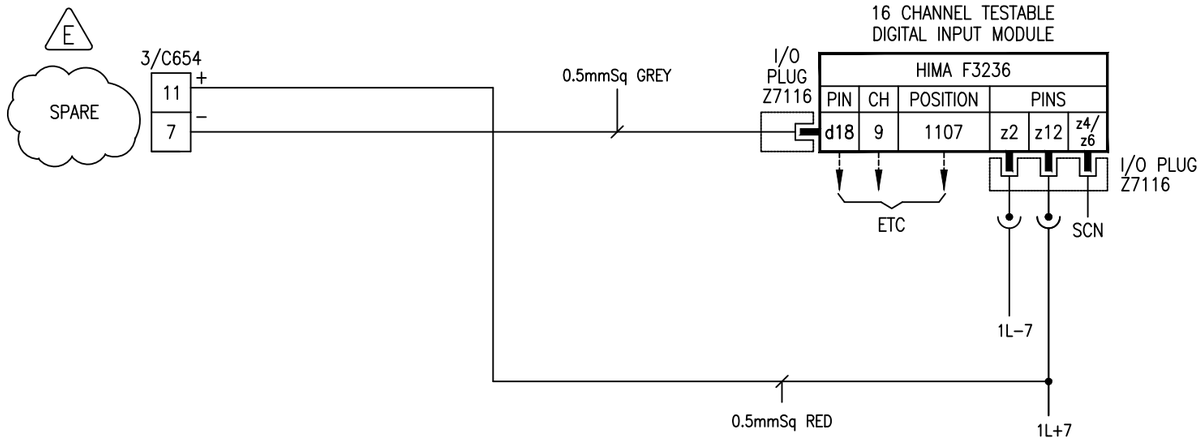

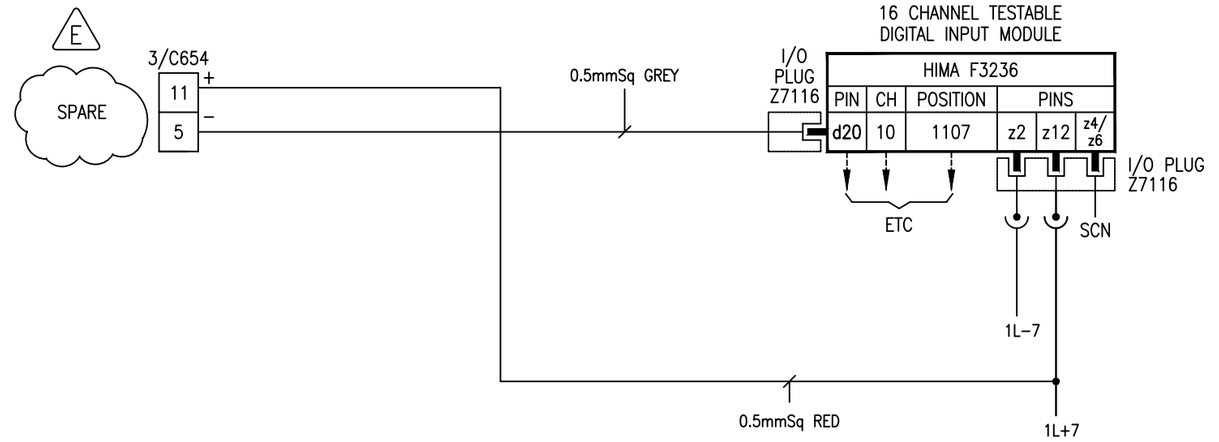

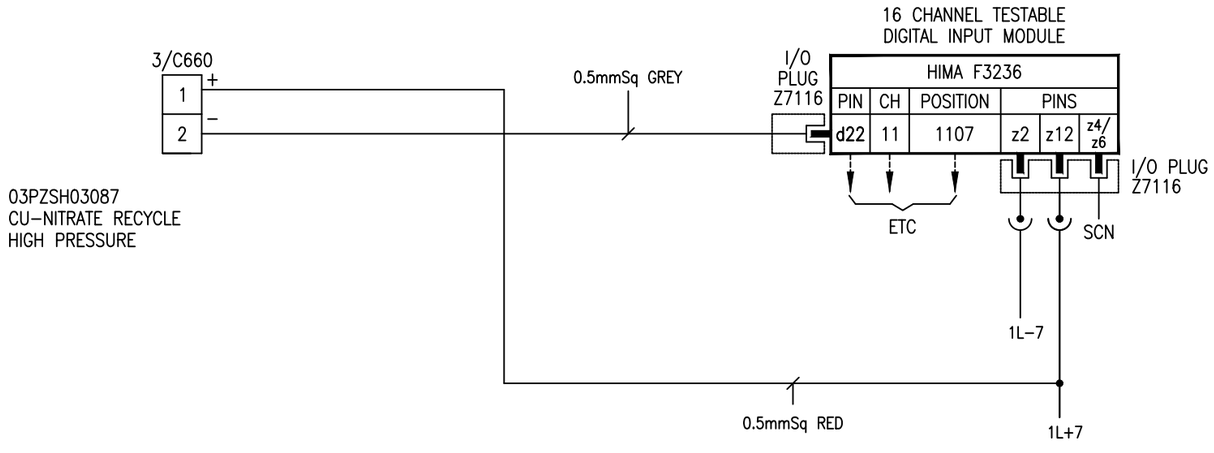

03PZSH03087
CU–NITRATE RECYCLE
HIGH PRESSURE

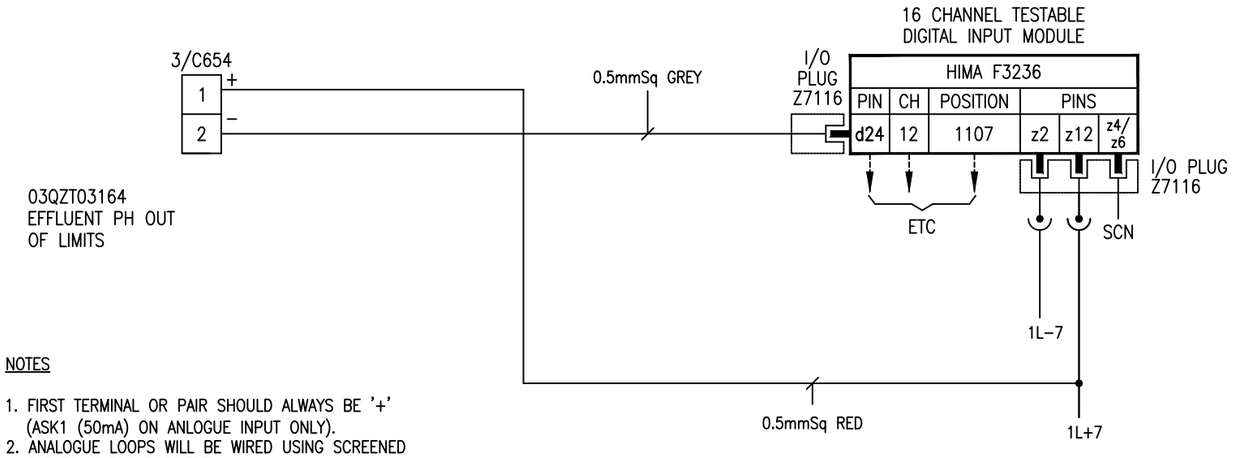

03QZT03164
EFFLUENT PH OUT
OF LIMITS

NOTES

1. FIRST TERMINAL OR PAIR SHOULD ALWAYS BE '+' (ASK1 (50mA) ON ANLOGUE INPUT ONLY).
2. ANALOGUE LOOPS WILL BE WIRED USING SCREENED CABLES WHERE POSSIBLE.
3. ALL WIRING TO BE TRI–RATED.
4. COMPENSATING CABLES FOR TYPE 'K' THERMOCOUPLES WITH COLD JUNCTION. COMPENSATION PROVIDED BY THE SIGNAL CONVERTER WILL BE USED ON ALL TYPES AI4 LOOPS.
5. L– FOR ALL REMOTE ANNUNCIATORS IS DELIVERED FROM THE ESD 24VDC SUPPLY.
6. WIRE No.s ARE DEFINED USING CARD POSITION / CHANNEL NUMBER.

THIS DRAWING IS THE PROPERTY OF HIMA-SELLA LIMITED AND IS LOANED IN CONFIDENCE FOR USE WITH OUR WORK. IT IS NOT TO BE REPRODUCED IN ANY MANNER, SUBMITTED TO OUTSIDE PARTIES FOR EXAMINATION OR USED DIRECTLY OR INDIRECTLY FOR PURPOSES OTHER THAN THOSE FOR WHICH IT WAS FURNISHED WITHOUT WRITTEN CONSENT.

Template Revision – For Office Records Only

REV	AUTH	DATE	CAD TEMPLATE REF.
B	MB	7.4.10	A3-FRAME

Scale on A3 sheet	N/A
Dimensions	N/A

DO NOT STAMP 'MASTER' UNTIL ALL WORK IS FULLY CADDED

Rev	Design	Drawn	Chkd	Appd	Description	Date
C	NH	NH	CW	NGB	AS BUILT.	06.06.00
D	NH	NH	CW	NGB	TEXT ADDED	14.10.11
E				CT	ZINC DISSOLVER PHR & MMN IMPROVEMENTS	20.02.14

Designed	NH
Drawn	NH
Checked	CW
Approved	NGB
Date	29.03.00
Cad Reference	10265-P3-089

HIMA–SELLA LIMITED © HIMA-SELLA

Title : LOOP DRAWING - INPUTS
ICI SYNETIX SCHEDULE - No.3 AND No.7 PLANTS
FISHER-ROSEMOUNTP.O. No. 99003994

Contract/ Drawing No	C10265H-P3	089	REV	E

50 100 150 200 250 300 350 400

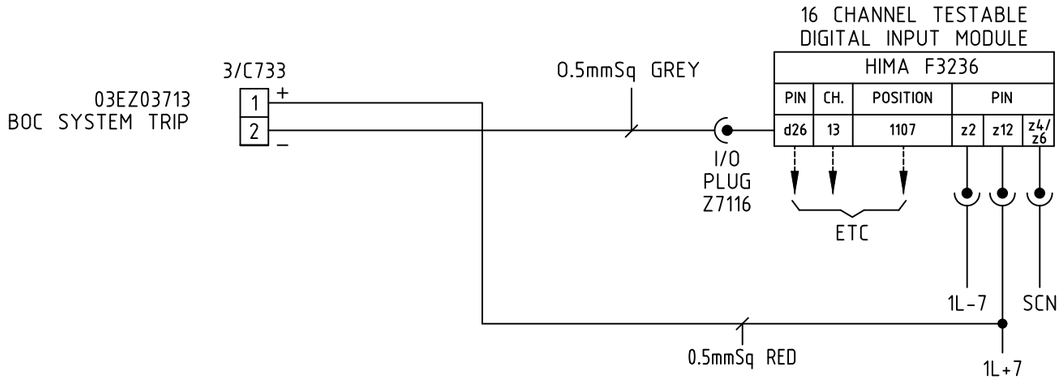

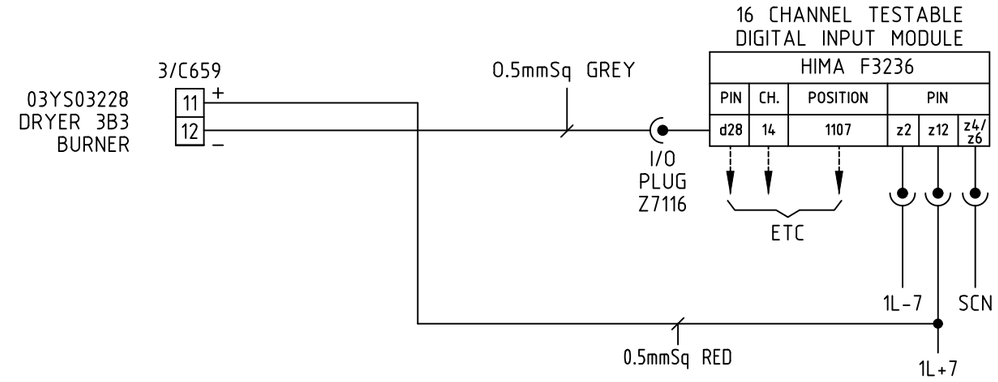

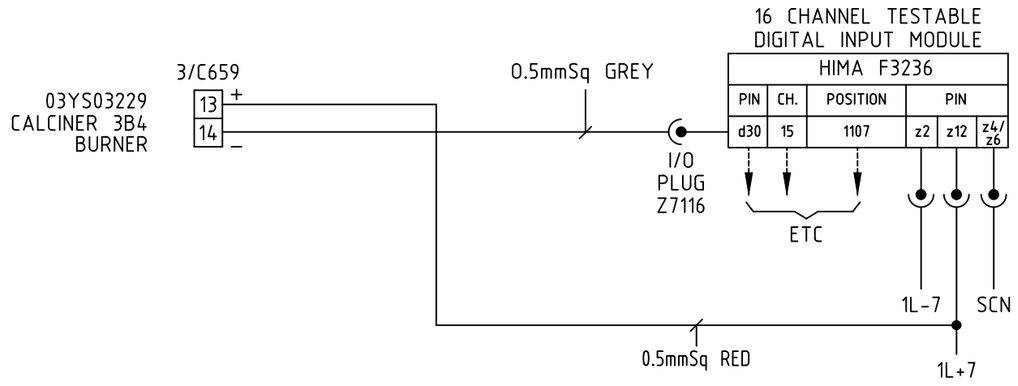

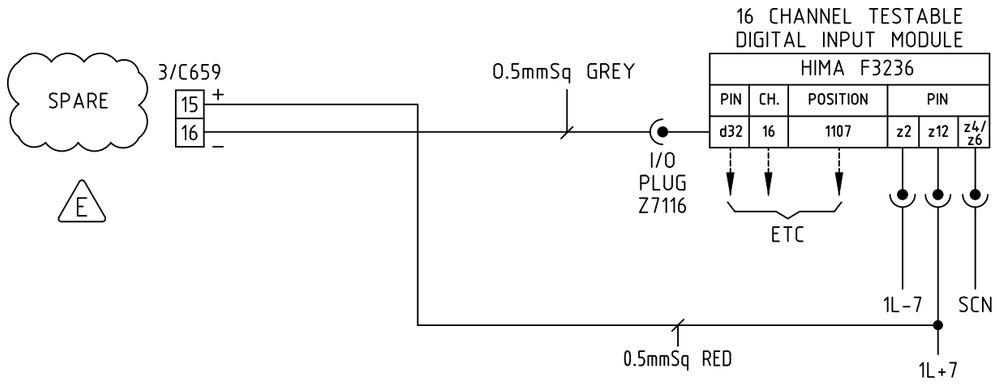

NOTES
1. FIRST TERMINAL OF PAIR SHOULD ALWAYS BE '+' (ASK1 (50mA) ON ANALOGUE INPUTS ONLY).
2. ANALOGUE LOOPS WILL BE WIRED USING SCREENED CABLES WHERE POSSIBLE.
3. ALL WIRING TO BE TRI-RATED.
4. COMPENSATING CABLES FOR TYPE 'K' THERMOCOUPLES WITH COLD JUNCTION.
   COMPENSATION PROVIDED BY THE SIGNAL CONVERTOR WILL BE USED ON ALL TYPE AI4 LOOPS.
5. L- FOR ALL REMOTE ANNUNCIATORS IS DERIVED FROM THE ESD 24Vdc SUPPLY.
6. WIRE No.s ARE DEFINED USING CARD POSITION/CHANNEL NUMBER.

THIS DRAWING IS THE PROPERTY OF HIMA-SELLA LIMITED AND IS LOANED IN CONFIDENCE FOR USE WITH OUR WORK. IT IS NOT TO BE REPRODUCED IN ANY MANNER, SUBMITTED TO OUTSIDE PARTIES FOR EXAMINATION OR USED DIRECTLY OR INDIRECTLY FOR PURPOSES OTHER THAN THOSE FOR WHICH IT WAS FURNISHED WITHOUT WRITTEN CONSENT.

Template Revision – For Office Records Only

REV	AUTH	DATE	CAD TEMPLATE REF.
B	MB	7.4.10	A3-FRAME

Scale on A3 sheet	N/A
Dimensions	N/A

DO NOT STAMP 'MASTER' UNTIL ALL WORK IS FULLY CADDED

Rev	Design	Drawn	Chkd	Appd	Description	Date
C	NH	NH	CW	NGB	AS BUILT.	06.06.00
D	IM	WJB	AD	CT	TEXT ADDED	14.10.11
E				CT	PLANT 3 ESD CABINET MODS C10265039V	29.01.21

Designed	NH
Drawn	NH
Checked	CW
Approved	NGB
Date	29.03.00
Cad Reference	10265-P3-090

HIMA–SELLA LIMITED © HIMA-SELLA

Title : LOOP DRAWING - INPUTS
ICI SYNETIX SCHEDULE - No.3 AND No.7 PLANTS
FISHER-ROSEMOUNTP.O. No. 99003994

Contract/ Drawing No	C10265H-P3	090	REV	E

50 100 150 200 250 300 350 400

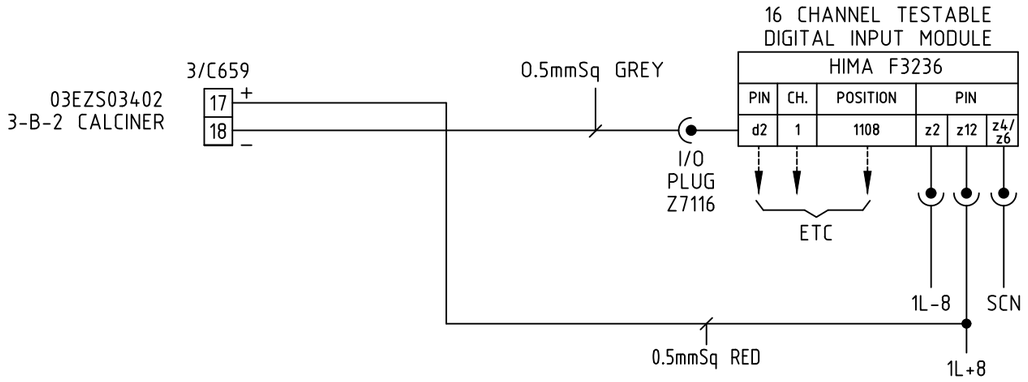

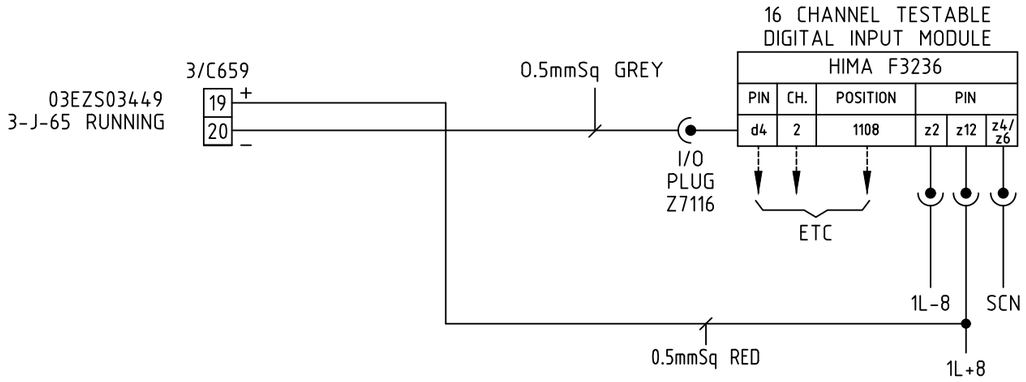

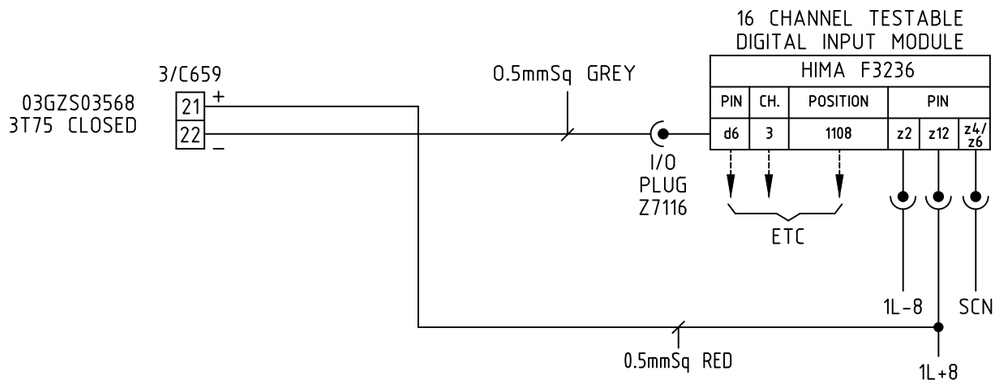

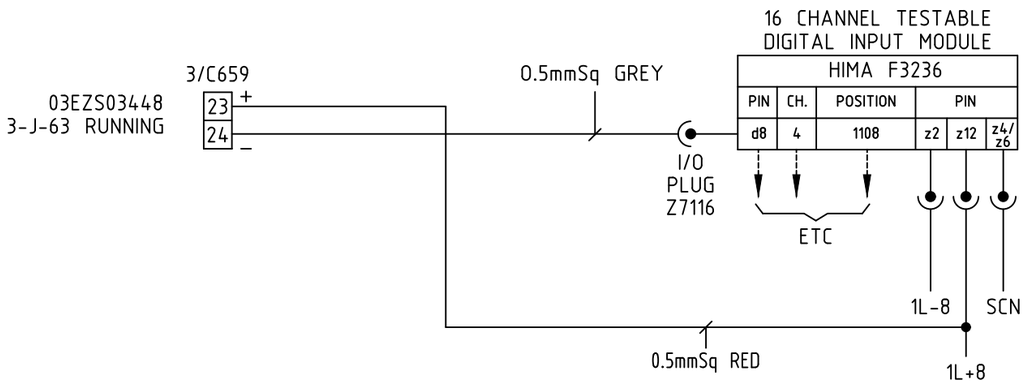

NOTES
1. FIRST TERMINAL OF PAIR SHOULD ALWAYS BE '+' (ASK1 (50mA) ON ANALOGUE INPUTS ONLY).
2. ANALOGUE LOOPS WILL BE WIRED USING SCREENED CABLES WHERE POSSIBLE.
3. ALL WIRING TO BE TRI-RATED.
4. COMPENSATING CABLES FOR TYPE 'K' THERMOCOUPLES WITH COLD JUNCTION.
   COMPENSATION PROVIDED BY THE SIGNAL CONVERTOR WILL BE USED ON ALL TYPE AI4 LOOPS.
5. L- FOR ALL REMOTE ANNUNCIATORS IS DERIVED FROM THE ESD 24Vdc SUPPLY.
6. WIRE No.s ARE DEFINED USING CARD POSITION/CHANNEL NUMBER.

THIS DRAWING IS THE PROPERTY OF HIMA-SELLA LIMITED AND IS LOANED IN CONFIDENCE FOR USE WITH OUR WORK. IT IS NOT TO BE REPRODUCED IN ANY MANNER, SUBMITTED TO OUTSIDE PARTIES FOR EXAMINATION OR USED DIRECTLY OR INDIRECTLY FOR PURPOSES OTHER THAN THOSE FOR WHICH IT WAS FURNISHED WITHOUT WRITTEN CONSENT.

Template Revision – For Office Records Only

REV	AUTH	DATE	CAD TEMPLATE REF.
B	MB	7.4.10	A3-FRAME

Scale on A3 sheet	N/A
Dimensions	N/A

DO NOT STAMP 'MASTER' UNTIL ALL WORK IS FULLY CADDED

Rev	Design	Drawn	Chkd	Appd	Description	Date
C	NH	NH	CW	NGB	AS BUILT.	06.06.00
.					. . .	. .

Designed	NH
Drawn	NH
Checked	CW
Approved	NGB
Date	29.03.00
Cad Reference	10265-P3-091

HIMA–SELLA LIMITED © HIMA-SELLA

Title : LOOP DRAWING - INPUTS
ICI SYNETIX SCHEDULE - No.3 AND No.7 PLANTS
FISHER-ROSEMOUNTP.O. No. 99003994

Contract/ Drawing No	C10265H-P3	091	REV	C

50 100 150 200 250 300 350 400

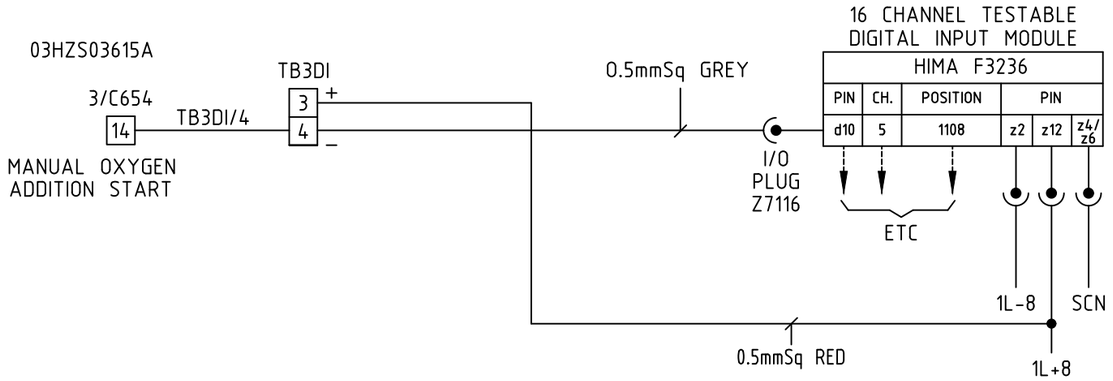

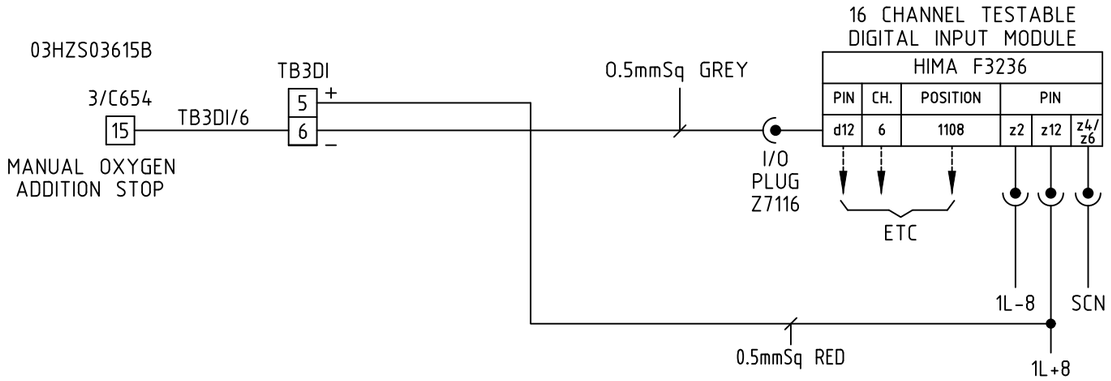

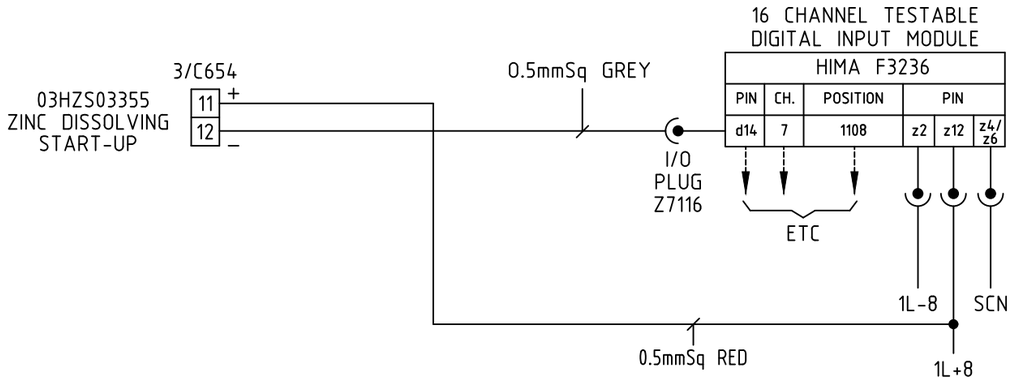

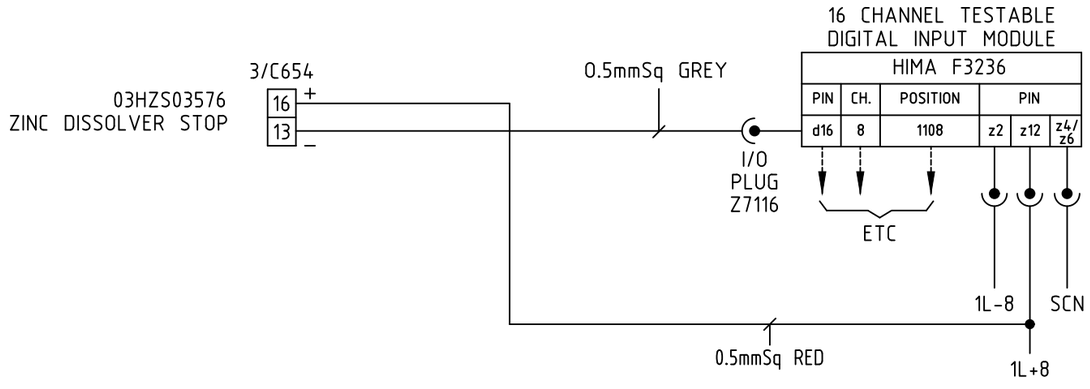

NOTES
1. FIRST TERMINAL OF PAIR SHOULD ALWAYS BE '+' (ASK1 (50mA) ON ANALOGUE INPUTS ONLY).
2. ANALOGUE LOOPS WILL BE WIRED USING SCREENED CABLES WHERE POSSIBLE.
3. ALL WIRING TO BE TRI-RATED.
4. COMPENSATING CABLES FOR TYPE 'K' THERMOCOUPLES WITH COLD JUNCTION.
   COMPENSATION PROVIDED BY THE SIGNAL CONVERTOR WILL BE USED ON ALL TYPE AI4 LOOPS.
5. L- FOR ALL REMOTE ANNUNCIATORS IS DERIVED FROM THE ESD 24Vdc SUPPLY.
6. WIRE No.s ARE DEFINED USING CARD POSITION/CHANNEL NUMBER.

THIS DRAWING IS THE PROPERTY OF HIMA-SELLA LIMITED AND IS LOANED IN CONFIDENCE FOR USE WITH OUR WORK. IT IS NOT TO BE REPRODUCED IN ANY MANNER, SUBMITTED TO OUTSIDE PARTIES FOR EXAMINATION OR USED DIRECTLY OR INDIRECTLY FOR PURPOSES OTHER THAN THOSE FOR WHICH IT WAS FURNISHED WITHOUT WRITTEN CONSENT.

Template Revision – For Office Records Only

REV	AUTH	DATE	CAD TEMPLATE REF.
B	MB	7.4.10	A3-FRAME

Scale on A3 sheet	N/A
Dimensions	N/A

DO NOT STAMP 'MASTER' UNTIL ALL WORK IS FULLY CADDED

Rev	Design	Drawn	Chkd	Appd	Description	Date
C	NH	NH	CW	NGB	AS BUILT.	06.06.00
D	CP	EJC	CW	NGB	SITE MODS	15.09.00
E					TEXT ADDED	06.10.11

Designed	NH
Drawn	NH
Checked	CW
Approved	NGB
Date	29.03.00
Cad Reference	10265-P3-092

HIMA–SELLA LIMITED © HIMA-SELLA

Title : LOOP DRAWING - INPUTS
ICI SYNETIX SCHEDULE - No.3 AND No.7 PLANTS
FISHER-ROSEMOUNTP.O. No. 99003994

Contract/ Drawing No	C10265H-P3	092	REV	E

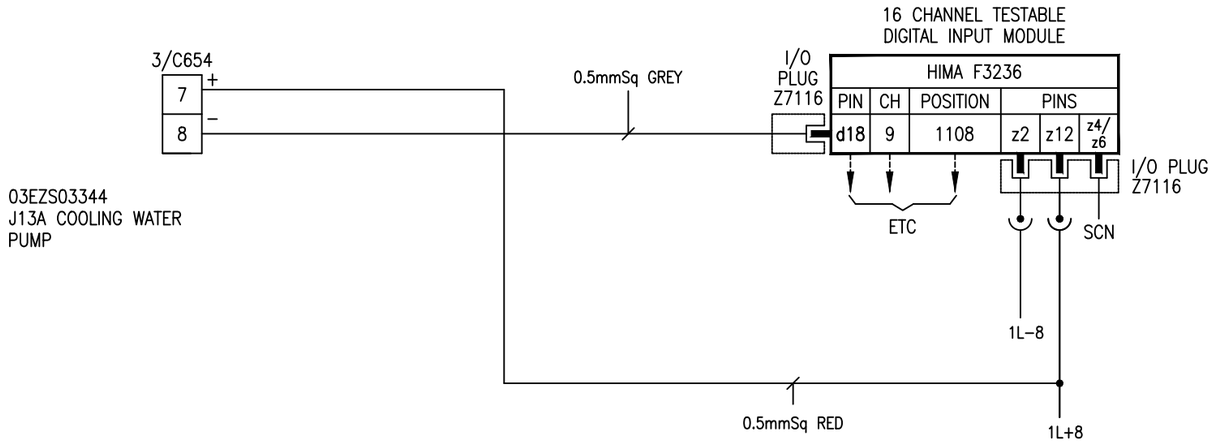

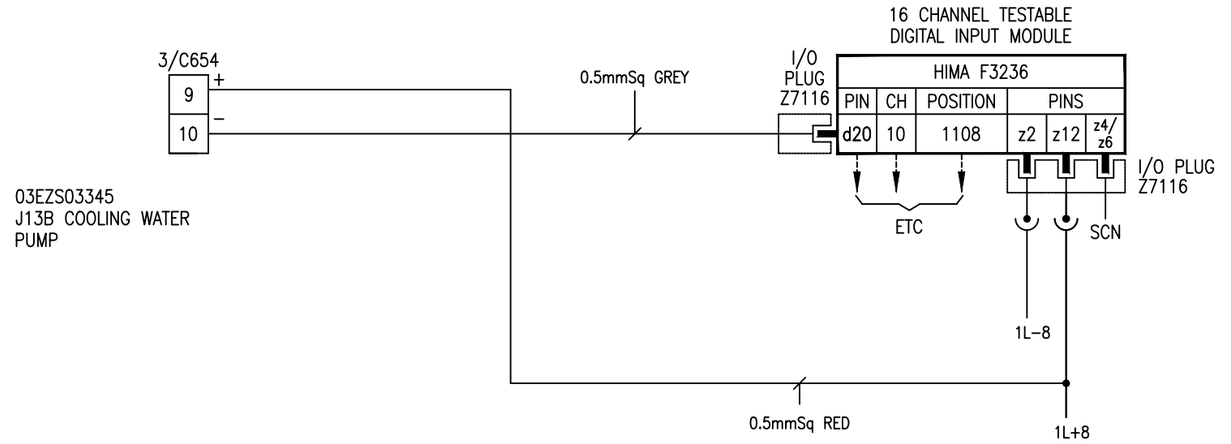

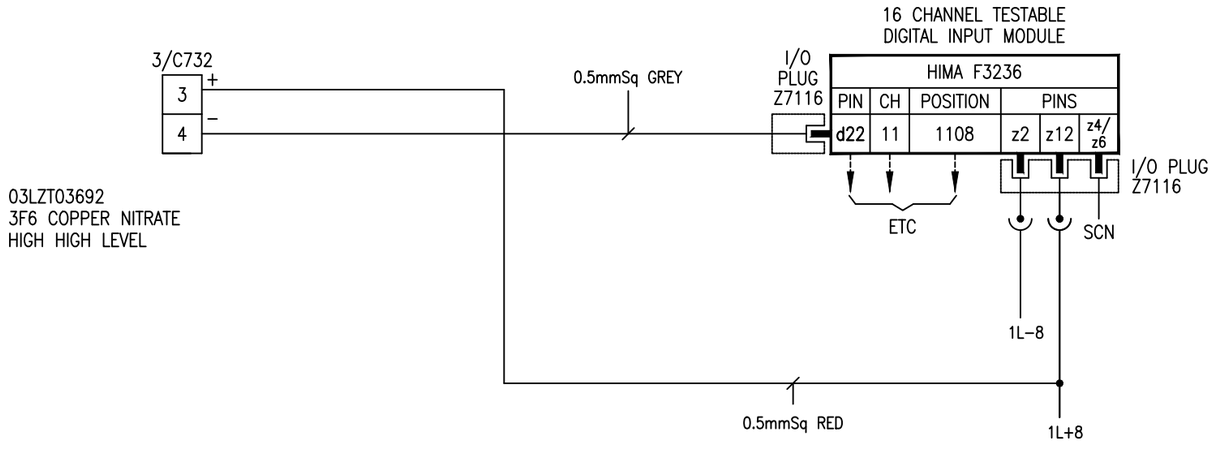

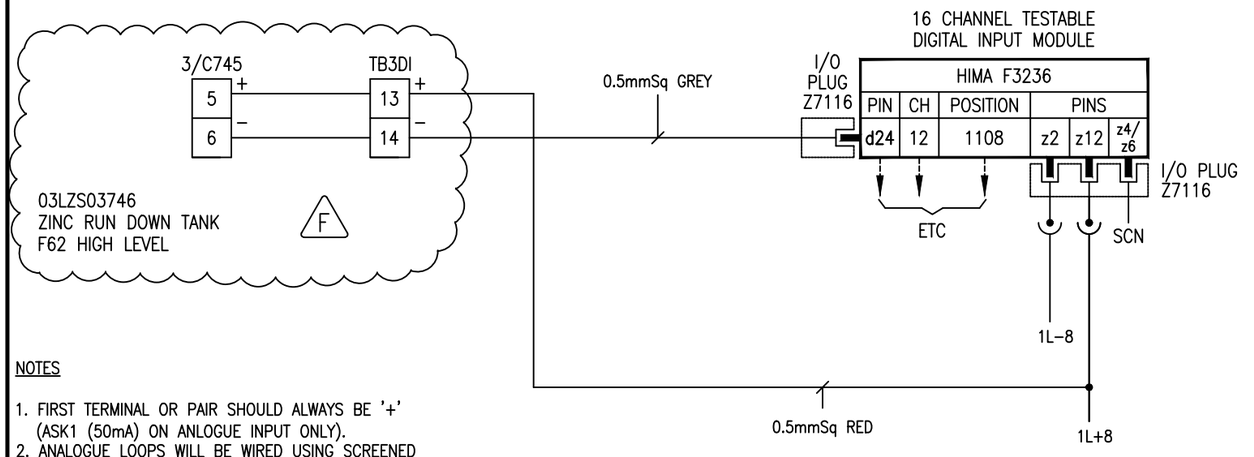

NOTES

1. FIRST TERMINAL OR PAIR SHOULD ALWAYS BE '+' (ASK1 (50mA) ON ANLOGUE INPUT ONLY).
2. ANALOGUE LOOPS WILL BE WIRED USING SCREENED CABLES WHERE POSSIBLE.
3. ALL WIRING TO BE TRI–RATED.
4. COMPENSATING CABLES FOR TYPE 'K' THERMOCOUPLES WITH COLD JUNCTION. COMPENSATION PROVIDED BY THE SIGNAL CONVERTER WILL BE USED ON ALL TYPES AI4 LOOPS.
5. L– FOR ALL REMOTE ANNUNCIATORS IS DELIVERED FROM THE ESD 24VDC SUPPLY.
6. WIRE No.s ARE DEFINED USING CARD POSITION / CHANNEL NUMBER.

THIS DRAWING IS THE PROPERTY OF HIMA-SELLA LIMITED AND IS LOANED IN CONFIDENCE FOR USE WITH OUR WORK. IT IS NOT TO BE REPRODUCED IN ANY MANNER, SUBMITTED TO OUTSIDE PARTIES FOR EXAMINATION OR USED DIRECTLY OR INDIRECTLY FOR PURPOSES OTHER THAN THOSE FOR WHICH IT WAS FURNISHED WITHOUT WRITTEN CONSENT.

Template Revision – For Office Records Only

REV	AUTH	DATE	CAD TEMPLATE REF.
B	MB	7.4.10	A3-FRAME

Scale on A3 sheet	N/A
Dimensions	N/A

DO NOT STAMP 'MASTER' UNTIL ALL WORK IS FULLY CADDED

Rev	Design	Drawn	Chkd	Appd	Description	Date
C	NH	NH	CW	NGB	AS BUILT.	06.06.00
D	IM	AB	IM	MHS	TEXT ADDED	11.08.11
E	IM	AB	IM	MHS	TEXT ADDED	06.10.11
F				CT	ZINC DISSOLVER PHR & MMN IMPROVEMENTS	11.08.11

Designed	NH
Drawn	NH
Checked	CW
Approved	NGB
Date	29.03.00
Cad Reference	10265-P3-093

HIMA–SELLA LIMITED © HIMA-SELLA

Title : LOOP DRAWING - INPUTS
ICI SYNETIX SCHEDULE - No.3 AND No.7 PLANTS
FISHER-ROSEMOUNTP.O. No. 99003994

Contract/ Drawing No	C10265H-P3	093	REV	F

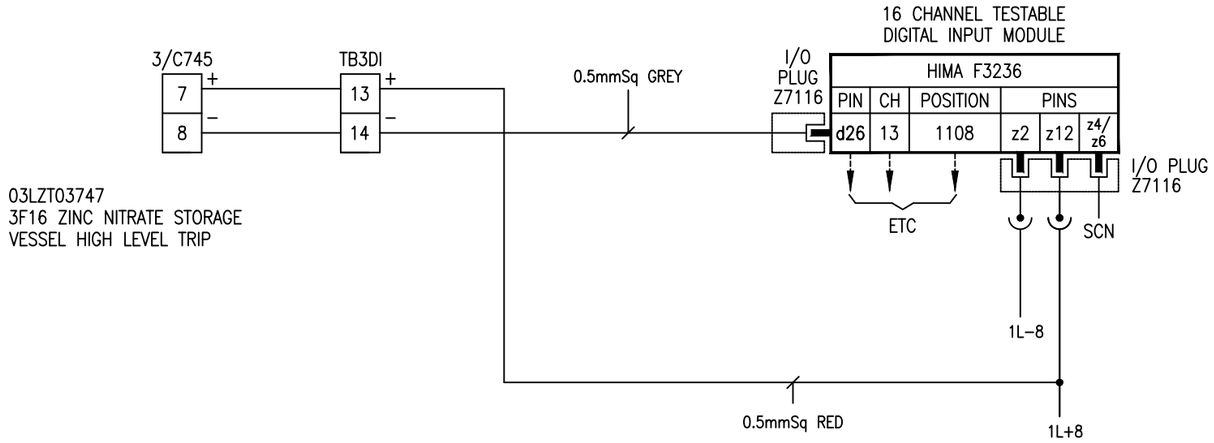

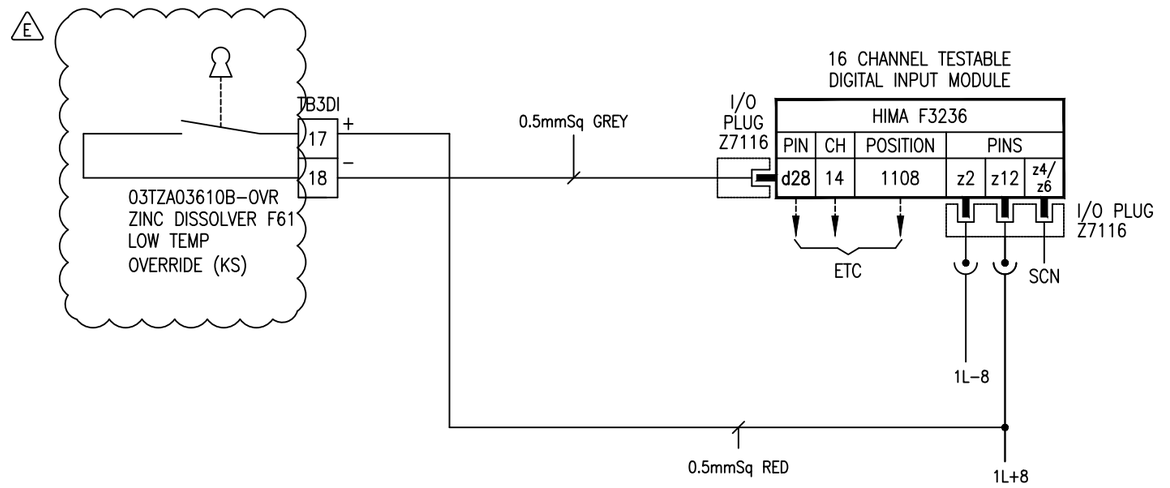

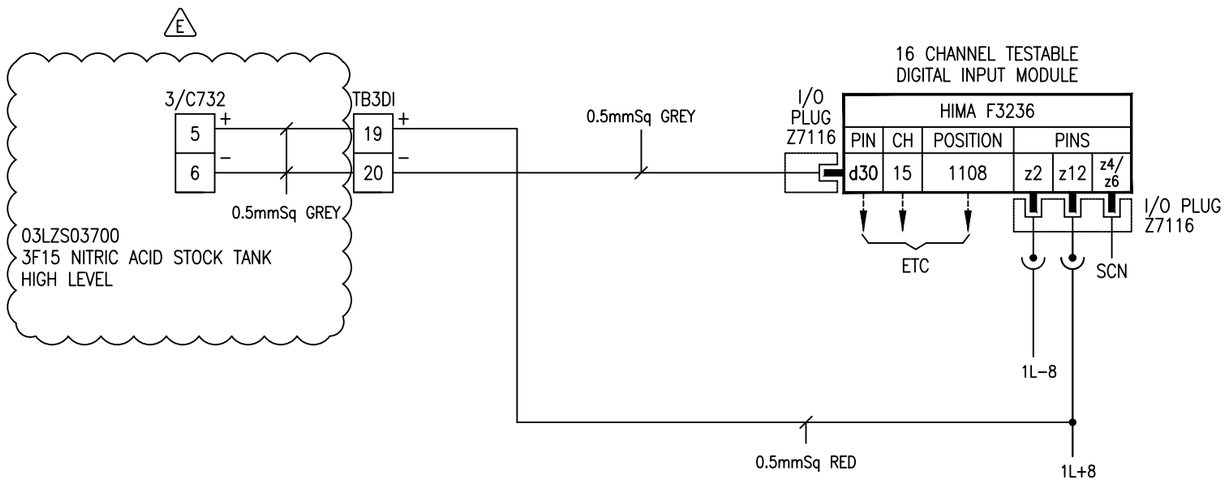

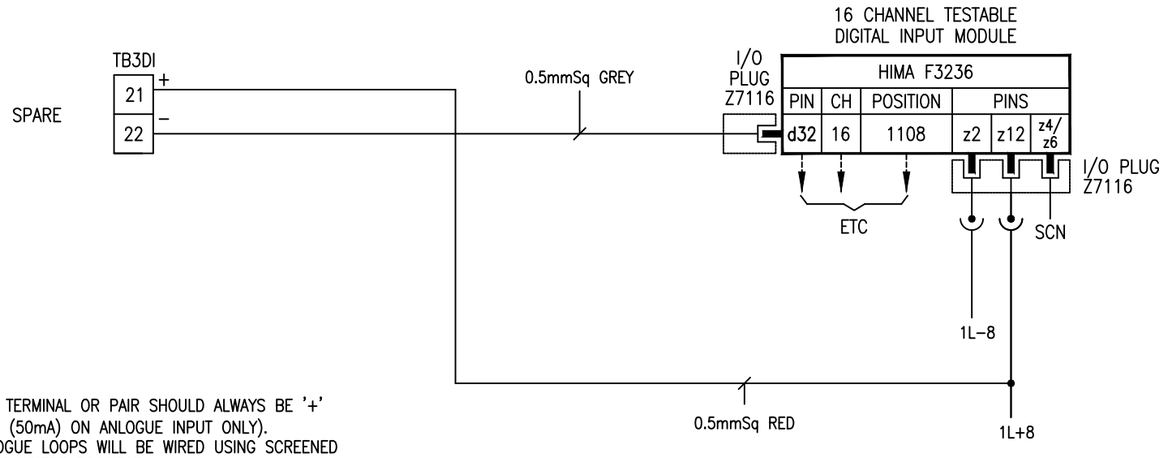

NOTES

1. FIRST TERMINAL OR PAIR SHOULD ALWAYS BE '+' (ASK1 (50mA) ON ANLOGUE INPUT ONLY).
2. ANALOGUE LOOPS WILL BE WIRED USING SCREENED CABLES WHERE POSSIBLE.
3. ALL WIRING TO BE TRI−RATED.
4. COMPENSATING CABLES FOR TYPE 'K' THERMOCOUPLES WITH COLD JUNCTION. COMPENSATION PROVIDED BY THE SIGNAL CONVERTER WILL BE USED ON ALL TYPES AI4 LOOPS.
5. L− FOR ALL REMOTE ANNUNCIATORS IS DELIVERED FROM THE ESD 24VDC SUPPLY.
6. WIRE No.s ARE DEFINED USING CARD POSITION / CHANNEL NUMBER.

THIS DRAWING IS THE PROPERTY OF HIMA-SELLA LIMITED AND IS LOANED IN CONFIDENCE FOR USE WITH OUR WORK. IT IS NOT TO BE REPRODUCED IN ANY MANNER, SUBMITTED TO OUTSIDE PARTIES FOR EXAMINATION OR USED DIRECTLY OR INDIRECTLY FOR PURPOSES OTHER THAN THOSE FOR WHICH IT WAS FURNISHED WITHOUT WRITTEN CONSENT.

Scale on A3 sheet	N/A
Dimensions	N/A

Template Revision – For Office Records Only

REV	AUTH	DATE	CAD TEMPLATE REF.
B	MB	7.4.10	A3-FRAME

DO NOT STAMP 'MASTER' UNTIL ALL WORK IS FULLY CADDED

Rev	Design	Drawn	Chkd	Appd	Description	Date
C	NH	NH	CW	NGB	AS BUILT.	06.06.00
D	DP	WJB	PB	CT	ZINC DISSOLVER PHR & MMN IMPROVEMENTS	20.02.14
E				MDI	PROJECT ARPG-80 MODS TO 3 PLANT ESD SYSTEM	20.03.19

Designed	NH
Drawn	NH
Checked	CW
Approved	NGB
Date	29.03.00
Cad Reference	10265-P3-094

HIMA−SELLA LIMITED © HIMA-SELLA

Title : LOOP DRAWING - INPUTS
ICI SYNETIX SCHEDULE - No.3 AND No.7 PLANTS
FISHER-ROSEMOUNTP.O. No. 99003994

Contract/ Drawing No	C10265H-P3	094	REV	E

50 100 150 200 250 300 350 400

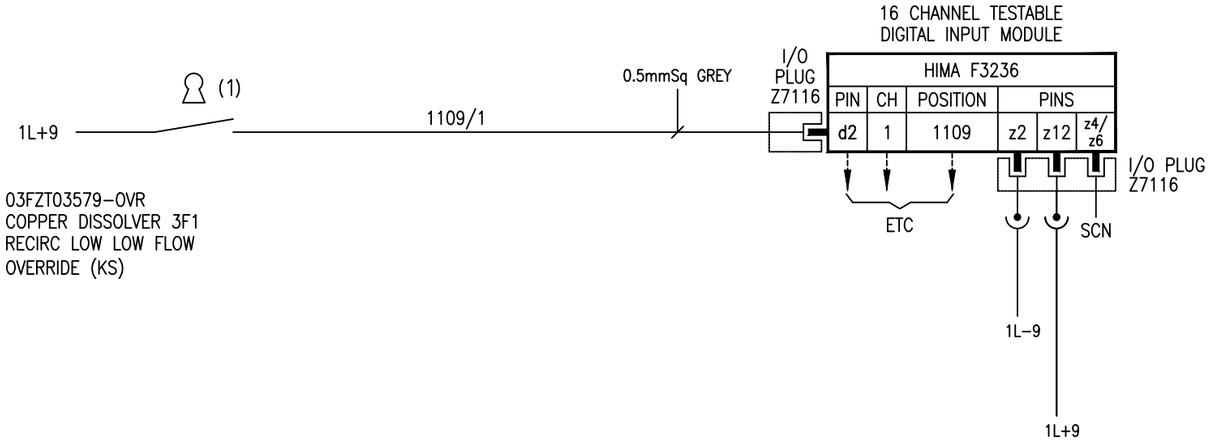

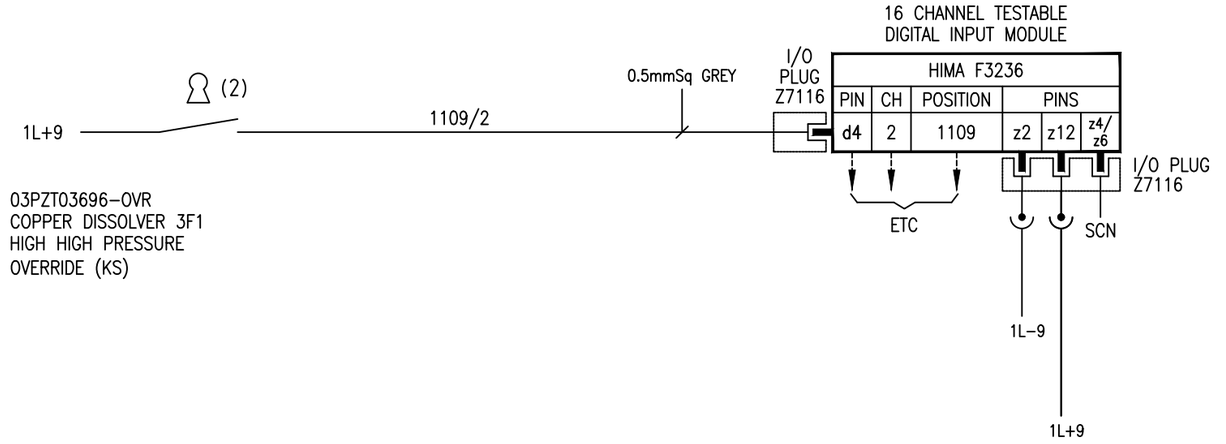

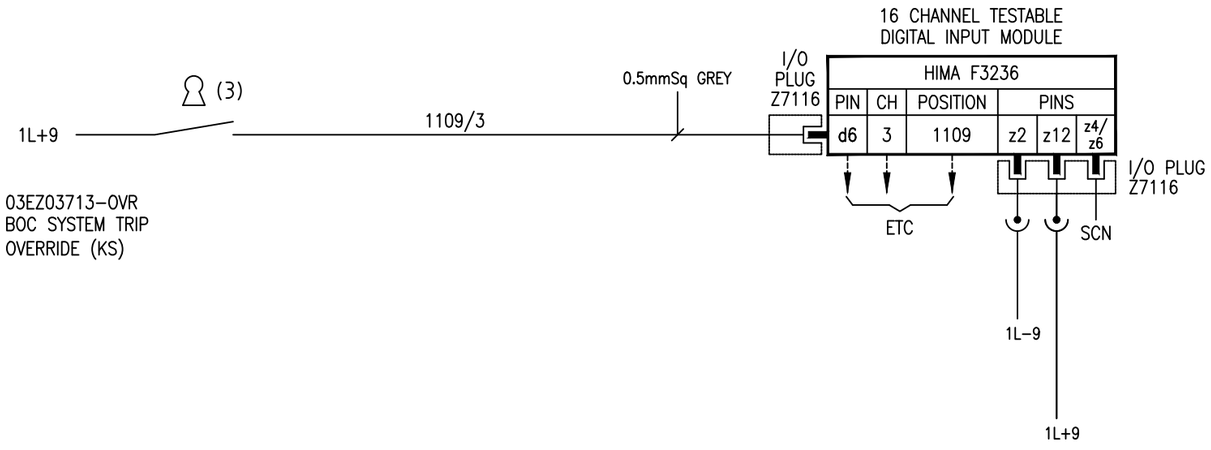

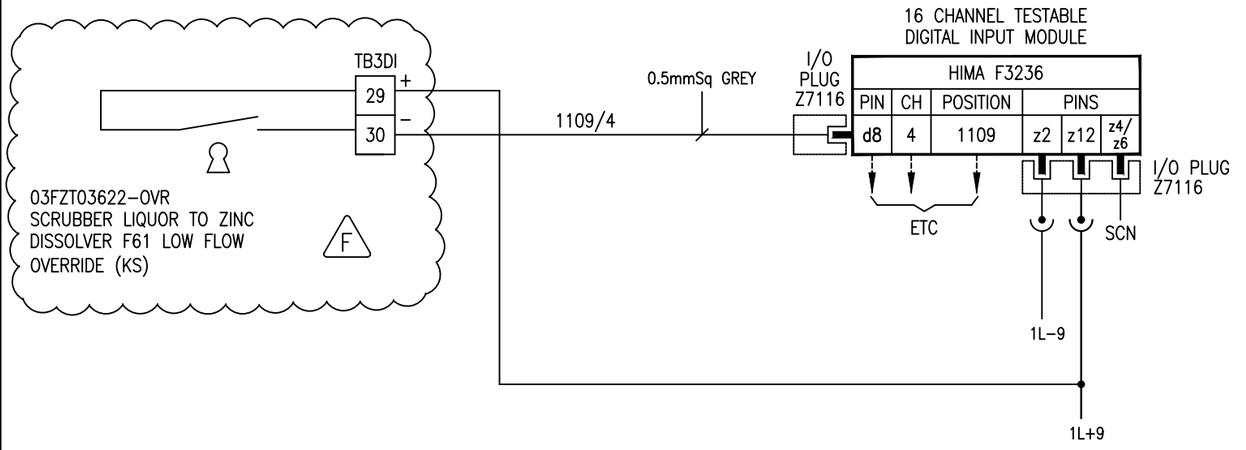

THIS DRAWING IS THE PROPERTY OF HIMA-SELLA LIMITED AND IS LOANED IN CONFIDENCE FOR USE WITH OUR WORK. IT IS NOT TO BE REPRODUCED IN ANY MANNER, SUBMITTED TO OUTSIDE PARTIES FOR EXAMINATION OR USED DIRECTLY OR INDIRECTLY FOR PURPOSES OTHER THAN THOSE FOR WHICH IT WAS FURNISHED WITHOUT WRITTEN CONSENT.

Template Revision – For Office Records Only

REV	AUTH	DATE	CAD TEMPLATE REF.
0	AB	18.07.11	A3-FRAME

Scale on A3 sheet	N/A
Dimensions	N/A

DO NOT STAMP 'MASTER' UNTIL ALL WORK IS FULLY CADDED

Rev	Design	Drawn	Chkd	Appd	Description	Date
C	NH	NH	CW	NGB	AS BUILT.	06.06.00
D	IM	AB	IM	MHS	TEXT ADDED	11.08.11
E	IM	AB	IM	MHS	TEXT ADDED	06.10.11
F				CT	ZINC DISSOLVER PHR MMN IMPROVEMENTS	21.02.14

Designed	NH
Drawn	NH
Checked	CW
Approved	NGB
Date	29.03.00
Cad Reference	10265-P3-095

HIMA–SELLA LIMITED © HIMA-SELLA

Title : LOOP DRAWING - INPUTS
ICI SYNETIX SCHEDULE - No.3 AND No.7 PLANTS
FISHER-ROSEMOUNTP.O. No. 99003994

Contract/ Drawing No	C10265H-P3	095	REV	F

50 100 150 200 250 300 350 400

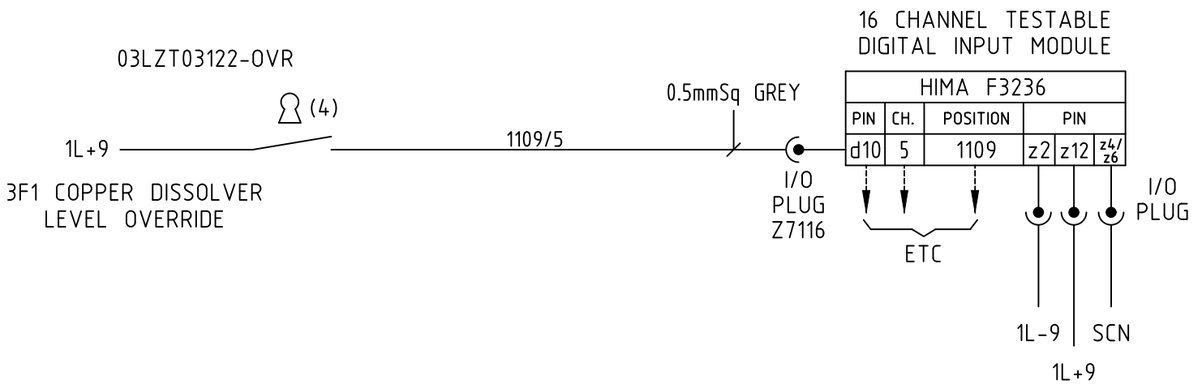

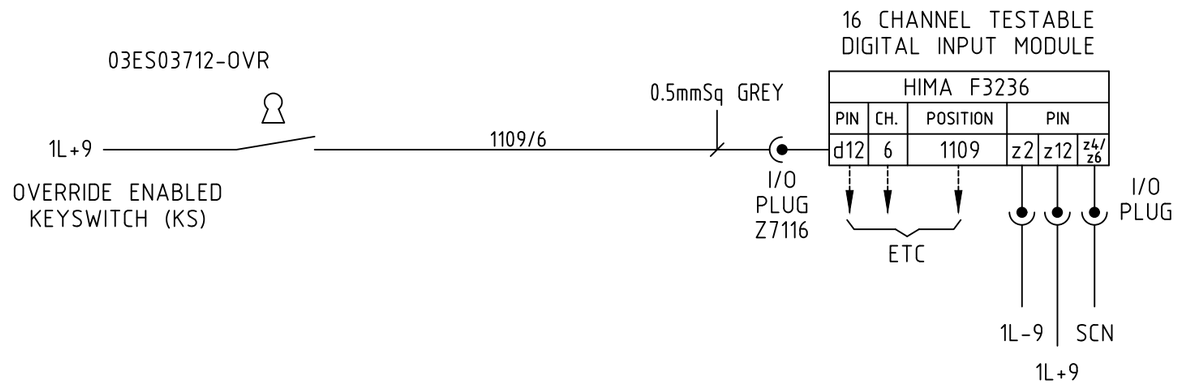

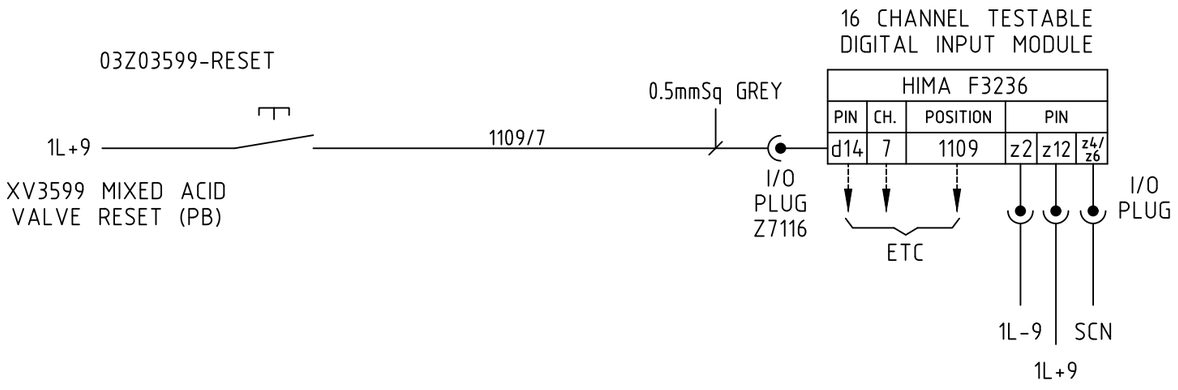

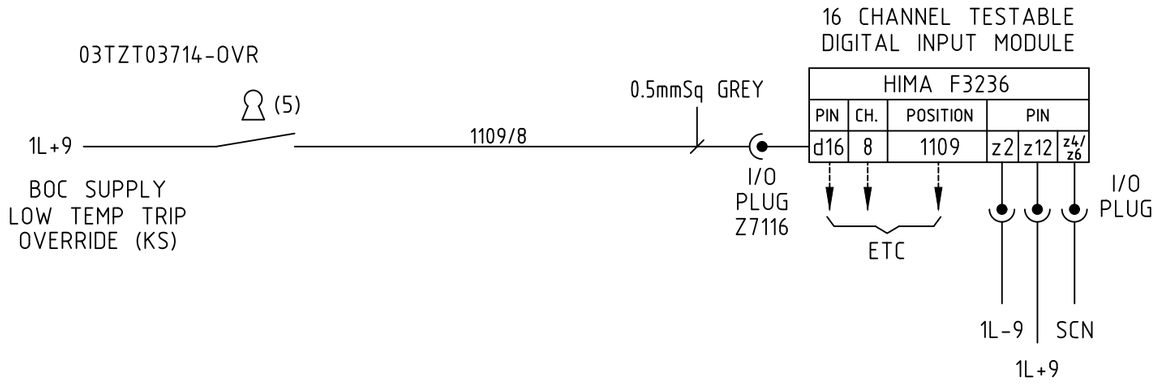

NOTES
1. FIRST TERMINAL OF PAIR SHOULD ALWAYS BE '+' (ASK1 (50mA) ON ANALOGUE INPUTS ONLY).
2. ANALOGUE LOOPS WILL BE WIRED USING SCREENED CABLES WHERE POSSIBLE.
3. ALL WIRING TO BE TRI-RATED.
4. COMPENSATING CABLES FOR TYPE 'K' THERMOCOUPLES WITH COLD JUNCTION.
   COMPENSATION PROVIDED BY THE SIGNAL CONVERTOR WILL BE USED ON ALL TYPE AI4 LOOPS.
5. L- FOR ALL REMOTE ANNUNCIATORS IS DERIVED FROM THE ESD 24Vdc SUPPLY.
6. WIRE No.s ARE DEFINED USING CARD POSITION/CHANNEL NUMBER.

THIS DRAWING IS THE PROPERTY OF HIMA-SELLA LIMITED AND IS LOANED IN CONFIDENCE FOR USE WITH OUR WORK. IT IS NOT TO BE REPRODUCED IN ANY MANNER, SUBMITTED TO OUTSIDE PARTIES FOR EXAMINATION OR USED DIRECTLY OR INDIRECTLY FOR PURPOSES OTHER THAN THOSE FOR WHICH IT WAS FURNISHED WITHOUT WRITTEN CONSENT.

Template Revision – For Office Records Only

REV	AUTH	DATE	CAD TEMPLATE REF.
0	AB	18.07.11	A3-FRAME

Scale on A3 sheet	N/A
Dimensions	N/A

DO NOT STAMP 'MASTER' UNTIL ALL WORK IS FULLY CADDED

Rev	Design	Drawn	Chkd	Appd	Description	Date
C	NH	NH	CW	NGB	AS BUILT.	06.06.00
D	IM	AB	IM	MHS	TEXT ADDED	11.08.11
E					TEXT ADDED	06.10.11

Designed	NH
Drawn	NH
Checked	CW
Approved	NGB
Date	29.03.00
Cad Reference	10265-P3-096

HIMA–SELLA LIMITED © HIMA-SELLA

Title : LOOP DRAWING - INPUTS
ICI SYNETIX SCHEDULE - No.3 AND No.7 PLANTS
FISHER-ROSEMOUNTP.O. No. 99003994

Contract/ Drawing No	C10265H-P3	096	REV	E

50 100 150 200 250 300 350 400

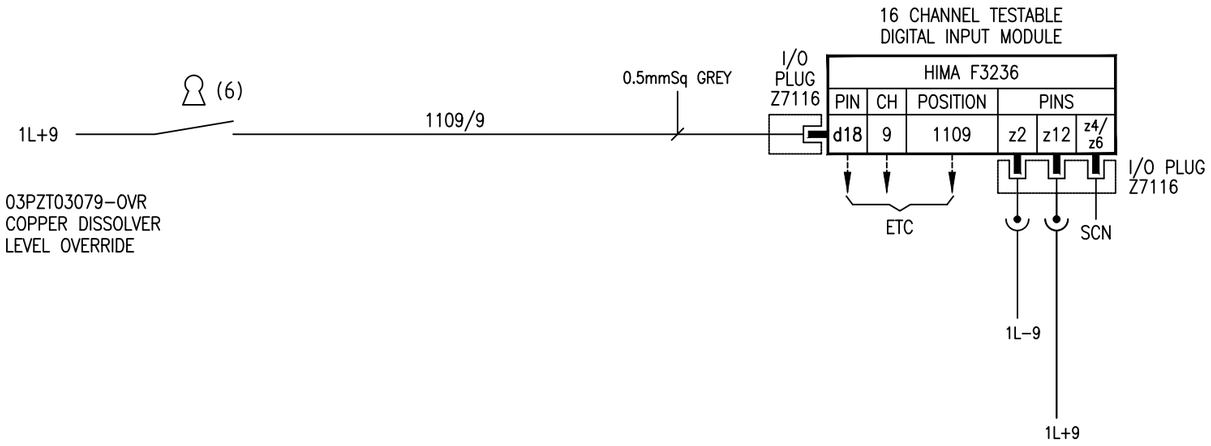

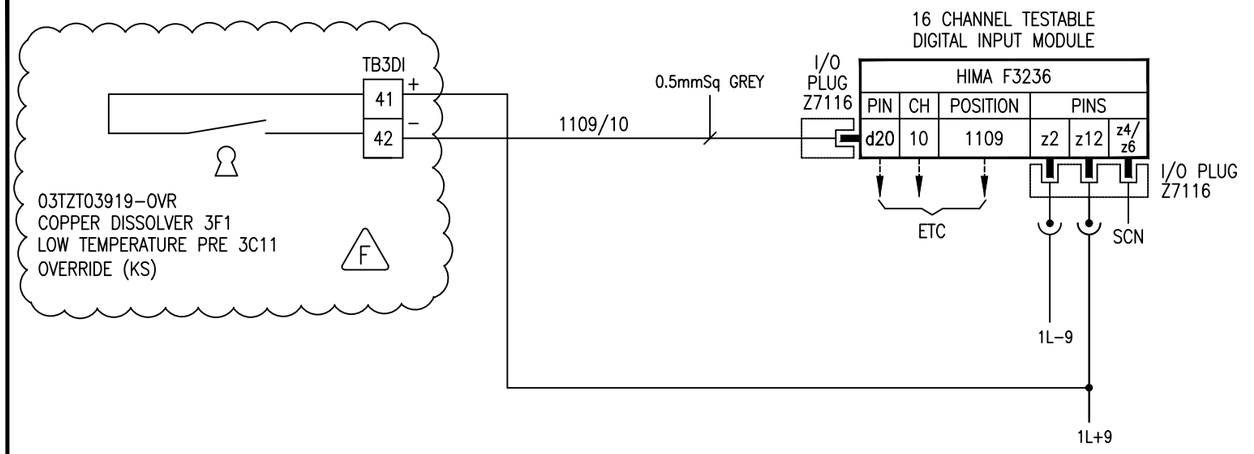

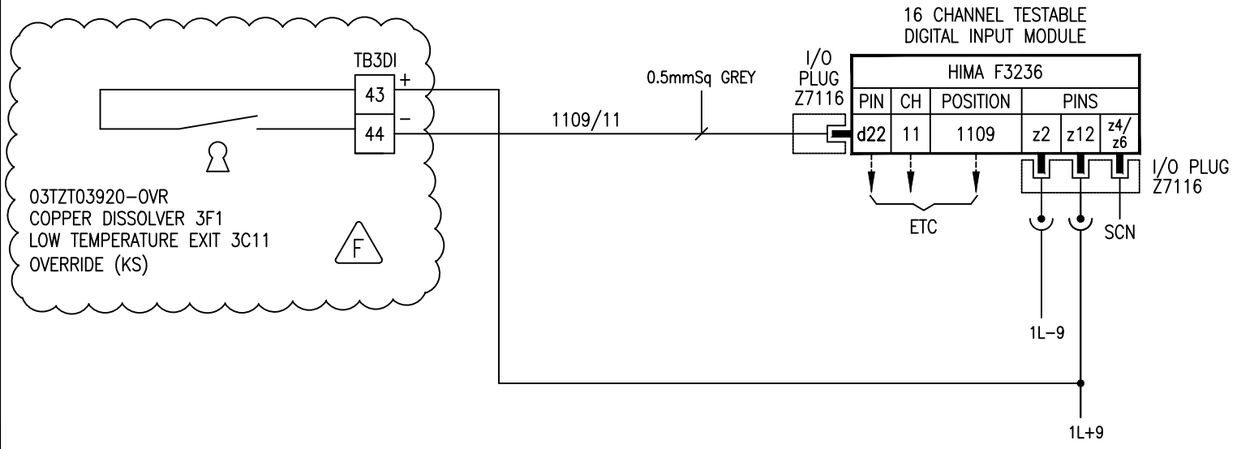

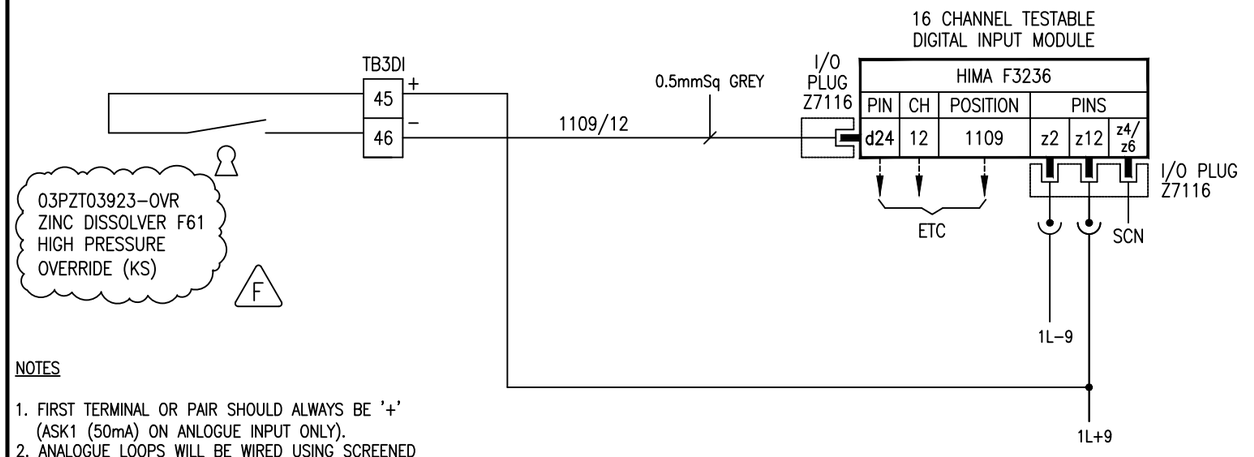

NOTES

1. FIRST TERMINAL OR PAIR SHOULD ALWAYS BE '+' (ASK1 (50mA) ON ANLOGUE INPUT ONLY).
2. ANALOGUE LOOPS WILL BE WIRED USING SCREENED CABLES WHERE POSSIBLE.
3. ALL WIRING TO BE TRI-RATED.
4. COMPENSATING CABLES FOR TYPE 'K' THERMOCOUPLES WITH COLD JUNCTION. COMPENSATION PROVIDED BY THE SIGNAL CONVERTER WILL BE USED ON ALL TYPES AI4 LOOPS.
5. L- FOR ALL REMOTE ANNUNCIATORS IS DELIVERED FROM THE ESD 24VDC SUPPLY.
6. WIRE No.s ARE DEFINED USING CARD POSITION / CHANNEL NUMBER.

THIS DRAWING IS THE PROPERTY OF HIMA-SELLA LIMITED AND IS LOANED IN CONFIDENCE FOR USE WITH OUR WORK. IT IS NOT TO BE REPRODUCED IN ANY MANNER, SUBMITTED TO OUTSIDE PARTIES FOR EXAMINATION OR USED DIRECTLY OR INDIRECTLY FOR PURPOSES OTHER THAN THOSE FOR WHICH IT WAS FURNISHED WITHOUT WRITTEN CONSENT.

Template Revision – For Office Records Only

REV	AUTH	DATE	CAD TEMPLATE REF.
0	AB	18.07.11	A3-FRAME

Scale on A3 sheet	N/A
Dimensions	N/A

DO NOT STAMP 'MASTER' UNTIL ALL WORK IS FULLY CADDED

Rev	Design	Drawn	Chkd	Appd	Description	Date
C	NH	NH	CW	NGB	AS BUILT.	06.06.00
D	IM	AB	IM	MHS	TEXT ADDED	11.08.11
E	IM	AB	IM	MHS	TEXT ADDED	11.08.11
F				CT	ZINC DISSOLVER PHR MMN IMPROVEMENTS	21.02.14

Designed	NH
Drawn	NH
Checked	CW
Approved	NGB
Date	29.03.00
Cad Reference	10265-P3-097

HIMA-SELLA LIMITED © HIMA-SELLA

Title : LOOP DRAWING - INPUTS
ICI SYNETIX SCHEDULE - No.3 AND No.7 PLANTS
FISHER-ROSEMOUNTP.O. No. 99003994

Contract/ Drawing No	C10265H-P3	097	REV	F

50 100 150 200 250 300 350 400

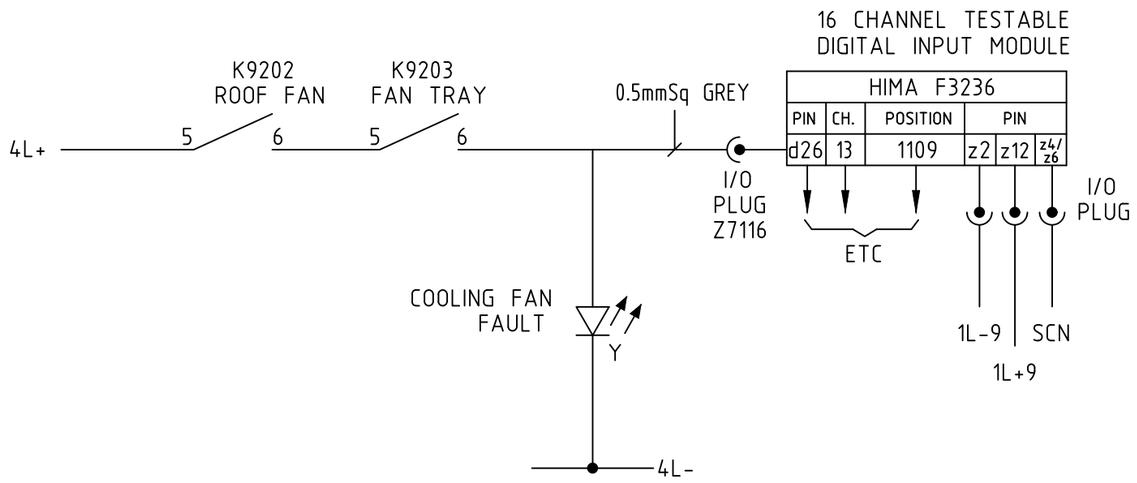

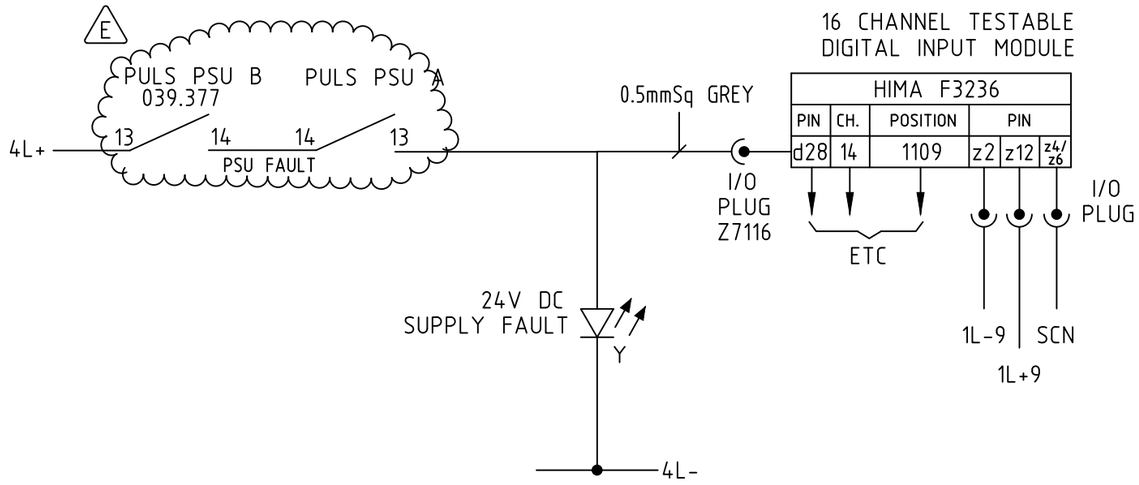

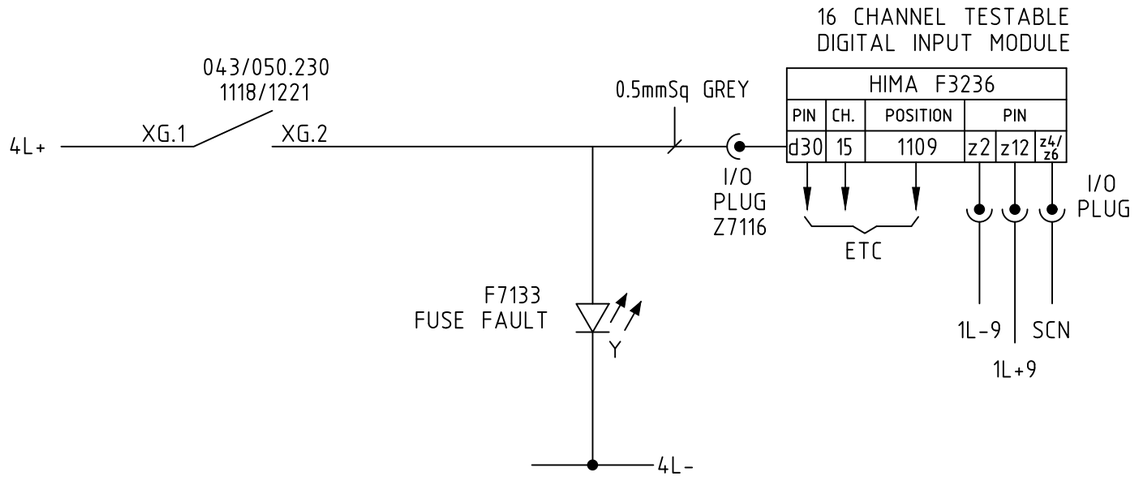

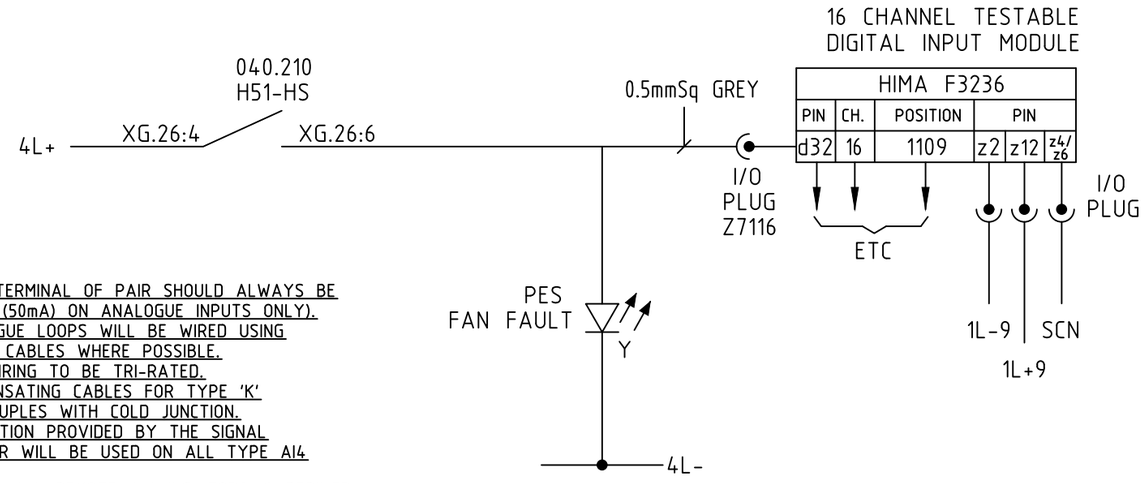

NOTES
1. FIRST TERMINAL OF PAIR SHOULD ALWAYS BE '+' (ASK1 (50mA) ON ANALOGUE INPUTS ONLY).
2. ANALOGUE LOOPS WILL BE WIRED USING SCREENED CABLES WHERE POSSIBLE.
3. ALL WIRING TO BE TRI-RATED.
4. COMPENSATING CABLES FOR TYPE 'K' THERMOCOUPLES WITH COLD JUNCTION. COMPENSATION PROVIDED BY THE SIGNAL CONVERTOR WILL BE USED ON ALL TYPE AI4 LOOPS.
5. L- FOR ALL REMOTE ANNUNCIATORS IS DERIVED FROM THE ESD 24Vdc SUPPLY.
6. WIRE No.s ARE DEFINED USING CARD POSITION/CHANNEL NUMBER.

THIS DRAWING IS THE PROPERTY OF HIMA-SELLA LIMITED AND IS LOANED IN CONFIDENCE FOR USE WITH OUR WORK. IT IS NOT TO BE REPRODUCED IN ANY MANNER, SUBMITTED TO OUTSIDE PARTIES FOR EXAMINATION OR USED DIRECTLY OR INDIRECTLY FOR PURPOSES OTHER THAN THOSE FOR WHICH IT WAS FURNISHED WITHOUT WRITTEN CONSENT.

Template Revision – For Office Records Only

REV	AUTH	DATE	CAD TEMPLATE REF.
0	AB	18.07.11	A3-FRAME

Scale on A3 sheet	N/A
Dimensions	N/A

DO NOT STAMP 'MASTER' UNTIL ALL WORK IS FULLY CADDED

Rev	Design	Drawn	Chkd	Appd	Description	Date
C	NH	NH	CW	NGB	AS BUILT.	06.06.00
D	DP	HG	CT	CT	PLANT 3/7 RACK UPGRADE AS PER C10265035V	01.05.19
E				CT	AS BUILT AS PER C10265035V	27.07.19

Designed	NH
Drawn	NH
Checked	CW
Approved	NGB
Date	29.03.00
Cad Reference	10265-P3-098

HIMA–SELLA LIMITED © HIMA-SELLA

Title : LOOP DRAWING - INPUTS
ICI SYNETIX SCHEDULE - No.3 AND No.7 PLANTS
FISHER-ROSEMOUNTP.O. No. 99003994

Contract/ Drawing No	C10265H-P3	098	REV	E

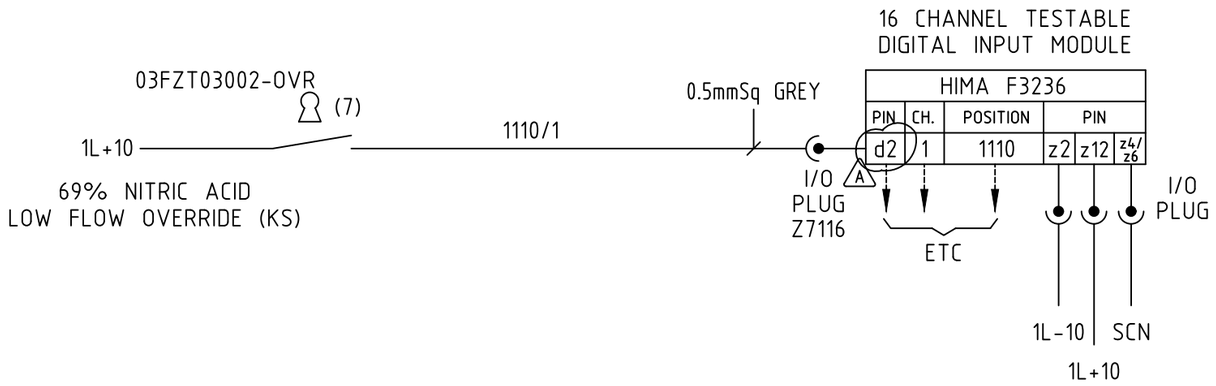

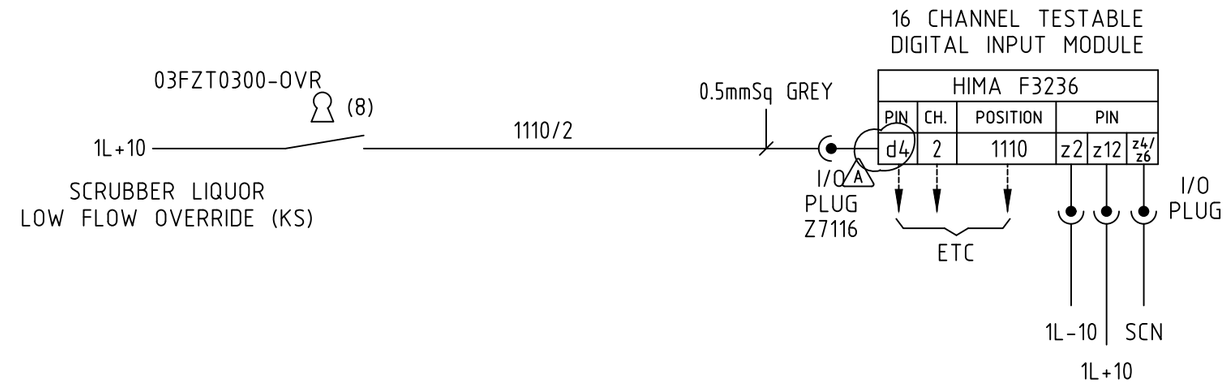

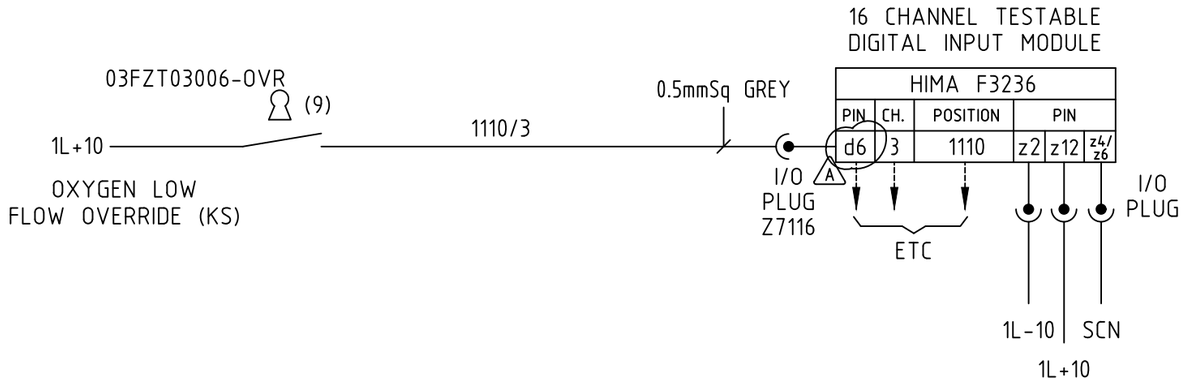

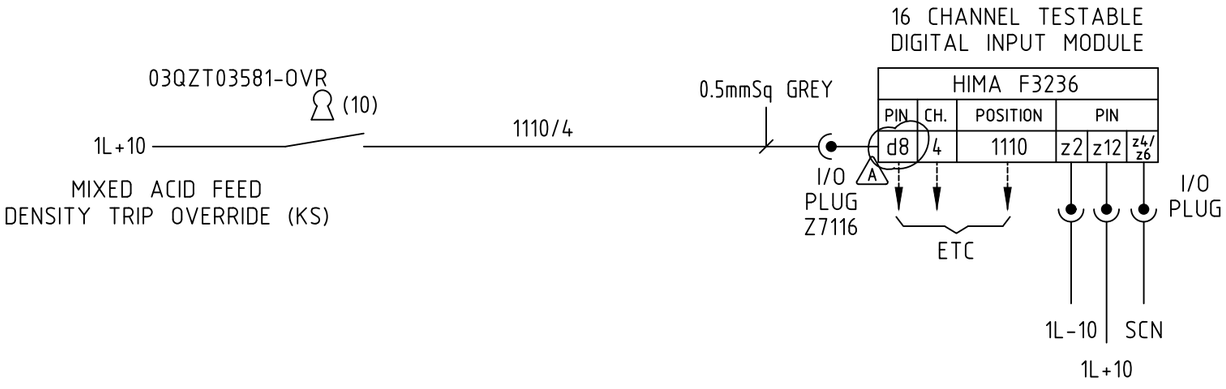

THIS DRAWING IS THE PROPERTY OF HIMA-SELLA LIMITED AND IS LOANED IN CONFIDENCE FOR USE WITH OUR WORK. IT IS NOT TO BE REPRODUCED IN ANY MANNER, SUBMITTED TO OUTSIDE PARTIES FOR EXAMINATION OR USED DIRECTLY OR INDIRECTLY FOR PURPOSES OTHER THAN THOSE FOR WHICH IT WAS FURNISHED WITHOUT WRITTEN CONSENT.

Template Revision – For Office Records Only

REV	AUTH	DATE	CAD TEMPLATE REF.
0	AB	18.07.11	A3-FRAME

Scale on A3 sheet	N/A
Dimensions	N/A

DO NOT STAMP 'MASTER' UNTIL ALL WORK IS FULLY CADDED

Rev	Design	Drawn	Chkd	Appd	Description	Date
A					PIN NUMBER CORRECTED & TEXT ADDED	06.10.11
.					. . .	. .

Designed	IM
Drawn	AB
Checked	IM
Approved	MHS
Date	11.08.11
Cad Reference	10265-P3-099

HIMA–SELLA LIMITED © HIMA-SELLA

Title : LOOP DRAWING - OUTPUTS
ICI SYNETIX SCHEDULE - No.3 AND No.7 PLANTS
FISHER-ROSEMOUNTP.O. No. 99003994

Contract/ Drawing No	C10265H-P3	099	REV	A

50 100 150 200 250 300 350 400

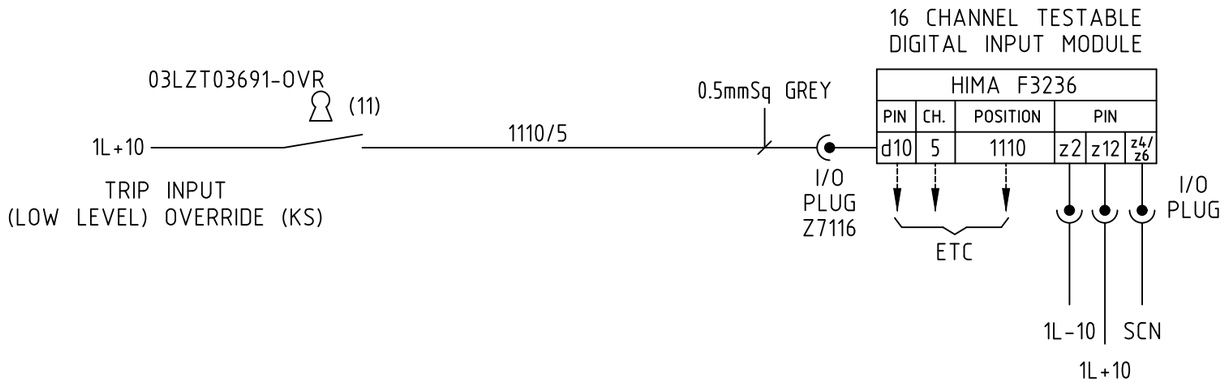

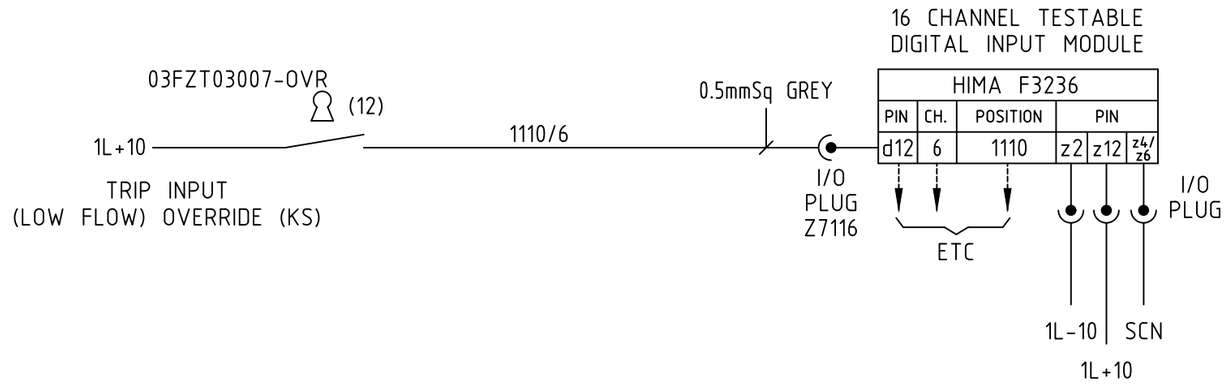

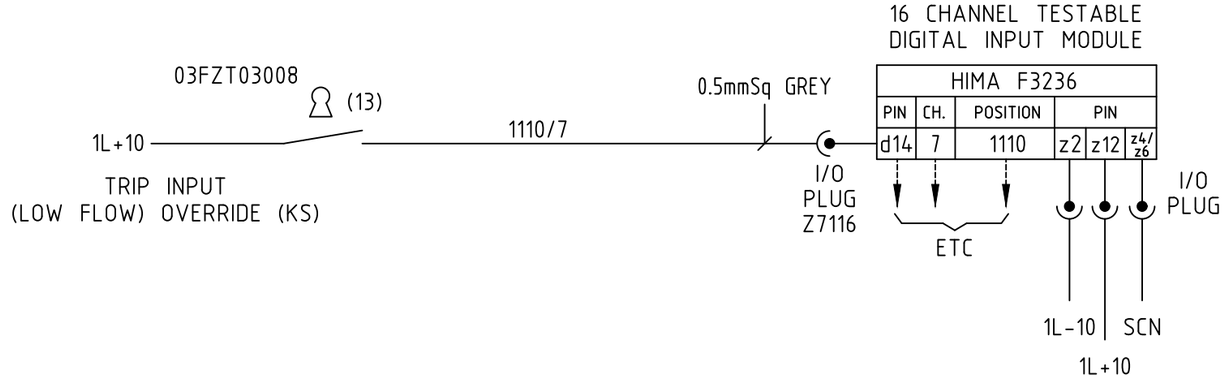

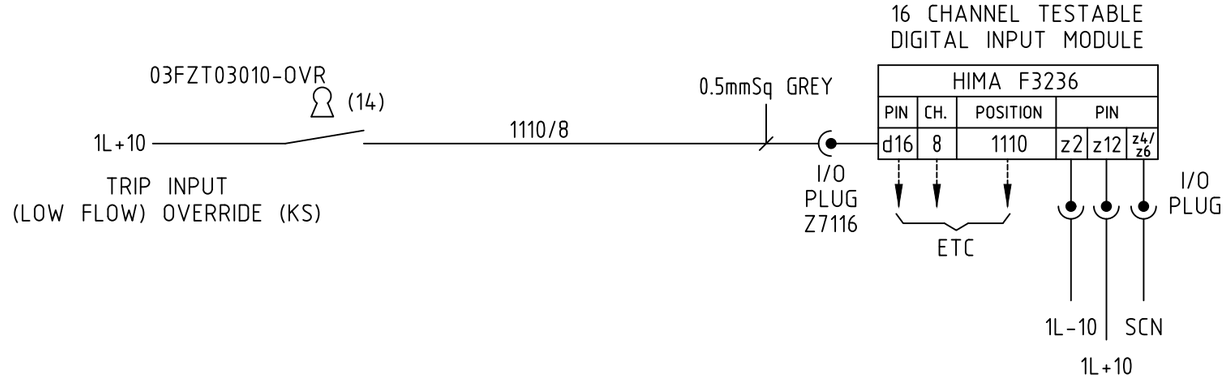

THIS DRAWING IS THE PROPERTY OF HIMA-SELLA LIMITED AND IS LOANED IN CONFIDENCE FOR USE WITH OUR WORK. IT IS NOT TO BE REPRODUCED IN ANY MANNER, SUBMITTED TO OUTSIDE PARTIES FOR EXAMINATION OR USED DIRECTLY OR INDIRECTLY FOR PURPOSES OTHER THAN THOSE FOR WHICH IT WAS FURNISHED WITHOUT WRITTEN CONSENT.

Template Revision – For Office Records Only

REV	AUTH	DATE	CAD TEMPLATE REF.
0	AB	18.07.11	A3-FRAME

Scale on A3 sheet	N/A
Dimensions	N/A

DO NOT STAMP 'MASTER' UNTIL ALL WORK IS FULLY CADDED

Rev	Design	Drawn	Chkd	Appd	Description	Date
A					PIN NUMBER CORRECTED & TEXT ADDED	06.10.11
.					. . .	. .

Designed	IM
Drawn	AB
Checked	IM
Approved	MHS
Date	11.08.11
Cad Reference	10265-P3-100

HIMA–SELLA LIMITED © HIMA-SELLA

Title : LOOP DRAWING - OUTPUTS
ICI SYNETIX SCHEDULE - No.3 AND No.7 PLANTS
FISHER-ROSEMOUNTP.O. No. 99003994

Contract/ Drawing No	C10265H-P3	100	REV	A

50 100 150 200 250 300 350 400

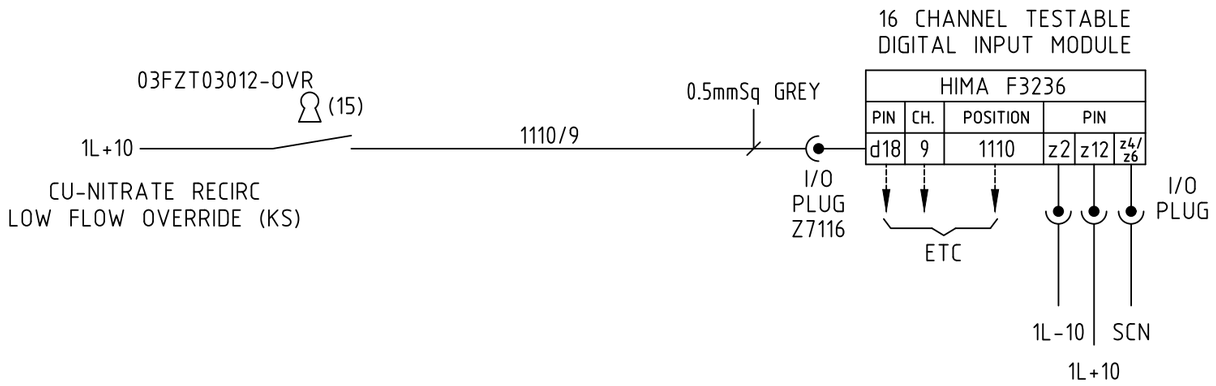

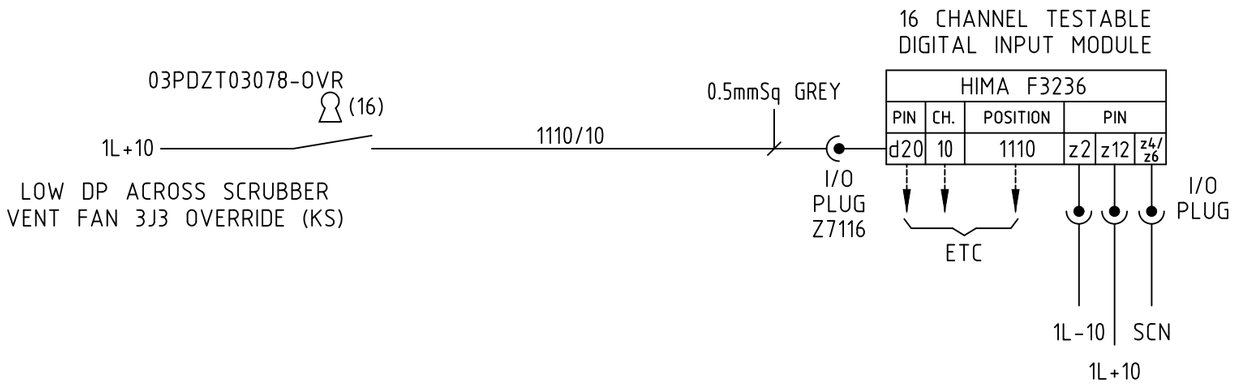

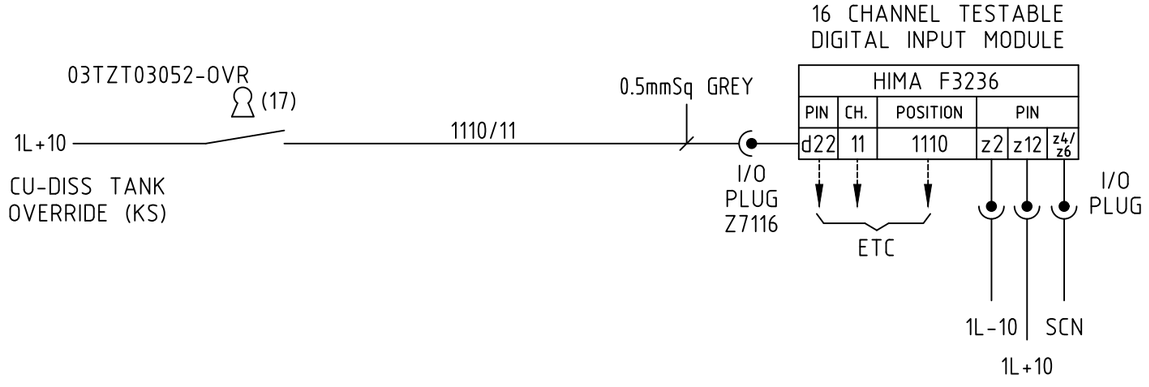

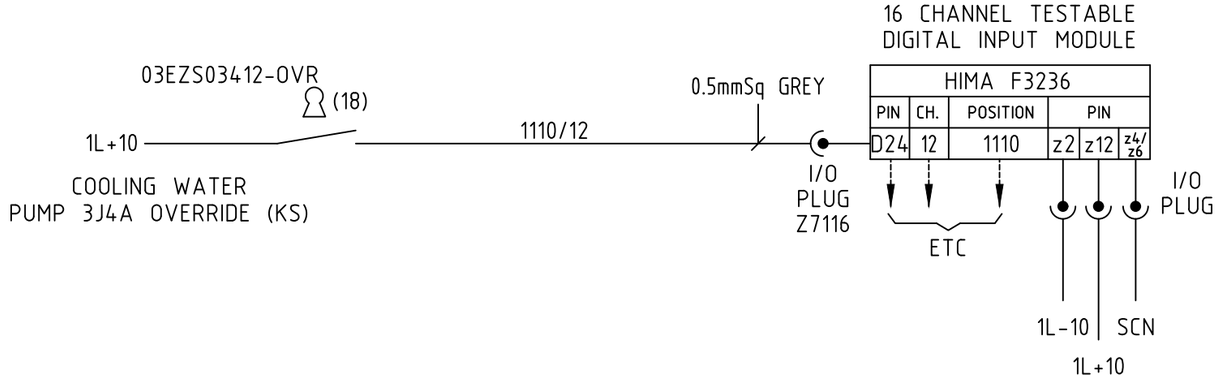

THIS DRAWING IS THE PROPERTY OF HIMA-SELLA LIMITED AND IS LOANED IN CONFIDENCE FOR USE WITH OUR WORK. IT IS NOT TO BE REPRODUCED IN ANY MANNER, SUBMITTED TO OUTSIDE PARTIES FOR EXAMINATION OR USED DIRECTLY OR INDIRECTLY FOR PURPOSES OTHER THAN THOSE FOR WHICH IT WAS FURNISHED WITHOUT WRITTEN CONSENT.

Template Revision – For Office Records Only

REV	AUTH	DATE	CAD TEMPLATE REF.
0	AB	18.07.11	A3-FRAME

Scale on A3 sheet	N/A
Dimensions	N/A

DO NOT STAMP 'MASTER' UNTIL ALL WORK IS FULLY CADDED

Rev	Design	Drawn	Chkd	Appd	Description	Date
A					PIN NUMBER CORRECTED & TEXT ADDED	06.10.11
.					. . .	. .

Designed	IM
Drawn	AB
Checked	IM
Approved	MHS
Date	11.08.11
Cad Reference	10265-P3-101

HIMA–SELLA LIMITED © HIMA-SELLA

Title : LOOP DRAWING - OUTPUTS
ICI SYNETIX SCHEDULE - No.3 AND No.7 PLANTS
FISHER-ROSEMOUNTP.O. No. 99003994

Contract/ Drawing No	C10265H-P3	101	REV	A

50 100 150 200 250 300 350 400

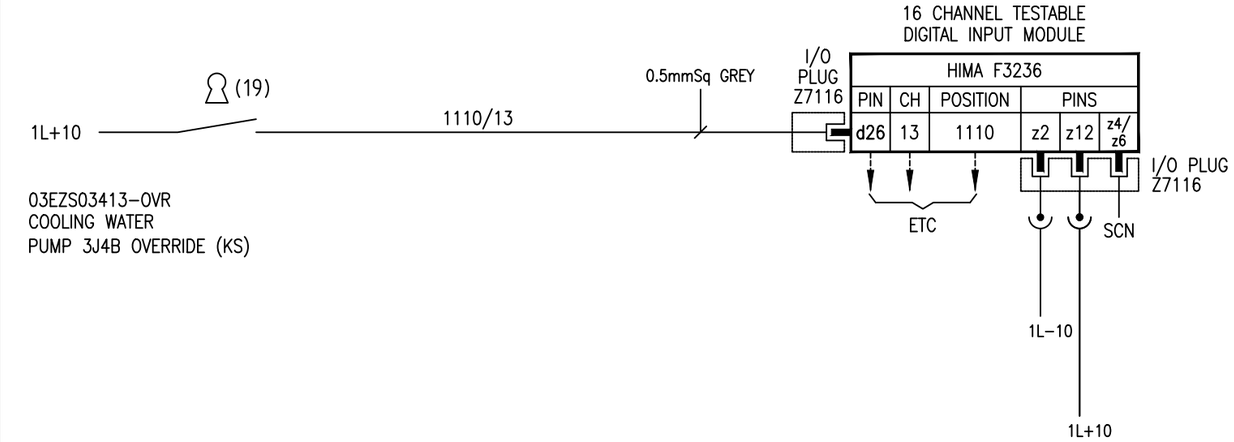

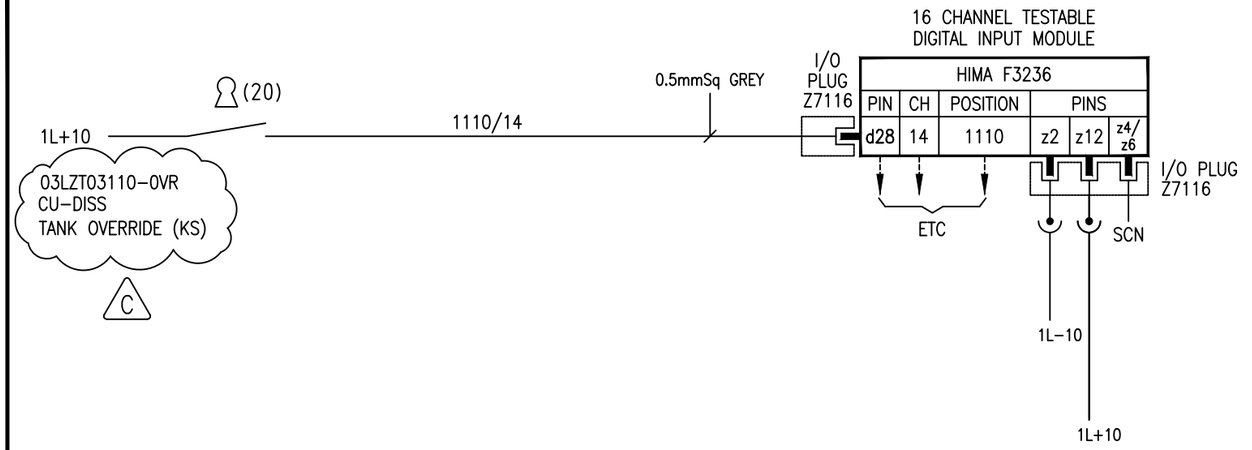

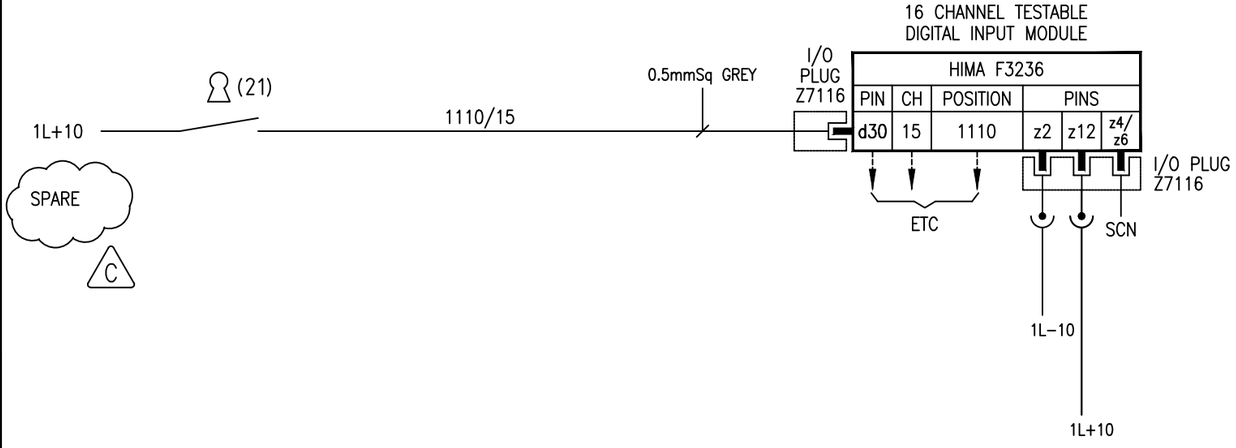

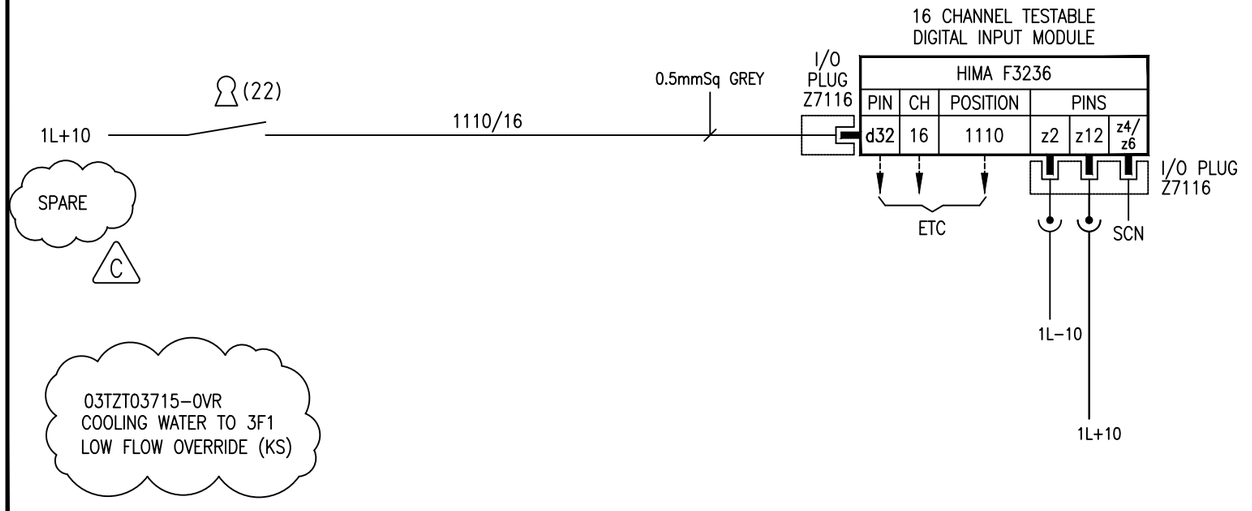

THIS DRAWING IS THE PROPERTY OF HIMA-SELLA LIMITED AND IS LOANED IN CONFIDENCE FOR USE WITH OUR WORK. IT IS NOT TO BE REPRODUCED IN ANY MANNER, SUBMITTED TO OUTSIDE PARTIES FOR EXAMINATION OR USED DIRECTLY OR INDIRECTLY FOR PURPOSES OTHER THAN THOSE FOR WHICH IT WAS FURNISHED WITHOUT WRITTEN CONSENT.

Template Revision – For Office Records Only

REV	AUTH	DATE	CAD TEMPLATE REF.
0	AB	18.07.11	A3-FRAME

Scale on A3 sheet	N/A
Dimensions	N/A

DO NOT STAMP 'MASTER' UNTIL ALL WORK IS FULLY CADDED

Rev	Design	Drawn	Chkd	Appd	Description	Date
A	IM	AB	IM	MRS	PIN NUMBER CORRECTED & TEXT ADDED	06.10.11
B	IM	AB	IM	MRS	AS BUILT PER C10265-006V	06.10.11
C				CT	ZINC DISSOLVER PHR & MMN IMPROVEMENTS	21.02.14

Designed	IM
Drawn	AB
Checked	IM
Approved	MHS
Date	11.08.11
Cad Reference	10265-P3-102

HIMA–SELLA LIMITED © HIMA-SELLA

Title : LOOP DRAWING - OUTPUTS
ICI SYNETIX SCHEDULE - No.3 AND No.7 PLANTS
FISHER-ROSEMOUNTP.O. No. 99003994

Contract/ Drawing No	C10265H-P3	102	REV	C

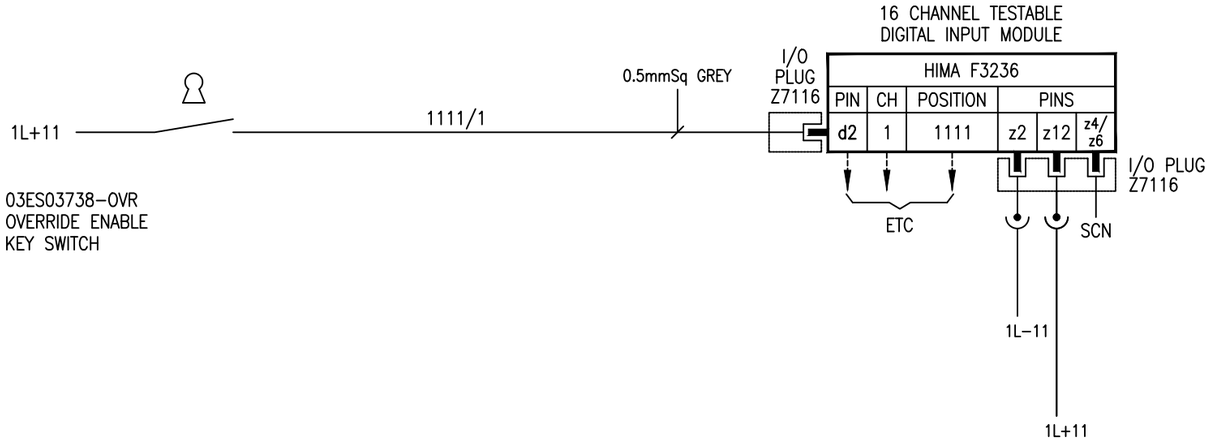

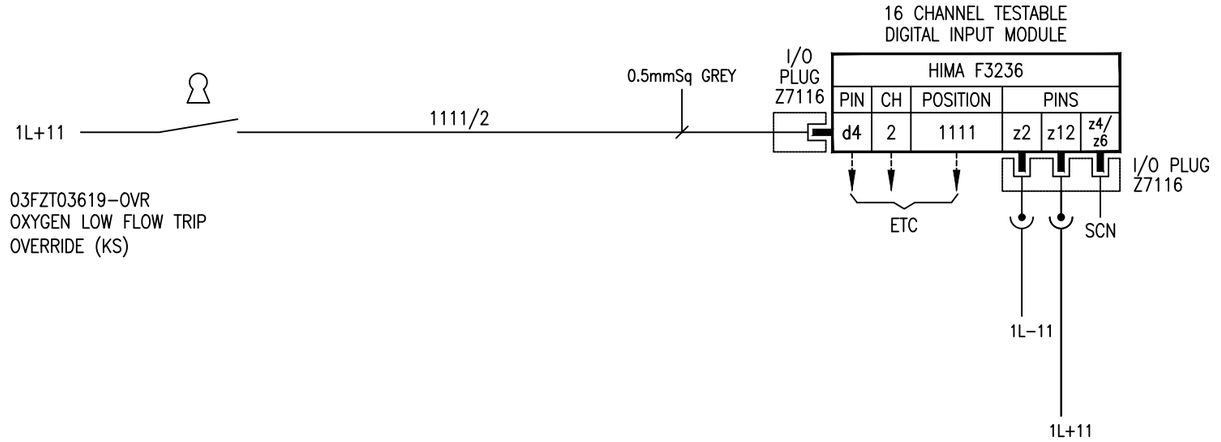

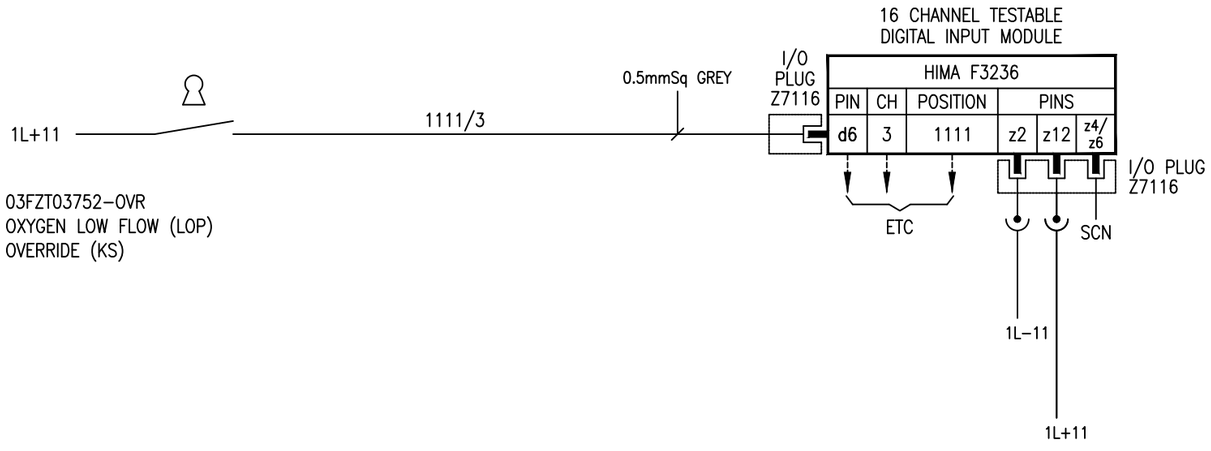

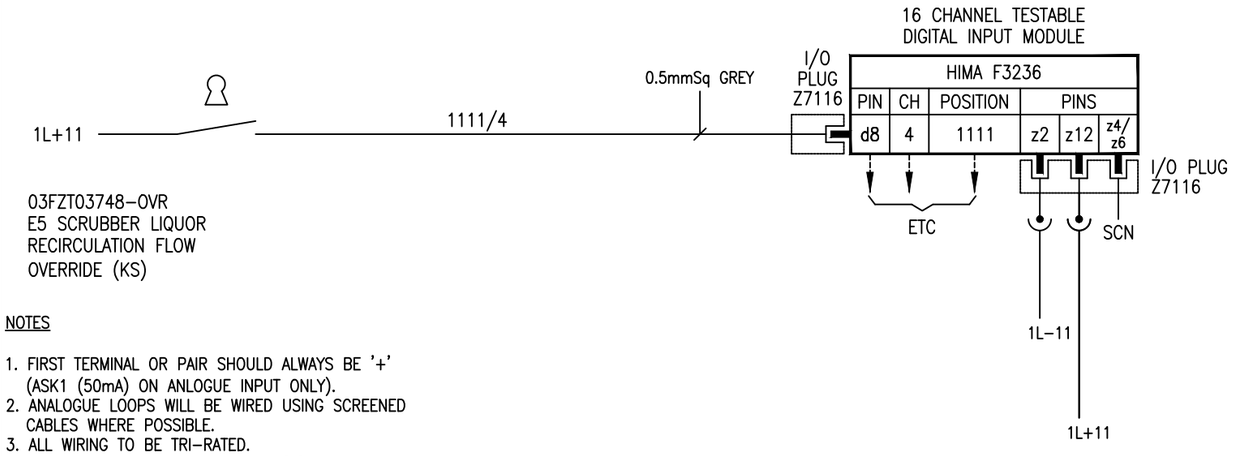

NOTES

1. FIRST TERMINAL OR PAIR SHOULD ALWAYS BE '+' (ASK1 (50mA) ON ANLOGUE INPUT ONLY).
2. ANALOGUE LOOPS WILL BE WIRED USING SCREENED CABLES WHERE POSSIBLE.
3. ALL WIRING TO BE TRI–RATED.
4. COMPENSATING CABLES FOR TYPE 'K' THERMOCOUPLES WITH COLD JUNCTION. COMPENSATION PROVIDED BY THE SIGNAL CONVERTER WILL BE USED ON ALL TYPES AI4 LOOPS.
5. L– FOR ALL REMOTE ANNUNCIATORS IS DELIVERED FROM THE ESD 24VDC SUPPLY.
6. WIRE No.s ARE DEFINED USING CARD POSITION / CHANNEL NUMBER.

THIS DRAWING IS THE PROPERTY OF HIMA-SELLA LIMITED AND IS LOANED IN CONFIDENCE FOR USE WITH OUR WORK. IT IS NOT TO BE REPRODUCED IN ANY MANNER, SUBMITTED TO OUTSIDE PARTIES FOR EXAMINATION OR USED DIRECTLY OR INDIRECTLY FOR PURPOSES OTHER THAN THOSE FOR WHICH IT WAS FURNISHED WITHOUT WRITTEN CONSENT.

Template Revision – For Office Records Only

REV	AUTH	DATE	CAD TEMPLATE REF.
0	AB	18.07.11	A3-FRAME

Scale on A3 sheet	N/A
Dimensions	N/A

DO NOT STAMP 'MASTER' UNTIL ALL WORK IS FULLY CADDED

Rev	Design	Drawn	Chkd	Appd	Description	Date

Designed	
Drawn	
Checked	
Approved	CT
Date	21.02.14
Cad Reference	10265-P3-103

HIMA–SELLA LIMITED © HIMA-SELLA

Title : LOOP DRAWING - INPUTS
ICI SYNETIX SCHEDULE - No.3 AND No.7 PLANTS
FISHER-ROSEMOUNTP.O. No. 99003994

Contract/ Drawing No	C10265H-P3	103	REV	0

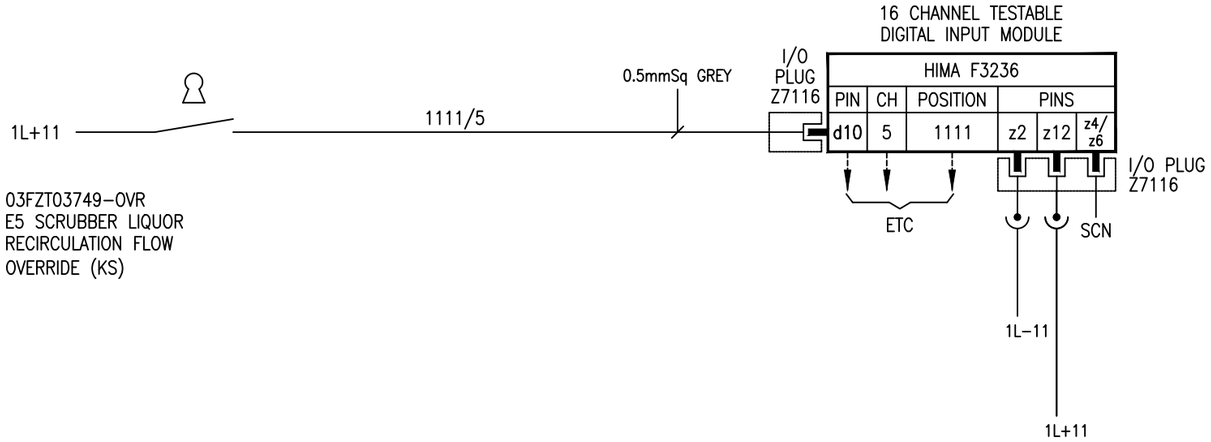

03FZT03749–OVR
E5 SCRUBBER LIQUOR
RECIRCULATION FLOW
OVERRIDE (KS)

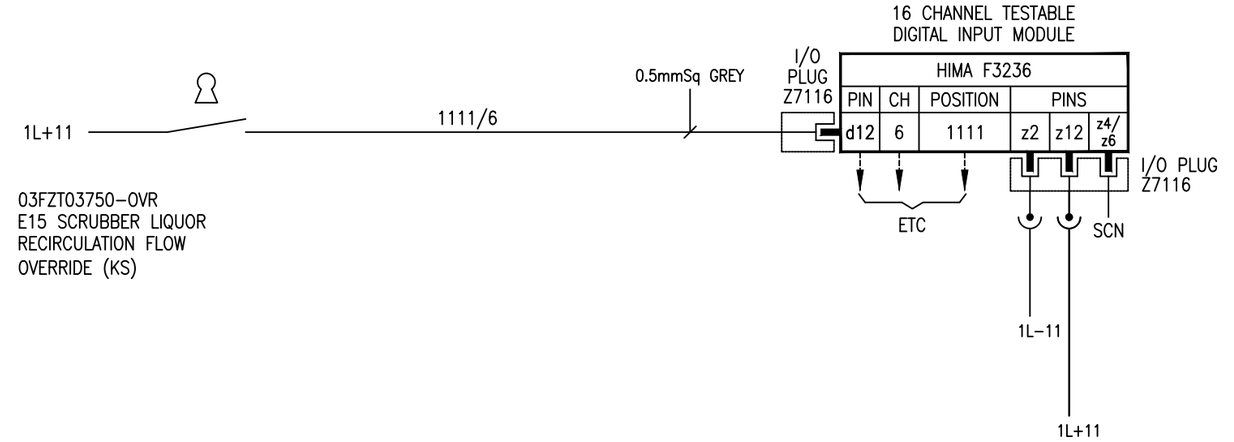

03FZT03750–OVR
E15 SCRUBBER LIQUOR
RECIRCULATION FLOW
OVERRIDE (KS)

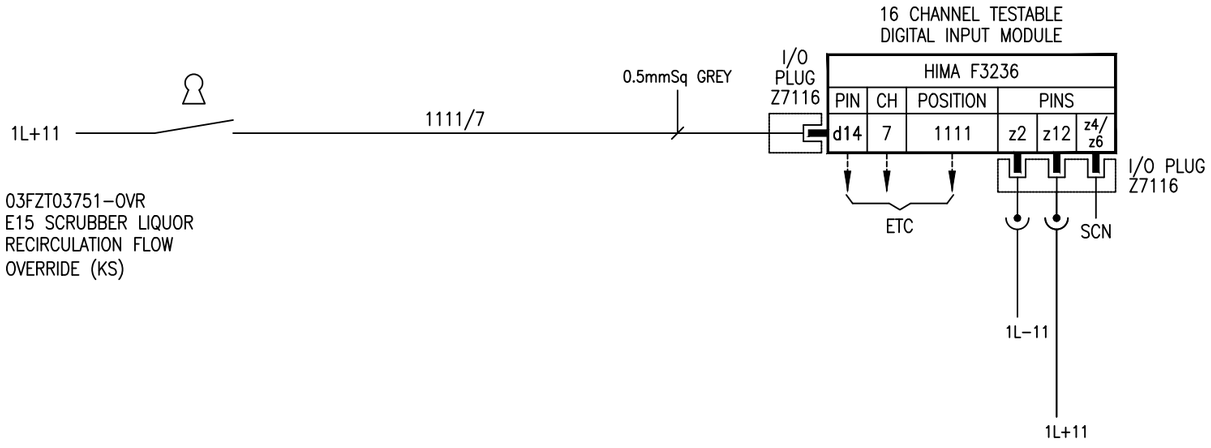

03FZT03751–OVR
E15 SCRUBBER LIQUOR
RECIRCULATION FLOW
OVERRIDE (KS)

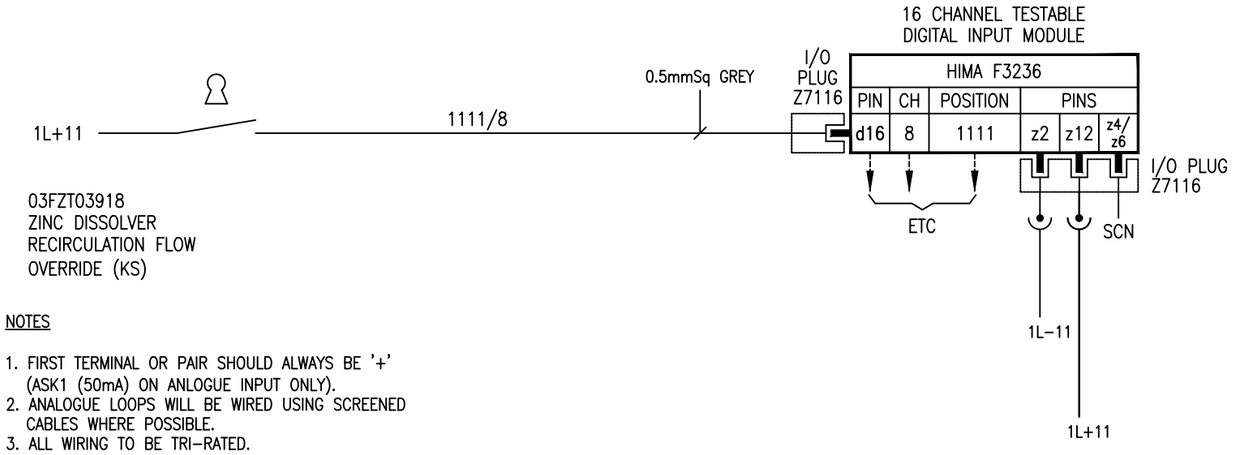

03FZT03918
ZINC DISSOLVER
RECIRCULATION FLOW
OVERRIDE (KS)

NOTES

1. FIRST TERMINAL OR PAIR SHOULD ALWAYS BE '+' (ASK1 (50mA) ON ANLOGUE INPUT ONLY).
2. ANALOGUE LOOPS WILL BE WIRED USING SCREENED CABLES WHERE POSSIBLE.
3. ALL WIRING TO BE TRI–RATED.
4. COMPENSATING CABLES FOR TYPE 'K' THERMOCOUPLES WITH COLD JUNCTION. COMPENSATION PROVIDED BY THE SIGNAL CONVERTER WILL BE USED ON ALL TYPES AI4 LOOPS.
5. L– FOR ALL REMOTE ANNUNCIATORS IS DELIVERED FROM THE ESD 24VDC SUPPLY.
6. WIRE No.s ARE DEFINED USING CARD POSITION / CHANNEL NUMBER.

THIS DRAWING IS THE PROPERTY OF HIMA-SELLA LIMITED AND IS LOANED IN CONFIDENCE FOR USE WITH OUR WORK. IT IS NOT TO BE REPRODUCED IN ANY MANNER, SUBMITTED TO OUTSIDE PARTIES FOR EXAMINATION OR USED DIRECTLY OR INDIRECTLY FOR PURPOSES OTHER THAN THOSE FOR WHICH IT WAS FURNISHED WITHOUT WRITTEN CONSENT.

Template Revision – For Office Records Only

REV	AUTH	DATE	CAD TEMPLATE REF.
0	AB	18.07.11	A3-FRAME

Scale on A3 sheet	N/A
Dimensions	N/A

DO NOT STAMP 'MASTER' UNTIL ALL WORK IS FULLY CADDED

Rev	Design	Drawn	Chkd	Appd	Description	Date

Designed	
Drawn	
Checked	
Approved	CT
Date	21.02.14
Cad Reference	10265-P3-104

HIMA–SELLA LIMITED © HIMA-SELLA

Title : LOOP DRAWING - INPUTS
ICI SYNETIX SCHEDULE - No.3 AND No.7 PLANTS
FISHER-ROSEMOUNTP.O. No. 99003994

Contract/ Drawing No	C10265H-P3	104	REV	0

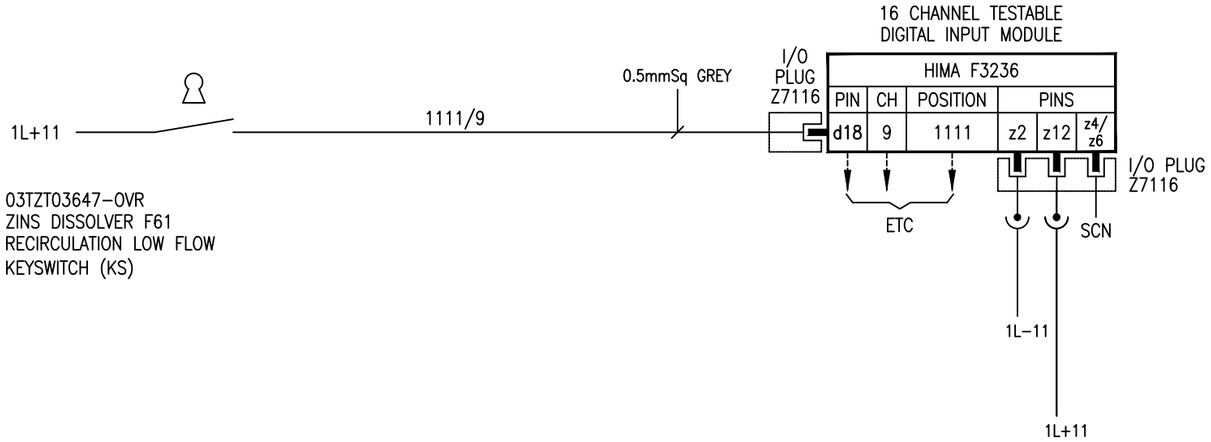

03TZT03647–OVR
ZINS DISSOLVER F61
RECIRCULATION LOW FLOW
KEYSWITCH (KS)

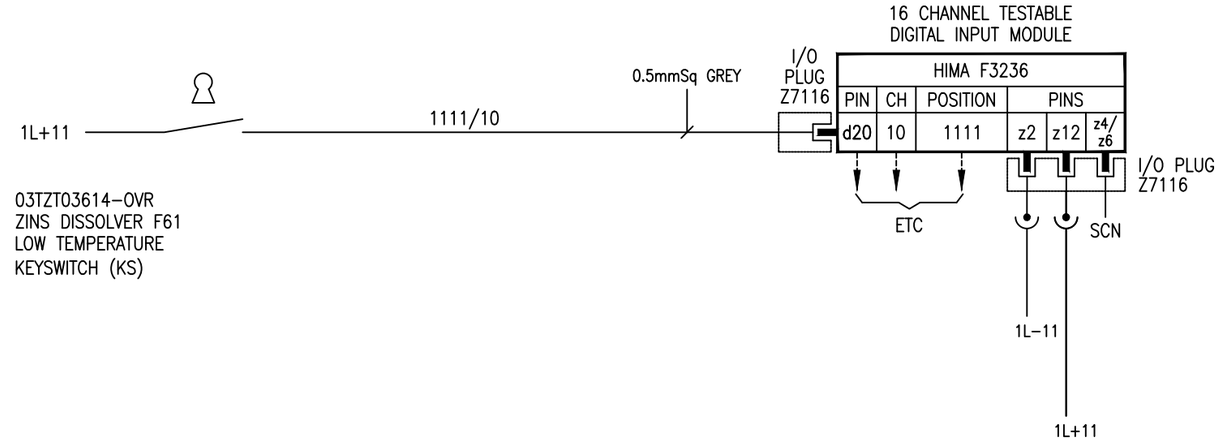

03TZT03614–OVR
ZINS DISSOLVER F61
LOW TEMPERATURE
KEYSWITCH (KS)

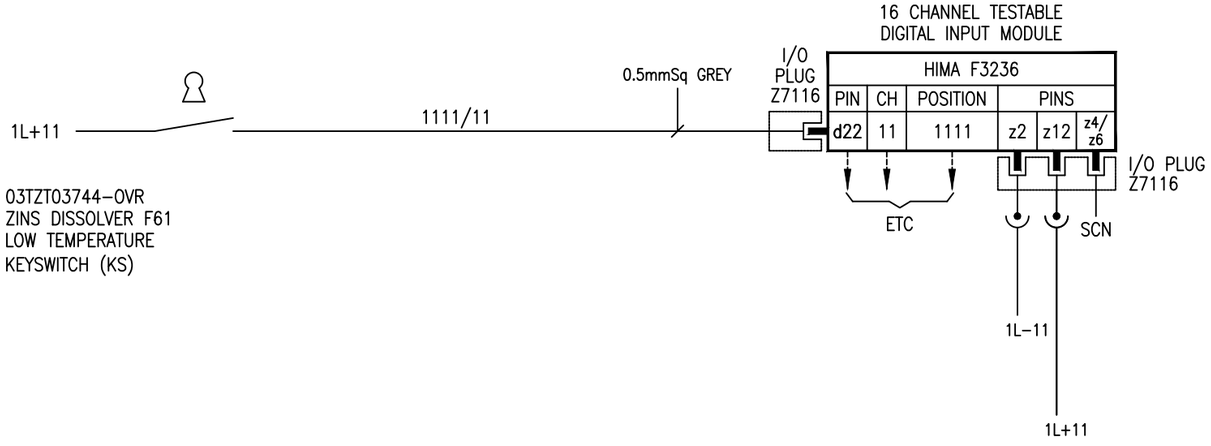

03TZT03744–OVR
ZINS DISSOLVER F61
LOW TEMPERATURE
KEYSWITCH (KS)

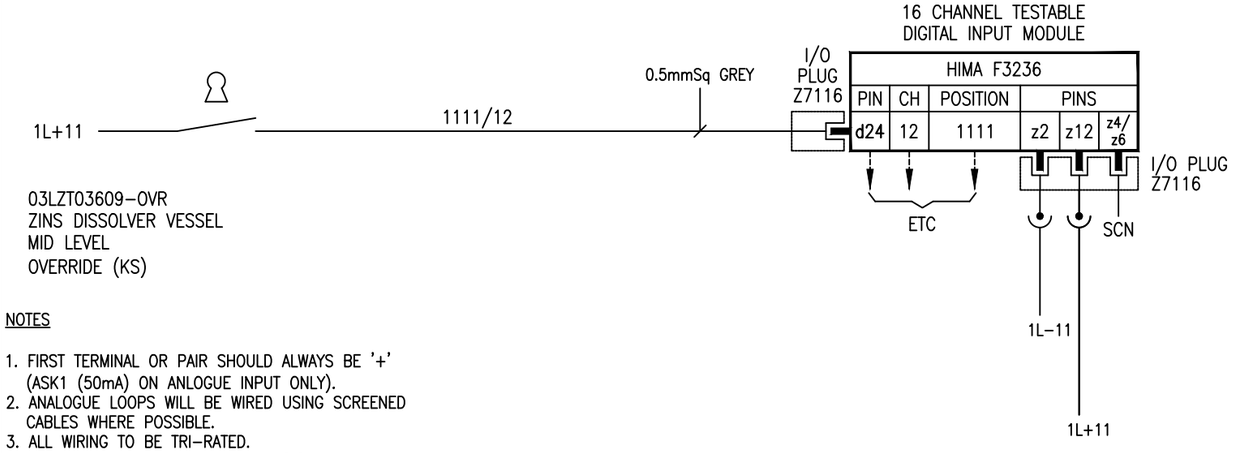

03LZT03609–OVR
ZINS DISSOLVER VESSEL
MID LEVEL
OVERRIDE (KS)

NOTES

1. FIRST TERMINAL OR PAIR SHOULD ALWAYS BE '+' (ASK1 (50mA) ON ANLOGUE INPUT ONLY).
2. ANALOGUE LOOPS WILL BE WIRED USING SCREENED CABLES WHERE POSSIBLE.
3. ALL WIRING TO BE TRI–RATED.
4. COMPENSATING CABLES FOR TYPE 'K' THERMOCOUPLES WITH COLD JUNCTION. COMPENSATION PROVIDED BY THE SIGNAL CONVERTER WILL BE USED ON ALL TYPES AI4 LOOPS.
5. L– FOR ALL REMOTE ANNUNCIATORS IS DELIVERED FROM THE ESD 24VDC SUPPLY.
6. WIRE No.s ARE DEFINED USING CARD POSITION / CHANNEL NUMBER.

THIS DRAWING IS THE PROPERTY OF HIMA-SELLA LIMITED AND IS LOANED IN CONFIDENCE FOR USE WITH OUR WORK. IT IS NOT TO BE REPRODUCED IN ANY MANNER, SUBMITTED TO OUTSIDE PARTIES FOR EXAMINATION OR USED DIRECTLY OR INDIRECTLY FOR PURPOSES OTHER THAN THOSE FOR WHICH IT WAS FURNISHED WITHOUT WRITTEN CONSENT.

Template Revision – For Office Records Only

REV	AUTH	DATE	CAD TEMPLATE REF.
0	AB	18.07.11	A3-FRAME

Scale on A3 sheet	N/A
Dimensions	N/A

DO NOT STAMP 'MASTER' UNTIL ALL WORK IS FULLY CADDED

Rev	Design	Drawn	Chkd	Appd	Description	Date

Designed	
Drawn	
Checked	
Approved	CT
Date	21.02.14
Cad Reference	10265-P3-105

HIMA–SELLA LIMITED © HIMA-SELLA

Title : LOOP DRAWING - INPUTS
ICI SYNETIX SCHEDULE - No.3 AND No.7 PLANTS
FISHER-ROSEMOUNTP.O. No. 99003994

Contract/ Drawing No	C10265H-P3	105	REV	0

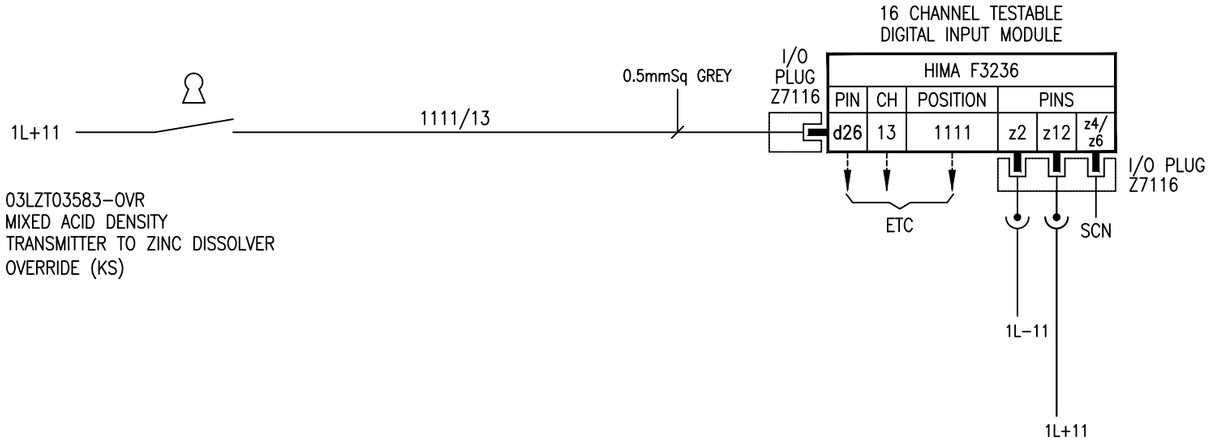

03LZT03583–OVR
MIXED ACID DENSITY
TRANSMITTER TO ZINC DISSOLVER
OVERRIDE (KS)

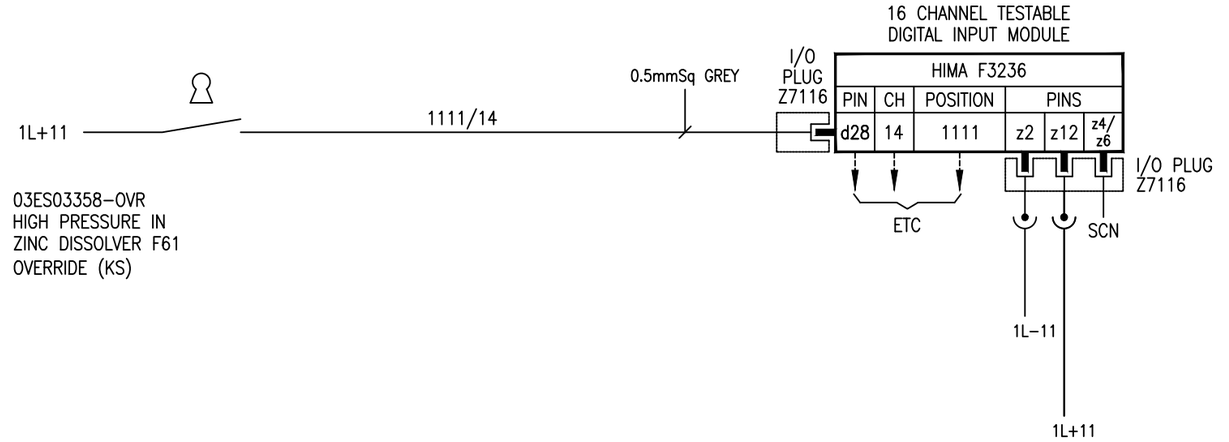

03ES03358–OVR
HIGH PRESSURE IN
ZINC DISSOLVER F61
OVERRIDE (KS)

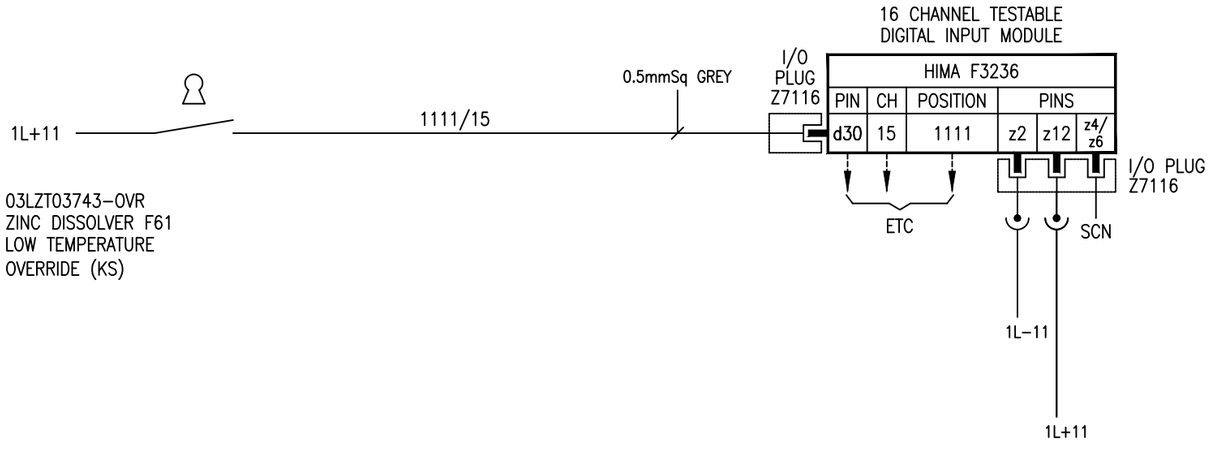

03LZT03743–OVR
ZINC DISSOLVER F61
LOW TEMPERATURE
OVERRIDE (KS)

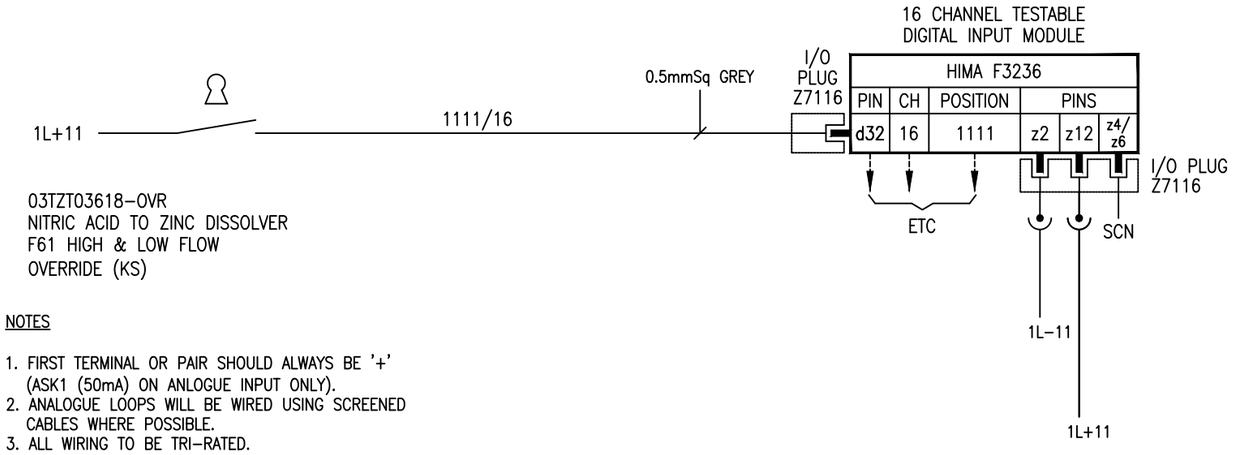

03TZT03618–OVR
NITRIC ACID TO ZINC DISSOLVER
F61 HIGH & LOW FLOW
OVERRIDE (KS)

NOTES

1. FIRST TERMINAL OR PAIR SHOULD ALWAYS BE '+' (ASK1 (50mA) ON ANLOGUE INPUT ONLY).
2. ANALOGUE LOOPS WILL BE WIRED USING SCREENED CABLES WHERE POSSIBLE.
3. ALL WIRING TO BE TRI–RATED.
4. COMPENSATING CABLES FOR TYPE 'K' THERMOCOUPLES WITH COLD JUNCTION. COMPENSATION PROVIDED BY THE SIGNAL CONVERTER WILL BE USED ON ALL TYPES AI4 LOOPS.
5. L– FOR ALL REMOTE ANNUNCIATORS IS DELIVERED FROM THE ESD 24VDC SUPPLY.
6. WIRE No.s ARE DEFINED USING CARD POSITION / CHANNEL NUMBER.

THIS DRAWING IS THE PROPERTY OF HIMA-SELLA LIMITED AND IS LOANED IN CONFIDENCE FOR USE WITH OUR WORK. IT IS NOT TO BE REPRODUCED IN ANY MANNER, SUBMITTED TO OUTSIDE PARTIES FOR EXAMINATION OR USED DIRECTLY OR INDIRECTLY FOR PURPOSES OTHER THAN THOSE FOR WHICH IT WAS FURNISHED WITHOUT WRITTEN CONSENT.

Template Revision – For Office Records Only

REV	AUTH	DATE	CAD TEMPLATE REF.
0	AB	18.07.11	A3-FRAME

Scale on A3 sheet	N/A
Dimensions	N/A

DO NOT STAMP 'MASTER' UNTIL ALL WORK IS FULLY CADDED

Rev	Design	Drawn	Chkd	Appd	Description	Date

Designed	
Drawn	
Checked	
Approved	CT
Date	21.02.14
Cad Reference	10265-P3-106

HIMA–SELLA LIMITED © HIMA-SELLA

Title : LOOP DRAWING - INPUTS
ICI SYNETIX SCHEDULE - No.3 AND No.7 PLANTS
FISHER-ROSEMOUNTP.O. No. 99003994

Contract/ Drawing No	C10265H-P3	106	REV	0

50 100 150 200 250 300 350 400

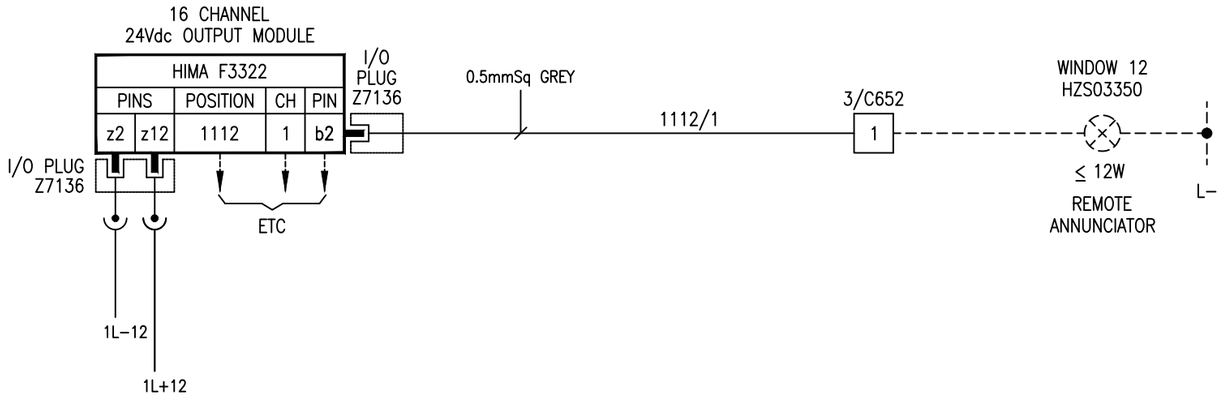

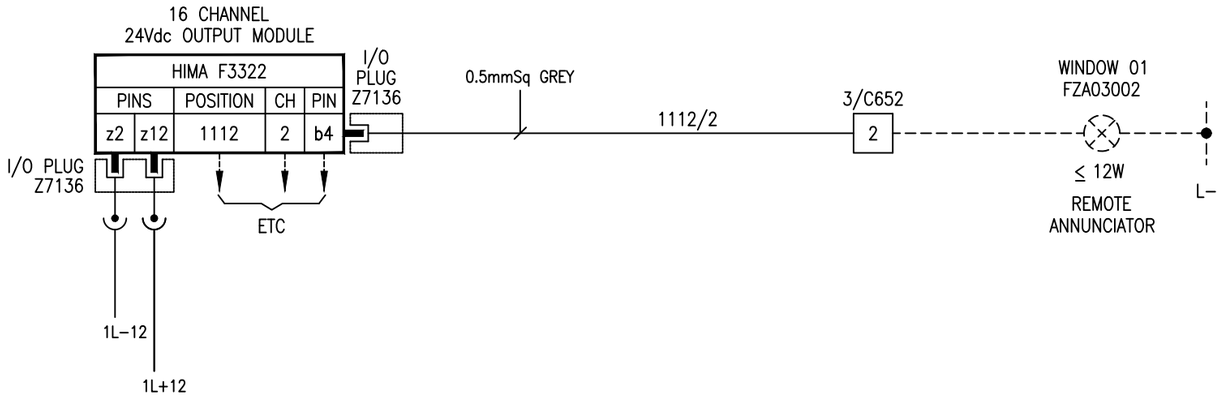

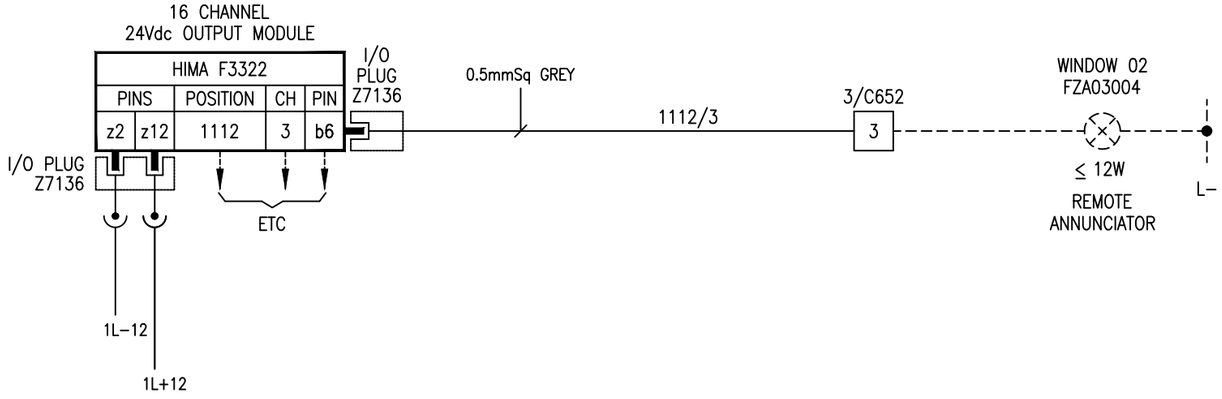

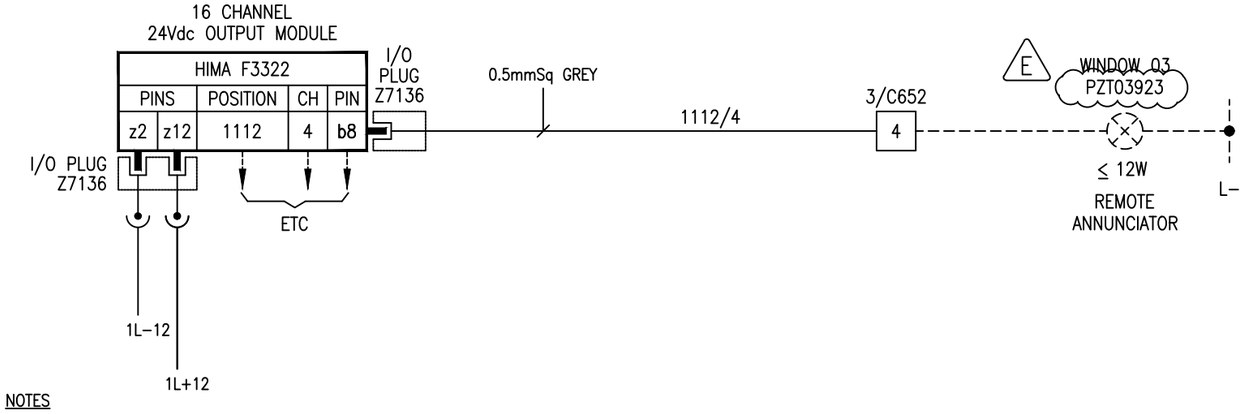

NOTES

1. FIRST TERMINAL OR PAIR SHOULD ALWAYS BE '+' (ASK1 (50mA) ON ANLOGUE INPUT ONLY).
2. ANALOGUE LOOPS WILL BE WIRED USING SCREENED CABLES WHERE POSSIBLE.
3. ALL WIRING TO BE TRI–RATED.
4. COMPENSATING CABLES FOR TYPE 'K' THERMOCOUPLES WITH COLD JUNCTION. COMPENSATION PROVIDED BY THE SIGNAL CONVERTER WILL BE USED ON ALL TYPES AI4 LOOPS.
5. L– FOR ALL REMOTE ANNUNCIATORS IS DELIVERED FROM THE ESD 24VDC SUPPLY.
6. WIRE No.s ARE DEFINED USING CARD POSITION / CHANNEL NUMBER.

THIS DRAWING IS THE PROPERTY OF HIMA-SELLA LIMITED AND IS LOANED IN CONFIDENCE FOR USE WITH OUR WORK. IT IS NOT TO BE REPRODUCED IN ANY MANNER, SUBMITTED TO OUTSIDE PARTIES FOR EXAMINATION OR USED DIRECTLY OR INDIRECTLY FOR PURPOSES OTHER THAN THOSE FOR WHICH IT WAS FURNISHED WITHOUT WRITTEN CONSENT.

Template Revision – For Office Records Only

REV	AUTH	DATE	CAD TEMPLATE REF.
B	MB	7.4.10	A3-FRAME

Scale on A3 sheet	N/A
Dimensions	N/A

DO NOT STAMP 'MASTER' UNTIL ALL WORK IS FULLY CADDED

Rev	Design	Drawn	Chkd	Appd	Description	Date
C	NH	NH	CW	NGB	AS BUILT.	06.06.00
D	NH	NH	CW		TEXT ADDED.	06.06.00
E				CT	ZINC DISSOLVER PHR & MMN IMPROVEMENTS	04.03.14

Designed	NH
Drawn	NH
Checked	CW
Approved	NGB
Date	30.03.00
Cad Reference	10265-P3-107

HIMA–SELLA LIMITED © HIMA-SELLA

Title : LOOP DRAWING - OUTPUTS
ICI SYNETIX SCHEDULE - No.3 AND No.7 PLANTS
FISHER-ROSEMOUNTP.O. No. 99003994

Contract/ Drawing No	C10265H-P3	107	REV	E

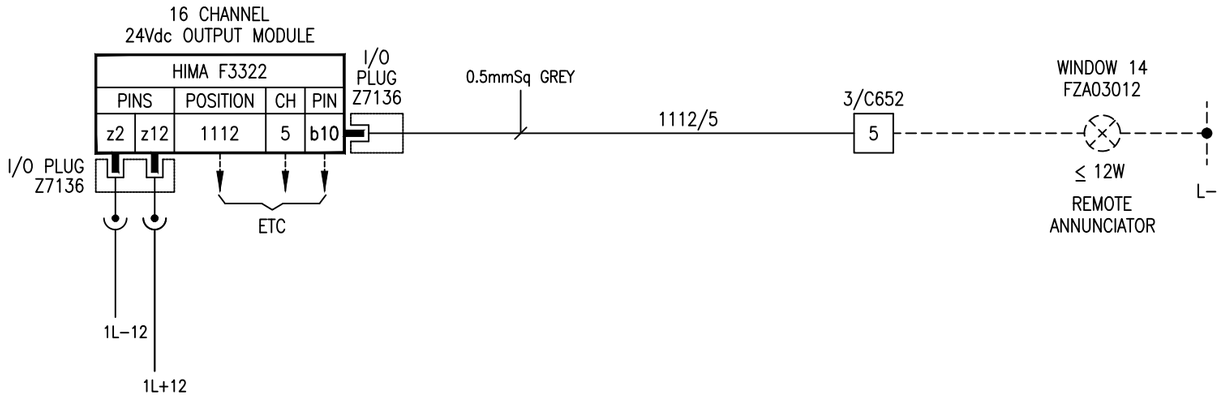

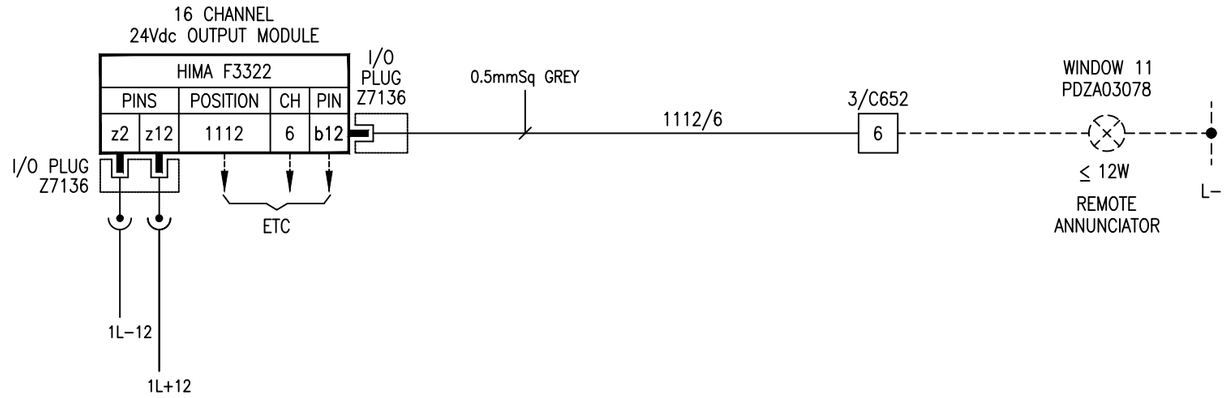

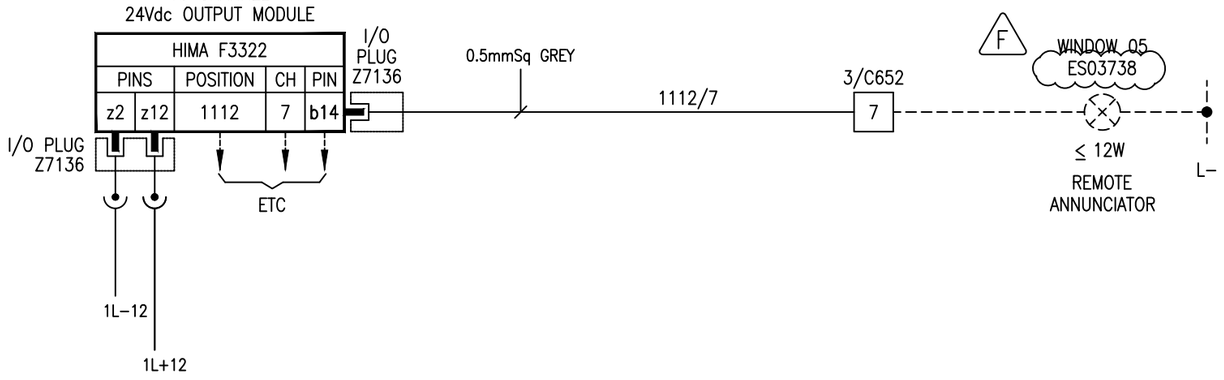

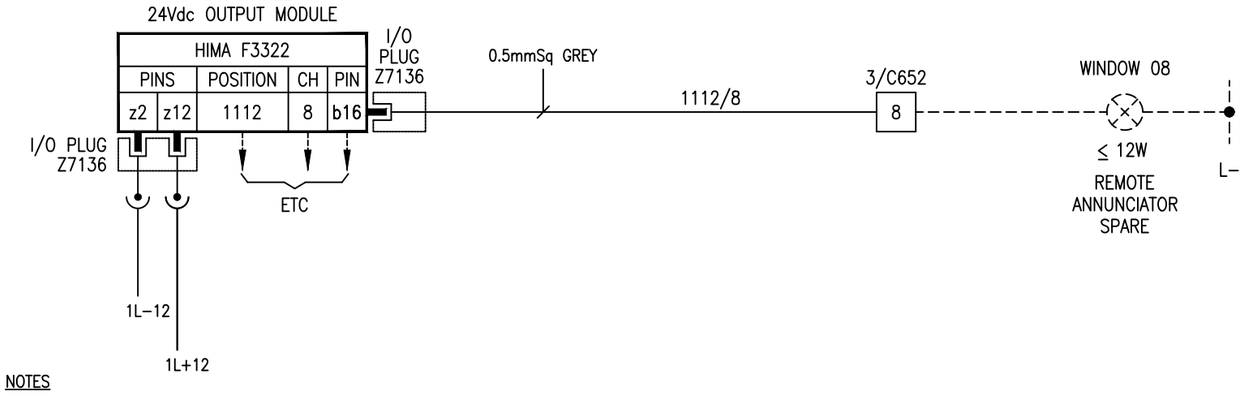

NOTES

1. FIRST TERMINAL OR PAIR SHOULD ALWAYS BE '+' (ASK1 (50mA) ON ANLOGUE INPUT ONLY).
2. ANALOGUE LOOPS WILL BE WIRED USING SCREENED CABLES WHERE POSSIBLE.
3. ALL WIRING TO BE TRI–RATED.
4. COMPENSATING CABLES FOR TYPE 'K' THERMOCOUPLES WITH COLD JUNCTION. COMPENSATION PROVIDED BY THE SIGNAL CONVERTER WILL BE USED ON ALL TYPES AI4 LOOPS.
5. L– FOR ALL REMOTE ANNUNCIATORS IS DELIVERED FROM THE ESD 24VDC SUPPLY.
6. WIRE No.s ARE DEFINED USING CARD POSITION / CHANNEL NUMBER.

THIS DRAWING IS THE PROPERTY OF HIMA-SELLA LIMITED AND IS LOANED IN CONFIDENCE FOR USE WITH OUR WORK. IT IS NOT TO BE REPRODUCED IN ANY MANNER, SUBMITTED TO OUTSIDE PARTIES FOR EXAMINATION OR USED DIRECTLY OR INDIRECTLY FOR PURPOSES OTHER THAN THOSE FOR WHICH IT WAS FURNISHED WITHOUT WRITTEN CONSENT.

Template Revision – For Office Records Only

REV	AUTH	DATE	CAD TEMPLATE REF.
B	MB	7.4.10	A3-FRAME

Scale on A3 sheet	N/A
Dimensions	N/A

DO NOT STAMP 'MASTER' UNTIL ALL WORK IS FULLY CADDED

Rev	Design	Drawn	Chkd	Appd	Description	Date
C	NH	NH	CW	NGB	AS BUILT.	06.06.00
D	IM	AB	IM	MHS	TEXT ADDED	11.08.11
E	IM	AB	IM	MHS	WIRE NUMBER CORRECTED	06.10.11
F				CT	ZINC DISSOLVER PHR & MMN IMPROVEMENTS	04.3.14

Designed	NH
Drawn	NH
Checked	CW
Approved	NGB
Date	30.03.00
Cad Reference	10265-P3-108

HIMA–SELLA LIMITED © HIMA-SELLA

Title : LOOP DRAWING - OUTPUTS
ICI SYNETIX SCHEDULE - No.3 AND No.7 PLANTS
FISHER-ROSEMOUNTP.O. No. 99003994

Contract/ Drawing No				
	C10265H-P3	108	REV	F

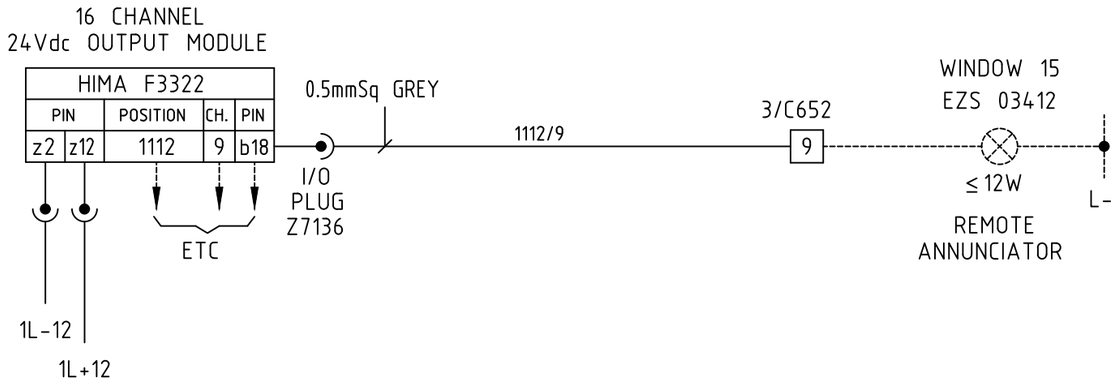

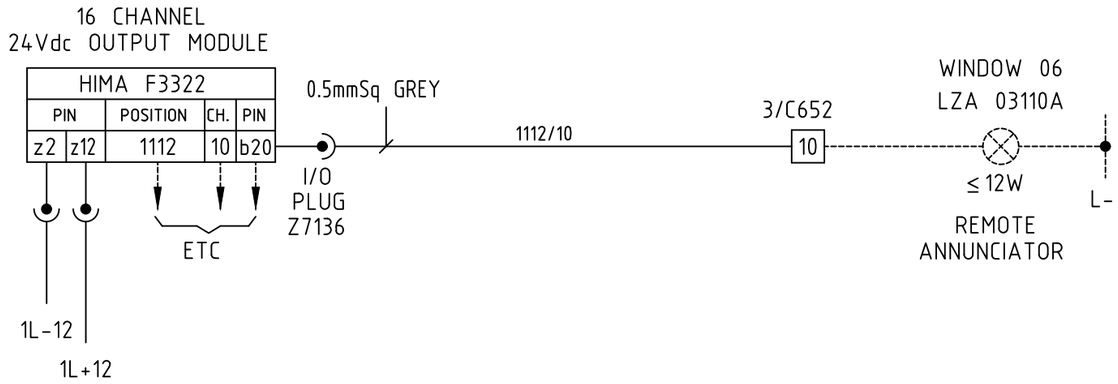

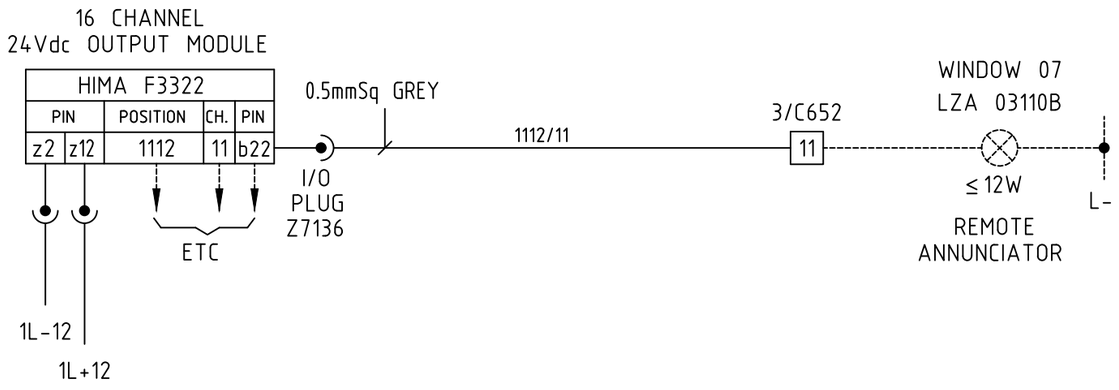

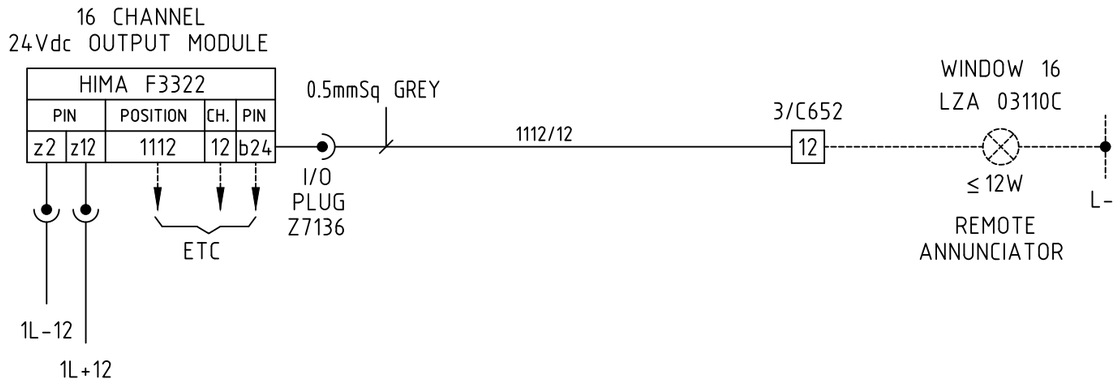

NOTES
1. FIRST TERMINAL OF PAIR SHOULD ALWAYS BE '+' (ASK1 (50mA) ON ANALOGUE INPUTS ONLY).
2. ANALOGUE LOOPS WILL BE WIRED USING SCREENED CABLES WHERE POSSIBLE.
3. ALL WIRING TO BE TRI-RATED.
4. COMPENSATING CABLES FOR TYPE 'K' THERMOCOUPLES WITH COLD JUNCTION.
   COMPENSATION PROVIDED BY THE SIGNAL CONVERTOR WILL BE USED ON ALL TYPE AI4 LOOPS.
5. L- FOR ALL REMOTE ANNUNCIATORS IS DERIVED FROM THE ESD 24Vdc SUPPLY.
6. WIRE No.s ARE DEFINED USING CARD POSITION/CHANNEL NUMBER.

THIS DRAWING IS THE PROPERTY OF HIMA-SELLA LIMITED AND IS LOANED IN CONFIDENCE FOR USE WITH OUR WORK. IT IS NOT TO BE REPRODUCED IN ANY MANNER, SUBMITTED TO OUTSIDE PARTIES FOR EXAMINATION OR USED DIRECTLY OR INDIRECTLY FOR PURPOSES OTHER THAN THOSE FOR WHICH IT WAS FURNISHED WITHOUT WRITTEN CONSENT.

Template Revision – For Office Records Only

REV	AUTH	DATE	CAD TEMPLATE REF.
B	MB	7.4.10	A3-FRAME

Scale on A3 sheet	N/A
Dimensions	N/A

DO NOT STAMP 'MASTER' UNTIL ALL WORK IS FULLY CADDED

Rev	Design	Drawn	Chkd	Appd	Description	Date
C	NH	NH	CW	NGB	AS BUILT.	06.06.00
.					. . .	. .

Designed	NH
Drawn	NH
Checked	CW
Approved	NGB
Date	30.03.00
Cad Reference	10265-P3-109

HIMA–SELLA LIMITED © HIMA-SELLA

Title : LOOP DRAWING - OUTPUTS
ICI SYNETIX SCHEDULE - No.3 AND No.7 PLANTS
FISHER-ROSEMOUNTP.O. No. 99003994

Contract/ Drawing No	C10265H-P3	109	REV	C

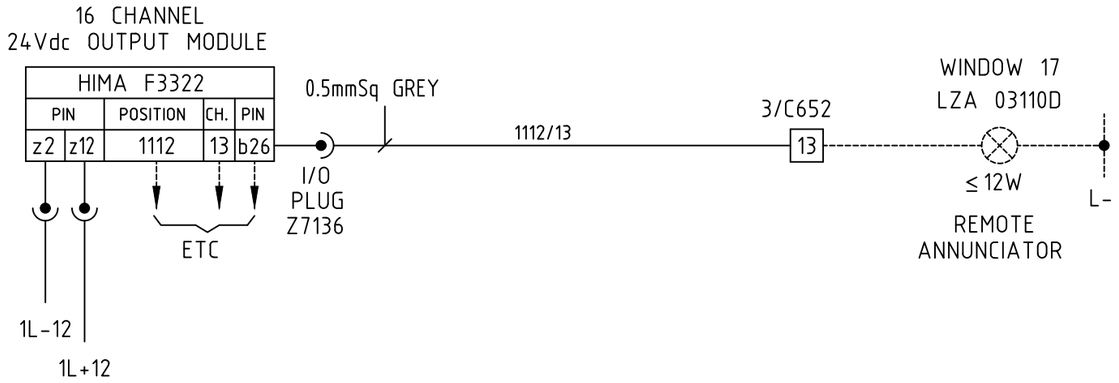

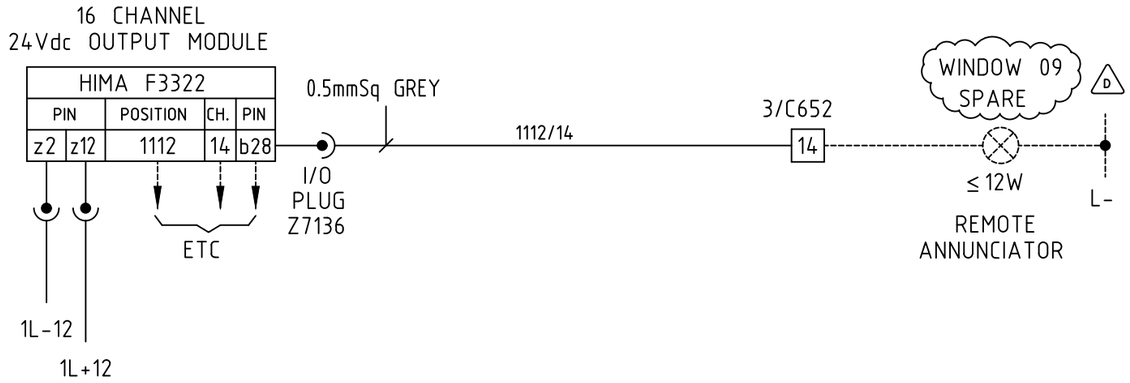

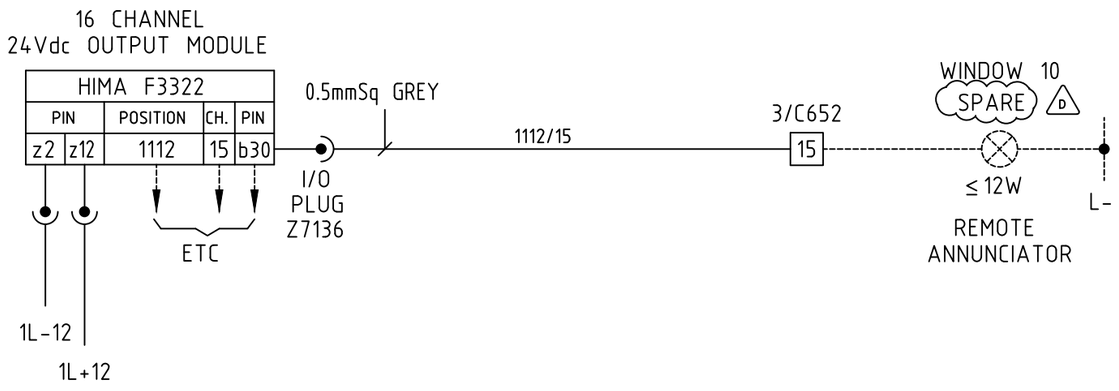

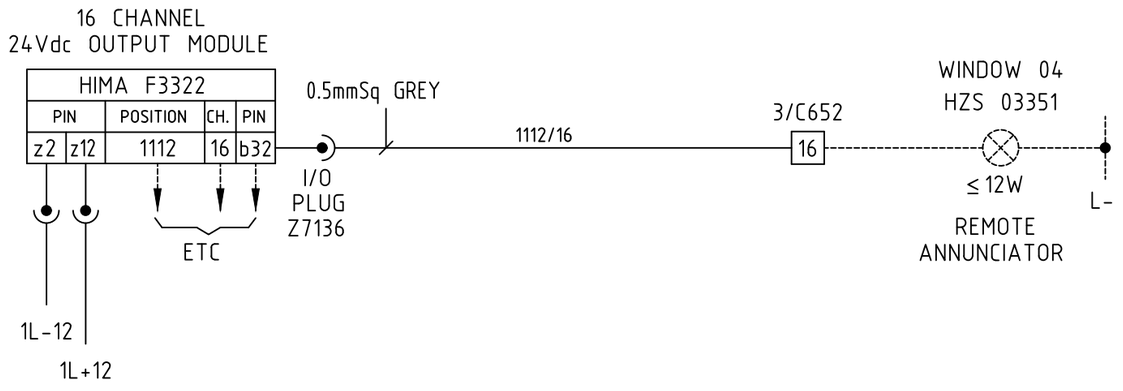

NOTES
1. FIRST TERMINAL OF PAIR SHOULD ALWAYS BE '+' (ASK1 (50mA) ON ANALOGUE INPUTS ONLY).
2. ANALOGUE LOOPS WILL BE WIRED USING SCREENED CABLES WHERE POSSIBLE.
3. ALL WIRING TO BE TRI-RATED.
4. COMPENSATING CABLES FOR TYPE 'K' THERMOCOUPLES WITH COLD JUNCTION.
   COMPENSATION PROVIDED BY THE SIGNAL CONVERTOR WILL BE USED ON ALL TYPE AI4 LOOPS.
5. L- FOR ALL REMOTE ANNUNCIATORS IS DERIVED FROM THE ESD 24Vdc SUPPLY.
6. WIRE No.s ARE DEFINED USING CARD POSITION/CHANNEL NUMBER.

THIS DRAWING IS THE PROPERTY OF HIMA-SELLA LIMITED AND IS LOANED IN CONFIDENCE FOR USE WITH OUR WORK. IT IS NOT TO BE REPRODUCED IN ANY MANNER, SUBMITTED TO OUTSIDE PARTIES FOR EXAMINATION OR USED DIRECTLY OR INDIRECTLY FOR PURPOSES OTHER THAN THOSE FOR WHICH IT WAS FURNISHED WITHOUT WRITTEN CONSENT.

Template Revision – For Office Records Only

REV	AUTH	DATE	CAD TEMPLATE REF.
B	MB	7.4.10	A3-FRAME

Scale on A3 sheet	N/A
Dimensions	N/A

DO NOT STAMP 'MASTER' UNTIL ALL WORK IS FULLY CADDED

Rev	Design	Drawn	Chkd	Appd	Description	Date
C	NH	NH	CW	NGB	AS BUILT.	06.06.00
D				CT	AS BUILT PER C10265-012V	29.10.14
.					. . .	. .

Designed	NH
Drawn	NH
Checked	CW
Approved	NGB
Date	30.03.00
Cad Reference	10265-P3-110

HIMA–SELLA LIMITED © HIMA-SELLA

Title : LOOP DRAWING - OUTPUTS
ICI SYNETIX SCHEDULE - No.3 AND No.7 PLANTS
FISHER-ROSEMOUNTP.O. No. 99003994

Contract/ Drawing No	C10265H-P3	110	REV	D

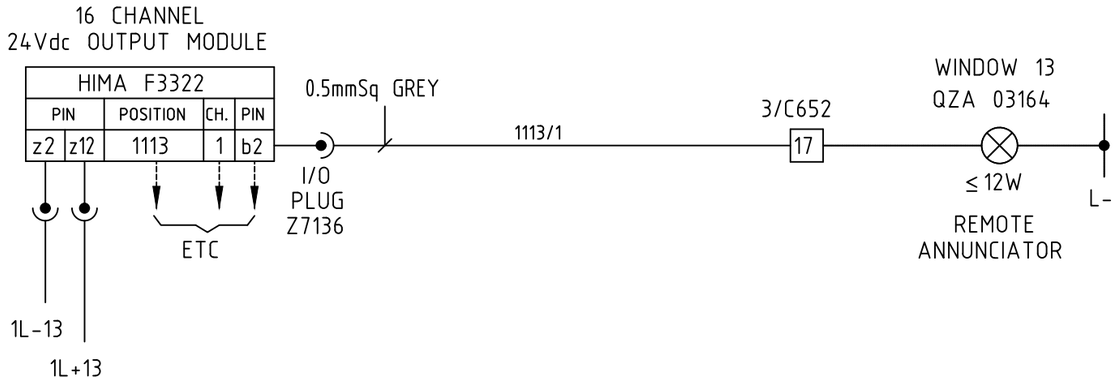

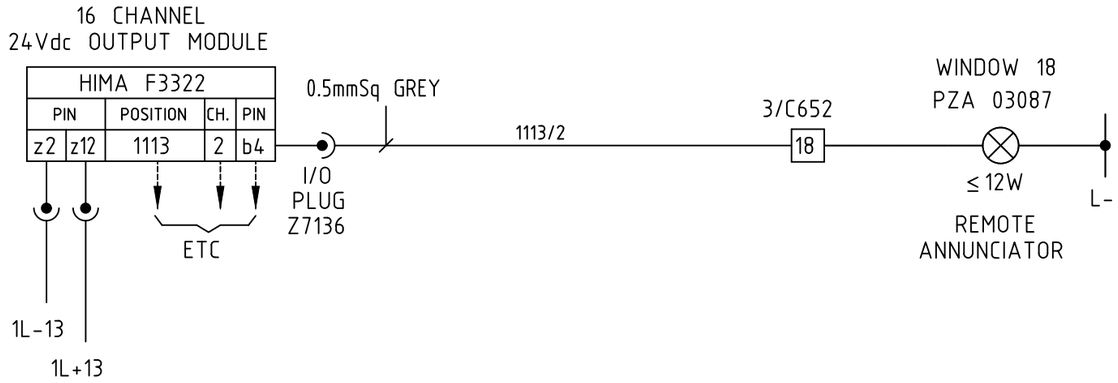

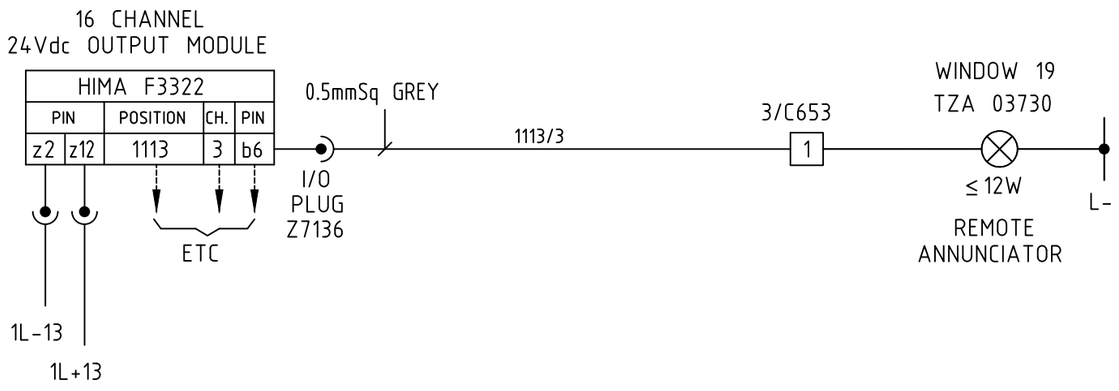

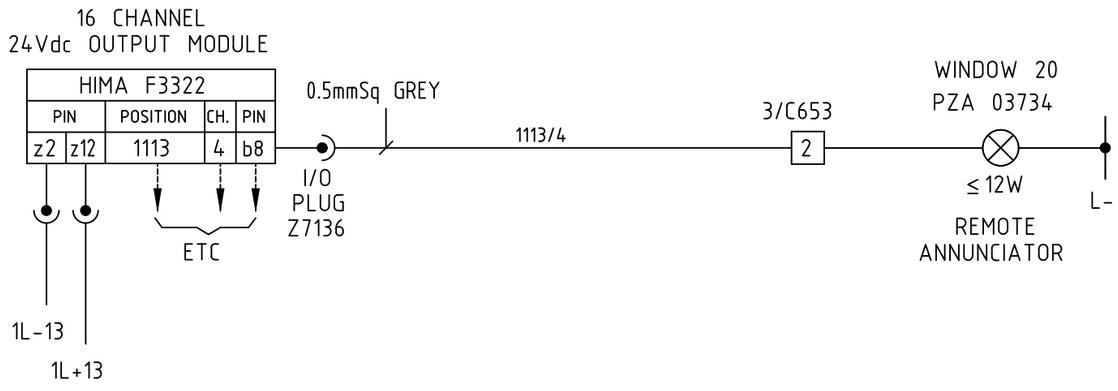

THIS DRAWING IS THE PROPERTY OF HIMA-SELLA LIMITED AND IS LOANED IN CONFIDENCE FOR USE WITH OUR WORK. IT IS NOT TO BE REPRODUCED IN ANY MANNER, SUBMITTED TO OUTSIDE PARTIES FOR EXAMINATION OR USED DIRECTLY OR INDIRECTLY FOR PURPOSES OTHER THAN THOSE FOR WHICH IT WAS FURNISHED WITHOUT WRITTEN CONSENT.

Template Revision – For Office Records Only

REV	AUTH	DATE	CAD TEMPLATE REF.
B	MB	7.4.10	A3-FRAME

Scale on A3 sheet	N/A
Dimensions	N/A

DO NOT STAMP 'MASTER' UNTIL ALL WORK IS FULLY CADDED

Rev	Design	Drawn	Chkd	Appd	Description	Date
C	NH	NH	CW	NGB	AS BUILT.	06.06.00
D					TZA03730 & PZA03734 ADDED.	10.08.09

Designed	NH
Drawn	NH
Checked	CW
Approved	NGB
Date	29.03.00
Cad Reference	10265-P3-111

HIMA–SELLA LIMITED © HIMA-SELLA

Title : LOOP DRAWING - OUTPUTS
ICI SYNETIX SCHEDULE - No.3 AND No.7 PLANTS
FISHER-ROSEMOUNTP.O. No. 99003994

Contract/ Drawing No	C10265H-P3	111	REV	D

50 100 150 200 250 300 350 400

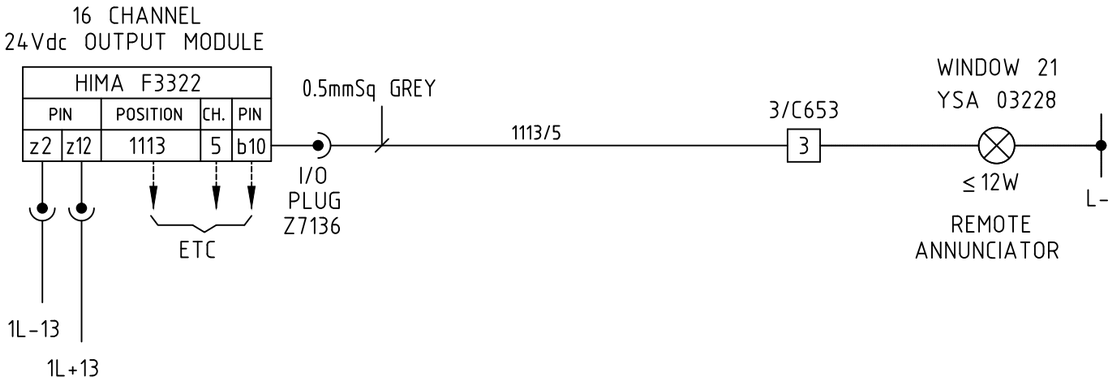

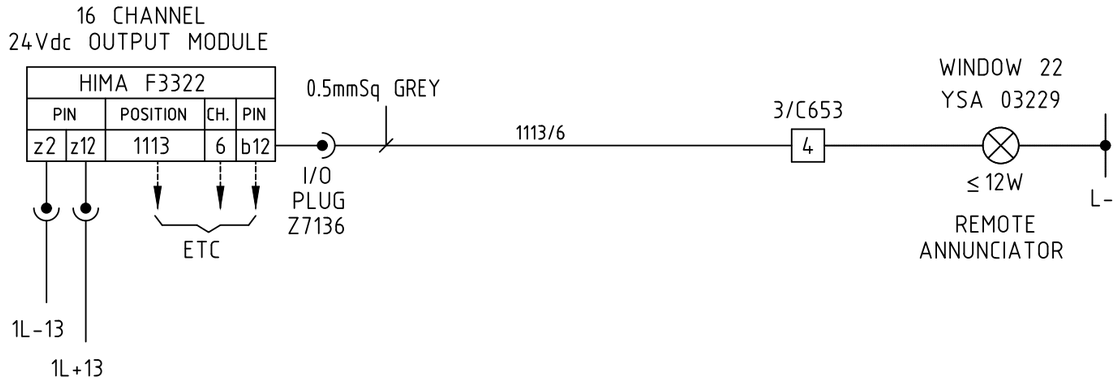

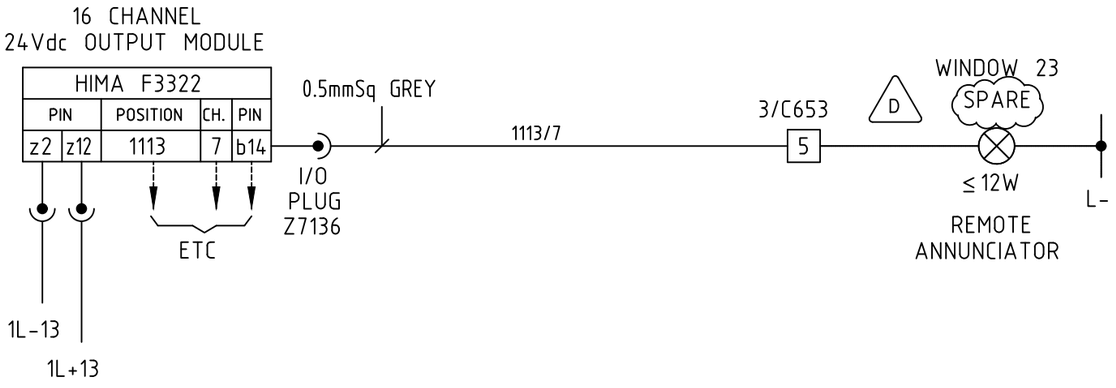

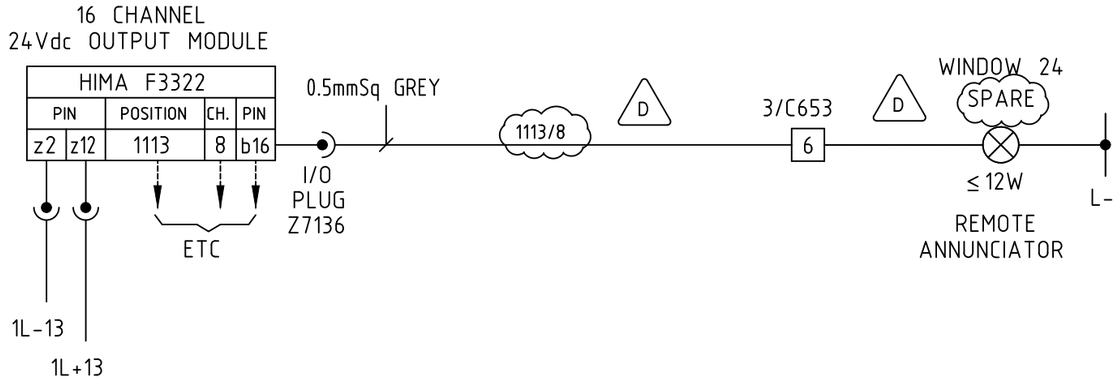

NOTES
1. FIRST TERMINAL OF PAIR SHOULD ALWAYS BE '+' (ASK1 (50mA) ON ANALOGUE INPUTS ONLY).
2. ANALOGUE LOOPS WILL BE WIRED USING SCREENED CABLES WHERE POSSIBLE.
3. ALL WIRING TO BE TRI-RATED.
4. COMPENSATING CABLES FOR TYPE 'K' THERMOCOUPLES WITH COLD JUNCTION.
   COMPENSATION PROVIDED BY THE SIGNAL CONVERTOR WILL BE USED ON ALL TYPE AI4 LOOPS.
5. L- FOR ALL REMOTE ANNUNCIATORS IS DERIVED FROM THE ESD 24Vdc SUPPLY.
6. WIRE No.s ARE DEFINED USING CARD POSITION/CHANNEL NUMBER.

THIS DRAWING IS THE PROPERTY OF HIMA-SELLA LIMITED AND IS LOANED IN CONFIDENCE FOR USE WITH OUR WORK. IT IS NOT TO BE REPRODUCED IN ANY MANNER, SUBMITTED TO OUTSIDE PARTIES FOR EXAMINATION OR USED DIRECTLY OR INDIRECTLY FOR PURPOSES OTHER THAN THOSE FOR WHICH IT WAS FURNISHED WITHOUT WRITTEN CONSENT.

Template Revision – For Office Records Only

REV	AUTH	DATE	CAD TEMPLATE REF.
B	MB	7.4.10	A3-FRAME

Scale on A3 sheet	N/A
Dimensions	N/A

DO NOT STAMP 'MASTER' UNTIL ALL WORK IS FULLY CADDED

Rev	Design	Drawn	Chkd	Appd	Description	Date
C	NH	NH	CW	NGB	AS BUILT.	06.06.00
D				CT	PLANT 3 ESD CABINET MODS C10265039V	29.01.21

Designed	NH
Drawn	NH
Checked	CW
Approved	NGB
Date	30.03.00
Cad Reference	10265-P3-112

HIMA–SELLA LIMITED © HIMA-SELLA

Title : LOOP DRAWING - OUTPUTS
ICI SYNETIX SCHEDULE - No.3 AND No.7 PLANTS
FISHER-ROSEMOUNTP.O. No. 99003994

Contract/ Drawing No	C10265H-P3	112	REV	D

50 100 150 200 250 300 350 400

16 CHANNEL
24Vdc OUTPUT MODULE

HIMA F3322

PIN		POSITION	CH.	PIN
z2	z12	1113	9	b18

0.5mmSq GREY

1113/9

I/O PLUG Z7136

ETC

1L-13

1L+13

3/C653 7

D

WINDOW 26
SPARE

≤ 12W

REMOTE ANNUNCIATOR

L-

16 CHANNEL
24Vdc OUTPUT MODULE

HIMA F3322

PIN		POSITION	CH.	PIN
z2	z12	1113	10	b20

0.5mmSq GREY

1113/10

I/O PLUG Z7136

ETC

1L-13

1L+13

3/C653 8

D

WINDOW 27
SPARE

≤ 12W

REMOTE ANNUNCIATOR

L-

16 CHANNEL
24Vdc OUTPUT MODULE

HIMA F3322

PIN		POSITION	CH.	PIN
z2	z12	1113	11	b22

0.5mmSq GREY

1113/11

I/O PLUG Z7136

ETC

1L-13

1L+13

3/C653 9

WINDOW 25
TZA 03220

≤ 12W

REMOTE ANNUNCIATOR

L-

16 CHANNEL
24Vdc OUTPUT MODULE

HIMA F3322

PIN		POSITION	CH.	PIN
z2	z12	1113	12	b24

0.5mmSq GREY

1113/12

I/O PLUG Z7136

ETC

1L-13

1L+13

3/C653 10

D

WINDOW 28
SPARE

≤ 12W

REMOTE ANNUNCIATOR

L-

NOTES
1. FIRST TERMINAL OF PAIR SHOULD ALWAYS BE '+' (ASK1 (50mA) ON ANALOGUE INPUTS ONLY).
2. ANALOGUE LOOPS WILL BE WIRED USING SCREENED CABLES WHERE POSSIBLE.
3. ALL WIRING TO BE TRI-RATED.
4. COMPENSATING CABLES FOR TYPE 'K' THERMOCOUPLES WITH COLD JUNCTION.
   COMPENSATION PROVIDED BY THE SIGNAL CONVERTOR WILL BE USED ON ALL TYPE AI4 LOOPS.
5. L- FOR ALL REMOTE ANNUNCIATORS IS DERIVED FROM THE ESD 24Vdc SUPPLY.
6. WIRE No.s ARE DEFINED USING CARD POSITION/CHANNEL NUMBER.

THIS DRAWING IS THE PROPERTY OF HIMA-SELLA LIMITED AND IS LOANED IN CONFIDENCE FOR USE WITH OUR WORK. IT IS NOT TO BE REPRODUCED IN ANY MANNER, SUBMITTED TO OUTSIDE PARTIES FOR EXAMINATION OR USED DIRECTLY OR INDIRECTLY FOR PURPOSES OTHER THAN THOSE FOR WHICH IT WAS FURNISHED WITHOUT WRITTEN CONSENT.

Template Revision – For Office Records Only

REV	AUTH	DATE	CAD TEMPLATE REF.
B	MB	7.4.10	A3-FRAME

Scale on A3 sheet	N/A
Dimensions	N/A

DO NOT STAMP 'MASTER' UNTIL ALL WORK IS FULLY CADDED

Rev	Design	Drawn	Chkd	Appd	Description	Date
C	NH	NH	CW	NGB	AS BUILT.	06.06.00
D				CT	PLANT 3 ESD CABINET MODS C10265039V	29.01.21

Designed	NH
Drawn	NH
Checked	CW
Approved	NGB
Date	30.03.00
Cad Reference	10265-P3-113

HIMA–SELLA LIMITED © HIMA-SELLA

Title : LOOP DRAWING - OUTPUTS
ICI SYNETIX SCHEDULE - No.3 AND No.7 PLANTS
FISHER-ROSEMOUNTP.O. No. 99003994

Contract/ Drawing No	C10265H-P3	113	REV	D

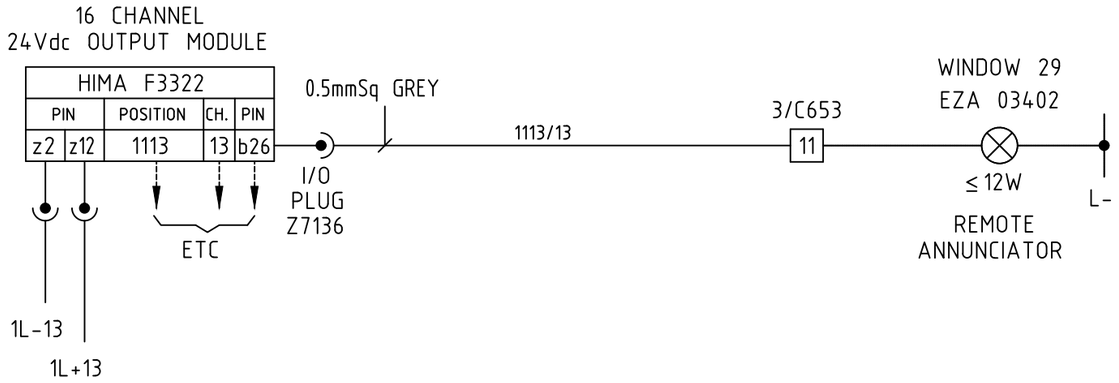

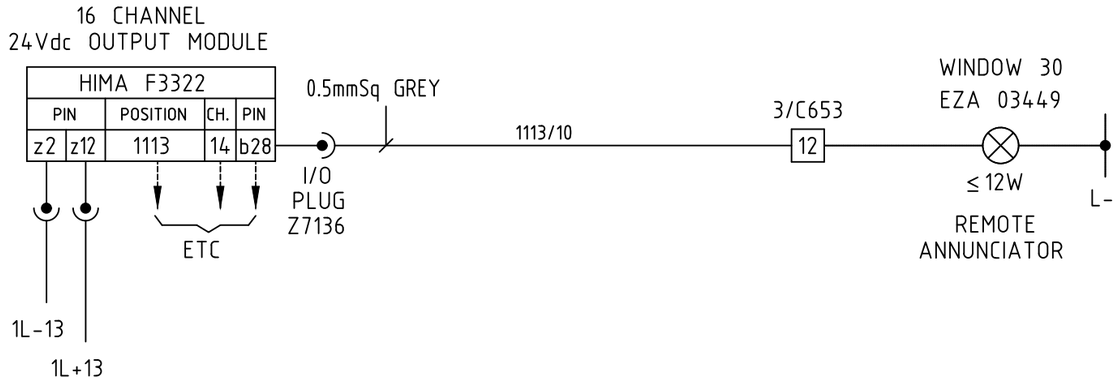

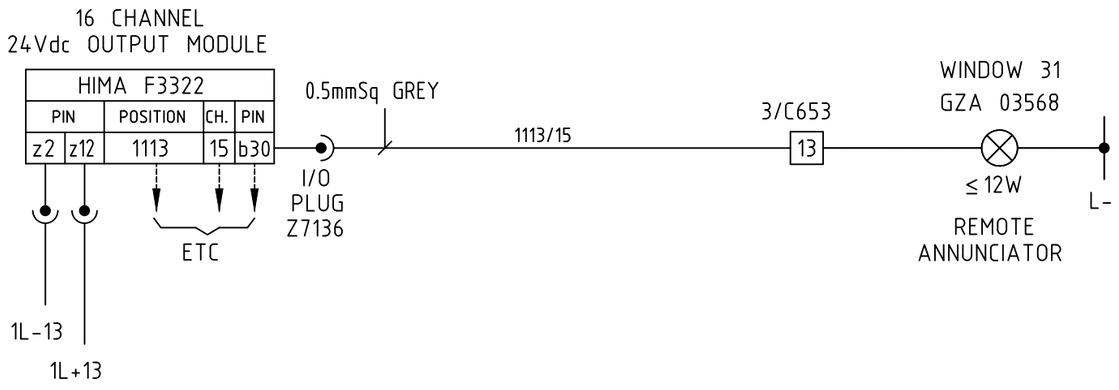

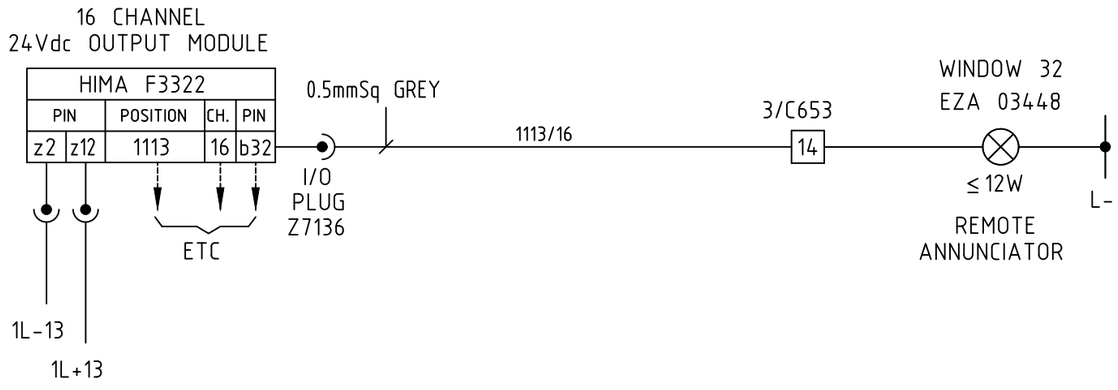

NOTES
1. FIRST TERMINAL OF PAIR SHOULD ALWAYS BE '+' (ASK1 (50mA) ON ANALOGUE INPUTS ONLY).
2. ANALOGUE LOOPS WILL BE WIRED USING SCREENED CABLES WHERE POSSIBLE.
3. ALL WIRING TO BE TRI-RATED.
4. COMPENSATING CABLES FOR TYPE 'K' THERMOCOUPLES WITH COLD JUNCTION.
   COMPENSATION PROVIDED BY THE SIGNAL CONVERTOR WILL BE USED ON ALL TYPE AI4 LOOPS.
5. L- FOR ALL REMOTE ANNUNCIATORS IS DERIVED FROM THE ESD 24Vdc SUPPLY.
6. WIRE No.s ARE DEFINED USING CARD POSITION/CHANNEL NUMBER.

THIS DRAWING IS THE PROPERTY OF HIMA-SELLA LIMITED AND IS LOANED IN CONFIDENCE FOR USE WITH OUR WORK. IT IS NOT TO BE REPRODUCED IN ANY MANNER, SUBMITTED TO OUTSIDE PARTIES FOR EXAMINATION OR USED DIRECTLY OR INDIRECTLY FOR PURPOSES OTHER THAN THOSE FOR WHICH IT WAS FURNISHED WITHOUT WRITTEN CONSENT.

Template Revision – For Office Records Only

REV	AUTH	DATE	CAD TEMPLATE REF.
B	MB	7.4.10	A3-FRAME

Scale on A3 sheet	N/A
Dimensions	N/A

DO NOT STAMP 'MASTER' UNTIL ALL WORK IS FULLY CADDED

Rev	Design	Drawn	Chkd	Appd	Description	Date
C	NH	NH	CW	NGB	AS BUILT.	06.06.00
.					. . .	. .

Designed	NH
Drawn	NH
Checked	CW
Approved	NGB
Date	30.03.00
Cad Reference	10265-P3-114

HIMA–SELLA LIMITED © HIMA-SELLA

Title : LOOP DRAWING - OUTPUTS
ICI SYNETIX SCHEDULE - No.3 AND No.7 PLANTS
FISHER-ROSEMOUNTP.O. No. 99003994

Contract/ Drawing No				
	C10265H-P3	114	REV	C

50 100 150 200 250 300 350 400

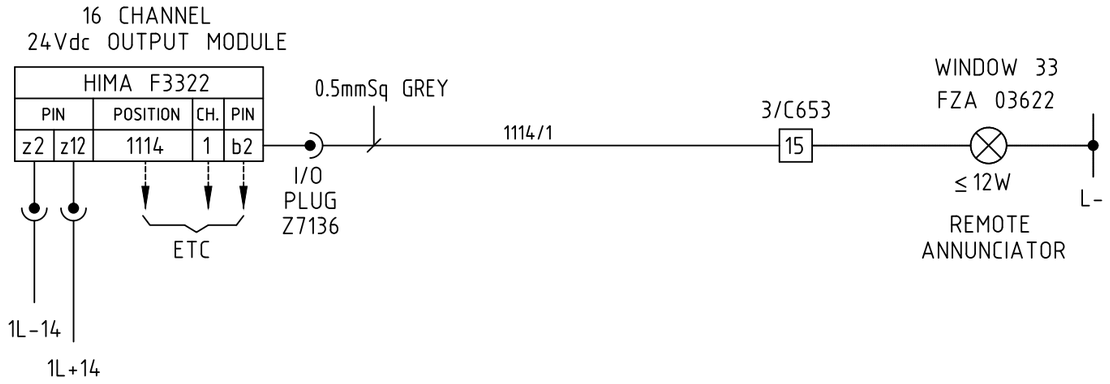

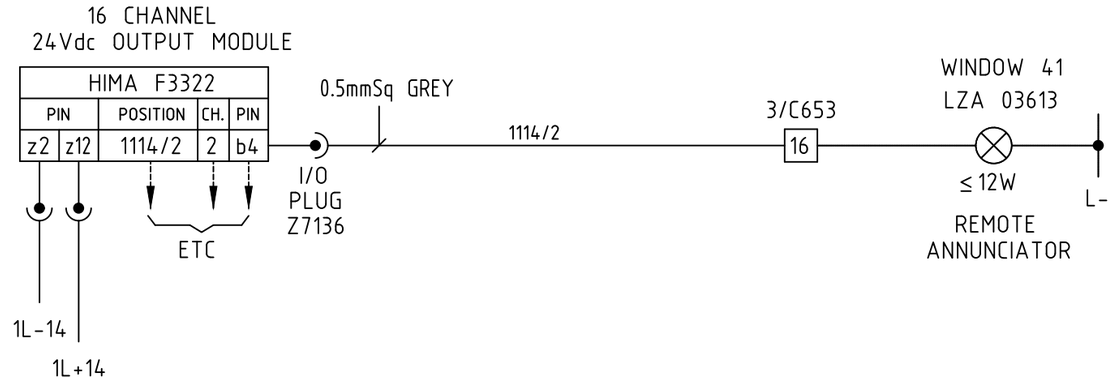

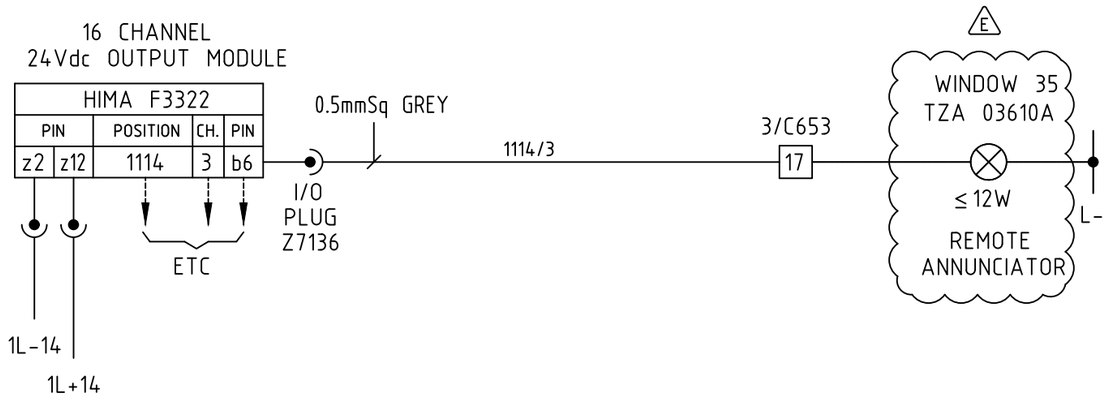

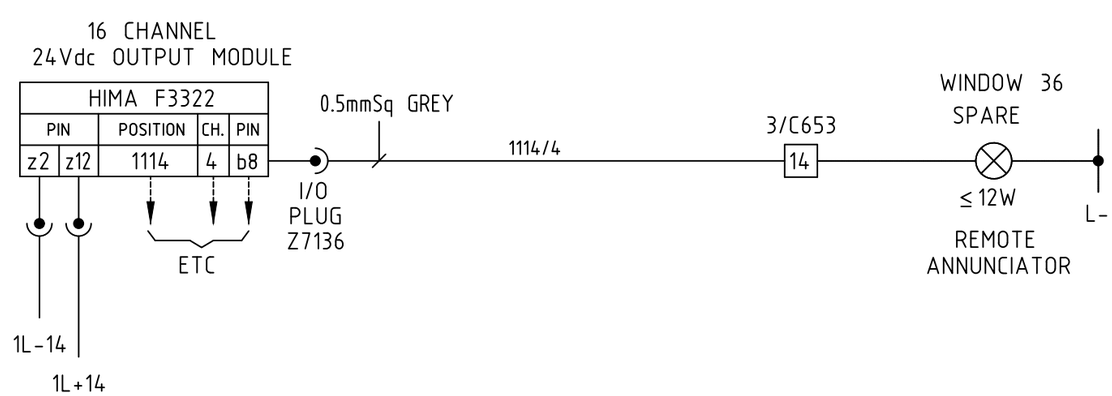

NOTES
1. FIRST TERMINAL OF PAIR SHOULD ALWAYS BE '+' (ASK1 (50mA) ON ANALOGUE INPUTS ONLY).
2. ANALOGUE LOOPS WILL BE WIRED USING SCREENED CABLES WHERE POSSIBLE.
3. ALL WIRING TO BE TRI-RATED.
4. COMPENSATING CABLES FOR TYPE 'K' THERMOCOUPLES WITH COLD JUNCTION.
   COMPENSATION PROVIDED BY THE SIGNAL CONVERTOR WILL BE USED ON ALL TYPE AI4 LOOPS.
5. L- FOR ALL REMOTE ANNUNCIATORS IS DERIVED FROM THE ESD 24Vdc SUPPLY.
6. WIRE No.s ARE DEFINED USING CARD POSITION/CHANNEL NUMBER.

THIS DRAWING IS THE PROPERTY OF HIMA-SELLA LIMITED AND IS LOANED IN CONFIDENCE FOR USE WITH OUR WORK. IT IS NOT TO BE REPRODUCED IN ANY MANNER, SUBMITTED TO OUTSIDE PARTIES FOR EXAMINATION OR USED DIRECTLY OR INDIRECTLY FOR PURPOSES OTHER THAN THOSE FOR WHICH IT WAS FURNISHED WITHOUT WRITTEN CONSENT.

Template Revision – For Office Records Only

REV	AUTH	DATE	CAD TEMPLATE REF.
B	MB	7.4.10	A3-FRAME

Scale on A3 sheet	N/A
Dimensions	N/A

DO NOT STAMP 'MASTER' UNTIL ALL WORK IS FULLY CADDED

Rev	Design	Drawn	Chkd	Appd	Description	Date
C	NH	NH	CW	NGB	AS BUILT.	06.06.00
D	DP	MW	AD	CT	AS BUILT PER C10265-012V	29.10.14
E				CW	MODS TO 3 PLANT ESD SYSTEM AS PER C10265033V	20.03.19

Designed	NH
Drawn	NH
Checked	CW
Approved	NGB
Date	30.03.00
Cad Reference	10265-P3-115

HIMA–SELLA LIMITED © HIMA-SELLA

Title : LOOP DRAWING - OUTPUTS
ICI SYNETIX SCHEDULE - No.3 AND No.7 PLANTS
FISHER-ROSEMOUNTP.O. No. 99003994

Contract/ Drawing No	C10265H-P3	115	REV	E

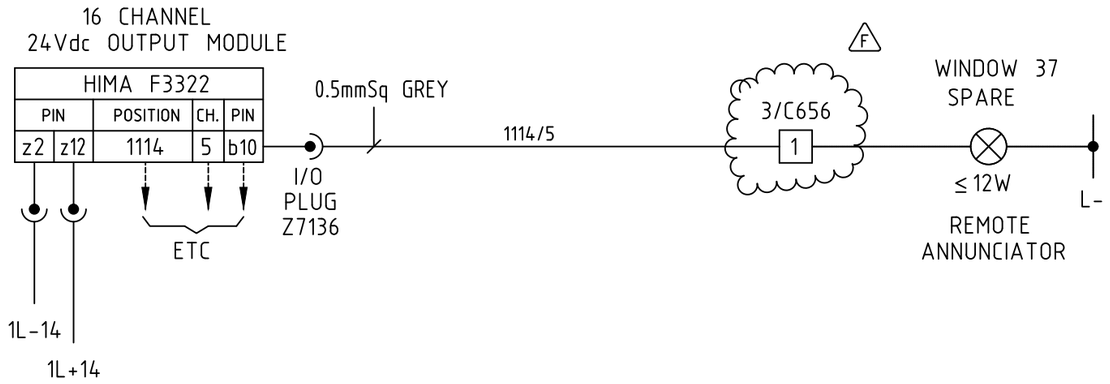

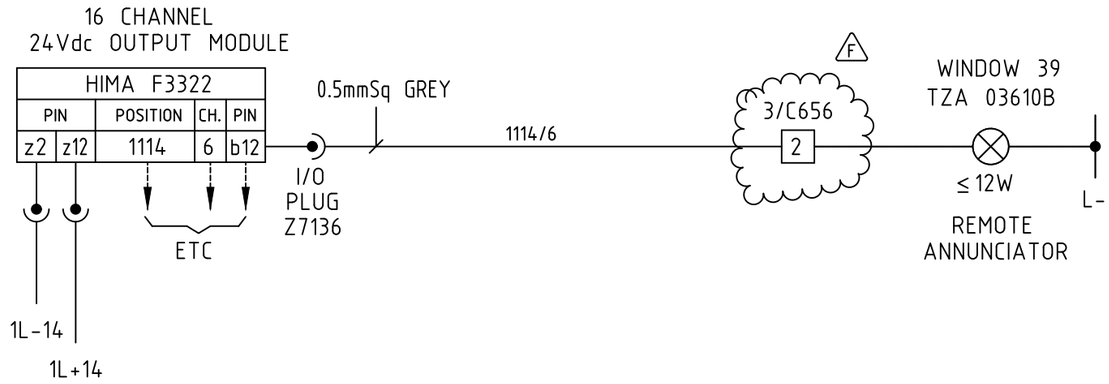

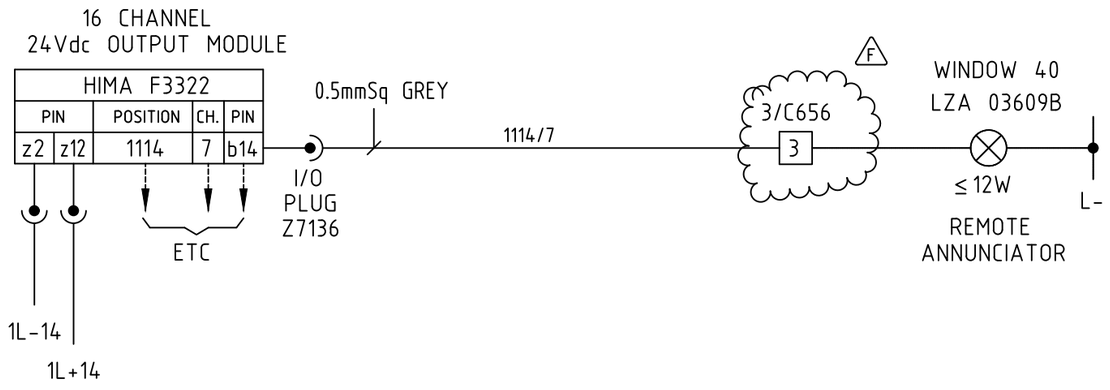

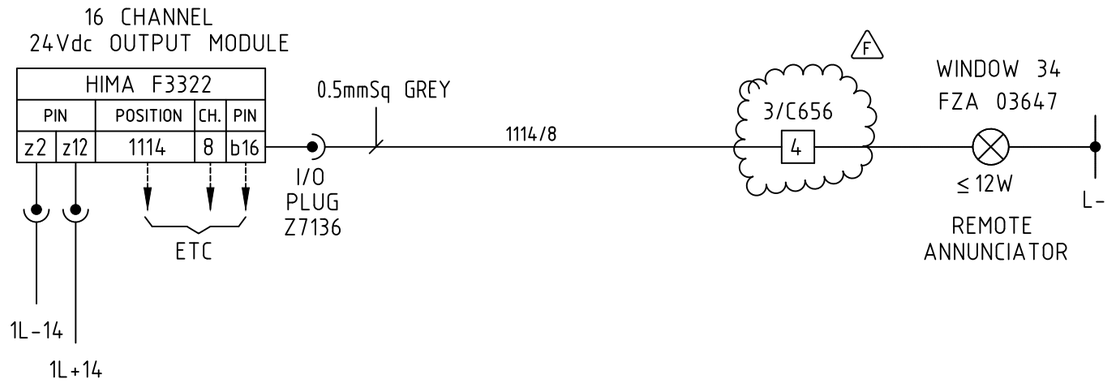

NOTES
1. FIRST TERMINAL OF PAIR SHOULD ALWAYS BE '+' (ASK1 (50mA) ON ANALOGUE INPUTS ONLY).
2. ANALOGUE LOOPS WILL BE WIRED USING SCREENED CABLES WHERE POSSIBLE.
3. ALL WIRING TO BE TRI-RATED.
4. COMPENSATING CABLES FOR TYPE 'K' THERMOCOUPLES WITH COLD JUNCTION.
   COMPENSATION PROVIDED BY THE SIGNAL CONVERTOR WILL BE USED ON ALL TYPE AI4 LOOPS.
5. L- FOR ALL REMOTE ANNUNCIATORS IS DERIVED FROM THE ESD 24Vdc SUPPLY.
6. WIRE No.s ARE DEFINED USING CARD POSITION/CHANNEL NUMBER.

THIS DRAWING IS THE PROPERTY OF HIMA-SELLA LIMITED AND IS LOANED IN CONFIDENCE FOR USE WITH OUR WORK. IT IS NOT TO BE REPRODUCED IN ANY MANNER, SUBMITTED TO OUTSIDE PARTIES FOR EXAMINATION OR USED DIRECTLY OR INDIRECTLY FOR PURPOSES OTHER THAN THOSE FOR WHICH IT WAS FURNISHED WITHOUT WRITTEN CONSENT.

Template Revision – For Office Records Only

REV	AUTH	DATE	CAD TEMPLATE REF.
B	MB	7.4.10	A3-FRAME

Scale on A3 sheet	N/A
Dimensions	N/A

DO NOT STAMP 'MASTER' UNTIL ALL WORK IS FULLY CADDED

Rev	Design	Drawn	Chkd	Appd	Description	Date
C	NH	NH	CW	NGB	AS BUILT.	06.06.00
D	DP	MW	AD	CT	AS BUILT PER C10265-012V	29.10.14
E	DP	HG	SP	CW	MODS TO 3 PLANT ESD SYSTEM AS PER C10265033V	20.03.19
F					AS BUILT - C10265033V	01.05.19

Designed	NH
Drawn	NH
Checked	CW
Approved	NGB
Date	30.03.00
Cad Reference	10265-P3-116

HIMA–SELLA LIMITED © HIMA-SELLA

Title : LOOP DRAWING - OUTPUTS
ICI SYNETIX SCHEDULE - No.3 AND No.7 PLANTS
FISHER-ROSEMOUNTP.O. No. 99003994

Contract/ Drawing No	C10265H-P3	116	REV	F

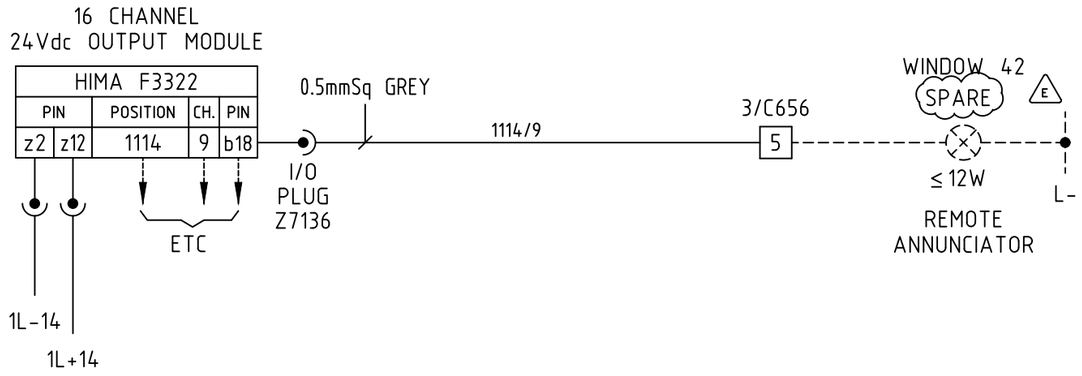

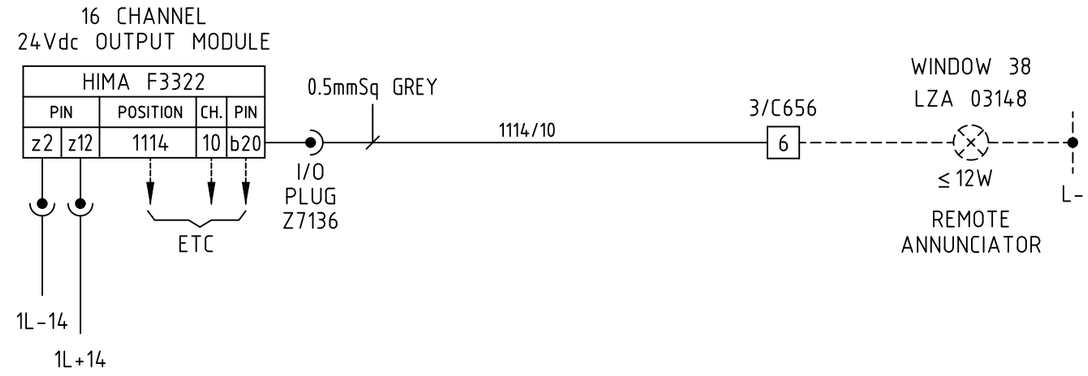

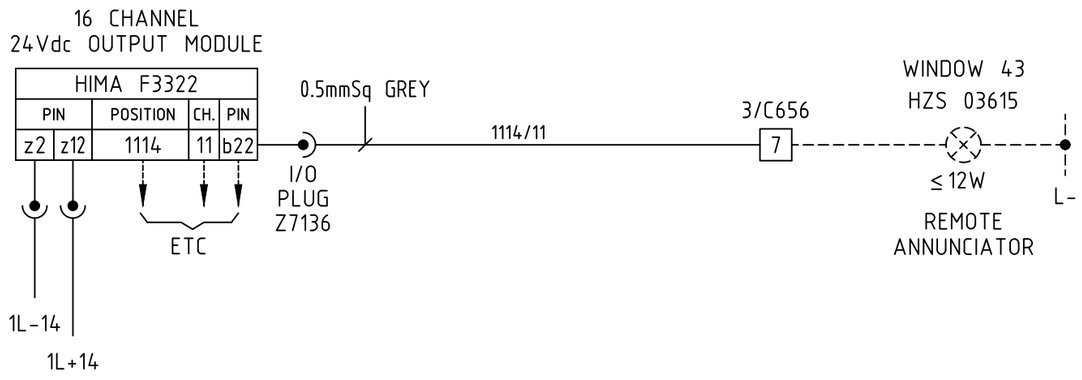

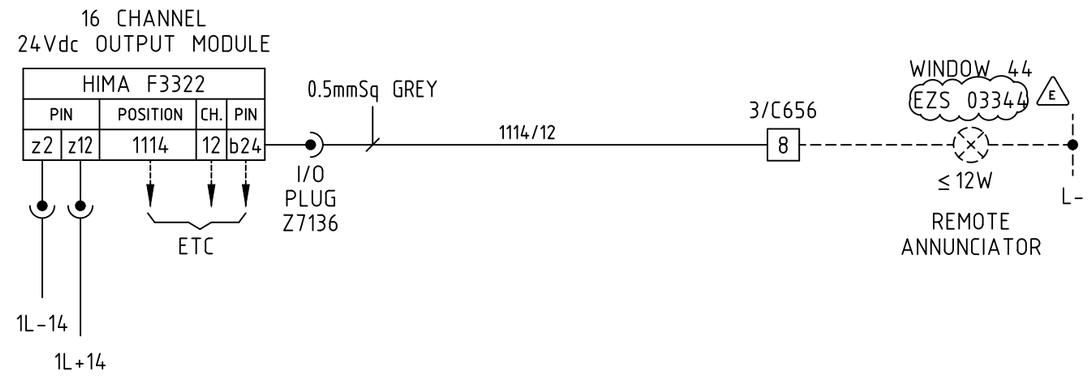

NOTES

1. FIRST TERMINAL OF PAIR SHOULD ALWAYS BE '+' (ASK1 (50mA) ON ANALOGUE INPUTS ONLY).
2. ANALOGUE LOOPS WILL BE WIRED USING SCREENED CABLES WHERE POSSIBLE.
3. ALL WIRING TO BE TRI-RATED.
4. COMPENSATING CABLES FOR TYPE 'K' THERMOCOUPLES WITH COLD JUNCTION COMPENSATION PROVIDED BY THE SIGNAL CONVERTER WILL BE USED ON ALL TYPE AI4 LOOPS.
5. L- FOR ALL REMOTE ANNUNCIATORS IS DERIVED FROM THE ESD 24Vdc SUPPLY.
6. WIRE No.s ARE DEFINED USING CARD POSITION/CHANNEL NUMBER.

THIS DRAWING IS THE PROPERTY OF HIMA-SELLA LIMITED AND IS LOANED IN CONFIDENCE FOR USE WITH OUR WORK. IT IS NOT TO BE REPRODUCED IN ANY MANNER, SUBMITTED TO OUTSIDE PARTIES FOR EXAMINATION OR USED DIRECTLY OR INDIRECTLY FOR PURPOSES OTHER THAN THOSE FOR WHICH IT WAS FURNISHED WITHOUT WRITTEN CONSENT.

Template Revision – For Office Records Only

REV	AUTH	DATE	CAD TEMPLATE REF.
A	PRS	9.2.00	A3-FRAME

Scale on A3 sheet	N/A
Dimensions	N/A

DO NOT STAMP 'MASTER' UNTIL ALL WORK IS FULLY CADDED

Rev	Design	Drawn	Chkd	Appd	Description	Date
C	NH	NH	CW	NGB	AS BUILT.	06.06.00
D	CP	EJC	CW	NGB	SITE MODS	15.09.00
E				CT	AS BUILT PER C10265-012V	29.10.14

Designed	NH
Drawn	NH
Checked	CW
Approved	NGB
Date	29.03.00
Cad Reference	
10265-P3-LOOPS#JC02	

HIMA–SELLA LIMITED © HIMA-SELLA

Title : LOOP DRAWING - OUTPUTS
ICI SYNETIX ESD SYSTEM - No.3 AND No.7 PLANTS
FISHER-ROSEMOUNT - P.O. No. 99003994

Contract/ Drawing No	C10265H/P3	117	REV	E

50 100 150 200 250 300 350 400

16 CHANNEL
24Vdc OUTPUT MODULE

HIMA F3322

PIN		POSITION	CH.	PIN
z2	z12	1114	13	b26

0.5mmSq GREY

1114/13

I/O PLUG Z7136

3/C656 — 9

WINDOW 45
LZA 03691

≤ 12W

REMOTE ANNUNCIATOR

L-

ETC

1L-14

1L+14

16 CHANNEL
24Vdc OUTPUT MODULE

HIMA F3322

PIN		POSITION	CH.	PIN
z2	z12	1114	14	b28

0.5mmSq GREY

1114/14

I/O PLUG Z7136

3/C656 — 10

WINDOW 46
FZA 03007

≤ 12W

REMOTE ANNUNCIATOR

L-

ETC

1L-14

1L+14

16 CHANNEL
24Vdc OUTPUT MODULE

HIMA F3322

PIN		POSITION	CH.	PIN
z2	z12	1114	15	b30

0.5mmSq GREY

1114/15

I/O PLUG Z7136

3/C656 — 11

WINDOW 47
FZA 03008

≤ 12W

REMOTE ANNUNCIATOR

L-

ETC

1L-14

1L+14

16 CHANNEL
24Vdc OUTPUT MODULE

HIMA F3322

PIN		POSITION	CH.	PIN
z2	z12	1114	16	b32

0.5mmSq GREY

1114/16

I/O PLUG Z7136

3/C656 — 12

WINDOW 48
FZA 03010

≤ 12W

REMOTE ANNUNCIATOR

L-

ETC

1L-14

1L+14

THIS DRAWING IS THE PROPERTY OF HIMA-SELLA LIMITED AND IS LOANED IN CONFIDENCE FOR USE WITH OUR WORK. IT IS NOT TO BE REPRODUCED IN ANY MANNER, SUBMITTED TO OUTSIDE PARTIES FOR EXAMINATION OR USED DIRECTLY OR INDIRECTLY FOR PURPOSES OTHER THAN THOSE FOR WHICH IT WAS FURNISHED WITHOUT WRITTEN CONSENT.

Template Revision – For Office Records Only

REV	AUTH	DATE	CAD TEMPLATE REF.
B	MB	7.4.10	A3-FRAME

Scale on A3 sheet	N/A
Dimensions	N/A

DO NOT STAMP 'MASTER' UNTIL ALL WORK IS FULLY CADDED

Rev	Design	Drawn	Chkd	Appd	Description	Date
C	NH	NH	CW	NGB	AS BUILT.	06.06.00
D					INSTRUMENTS ADDED.	13.08.09

Designed	NH
Drawn	NH
Checked	CW
Approved	NGB
Date	29.03.00
Cad Reference	10265-P3-118

HIMA–SELLA LIMITED © HIMA-SELLA

Title : LOOP DRAWING - OUTPUTS
ICI SYNETIX SCHEDULE - No.3 AND No.7 PLANTS
FISHER-ROSEMOUNTP.O. No. 99003994

Contract/ Drawing No	C10265H-P3	118	REV	D

SPARE

16 CHANNEL
24Vdc OUTPUT MODULE

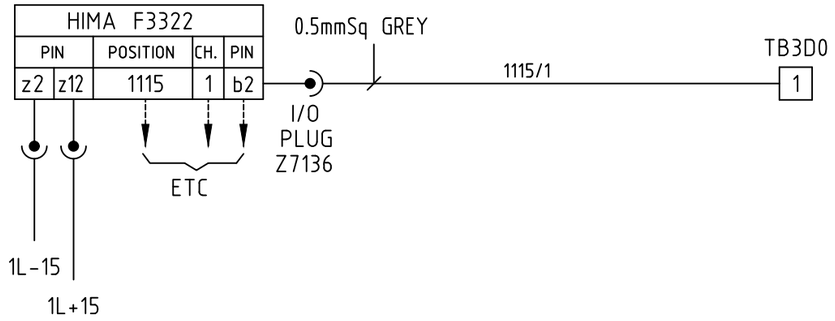

SPARE

16 CHANNEL
24Vdc OUTPUT MODULE

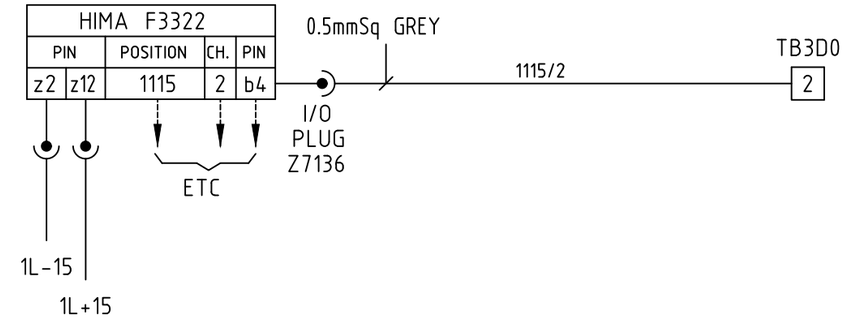

16 CHANNEL
24Vdc OUTPUT MODULE

SPARE

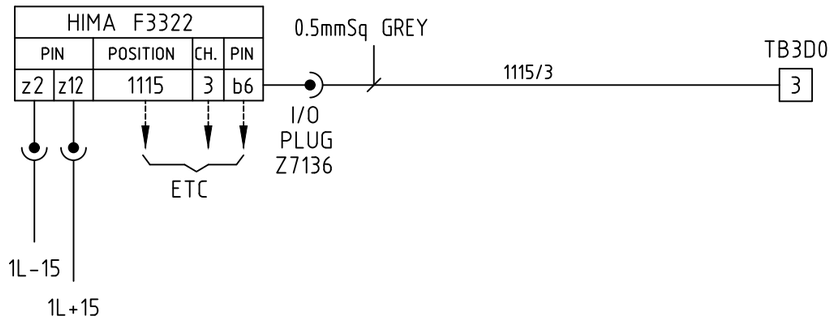

16 CHANNEL
24Vdc OUTPUT MODULE

SPARE

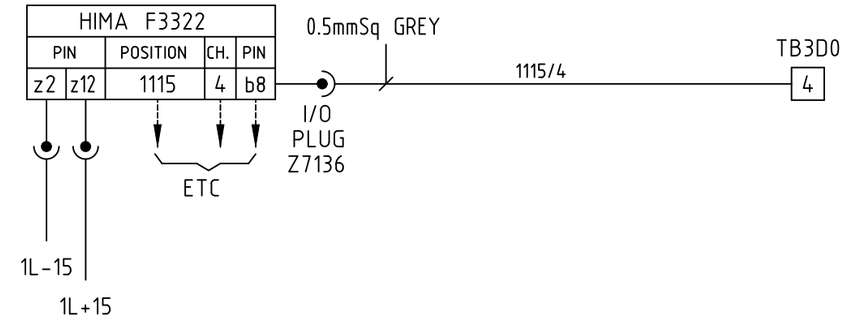

NOTES
1. FIRST TERMINAL OF PAIR SHOULD ALWAYS BE '+' (ASK1 (50mA) ON ANALOGUE INPUTS ONLY).
2. ANALOGUE LOOPS WILL BE WIRED USING SCREENED CABLES WHERE POSSIBLE.
3. ALL WIRING TO BE TRI-RATED.
4. COMPENSATING CABLES FOR TYPE 'K' THERMOCOUPLES WITH COLD JUNCTION.
   COMPENSATION PROVIDED BY THE SIGNAL CONVERTOR WILL BE USED ON ALL TYPE AI4 LOOPS.
5. L- FOR ALL REMOTE ANNUNCIATORS IS DERIVED FROM THE ESD 24Vdc SUPPLY.
6. WIRE No.s ARE DEFINED USING CARD POSITION/CHANNEL NUMBER.

THIS DRAWING IS THE PROPERTY OF HIMA-SELLA LIMITED AND IS LOANED IN CONFIDENCE FOR USE WITH OUR WORK. IT IS NOT TO BE REPRODUCED IN ANY MANNER, SUBMITTED TO OUTSIDE PARTIES FOR EXAMINATION OR USED DIRECTLY OR INDIRECTLY FOR PURPOSES OTHER THAN THOSE FOR WHICH IT WAS FURNISHED WITHOUT WRITTEN CONSENT.

Template Revision – For Office Records Only

REV	AUTH	DATE	CAD TEMPLATE REF.
B	MB	7.4.10	A3-FRAME

Scale on A3 sheet	N/A
Dimensions	N/A

DO NOT STAMP 'MASTER' UNTIL ALL WORK IS FULLY CADDED

Rev	Design	Drawn	Chkd	Appd	Description	Date
C	NH	NH	CW	NGB	AS BUILT.	06.06.00
D					SPARE ADDED	06.10.11

Designed	NH
Drawn	NH
Checked	CW
Approved	NGB
Date	29.03.00
Cad Reference	10265-P3-119

HIMA–SELLA LIMITED © HIMA-SELLA

Title : LOOP DRAWING - OUTPUTS
ICI SYNETIX SCHEDULE - No.3 AND No.7 PLANTS
FISHER-ROSEMOUNTP.O. No. 99003994

Contract/ Drawing No	C10265H-P3	119	REV	D

50 100 150 200 250 300 350 400

SPARE

16 CHANNEL
24Vdc OUTPUT MODULE

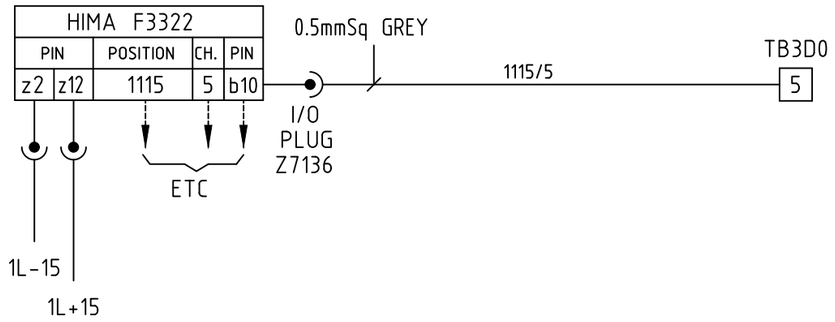

SPARE

16 CHANNEL
24Vdc OUTPUT MODULE

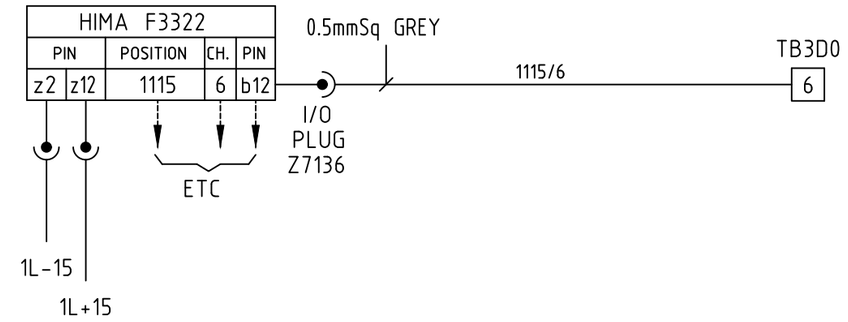

SPARE

16 CHANNEL
24Vdc OUTPUT MODULE

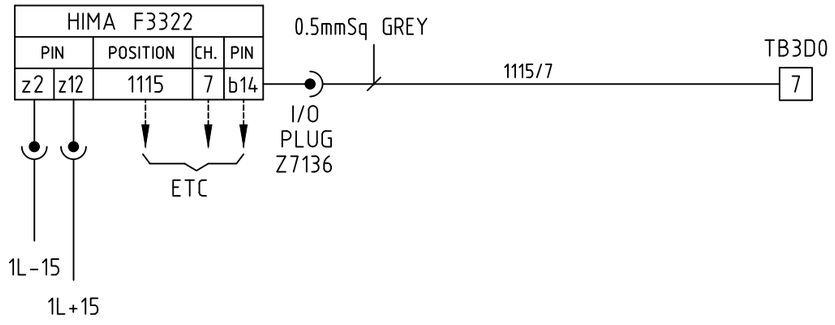

SPARE

16 CHANNEL
24Vdc OUTPUT MODULE

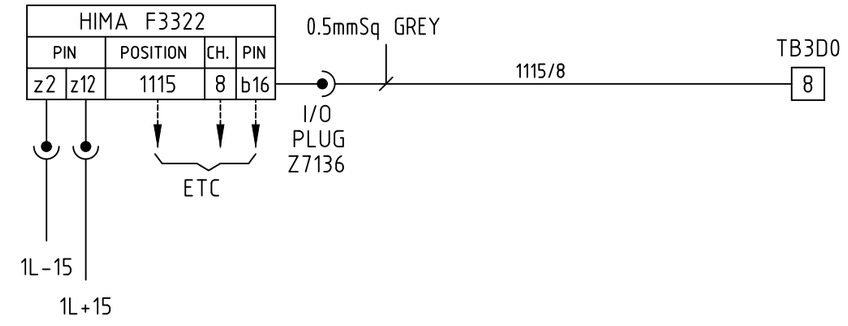

NOTES
1. FIRST TERMINAL OF PAIR SHOULD ALWAYS BE '+' (ASK1 (50mA) ON ANALOGUE INPUTS ONLY).
2. ANALOGUE LOOPS WILL BE WIRED USING SCREENED CABLES WHERE POSSIBLE.
3. ALL WIRING TO BE TRI-RATED.
4. COMPENSATING CABLES FOR TYPE 'K' THERMOCOUPLES WITH COLD JUNCTION.
   COMPENSATION PROVIDED BY THE SIGNAL CONVERTOR WILL BE USED ON ALL TYPE AI4 LOOPS.
5. L- FOR ALL REMOTE ANNUNCIATORS IS DERIVED FROM THE ESD 24Vdc SUPPLY.
6. WIRE No.s ARE DEFINED USING CARD POSITION/CHANNEL NUMBER.

THIS DRAWING IS THE PROPERTY OF HIMA-SELLA LIMITED AND IS LOANED IN CONFIDENCE FOR USE WITH OUR WORK. IT IS NOT TO BE REPRODUCED IN ANY MANNER, SUBMITTED TO OUTSIDE PARTIES FOR EXAMINATION OR USED DIRECTLY OR INDIRECTLY FOR PURPOSES OTHER THAN THOSE FOR WHICH IT WAS FURNISHED WITHOUT WRITTEN CONSENT.

Template Revision – For Office Records Only

REV	AUTH	DATE	CAD TEMPLATE REF.
B	MB	7.4.10	A3-FRAME

Scale on A3 sheet	N/A
Dimensions	N/A

DO NOT STAMP 'MASTER' UNTIL ALL WORK IS FULLY CADDED

Rev	Design	Drawn	Chkd	Appd	Description	Date
C	NH	NH	CW	NGB	AS BUILT.	06.06.00
D					SPARE ADDED	06.10.11

Designed	NH
Drawn	NH
Checked	CW
Approved	NGB
Date	29.03.00
Cad Reference	10265-P3-120

HIMA–SELLA LIMITED © HIMA-SELLA

Title : LOOP DRAWING - OUTPUTS
ICI SYNETIX SCHEDULE - No.3 AND No.7 PLANTS
FISHER-ROSEMOUNTP.O. No. 99003994

Contract/ Drawing No	C10265H-P3	120	REV	D

50 100 150 200 250 300 350 400

SPARE

16 CHANNEL
24Vdc OUTPUT MODULE

HIMA F3322				
PIN		POSITION	CH.	PIN
z2	z12	1115	9	b18

0.5mmSq GREY — 1115/9 — TB3D0 [9]

I/O PLUG Z7136

ETC

1L-15

1L+15

SPARE

SPARE

16 CHANNEL
24Vdc OUTPUT MODULE

HIMA F3322				
PIN		POSITION	CH.	PIN
z2	z12	1115	10	b20

0.5mmSq GREY — 1115/10 — TB3D0 [10]

I/O PLUG Z7136

ETC

1L-15

1L+15

SPARE

SPARE

16 CHANNEL
24Vdc OUTPUT MODULE

HIMA F3322				
PIN		POSITION	CH.	PIN
z2	z12	1115	11	b22

0.5mmSq GREY — 1115/11 — TB3D0 [11]

I/O PLUG Z7136

ETC

1L-15

1L+15

SPARE

SPARE

16 CHANNEL
24Vdc OUTPUT MODULE

HIMA F3322				
PIN		POSITION	CH.	PIN
z2	z12	1115	12	b24

0.5mmSq GREY — 1115/12 — TB3D0 [12]

I/O PLUG Z7136

ETC

1L-15

1L+15

SPARE

NOTES
1. FIRST TERMINAL OF PAIR SHOULD ALWAYS BE '+' (ASK1 (50mA) ON ANALOGUE INPUTS ONLY).
2. ANALOGUE LOOPS WILL BE WIRED USING SCREENED CABLES WHERE POSSIBLE.
3. ALL WIRING TO BE TRI-RATED.
4. COMPENSATING CABLES FOR TYPE 'K' THERMOCOUPLES WITH COLD JUNCTION. COMPENSATION PROVIDED BY THE SIGNAL CONVERTOR WILL BE USED ON ALL TYPE AI4 LOOPS.
5. L- FOR ALL REMOTE ANNUNCIATORS IS DERIVED FROM THE ESD 24Vdc SUPPLY.
6. WIRE No.s ARE DEFINED USING CARD POSITION/CHANNEL NUMBER.

THIS DRAWING IS THE PROPERTY OF HIMA-SELLA LIMITED AND IS LOANED IN CONFIDENCE FOR USE WITH OUR WORK. IT IS NOT TO BE REPRODUCED IN ANY MANNER, SUBMITTED TO OUTSIDE PARTIES FOR EXAMINATION OR USED DIRECTLY OR INDIRECTLY FOR PURPOSES OTHER THAN THOSE FOR WHICH IT WAS FURNISHED WITHOUT WRITTEN CONSENT.

Template Revision – For Office Records Only

REV	AUTH	DATE	CAD TEMPLATE REF.
B	MB	7.4.10	A3-FRAME

Scale on A3 sheet	N/A
Dimensions	N/A

DO NOT STAMP 'MASTER' UNTIL ALL WORK IS FULLY CADDED

Rev	Design	Drawn	Chkd	Appd	Description	Date
C	NH	NH	CW	NGB	AS BUILT.	06.06.00
D					SPARE ADDED	06.10.11

Designed	NH
Drawn	NH
Checked	CW
Approved	NGB
Date	29.03.00
Cad Reference	10265-P3-121

HIMA–SELLA LIMITED © HIMA-SELLA

Title : LOOP DRAWING - OUTPUTS
ICI SYNETIX SCHEDULE - No.3 AND No.7 PLANTS
FISHER-ROSEMOUNTP.O. No. 99003994

Contract/ Drawing No	C10265H-P3	121	REV	C

50 100 150 200 250 300 350 400

SPARE

16 CHANNEL
24Vdc OUTPUT MODULE

HIMA F3322				
PIN		POSITION	CH.	PIN
z2	z12	1115	13	b26

0.5mmSq GREY — 1115/13 — TB3D0 13

I/O PLUG Z7136

ETC

1L-15

1L+15

SPARE

16 CHANNEL
24Vdc OUTPUT MODULE

HIMA F3322				
PIN		POSITION	CH.	PIN
z2	z12	1115	14	b28

0.5mmSq GREY — 1115/14 — TB3D0 14

I/O PLUG Z7136

ETC

1L-15

2L+3

16 CHANNEL
24Vdc OUTPUT MODULE

HIMA F3322				
PIN		POSITION	CH.	PIN
z2	z12	1115	15	b30

0.5mmSq GREY — 1115/15

I/O PLUG Z7136

ETC

1L-15

2L+3

PES FAULT — Y — SYSTEM STATUS PLATE

4L-

16 CHANNEL
24Vdc OUTPUT MODULE

HIMA F3322				
PIN		POSITION	CH.	PIN
z2	z12	1115	16	b32

0.5mmSq GREY — 1115/16

I/O PLUG Z7136

ETC

1L-15

1L+15

ANALOGUE FAULT — Y — SYSTEM STATUS PLATE

4L-

NOTES
1. FIRST TERMINAL OF PAIR SHOULD ALWAYS BE '+' (ASK1 (50mA) ON ANALOGUE INPUTS ONLY).
2. ANALOGUE LOOPS WILL BE WIRED USING SCREENED CABLES WHERE POSSIBLE.
3. ALL WIRING TO BE TRI-RATED.
4. COMPENSATING CABLES FOR TYPE 'K' THERMOCOUPLES WITH COLD JUNCTION. COMPENSATION PROVIDED BY THE SIGNAL CONVERTOR WILL BE USED ON ALL TYPE AI4 LOOPS.
5. L- FOR ALL REMOTE ANNUNCIATORS IS DERIVED FROM THE ESD 24Vdc SUPPLY.
6. WIRE No.s ARE DEFINED USING CARD POSITION/CHANNEL NUMBER.

THIS DRAWING IS THE PROPERTY OF HIMA-SELLA LIMITED AND IS LOANED IN CONFIDENCE FOR USE WITH OUR WORK. IT IS NOT TO BE REPRODUCED IN ANY MANNER, SUBMITTED TO OUTSIDE PARTIES FOR EXAMINATION OR USED DIRECTLY OR INDIRECTLY FOR PURPOSES OTHER THAN THOSE FOR WHICH IT WAS FURNISHED WITHOUT WRITTEN CONSENT.

Template Revision – For Office Records Only

REV	AUTH	DATE	CAD TEMPLATE REF.
B	MB	7.4.10	A3-FRAME

Scale on A3 sheet	N/A
Dimensions	N/A

DO NOT STAMP 'MASTER' UNTIL ALL WORK IS FULLY CADDED

Rev	Design	Drawn	Chkd	Appd	Description	Date
C	NH	NH	CW	NGB	AS BUILT.	06.06.00
D					SPARE ADDED	06.10.11

Designed	NH
Drawn	NH
Checked	CW
Approved	NGB
Date	29.03.00
Cad Reference	10265-P3-121

HIMA–SELLA LIMITED © HIMA-SELLA

Title : LOOP DRAWING - OUTPUTS
ICI SYNETIX SCHEDULE - No.3 AND No.7 PLANTS
FISHER-ROSEMOUNTP.O. No. 99003994

Contract/ Drawing No	C10265H-P3	122	REV	D

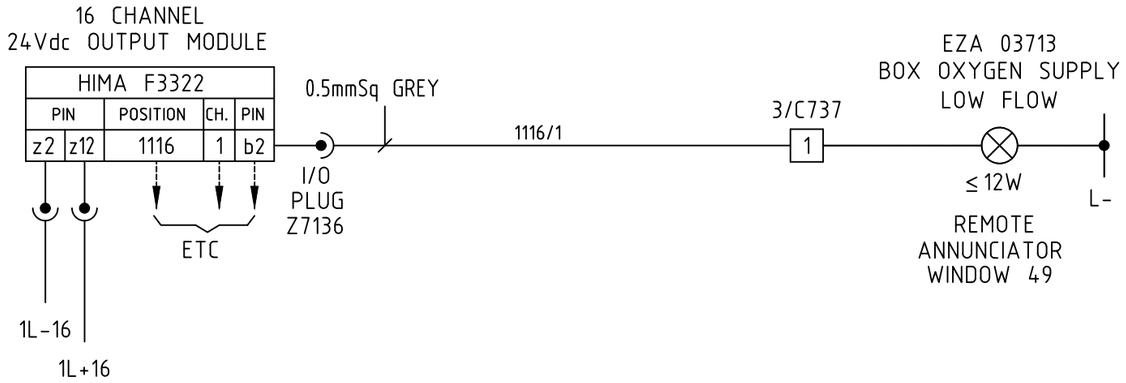

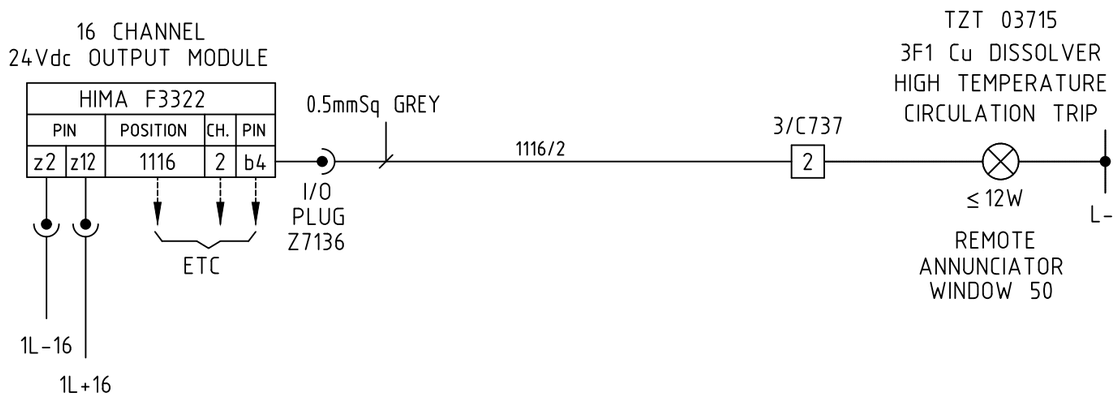

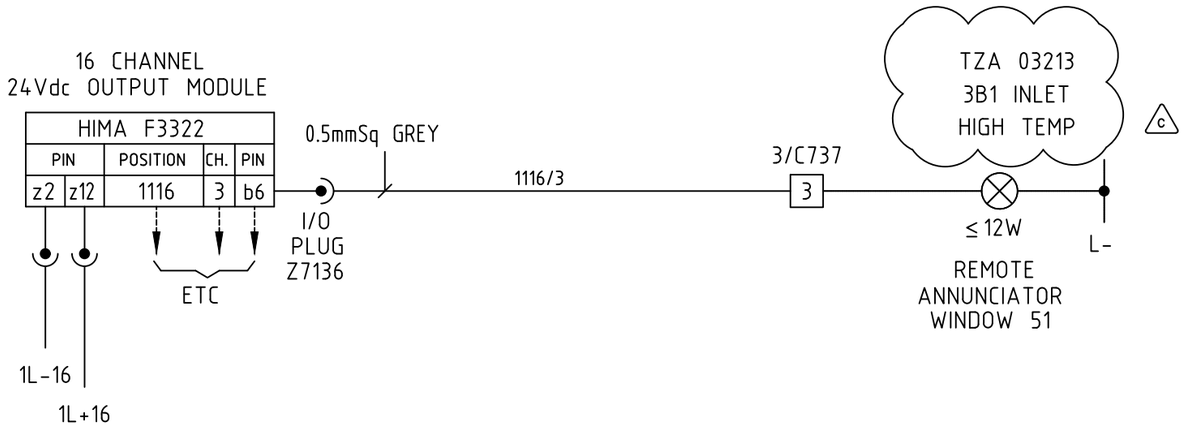

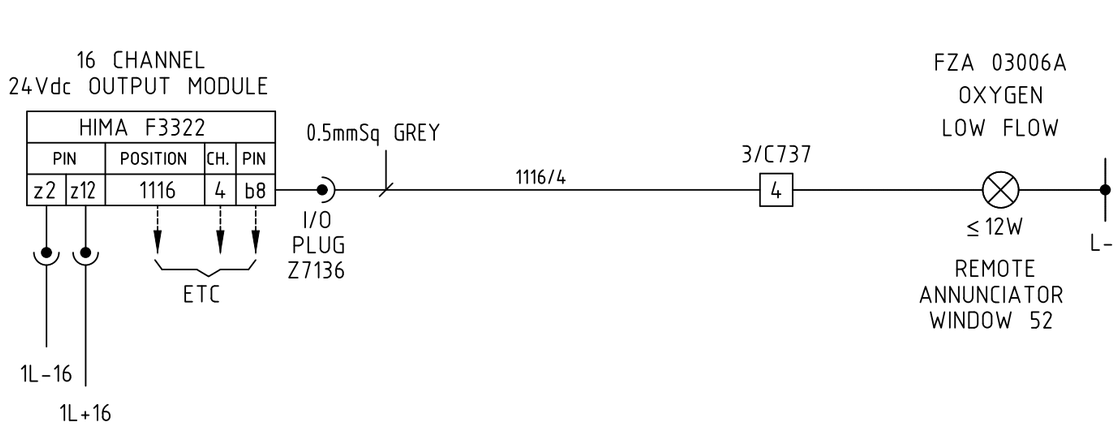

THIS DRAWING IS THE PROPERTY OF HIMA-SELLA LIMITED AND IS LOANED IN CONFIDENCE FOR USE WITH OUR WORK. IT IS NOT TO BE REPRODUCED IN ANY MANNER, SUBMITTED TO OUTSIDE PARTIES FOR EXAMINATION OR USED DIRECTLY OR INDIRECTLY FOR PURPOSES OTHER THAN THOSE FOR WHICH IT WAS FURNISHED WITHOUT WRITTEN CONSENT.

Template Revision – For Office Records Only

REV	AUTH	DATE	CAD TEMPLATE REF.
B	MB	7.4.10	A3-FRAME

Scale on A3 sheet	N/A
Dimensions	N/A

DO NOT STAMP 'MASTER' UNTIL ALL WORK IS FULLY CADDED

Rev	Design	Drawn	Chkd	Appd	Description	Date
A	IM	JRM	IM	MHS	PIN & NUMBERS CORRECTED	06.10.11
B	DP	MW	AD	CT	AS BUILT PER C10265012V	29.10.14
C				CT	PLANT 3 ESD CABINET MODS C10265039V	29.01.21

Designed	IM
Drawn	JRM
Checked	IM
Approved	MHS
Date	11.08.11
Cad Reference	10265-P3-123

HIMA–SELLA LIMITED © HIMA-SELLA

Title : LOOP DRAWING - OUTPUTS
ICI SYNETIX SCHEDULE - No.3 AND No.7 PLANTS
FISHER-ROSEMOUNTP.O. No. 99003994

Contract/ Drawing No				
	C10265H-P3	123	REV	C

50 100 150 200 250 300 350 400

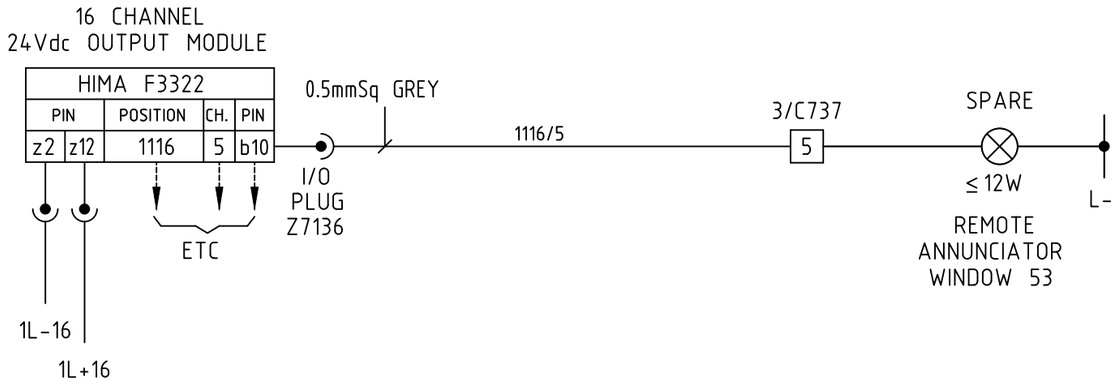

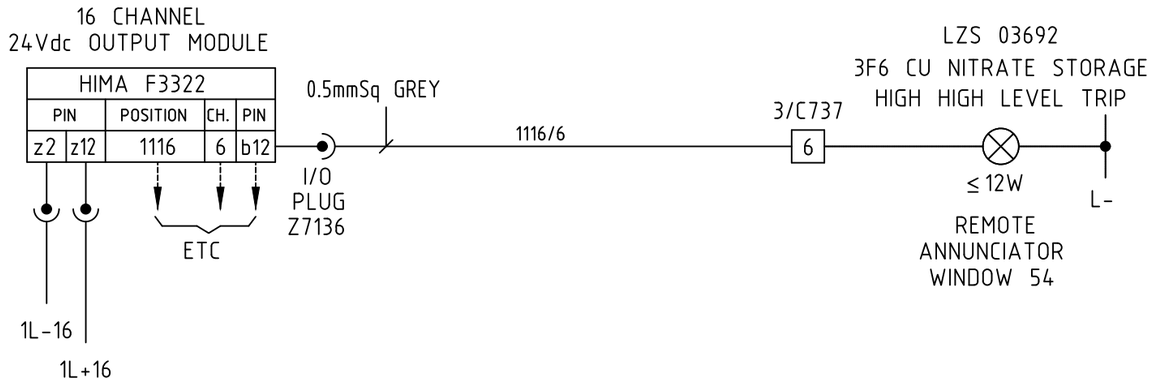

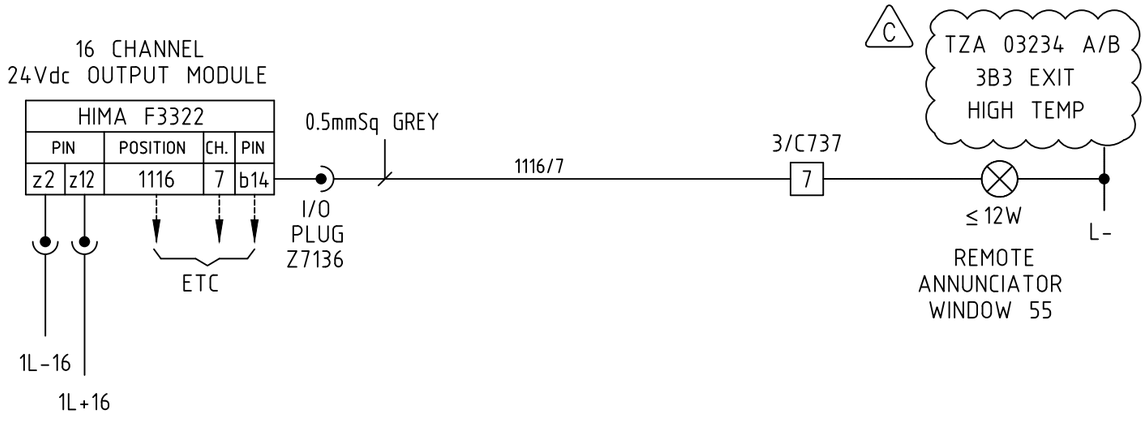

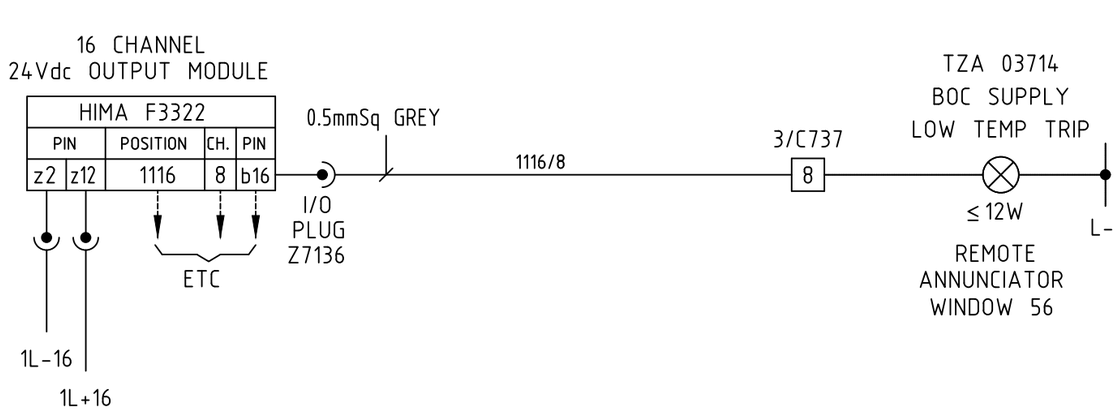

THIS DRAWING IS THE PROPERTY OF HIMA-SELLA LIMITED AND IS LOANED IN CONFIDENCE FOR USE WITH OUR WORK. IT IS NOT TO BE REPRODUCED IN ANY MANNER, SUBMITTED TO OUTSIDE PARTIES FOR EXAMINATION OR USED DIRECTLY OR INDIRECTLY FOR PURPOSES OTHER THAN THOSE FOR WHICH IT WAS FURNISHED WITHOUT WRITTEN CONSENT.

Template Revision – For Office Records Only

REV	AUTH	DATE	CAD TEMPLATE REF.
B	MB	7.4.10	A3-FRAME

Scale on A3 sheet	N/A
Dimensions	N/A

DO NOT STAMP 'MASTER' UNTIL ALL WORK IS FULLY CADDED

Rev	Design	Drawn	Chkd	Appd	Description	Date
A	IM	JRM	IM	MHS	PIN & NUMBERS CORRECTED	06.10.11
B	DP	MW	AD	CT	AS BUILT PER C10265-012V	29.10.14
C				CT	PLANT 3 ESD CABINET MODS C10265039V	29.01.21

Designed	IM
Drawn	AB
Checked	IM
Approved	MHS
Date	11.08.11
Cad Reference	10265-P3-124

HIMA–SELLA LIMITED © HIMA-SELLA

Title : LOOP DRAWING - OUTPUTS
ICI SYNETIX SCHEDULE - No.3 AND No.7 PLANTS
FISHER-ROSEMOUNTP.O. No. 99003994

Contract/ Drawing No	C10265H-P3	124	REV	C

50 100 150 200 250 300 350 400

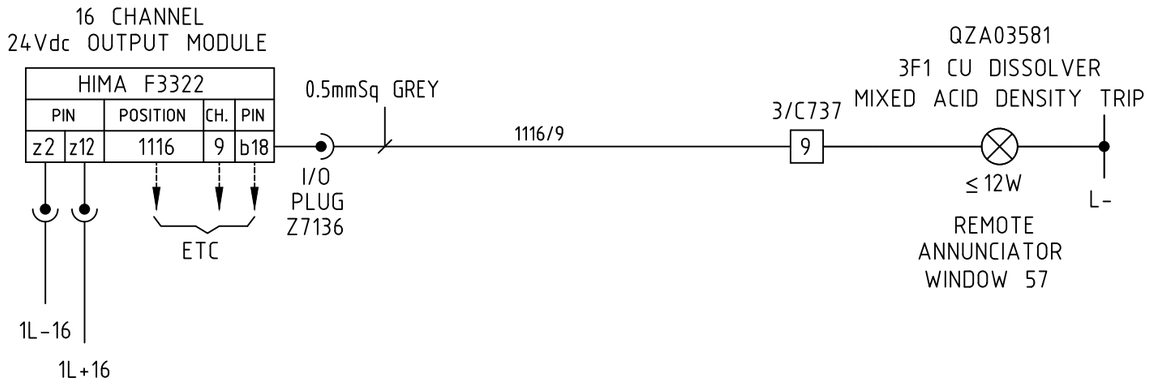

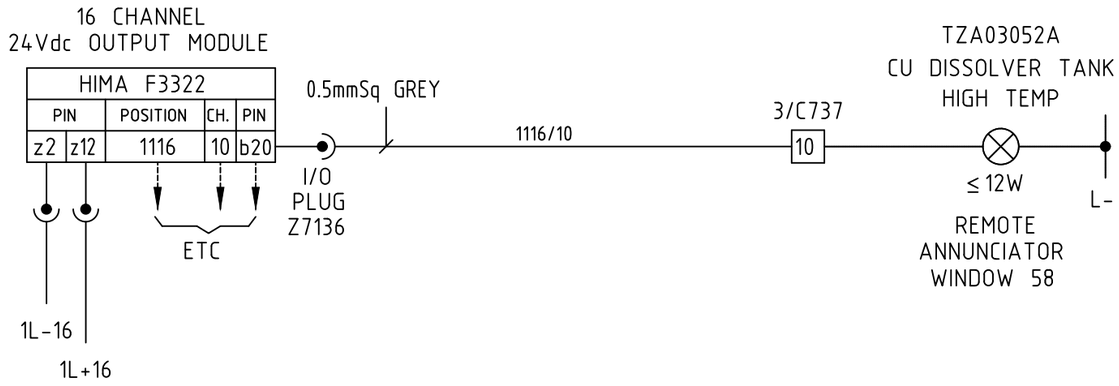

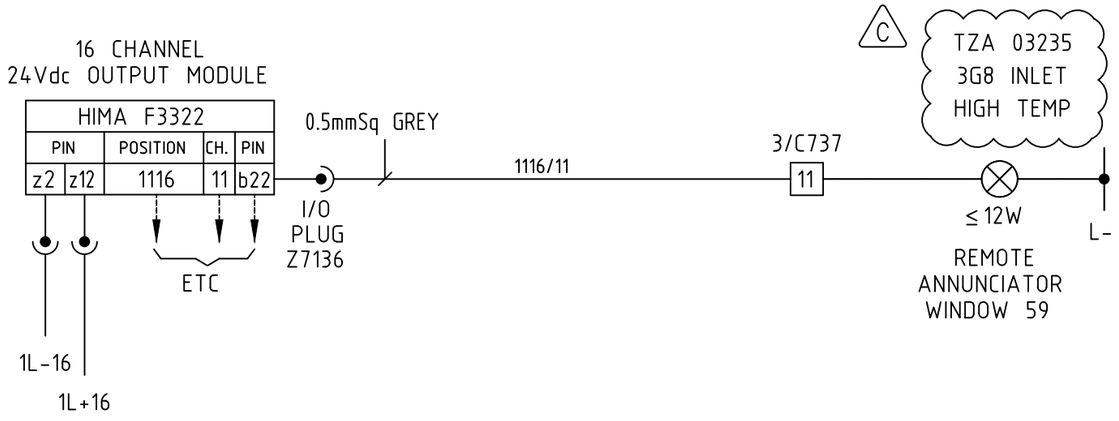

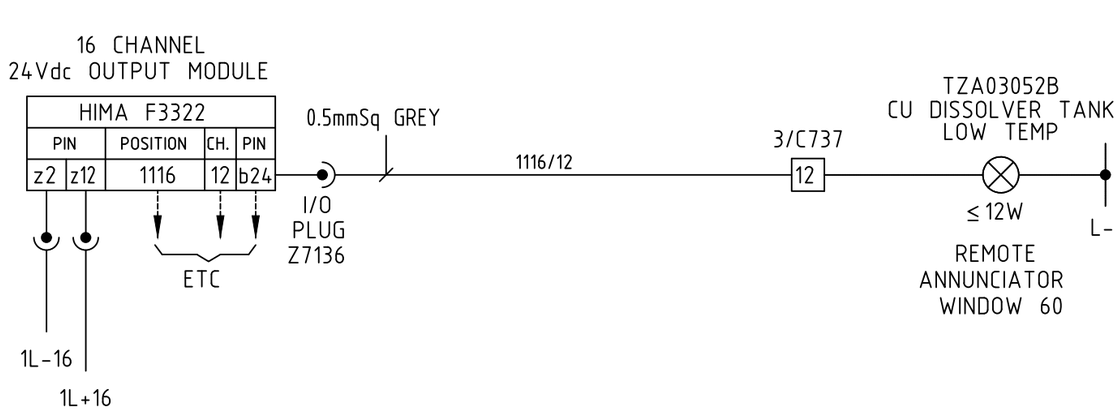

THIS DRAWING IS THE PROPERTY OF HIMA-SELLA LIMITED AND IS LOANED IN CONFIDENCE FOR USE WITH OUR WORK. IT IS NOT TO BE REPRODUCED IN ANY MANNER, SUBMITTED TO OUTSIDE PARTIES FOR EXAMINATION OR USED DIRECTLY OR INDIRECTLY FOR PURPOSES OTHER THAN THOSE FOR WHICH IT WAS FURNISHED WITHOUT WRITTEN CONSENT.

Template Revision – For Office Records Only

REV	AUTH	DATE	CAD TEMPLATE REF.
B	MB	7.4.10	A3-FRAME

Scale on A3 sheet	N/A
Dimensions	N/A

DO NOT STAMP 'MASTER' UNTIL ALL WORK IS FULLY CADDED

Rev	Design	Drawn	Chkd	Appd	Description	Date
A	IM	JRM	IM	MHS	PIN NUMBERS CORRECTED	06.10.11
B	IM	WJB	PP	CT	AS BUILT PER C10265-012V	29.10.14
C				CT	PLANT 3 ESD CABINET MODS C10265039V	29.01.21

Designed	IM
Drawn	JRM
Checked	IM
Approved	MHS
Date	11.08.11
Cad Reference	10265-P3-125

HIMA–SELLA LIMITED © HIMA-SELLA

Title : LOOP DRAWING - OUTPUTS
ICI SYNETIX SCHEDULE - No.3 AND No.7 PLANTS
FISHER-ROSEMOUNTP.O. No. 99003994

Contract/ Drawing No	C10265H-P3	125	REV	C

50 100 150 200 250 300 350 400

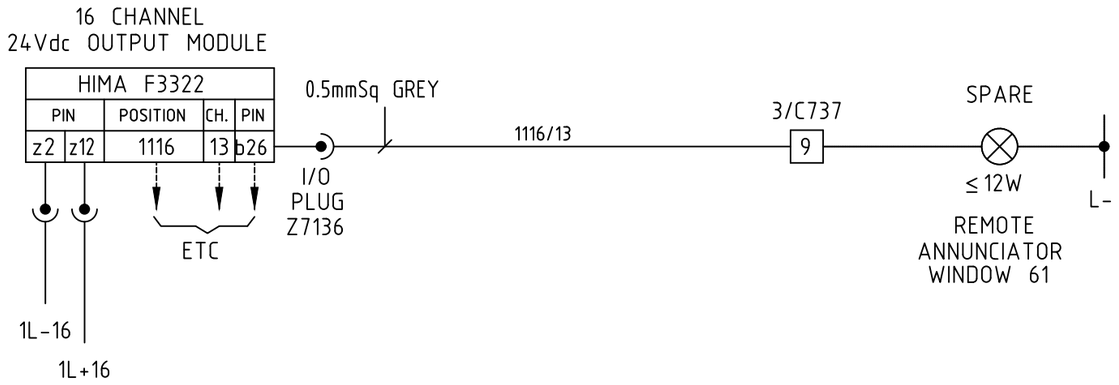

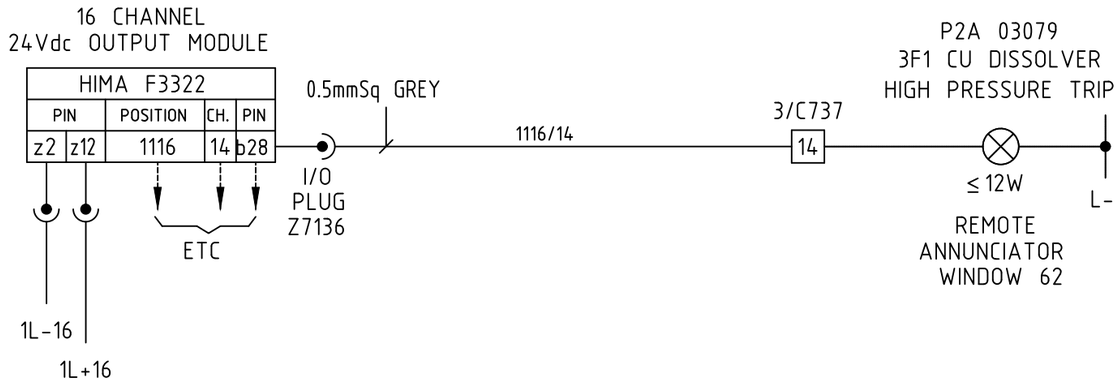

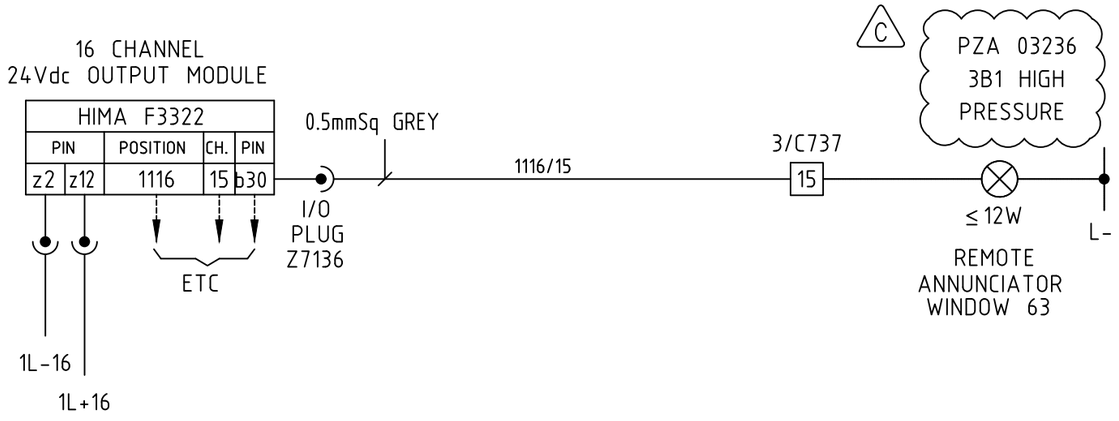

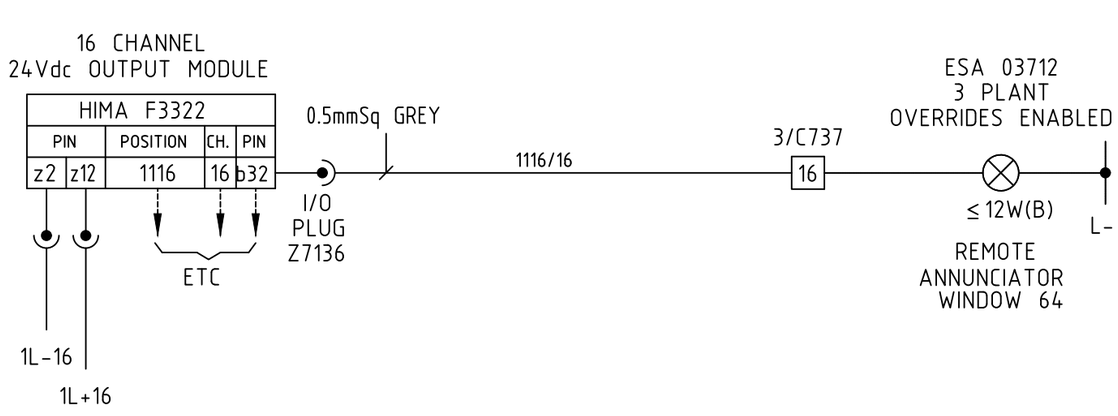

THIS DRAWING IS THE PROPERTY OF HIMA-SELLA LIMITED AND IS LOANED IN CONFIDENCE FOR USE WITH OUR WORK. IT IS NOT TO BE REPRODUCED IN ANY MANNER, SUBMITTED TO OUTSIDE PARTIES FOR EXAMINATION OR USED DIRECTLY OR INDIRECTLY FOR PURPOSES OTHER THAN THOSE FOR WHICH IT WAS FURNISHED WITHOUT WRITTEN CONSENT.

Template Revision – For Office Records Only

REV	AUTH	DATE	CAD TEMPLATE REF.
B	MB	7.4.10	A3-FRAME

Scale on A3 sheet	N/A
Dimensions	N/A

DO NOT STAMP 'MASTER' UNTIL ALL WORK IS FULLY CADDED

Rev	Design	Drawn	Chkd	Appd	Description	Date
A	IM	JRM	IM	MHS	NUMBERS CORRECTED	06.10.11
B	DP	MW	AD	CT	AS BUILT PER C120625-012V	29.10.14
C				CT	PLANT 3 ESD CABINET MODS C10265039V	29.01.21

Designed	IM
Drawn	JRM
Checked	IM
Approved	MHS
Date	11.08.11
Cad Reference	10265-P3-125

HIMA–SELLA LIMITED © HIMA-SELLA

Title : LOOP DRAWING - OUTPUTS
ICI SYNETIX SCHEDULE - No.3 AND No.7 PLANTS
FISHER-ROSEMOUNTP.O. No. 99003994

Contract/ Drawing No	C10265H-P3	126	REV	C

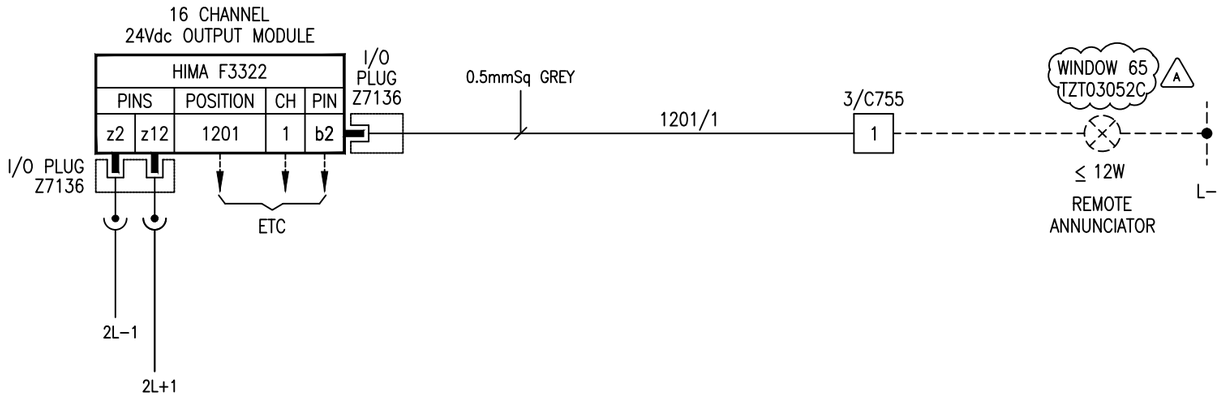

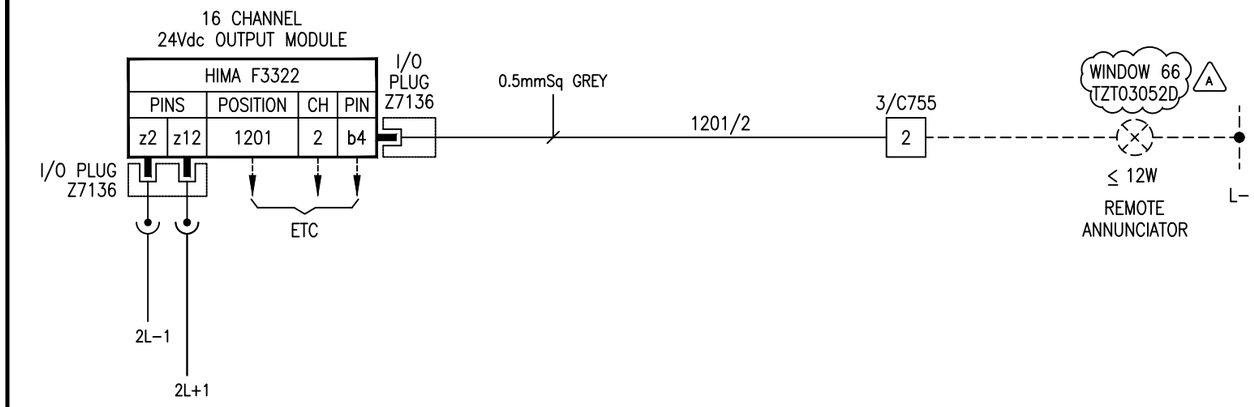

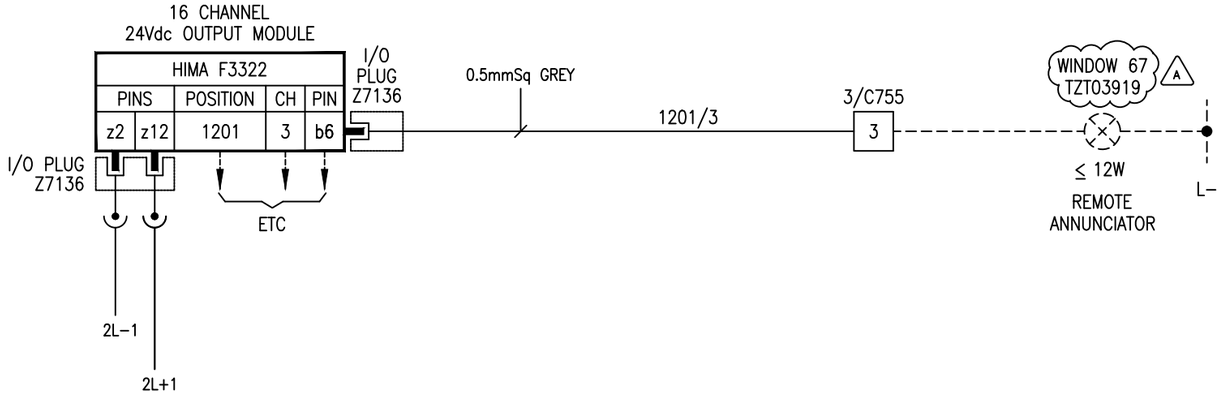

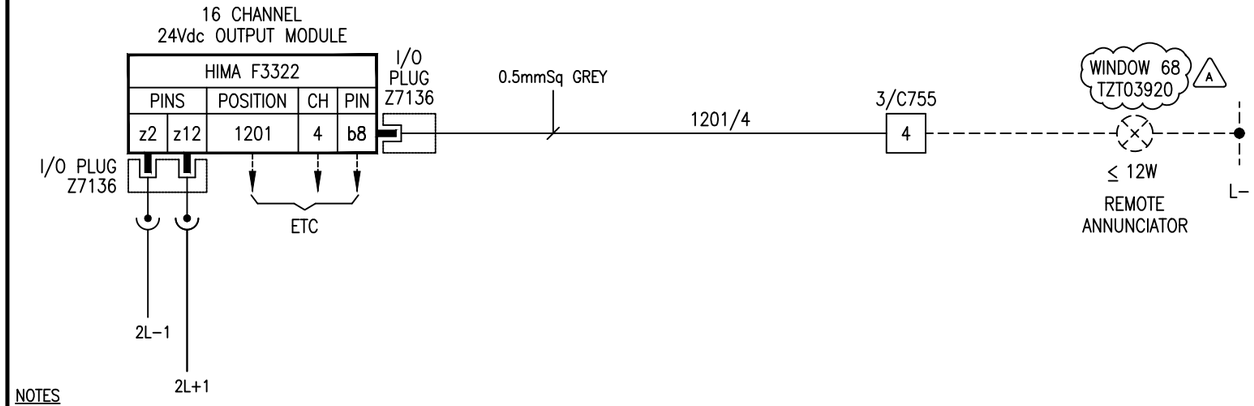

NOTES

1. FIRST TERMINAL OR PAIR SHOULD ALWAYS BE '+' (ASK1 (50mA) ON ANLOGUE INPUT ONLY).
2. ANALOGUE LOOPS WILL BE WIRED USING SCREENED CABLES WHERE POSSIBLE.
3. ALL WIRING TO BE TRI–RATED.
4. COMPENSATING CABLES FOR TYPE 'K' THERMOCOUPLES WITH COLD JUNCTION. COMPENSATION PROVIDED BY THE SIGNAL CONVERTER WILL BE USED ON ALL TYPES AI4 LOOPS.
5. L– FOR ALL REMOTE ANNUNCIATORS IS DELIVERED FROM THE ESD 24VDC SUPPLY.
6. WIRE No.s ARE DEFINED USING CARD POSITION / CHANNEL NUMBER.

THIS DRAWING IS THE PROPERTY OF HIMA-SELLA LIMITED AND IS LOANED IN CONFIDENCE FOR USE WITH OUR WORK. IT IS NOT TO BE REPRODUCED IN ANY MANNER, SUBMITTED TO OUTSIDE PARTIES FOR EXAMINATION OR USED DIRECTLY OR INDIRECTLY FOR PURPOSES OTHER THAN THOSE FOR WHICH IT WAS FURNISHED WITHOUT WRITTEN CONSENT.

Template Revision – For Office Records Only

REV	AUTH	DATE	CAD TEMPLATE REF.
B	MB	7.4.10	A3-FRAME

Scale on A3 sheet	N/A
Dimensions	N/A

DO NOT STAMP 'MASTER' UNTIL ALL WORK IS FULLY CADDED

Rev	Design	Drawn	Chkd	Appd	Description	Date
A				CT	AS BUILT PER C10265-012V	29.10.14

Designed	DP
Drawn	WB
Checked	RB
Approved	CT
Date	24.02.14
Cad Reference	10265-P3-127

HIMA–SELLA LIMITED © HIMA-SELLA

Title : LOOP DRAWING - OUTPUTS
ICI SYNETIX SCHEDULE - No.3 AND No.7 PLANTS
FISHER-ROSEMOUNTP.O. No. 99003994

Contract/ Drawing No	C10265H-P3	127	REV	A

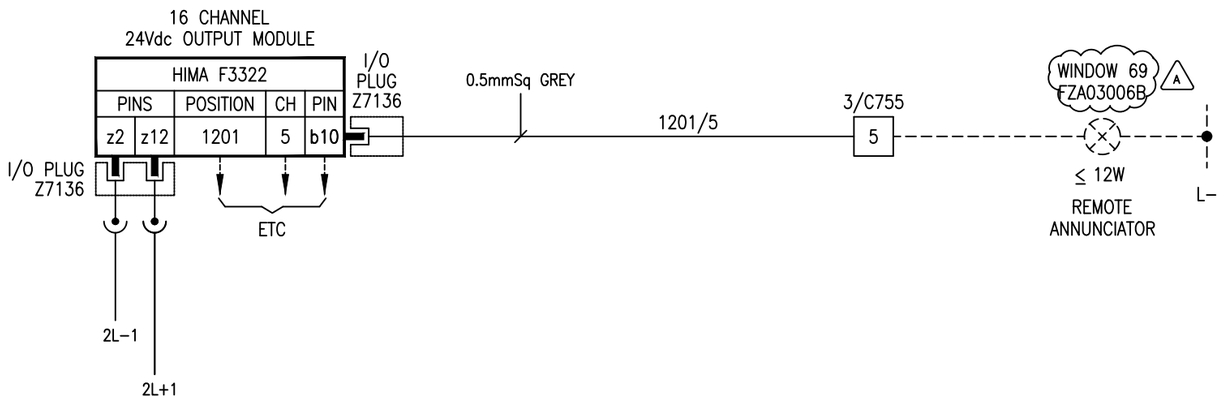

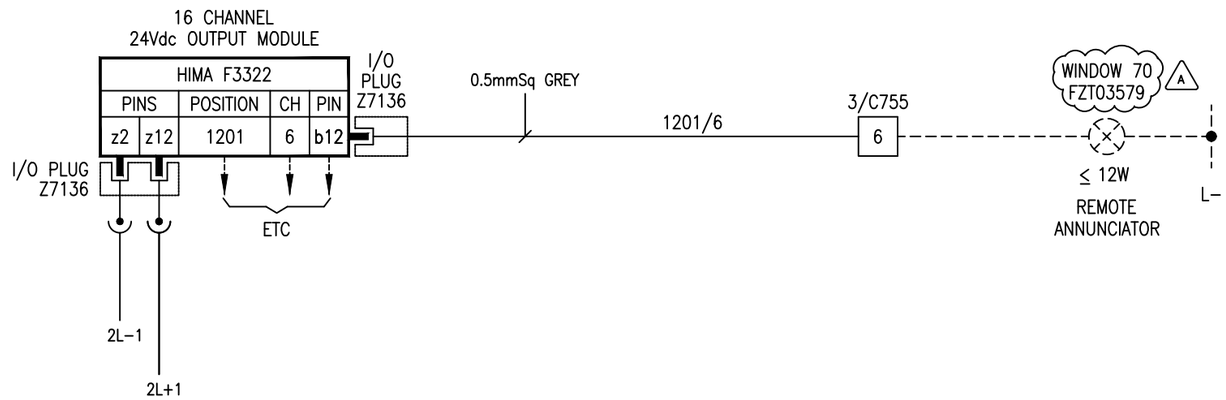

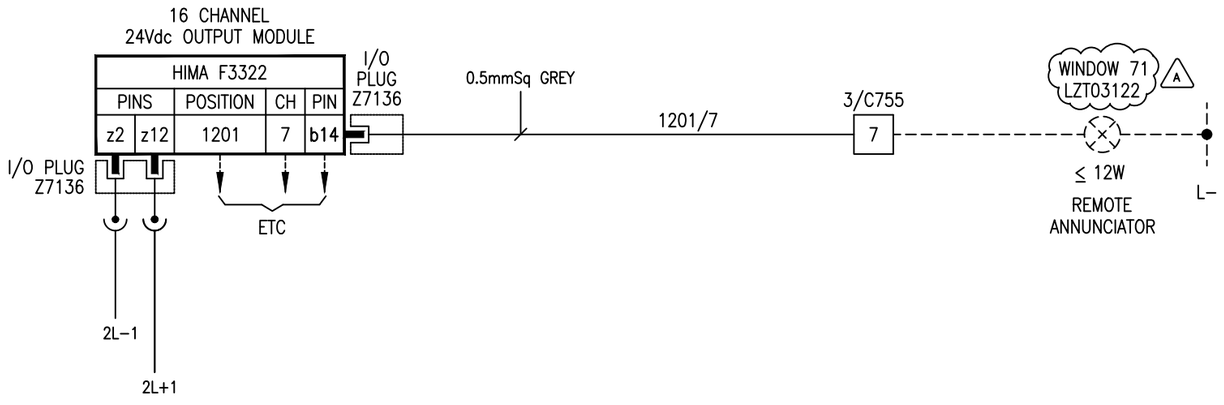

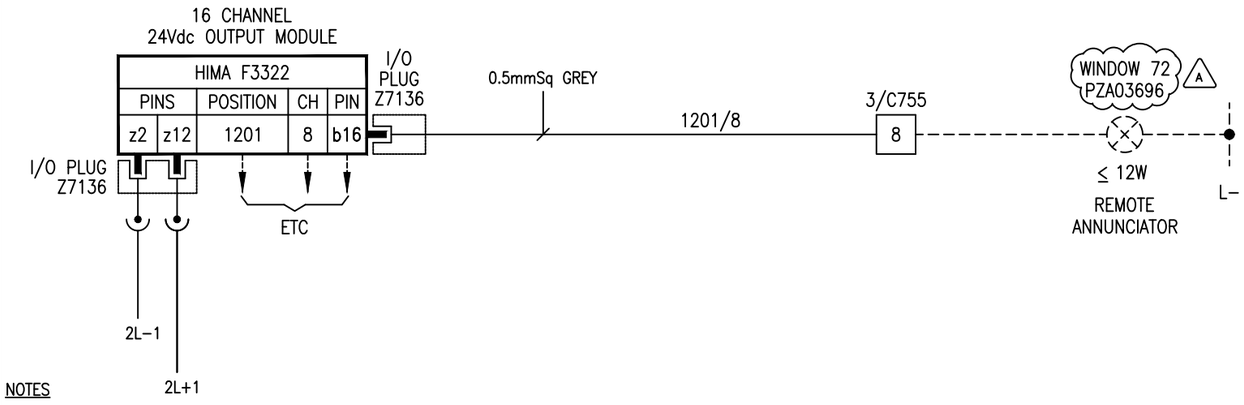

NOTES

1. FIRST TERMINAL OR PAIR SHOULD ALWAYS BE '+' (ASK1 (50mA) ON ANLOGUE INPUT ONLY).
2. ANALOGUE LOOPS WILL BE WIRED USING SCREENED CABLES WHERE POSSIBLE.
3. ALL WIRING TO BE TRI–RATED.
4. COMPENSATING CABLES FOR TYPE 'K' THERMOCOUPLES WITH COLD JUNCTION. COMPENSATION PROVIDED BY THE SIGNAL CONVERTER WILL BE USED ON ALL TYPES AI4 LOOPS.
5. L– FOR ALL REMOTE ANNUNCIATORS IS DELIVERED FROM THE ESD 24VDC SUPPLY.
6. WIRE No.s ARE DEFINED USING CARD POSITION / CHANNEL NUMBER.

THIS DRAWING IS THE PROPERTY OF HIMA-SELLA LIMITED AND IS LOANED IN CONFIDENCE FOR USE WITH OUR WORK. IT IS NOT TO BE REPRODUCED IN ANY MANNER, SUBMITTED TO OUTSIDE PARTIES FOR EXAMINATION OR USED DIRECTLY OR INDIRECTLY FOR PURPOSES OTHER THAN THOSE FOR WHICH IT WAS FURNISHED WITHOUT WRITTEN CONSENT.

Template Revision – For Office Records Only

REV	AUTH	DATE	CAD TEMPLATE REF.
B	MB	7.4.10	A3-FRAME

Scale on A3 sheet	N/A
Dimensions	N/A

DO NOT STAMP 'MASTER' UNTIL ALL WORK IS FULLY CADDED

Rev	Design	Drawn	Chkd	Appd	Description	Date
A				CT	AS BUILT PER C10265-012V	29.10.14

Designed	DP
Drawn	WB
Checked	RB
Approved	CT
Date	24.02.14
Cad Reference	10265-P3-128

HIMA–SELLA LIMITED © HIMA-SELLA

Title : LOOP DRAWING - OUTPUTS
ICI SYNETIX SCHEDULE - No.3 AND No.7 PLANTS
FISHER-ROSEMOUNTP.O. No. 99003994

Contract/ Drawing No	C10265H-P3	128	REV	A

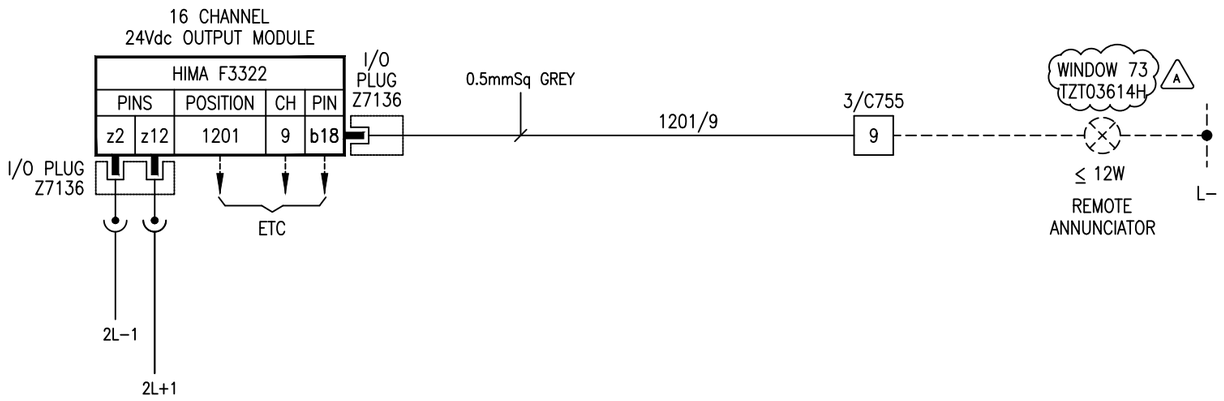

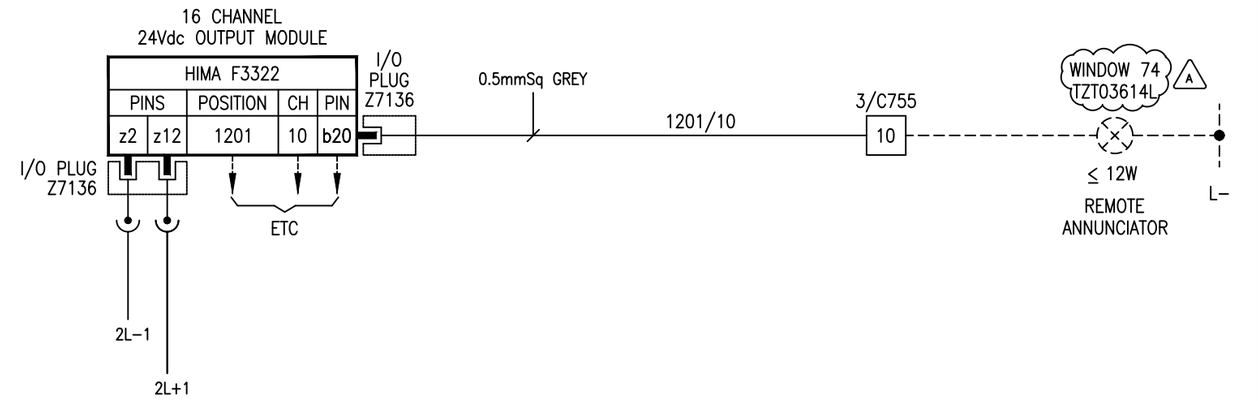

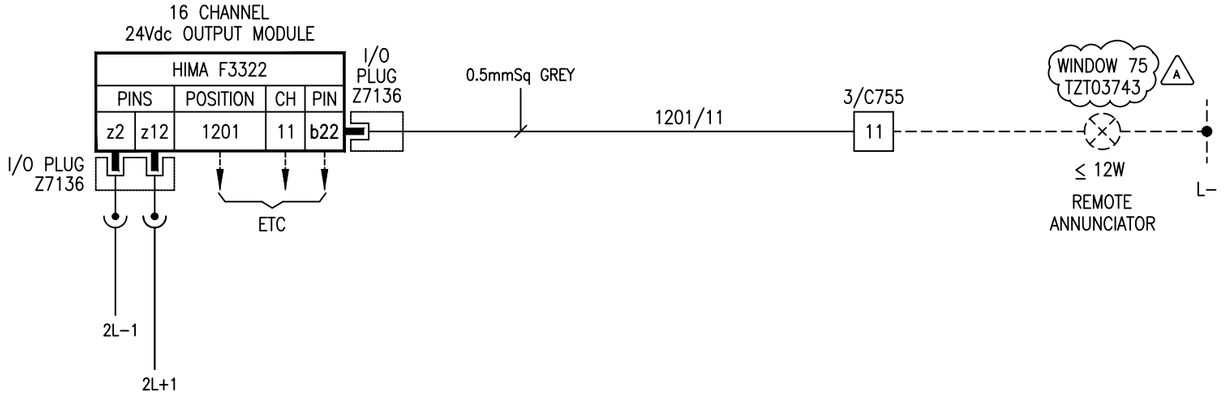

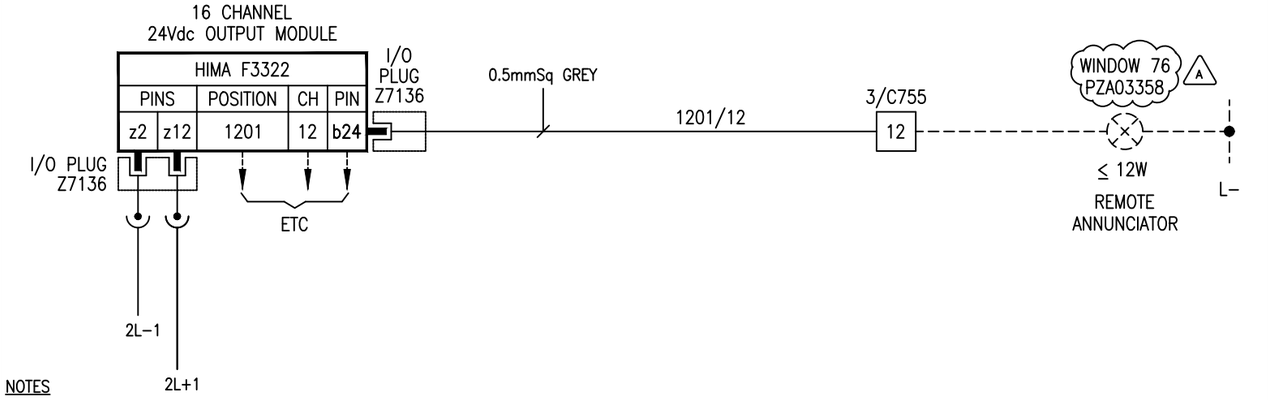

NOTES

1. FIRST TERMINAL OR PAIR SHOULD ALWAYS BE '+' (ASK1 (50mA) ON ANLOGUE INPUT ONLY).
2. ANALOGUE LOOPS WILL BE WIRED USING SCREENED CABLES WHERE POSSIBLE.
3. ALL WIRING TO BE TRI–RATED.
4. COMPENSATING CABLES FOR TYPE 'K' THERMOCOUPLES WITH COLD JUNCTION. COMPENSATION PROVIDED BY THE SIGNAL CONVERTER WILL BE USED ON ALL TYPES AI4 LOOPS.
5. L– FOR ALL REMOTE ANNUNCIATORS IS DELIVERED FROM THE ESD 24VDC SUPPLY.
6. WIRE No.s ARE DEFINED USING CARD POSITION / CHANNEL NUMBER.

THIS DRAWING IS THE PROPERTY OF HIMA-SELLA LIMITED AND IS LOANED IN CONFIDENCE FOR USE WITH OUR WORK. IT IS NOT TO BE REPRODUCED IN ANY MANNER, SUBMITTED TO OUTSIDE PARTIES FOR EXAMINATION OR USED DIRECTLY OR INDIRECTLY FOR PURPOSES OTHER THAN THOSE FOR WHICH IT WAS FURNISHED WITHOUT WRITTEN CONSENT.

Template Revision – For Office Records Only

REV	AUTH	DATE	CAD TEMPLATE REF.
B	MB	7.4.10	A3-FRAME

Scale on A3 sheet	N/A
Dimensions	N/A

DO NOT STAMP 'MASTER' UNTIL ALL WORK IS FULLY CADDED

Rev	Design	Drawn	Chkd	Appd	Description	Date
A				CT	AS BUILT PER C10265-012V	29.10.14

Designed	DP
Drawn	WB
Checked	RB
Approved	CT
Date	24.02.14
Cad Reference	10265-P3-129

HIMA–SELLA LIMITED © HIMA-SELLA

Title : LOOP DRAWING - OUTPUTS
ICI SYNETIX SCHEDULE - No.3 AND No.7 PLANTS
FISHER-ROSEMOUNTP.O. No. 99003994

Contract/ Drawing No	C10265H-P3	129	REV	A

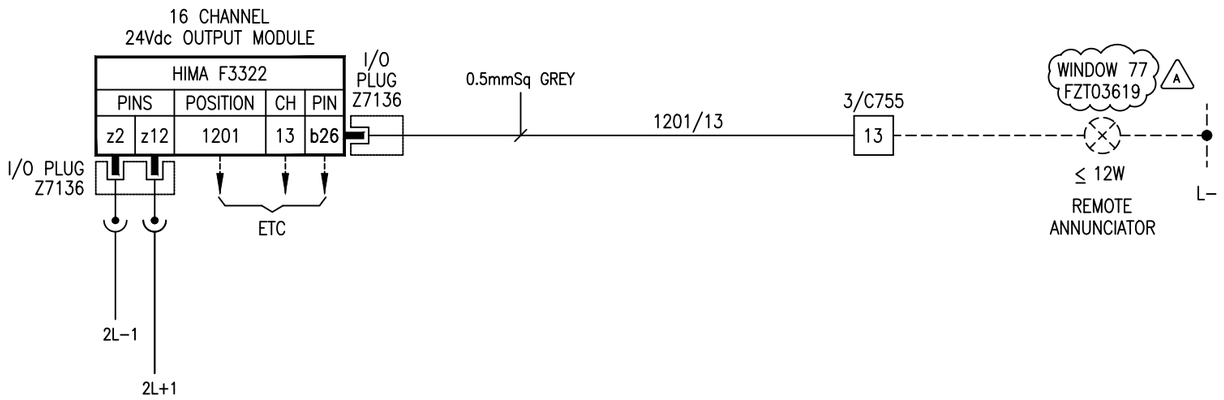

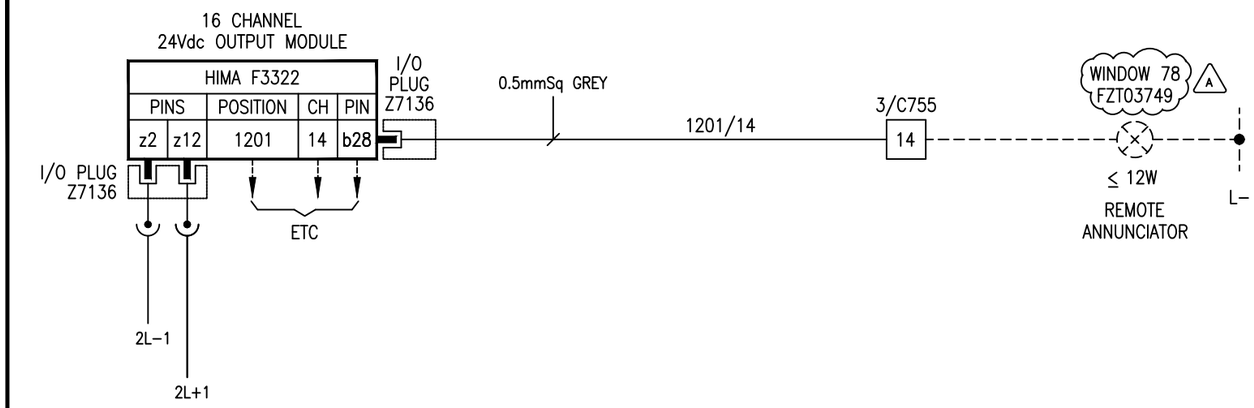

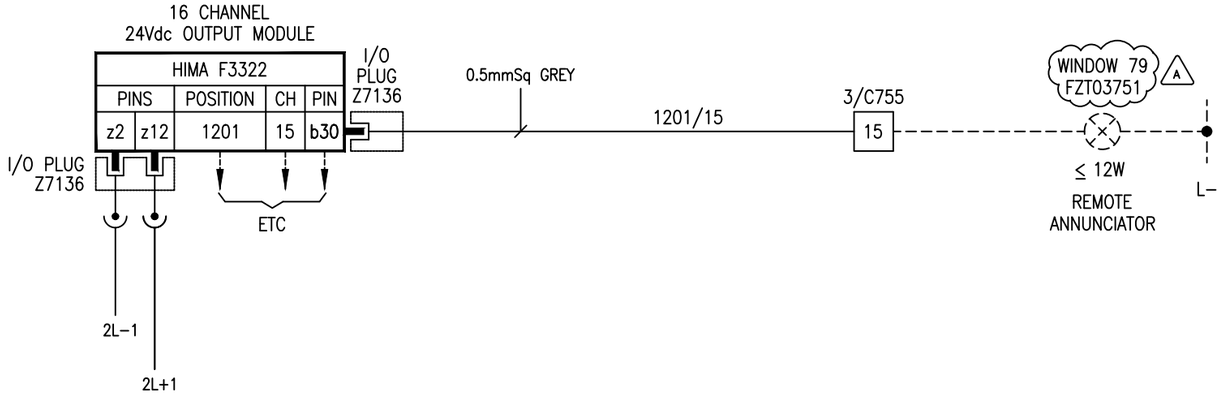

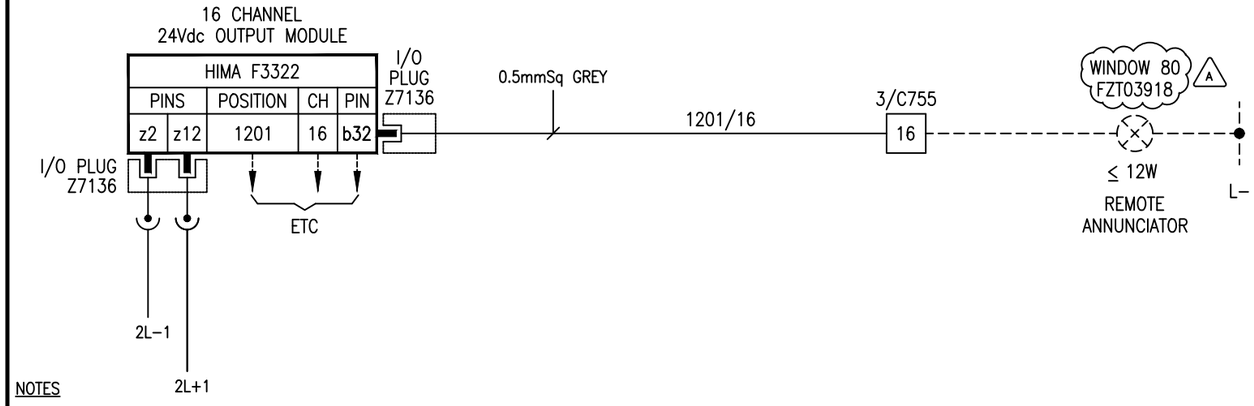

NOTES

1. FIRST TERMINAL OR PAIR SHOULD ALWAYS BE '+' (ASK1 (50mA) ON ANLOGUE INPUT ONLY).
2. ANALOGUE LOOPS WILL BE WIRED USING SCREENED CABLES WHERE POSSIBLE.
3. ALL WIRING TO BE TRI–RATED.
4. COMPENSATING CABLES FOR TYPE 'K' THERMOCOUPLES WITH COLD JUNCTION. COMPENSATION PROVIDED BY THE SIGNAL CONVERTER WILL BE USED ON ALL TYPES AI4 LOOPS.
5. L– FOR ALL REMOTE ANNUNCIATORS IS DELIVERED FROM THE ESD 24VDC SUPPLY.
6. WIRE No.s ARE DEFINED USING CARD POSITION / CHANNEL NUMBER.

THIS DRAWING IS THE PROPERTY OF HIMA-SELLA LIMITED AND IS LOANED IN CONFIDENCE FOR USE WITH OUR WORK. IT IS NOT TO BE REPRODUCED IN ANY MANNER, SUBMITTED TO OUTSIDE PARTIES FOR EXAMINATION OR USED DIRECTLY OR INDIRECTLY FOR PURPOSES OTHER THAN THOSE FOR WHICH IT WAS FURNISHED WITHOUT WRITTEN CONSENT.

Template Revision – For Office Records Only

REV	AUTH	DATE	CAD TEMPLATE REF.
B	MB	7.4.10	A3-FRAME

Scale on A3 sheet	N/A
Dimensions	N/A

DO NOT STAMP 'MASTER' UNTIL ALL WORK IS FULLY CADDED

Rev	Design	Drawn	Chkd	Appd	Description	Date
A				CT	AS BUILT PER C10265-012V	29.10.14

Designed	DP
Drawn	WB
Checked	RB
Approved	CT
Date	24.02.14
Cad Reference	10265-P3-130

HIMA–SELLA LIMITED © HIMA-SELLA

Title : LOOP DRAWING - OUTPUTS
ICI SYNETIX SCHEDULE - No.3 AND No.7 PLANTS
FISHER-ROSEMOUNTP.O. No. 99003994

Contract/ Drawing No	C10265H-P3	130	REV	A

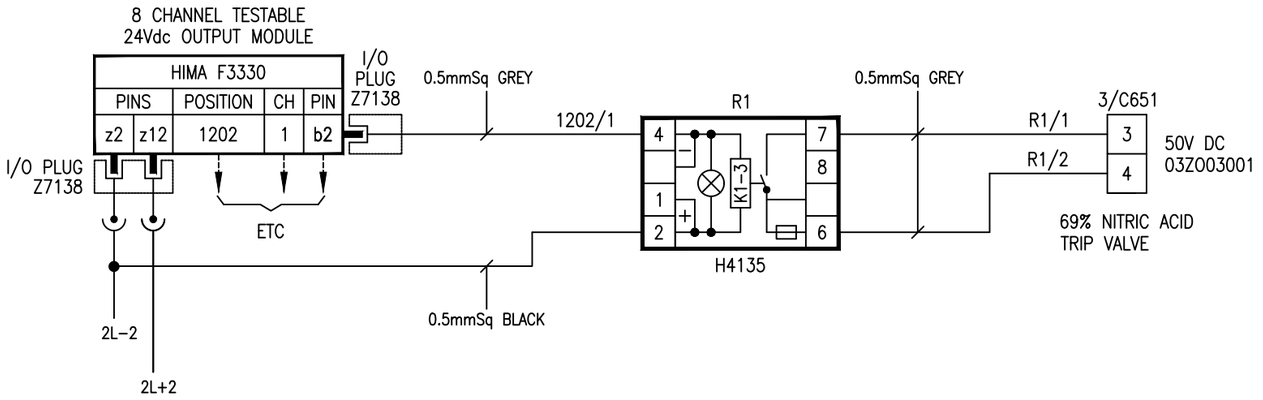

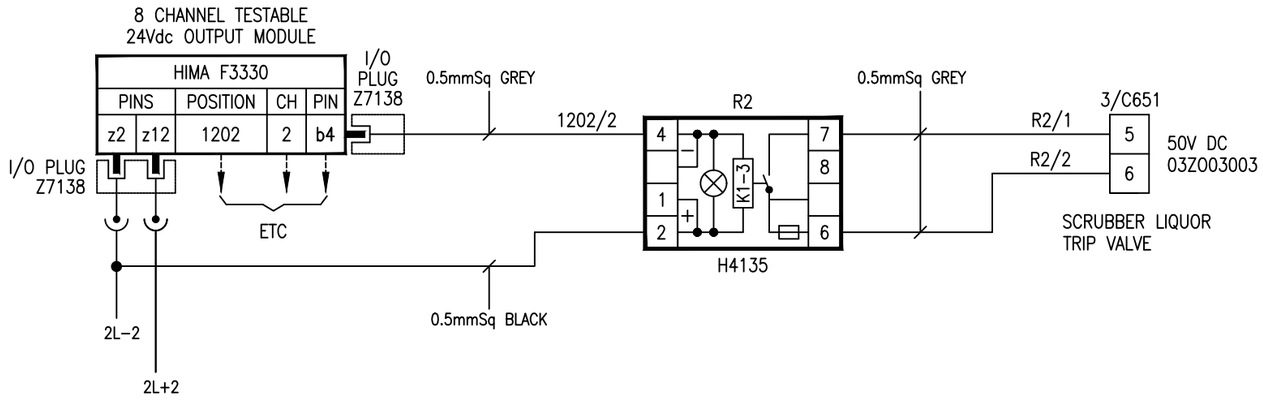

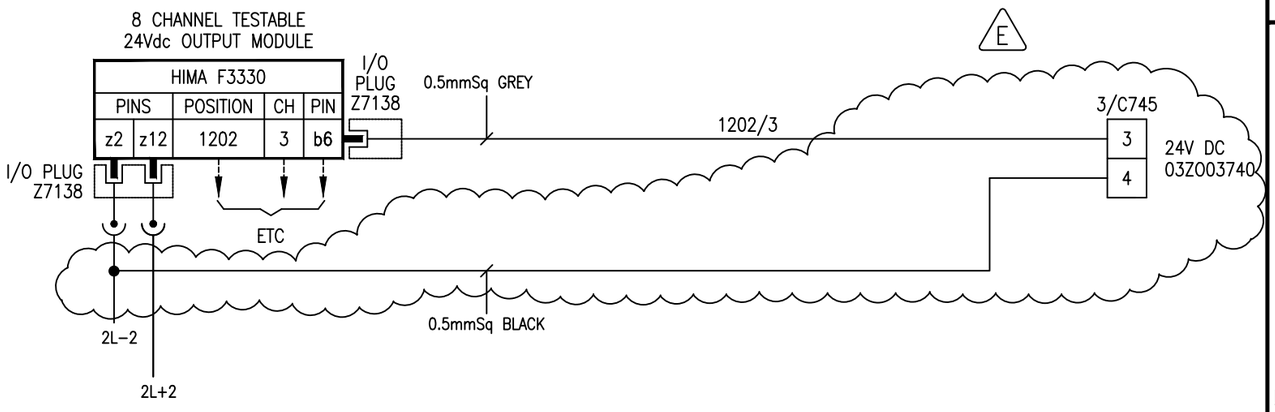

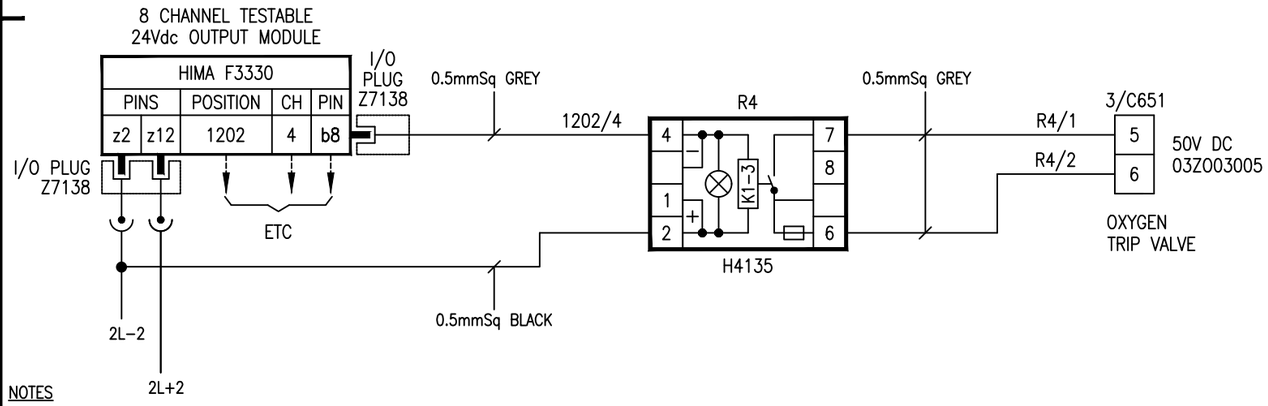

NOTES

1. FIRST TERMINAL OR PAIR SHOULD ALWAYS BE '+' (ASK1 (50mA) ON ANLOGUE INPUT ONLY).
2. ANALOGUE LOOPS WILL BE WIRED USING SCREENED CABLES WHERE POSSIBLE.
3. ALL WIRING TO BE TRI-RATED.
4. COMPENSATING CABLES FOR TYPE 'K' THERMOCOUPLES WITH COLD JUNCTION. COMPENSATION PROVIDED BY THE SIGNAL CONVERTER WILL BE USED ON ALL TYPES AI4 LOOPS.
5. L- FOR ALL REMOTE ANNUNCIATORS IS DELIVERED FROM THE ESD 24VDC SUPPLY.
6. WIRE No.s ARE DEFINED USING CARD POSITION / CHANNEL NUMBER.

THIS DRAWING IS THE PROPERTY OF HIMA-SELLA LIMITED AND IS LOANED IN CONFIDENCE FOR USE WITH OUR WORK. IT IS NOT TO BE REPRODUCED IN ANY MANNER, SUBMITTED TO OUTSIDE PARTIES FOR EXAMINATION OR USED DIRECTLY OR INDIRECTLY FOR PURPOSES OTHER THAN THOSE FOR WHICH IT WAS FURNISHED WITHOUT WRITTEN CONSENT.

Template Revision – For Office Records Only

REV	AUTH	DATE	CAD TEMPLATE REF.
B	MB	7.4.10	A3-FRAME

Scale on A3 sheet	N/A
Dimensions	N/A

DO NOT STAMP 'MASTER' UNTIL ALL WORK IS FULLY CADDED

Rev	Design	Drawn	Chkd	Appd	Description	Date
C	NH	NH	CW	NGB	AS BUILT.	06.06.00
D	NH	NH	CW	NGB	TEXT CORRECTED	06.10.11
E				CT	ZINC DISSOLVER PHR & MMN IMPROVEMENTS	24.02.14

Designed	NH
Drawn	NH
Checked	CW
Approved	NGB
Date	29.03.00
Cad Reference	10265-P3-131

HIMA-SELLA LIMITED © HIMA-SELLA

Title : LOOP DRAWING - OUTPUTS
ICI SYNETIX SCHEDULE - No.3 AND No.7 PLANTS
FISHER-ROSEMOUNTP.O. No. 99003994

Contract/ Drawing No	C10265H-P3	131	REV	E

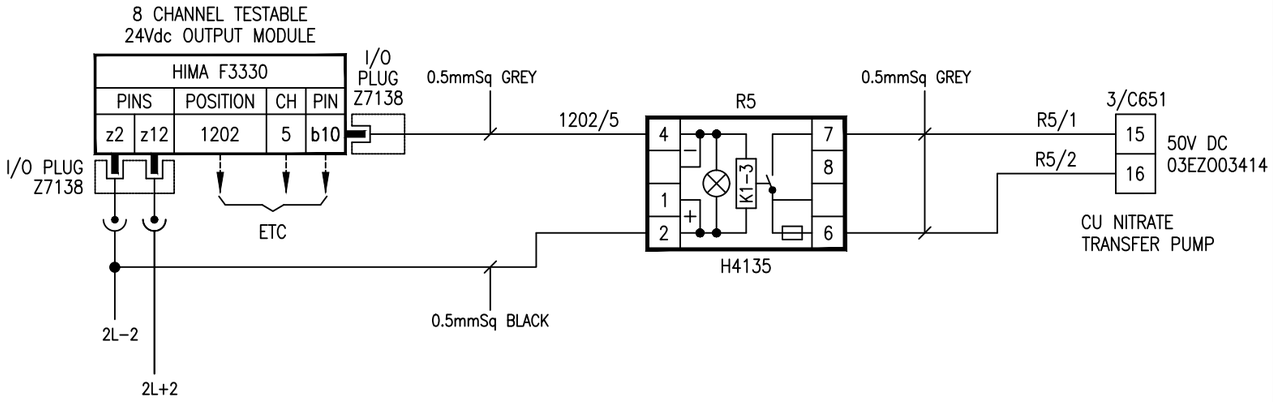

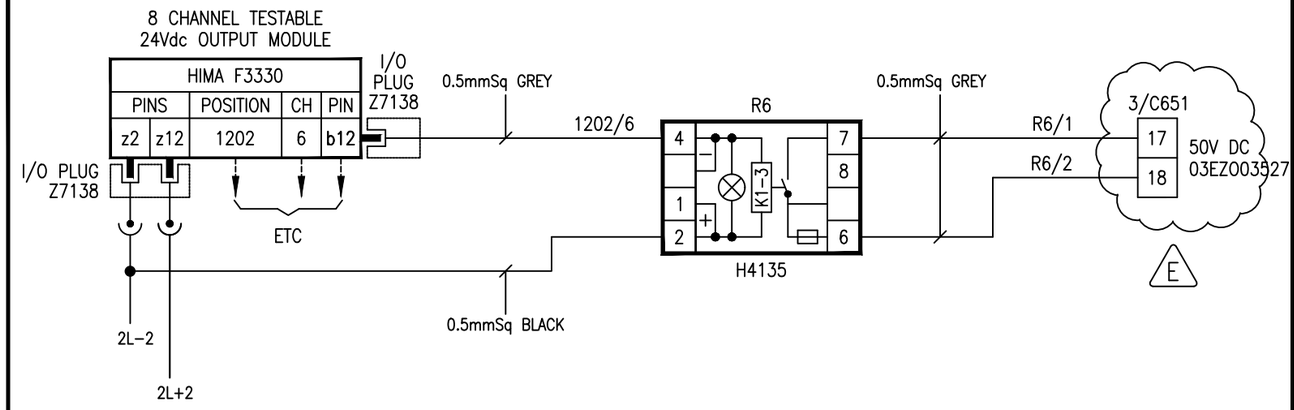

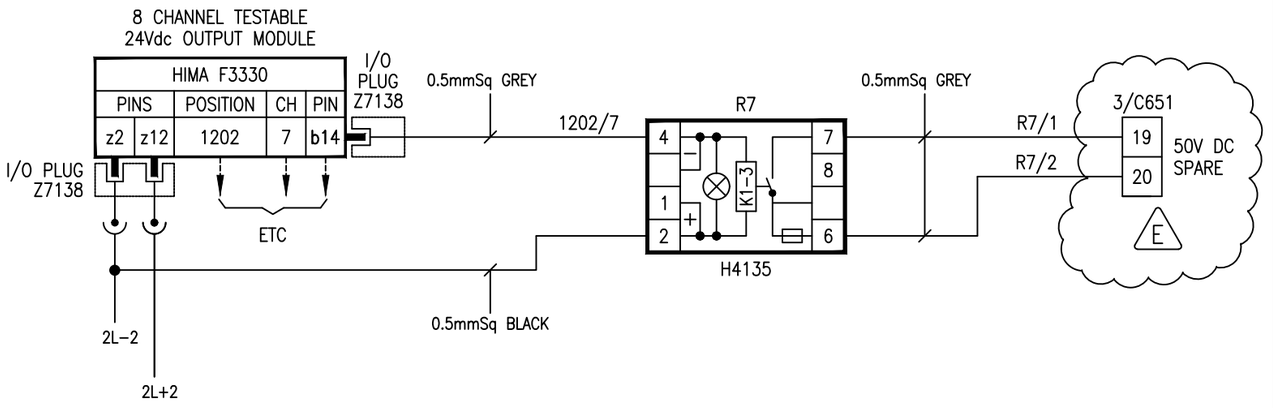

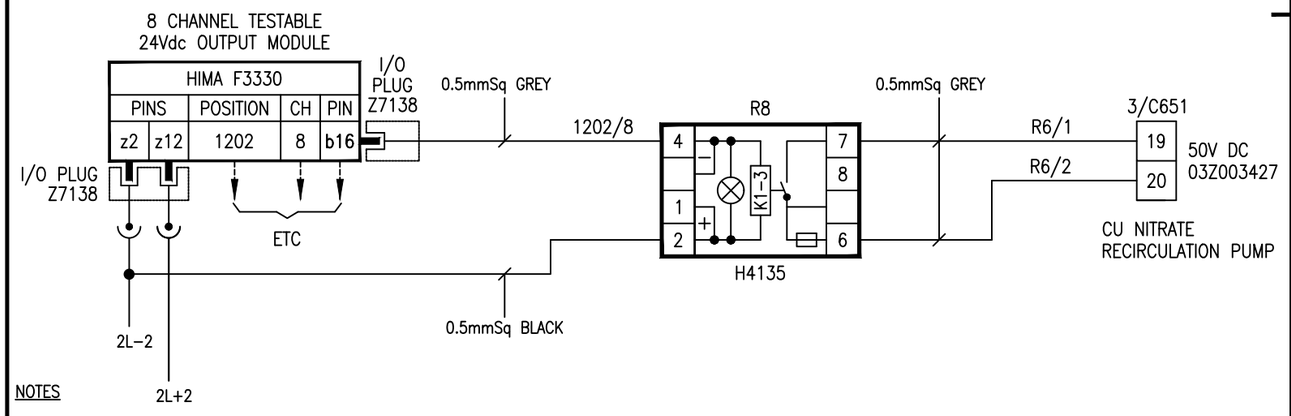

NOTES

1. FIRST TERMINAL OR PAIR SHOULD ALWAYS BE '+' (ASK1 (50mA) ON ANLOGUE INPUT ONLY).
2. ANALOGUE LOOPS WILL BE WIRED USING SCREENED CABLES WHERE POSSIBLE.
3. ALL WIRING TO BE TRI-RATED.
4. COMPENSATING CABLES FOR TYPE 'K' THERMOCOUPLES WITH COLD JUNCTION. COMPENSATION PROVIDED BY THE SIGNAL CONVERTER WILL BE USED ON ALL TYPES AI4 LOOPS.
5. L- FOR ALL REMOTE ANNUNCIATORS IS DELIVERED FROM THE ESD 24VDC SUPPLY.
6. WIRE No.s ARE DEFINED USING CARD POSITION / CHANNEL NUMBER.

THIS DRAWING IS THE PROPERTY OF HIMA-SELLA LIMITED AND IS LOANED IN CONFIDENCE FOR USE WITH OUR WORK. IT IS NOT TO BE REPRODUCED IN ANY MANNER, SUBMITTED TO OUTSIDE PARTIES FOR EXAMINATION OR USED DIRECTLY OR INDIRECTLY FOR PURPOSES OTHER THAN THOSE FOR WHICH IT WAS FURNISHED WITHOUT WRITTEN CONSENT.

Template Revision – For Office Records Only

REV	AUTH	DATE	CAD TEMPLATE REF.
B	MB	7.4.10	A3-FRAME

Scale on A3 sheet	N/A
Dimensions	N/A

DO NOT STAMP 'MASTER' UNTIL ALL WORK IS FULLY CADDED

Rev	Design	Drawn	Chkd	Appd	Description	Date
C	NH	NH	CW	NGB	AS BUILT.	06.06.00
D	NH	NH	CW	NGB	TEXT CORRECTED	06.10.11
E				CT	ZINC DISSOLVER PHR & MMN IMPROVEMENTS	24.02.14

Designed	NH
Drawn	NH
Checked	CW
Approved	NGB
Date	31.03.00
Cad Reference	10265-P3-132

HIMA-SELLA LIMITED © HIMA-SELLA

Title : LOOP DRAWING - OUTPUTS
ICI SYNETIX SCHEDULE - No.3 AND No.7 PLANTS
FISHER-ROSEMOUNTP.O. No. 99003994

Contract/ Drawing No	C10265H-P3	132	REV	E

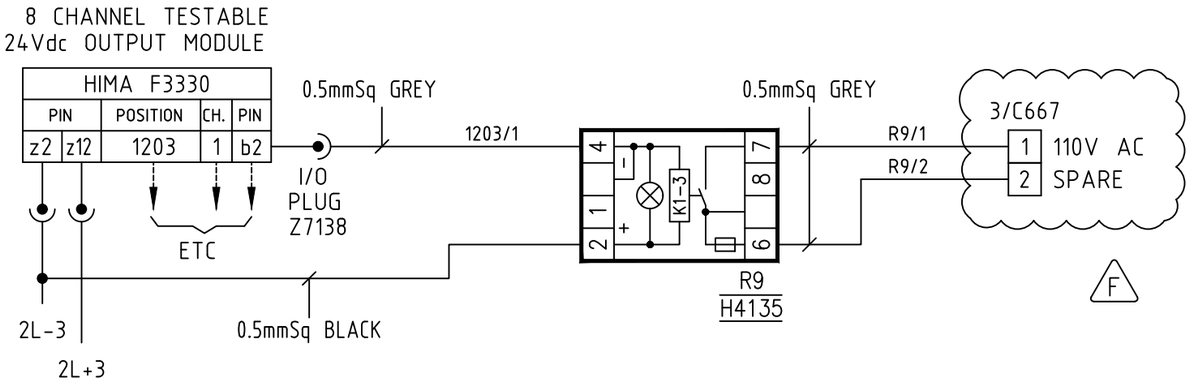

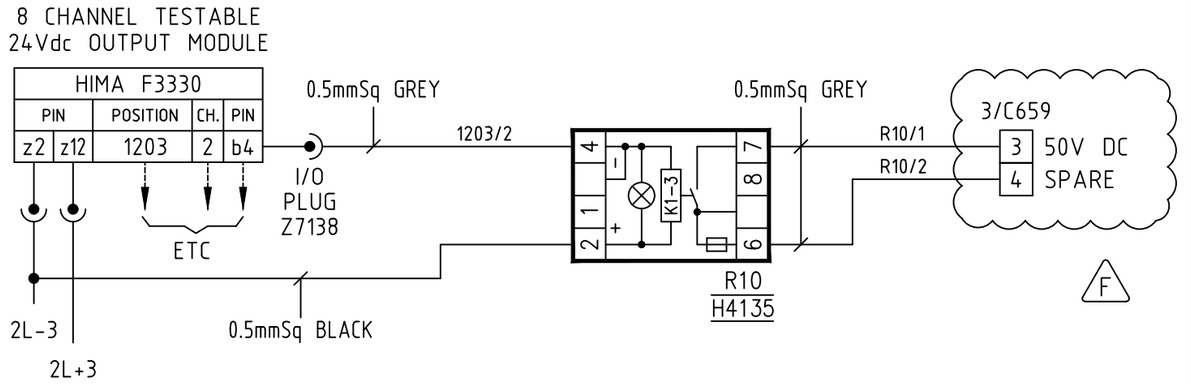

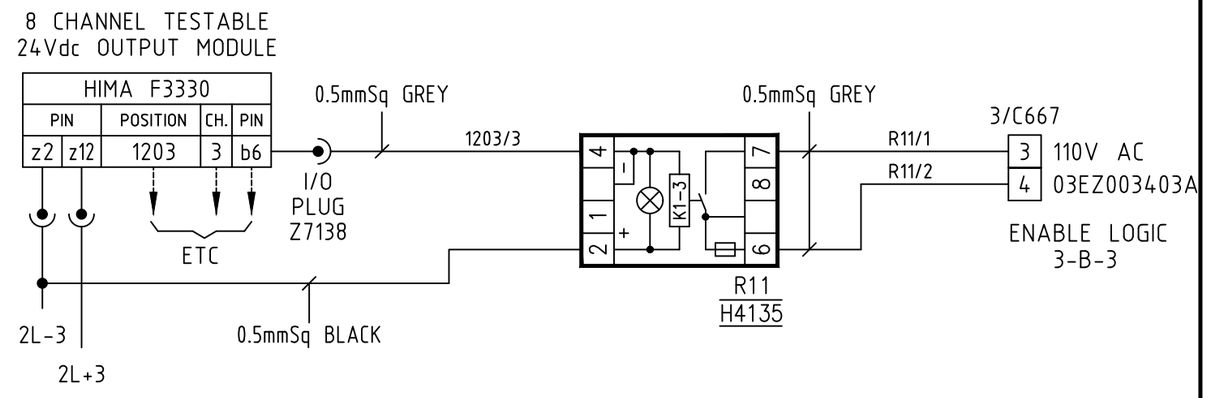

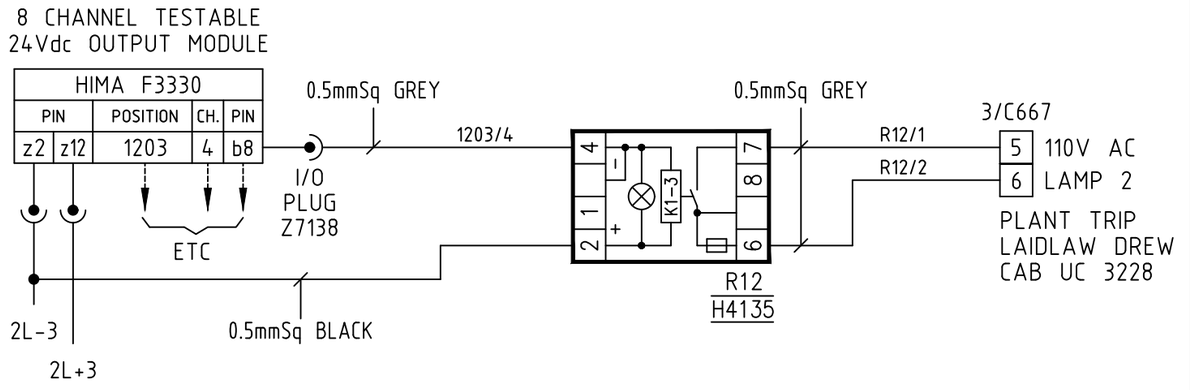

NOTES
1. FIRST TERMINAL OF PAIR SHOULD ALWAYS BE '+' (ASK1 (50mA) ON ANALOGUE INPUTS ONLY).
2. ANALOGUE LOOPS WILL BE WIRED USING SCREENED CABLES WHERE POSSIBLE.
3. ALL WIRING TO BE TRI-RATED.
4. COMPENSATING CABLES FOR TYPE 'K' THERMOCOUPLES WITH COLD JUNCTION.
   COMPENSATION PROVIDED BY THE SIGNAL CONVERTOR WILL BE USED ON ALL TYPE AI4 LOOPS.
5. L- FOR ALL REMOTE ANNUNCIATORS IS DERIVED FROM THE ESD 24Vdc SUPPLY.
6. WIRE No.s ARE DEFINED USING CARD POSITION/CHANNEL NUMBER.

THIS DRAWING IS THE PROPERTY OF HIMA-SELLA LIMITED AND IS LOANED IN CONFIDENCE FOR USE WITH OUR WORK. IT IS NOT TO BE REPRODUCED IN ANY MANNER, SUBMITTED TO OUTSIDE PARTIES FOR EXAMINATION OR USED DIRECTLY OR INDIRECTLY FOR PURPOSES OTHER THAN THOSE FOR WHICH IT WAS FURNISHED WITHOUT WRITTEN CONSENT.

Template Revision – For Office Records Only

REV	AUTH	DATE	CAD TEMPLATE REF.
B	MB	7.4.10	A3-FRAME

Scale on A3 sheet	N/A
Dimensions	N/A

DO NOT STAMP 'MASTER' UNTIL ALL WORK IS FULLY CADDED

Rev	Design	Drawn	Chkd	Appd	Description	Date
C	NH	NH	CW	NGB	AS BUILT.	06.06.00
D	CP	EJC	CW	NGB	SITE MODS	15.09.00
E	IM	AB	AD	CT	TEXT ADDED	06.10.11
F				CT	PLANT 3 ESD CABINET MODS C10265039V	29.01.21

Designed	NH
Drawn	NH
Checked	CW
Approved	NGB
Date	31.03.00
Cad Reference	10265-P3-133

HIMA–SELLA LIMITED © HIMA-SELLA

Title : LOOP DRAWING - OUTPUTS
ICI SYNETIX SCHEDULE - No.3 AND No.7 PLANTS
FISHER-ROSEMOUNTP.O. No. 99003994

Contract/ Drawing No	C10265H-P3	133	REV	F

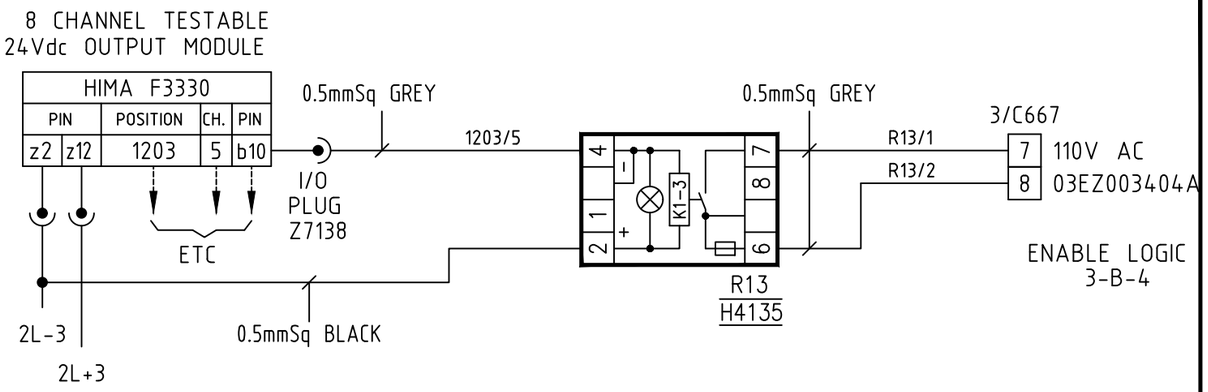

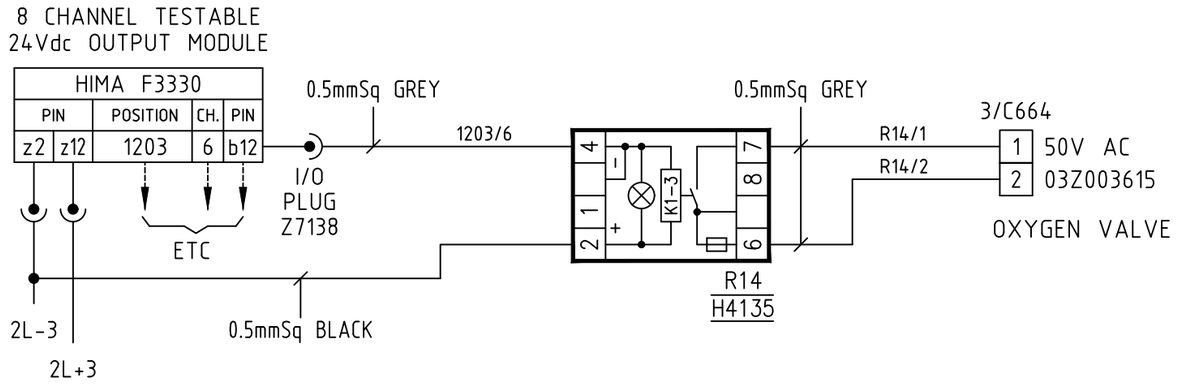

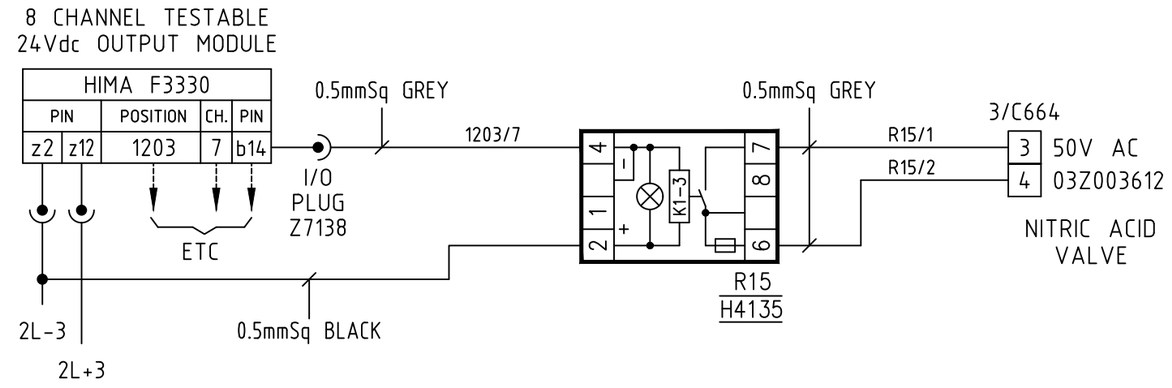

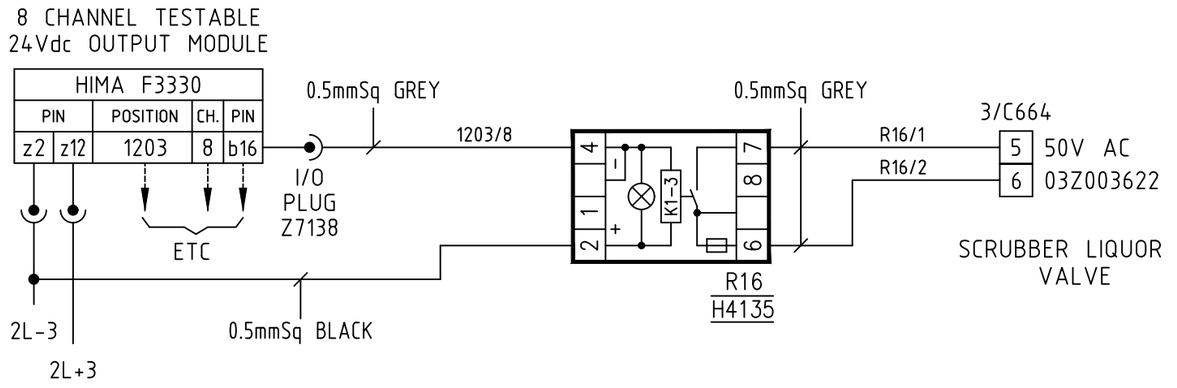

NOTES
1. FIRST TERMINAL OF PAIR SHOULD ALWAYS BE '+' (ASK1 (50mA) ON ANALOGUE INPUTS ONLY).
2. ANALOGUE LOOPS WILL BE WIRED USING SCREENED CABLES WHERE POSSIBLE.
3. ALL WIRING TO BE TRI-RATED.
4. COMPENSATING CABLES FOR TYPE 'K' THERMOCOUPLES WITH COLD JUNCTION.
   COMPENSATION PROVIDED BY THE SIGNAL CONVERTOR WILL BE USED ON ALL TYPE AI4 LOOPS.
5. L- FOR ALL REMOTE ANNUNCIATORS IS DERIVED FROM THE ESD 24Vdc SUPPLY.
6. WIRE No.s ARE DEFINED USING CARD POSITION/CHANNEL NUMBER.

THIS DRAWING IS THE PROPERTY OF HIMA-SELLA LIMITED AND IS LOANED IN CONFIDENCE FOR USE WITH OUR WORK. IT IS NOT TO BE REPRODUCED IN ANY MANNER, SUBMITTED TO OUTSIDE PARTIES FOR EXAMINATION OR USED DIRECTLY OR INDIRECTLY FOR PURPOSES OTHER THAN THOSE FOR WHICH IT WAS FURNISHED WITHOUT WRITTEN CONSENT.

Template Revision – For Office Records Only

REV	AUTH	DATE	CAD TEMPLATE REF.
B	MB	7.4.10	A3-FRAME

Scale on A3 sheet	N/A
Dimensions	N/A

DO NOT STAMP 'MASTER' UNTIL ALL WORK IS FULLY CADDED

Rev	Design	Drawn	Chkd	Appd	Description	Date
C	NH	NH	CW	NGB	AS BUILT.	06.06.00
D					TEXT ADDED	11.08.11

Designed	NH
Drawn	NH
Checked	CW
Approved	NGB
Date	31.03.00
Cad Reference	10265-P3-134

HIMA–SELLA LIMITED © HIMA-SELLA

Title : LOOP DRAWING - OUTPUTS
ICI SYNETIX SCHEDULE - No.3 AND No.7 PLANTS
FISHER-ROSEMOUNTP.O. No. 99003994

Contract/ Drawing No	C10265H-P3	134	REV	D

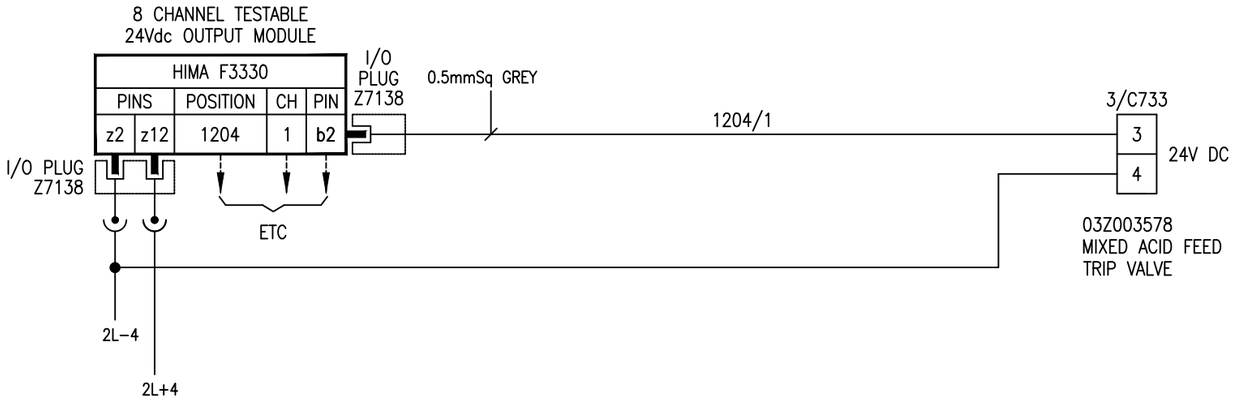

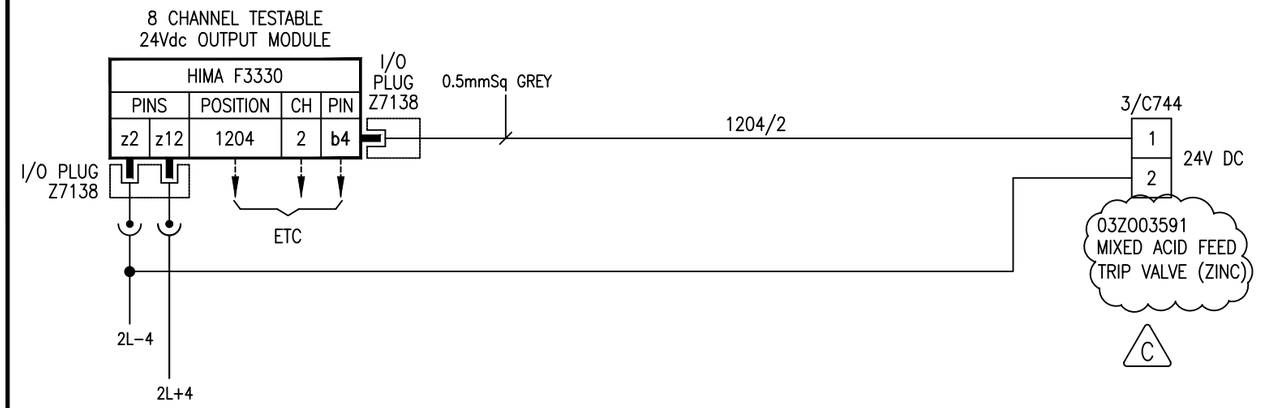

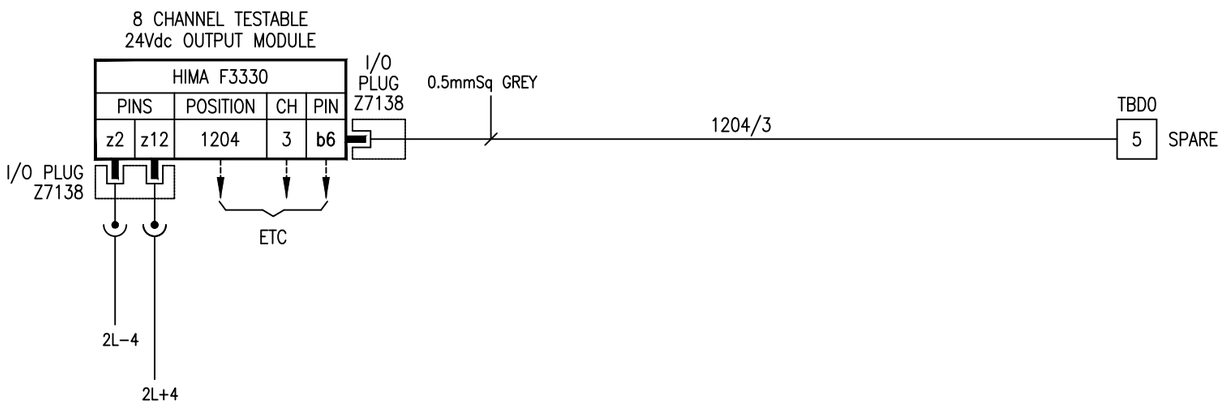

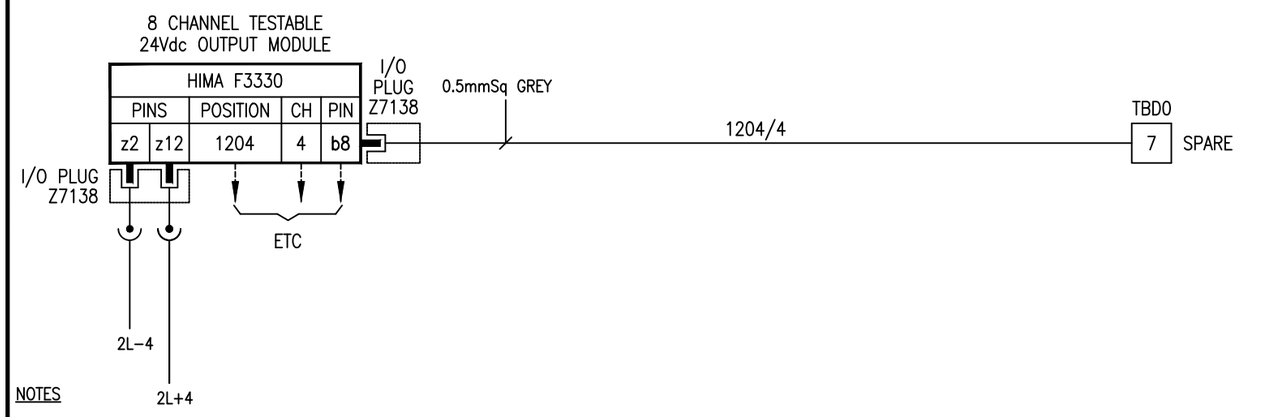

NOTES

1. FIRST TERMINAL OR PAIR SHOULD ALWAYS BE '+' (ASK1 (50mA) ON ANLOGUE INPUT ONLY).
2. ANALOGUE LOOPS WILL BE WIRED USING SCREENED CABLES WHERE POSSIBLE.
3. ALL WIRING TO BE TRI-RATED.
4. COMPENSATING CABLES FOR TYPE 'K' THERMOCOUPLES WITH COLD JUNCTION. COMPENSATION PROVIDED BY THE SIGNAL CONVERTER WILL BE USED ON ALL TYPES AI4 LOOPS.
5. L- FOR ALL REMOTE ANNUNCIATORS IS DELIVERED FROM THE ESD 24VDC SUPPLY.
6. WIRE No.s ARE DEFINED USING CARD POSITION / CHANNEL NUMBER.

THIS DRAWING IS THE PROPERTY OF HIMA-SELLA LIMITED AND IS LOANED IN CONFIDENCE FOR USE WITH OUR WORK. IT IS NOT TO BE REPRODUCED IN ANY MANNER, SUBMITTED TO OUTSIDE PARTIES FOR EXAMINATION OR USED DIRECTLY OR INDIRECTLY FOR PURPOSES OTHER THAN THOSE FOR WHICH IT WAS FURNISHED WITHOUT WRITTEN CONSENT.

Scale on A3 sheet	N/A
Dimensions	N/A

Template Revision – For Office Records Only

REV	AUTH	DATE	CAD TEMPLATE REF.
0	AB	18.07.11	A3-FRAME

DO NOT STAMP 'MASTER' UNTIL ALL WORK IS FULLY CADDED

Rev	Design	Drawn	Chkd	Appd	Description	Date
A					WIRE NUMBERS ADDED	06.10.11
B	DP	WJB	RB	CT	ZINC DISSOLVER PHR & MMN IMPROVEMENTS	06.03.14
C				DP	AS BUILT POST C10265033V	01.05.19

Designed	IM
Drawn	JRM
Checked	IM
Approved	MHS
Date	11.08.11
Cad Reference	10265-P3-135

HIMA-SELLA LIMITED © HIMA-SELLA

Title : LOOP DRAWING - OUTPUTS
ICI SYNETIX SCHEDULE - No.3 AND No.7 PLANTS
FISHER-ROSEMOUNTP.O. No. 99003994

Contract/ Drawing No	C10265H-P3	135	REV	C

8 CHANNEL TESTABLE
24Vdc OUTPUT MODULE

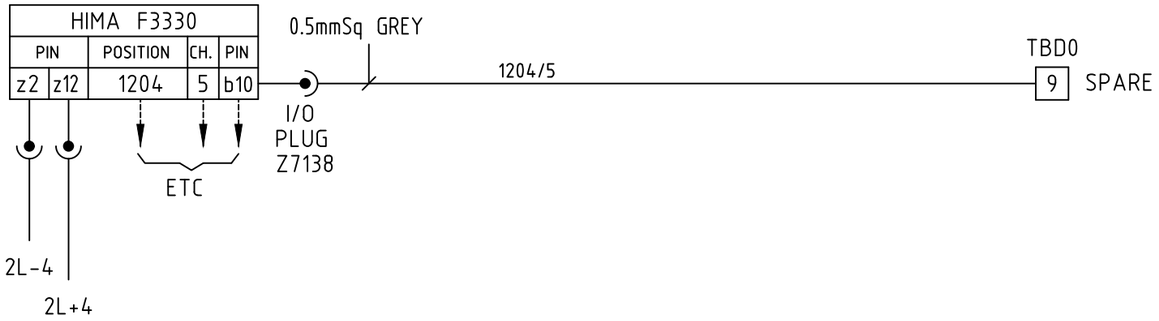

8 CHANNEL TESTABLE
24Vdc OUTPUT MODULE

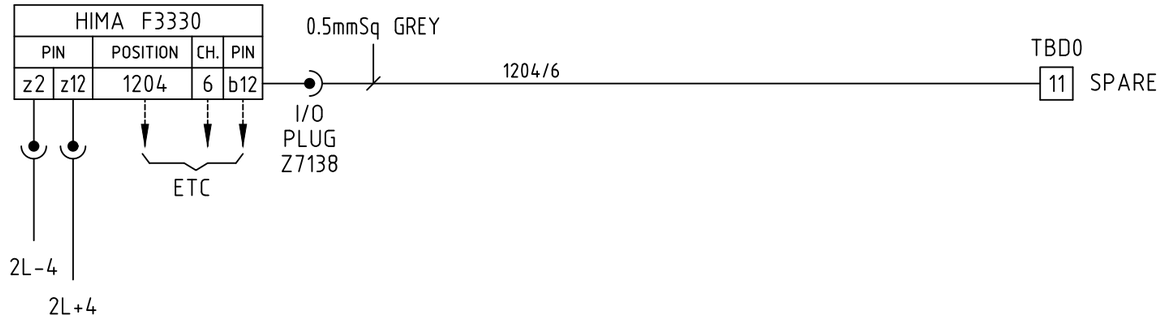

8 CHANNEL TESTABLE
24Vdc OUTPUT MODULE

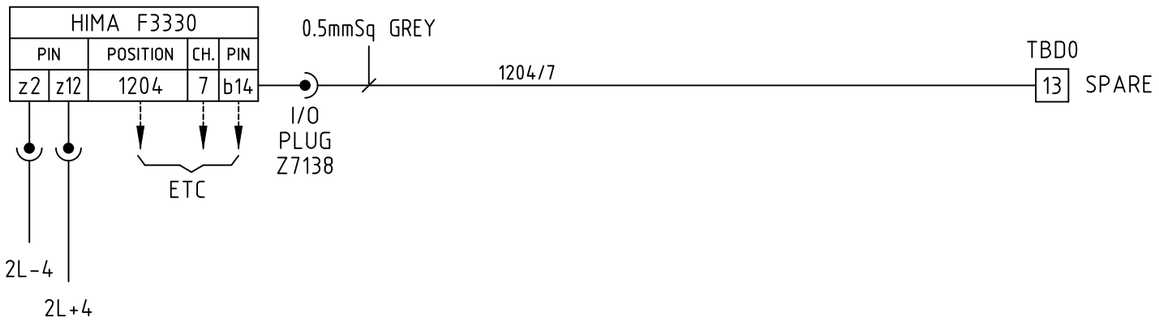

8 CHANNEL TESTABLE
24Vdc OUTPUT MODULE

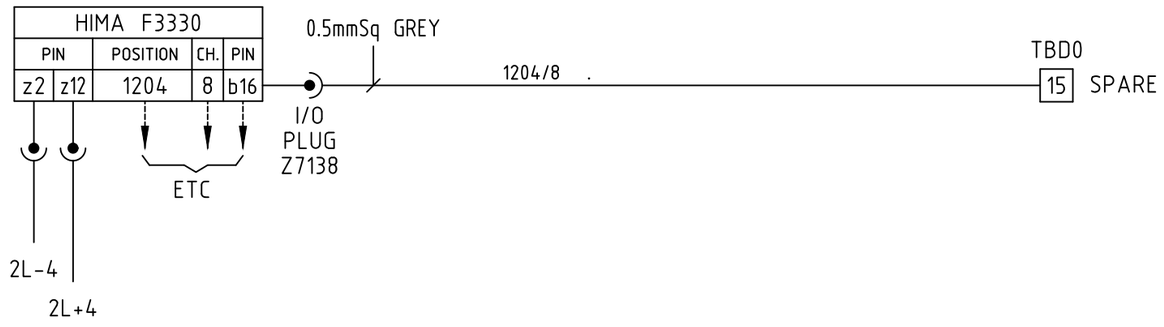

THIS DRAWING IS THE PROPERTY OF HIMA-SELLA LIMITED AND IS LOANED IN CONFIDENCE FOR USE WITH OUR WORK. IT IS NOT TO BE REPRODUCED IN ANY MANNER, SUBMITTED TO OUTSIDE PARTIES FOR EXAMINATION OR USED DIRECTLY OR INDIRECTLY FOR PURPOSES OTHER THAN THOSE FOR WHICH IT WAS FURNISHED WITHOUT WRITTEN CONSENT.

Template Revision – For Office Records Only

REV	AUTH	DATE	CAD TEMPLATE REF.
0	AB	18.07.11	A3-FRAME

Scale on A3 sheet	N/A
Dimensions	N/A

DO NOT STAMP 'MASTER' UNTIL ALL WORK IS FULLY CADDED

Rev	Design	Drawn	Chkd	Appd	Description	Date
A					WIRE NUMBERS ADDED	06.10.11

Designed	IM
Drawn	JRM
Checked	IM
Approved	MHS
Date	18.07.11
Cad Reference	10265-P3-136

HIMA–SELLA LIMITED © HIMA-SELLA

Title : LOOP DRAWING - OUTPUTS
ICI SYNETIX SCHEDULE - No.3 AND No.7 PLANTS
FISHER-ROSEMOUNTP.O. No. 99003994

Contract/ Drawing No			REV	
	C10265H-P3	136	REV	A

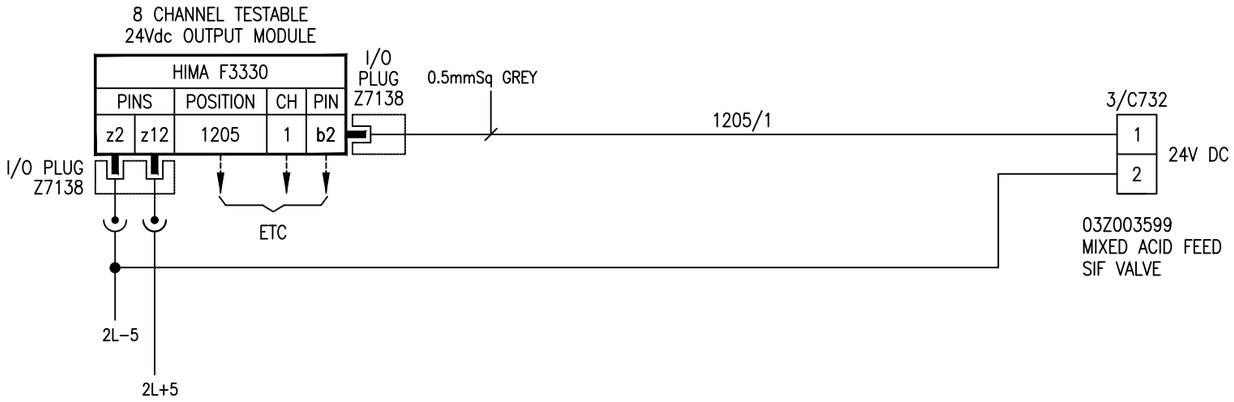

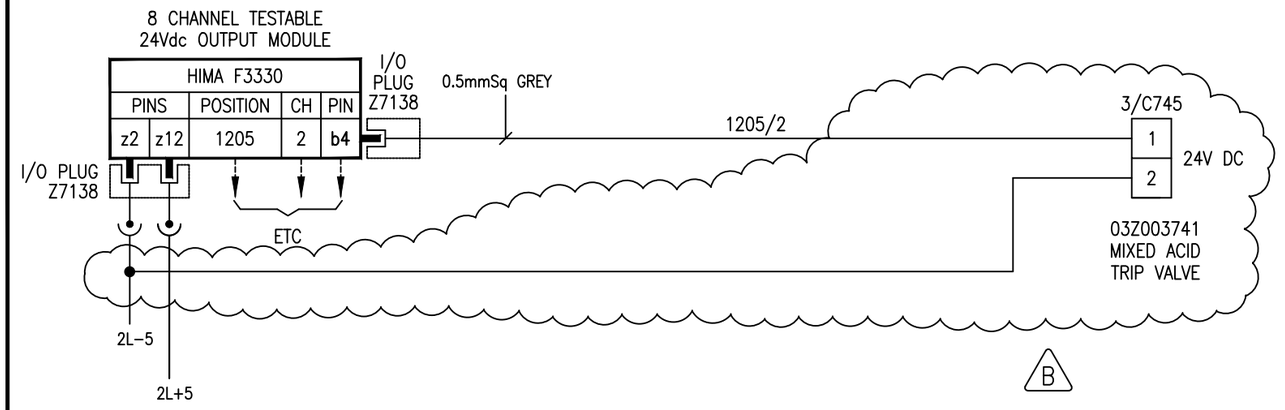

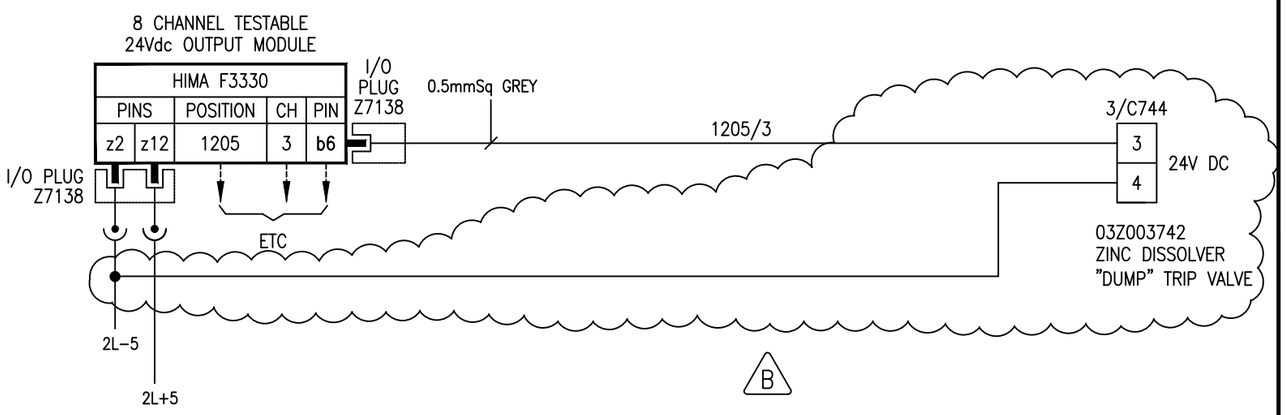

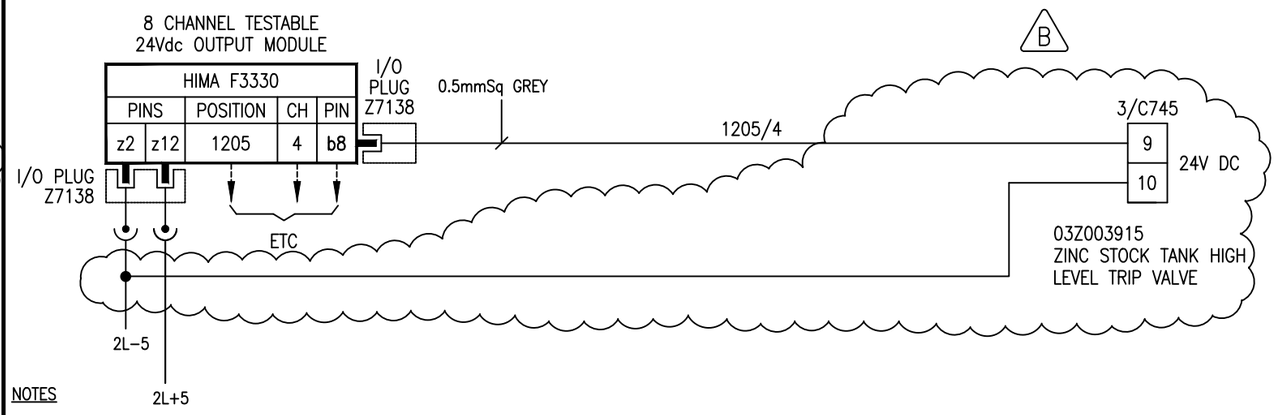

NOTES

1. FIRST TERMINAL OR PAIR SHOULD ALWAYS BE '+' (ASK1 (50mA) ON ANLOGUE INPUT ONLY).
2. ANALOGUE LOOPS WILL BE WIRED USING SCREENED CABLES WHERE POSSIBLE.
3. ALL WIRING TO BE TRI-RATED.
4. COMPENSATING CABLES FOR TYPE 'K' THERMOCOUPLES WITH COLD JUNCTION. COMPENSATION PROVIDED BY THE SIGNAL CONVERTER WILL BE USED ON ALL TYPES AI4 LOOPS.
5. L- FOR ALL REMOTE ANNUNCIATORS IS DELIVERED FROM THE ESD 24VDC SUPPLY.
6. WIRE No.s ARE DEFINED USING CARD POSITION / CHANNEL NUMBER.

THIS DRAWING IS THE PROPERTY OF HIMA-SELLA LIMITED AND IS LOANED IN CONFIDENCE FOR USE WITH OUR WORK. IT IS NOT TO BE REPRODUCED IN ANY MANNER, SUBMITTED TO OUTSIDE PARTIES FOR EXAMINATION OR USED DIRECTLY OR INDIRECTLY FOR PURPOSES OTHER THAN THOSE FOR WHICH IT WAS FURNISHED WITHOUT WRITTEN CONSENT.

Template Revision – For Office Records Only

REV	AUTH	DATE	CAD TEMPLATE REF.
0	AB	18.07.11	A3-FRAME

Scale on A3 sheet	N/A
Dimensions	N/A

DO NOT STAMP 'MASTER' UNTIL ALL WORK IS FULLY CADDED

Rev	Design	Drawn	Chkd	Appd	Description	Date
A					WIRE NUMBERS ADDED	06.10.11
B				CT	ZINC DISSOLVER PHR & MMN IMPROVEMENTS	24.02.14

Designed	IM
Drawn	JRM
Checked	IM
Approved	MHS
Date	11.08.11
Cad Reference	10265-P3-137

HIMA-SELLA LIMITED © HIMA-SELLA

Title : LOOP DRAWING - OUTPUTS
ICI SYNETIX SCHEDULE - No.3 AND No.7 PLANTS
FISHER-ROSEMOUNTP.O. No. 99003994

Contract/ Drawing No	C10265H-P3	137	REV	B

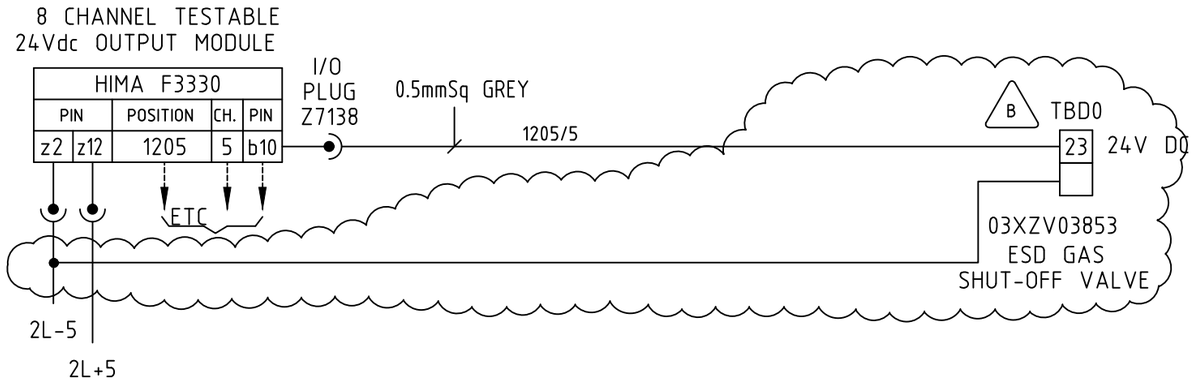

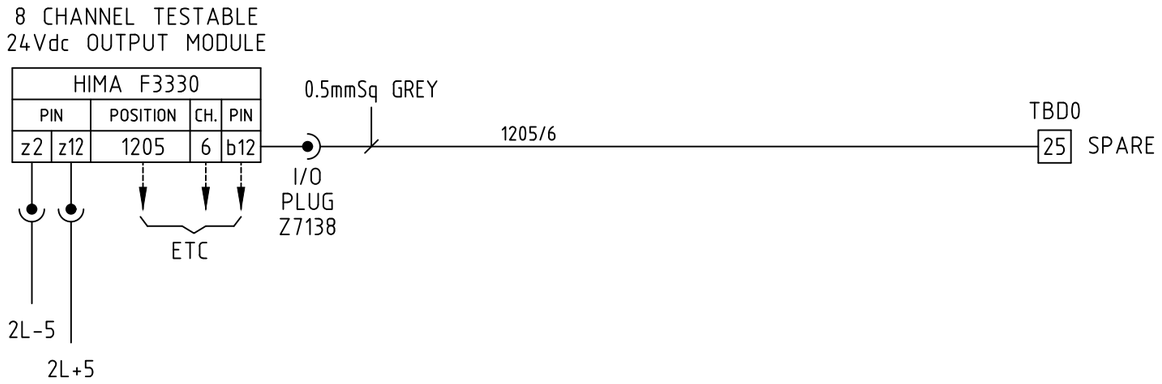

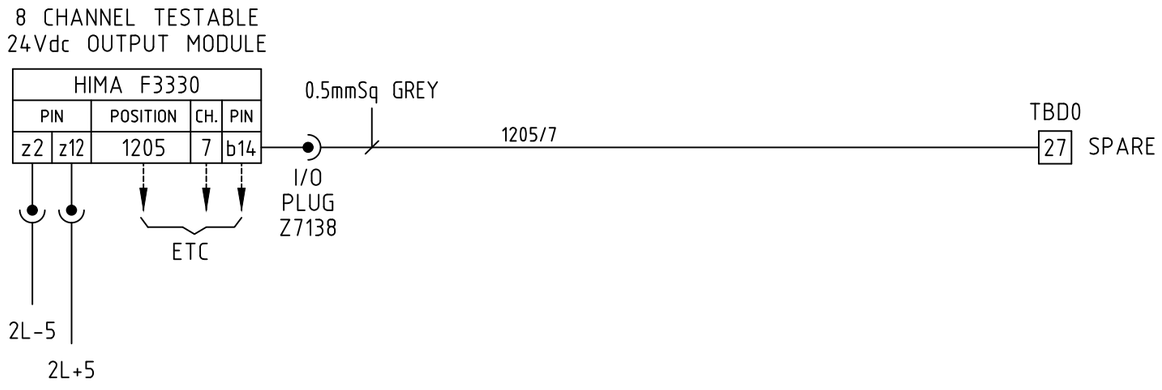

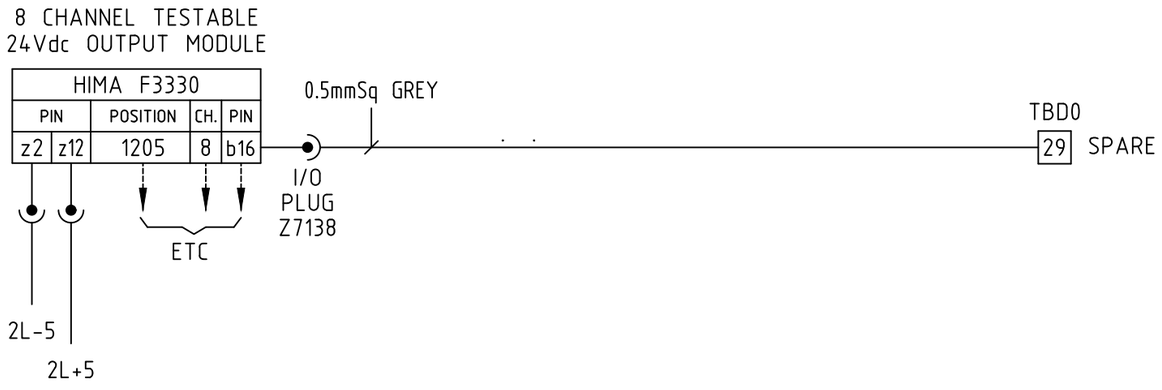

THIS DRAWING IS THE PROPERTY OF HIMA-SELLA LIMITED AND IS LOANED IN CONFIDENCE FOR USE WITH OUR WORK. IT IS NOT TO BE REPRODUCED IN ANY MANNER, SUBMITTED TO OUTSIDE PARTIES FOR EXAMINATION OR USED DIRECTLY OR INDIRECTLY FOR PURPOSES OTHER THAN THOSE FOR WHICH IT WAS FURNISHED WITHOUT WRITTEN CONSENT.

Template Revision – For Office Records Only			
REV	AUTH	DATE	CAD TEMPLATE REF.
0	AB	18.07.11	A3-FRAME

Scale on A3 sheet	N/A
Dimensions	N/A

DO NOT STAMP 'MASTER' UNTIL ALL WORK IS FULLY CADDED

Rev	Design	Drawn	Chkd	Appd	Description	Date
A					WIRE NUMBERS ADDED	06.10.11

Designed	IM
Drawn	JRM
Checked	IM
Approved	MHS
Date	18.07.11
Cad Reference	10265-P3-138

HIMA–SELLA LIMITED © HIMA-SELLA

Title : LOOP DRAWING - OUTPUTS
ICI SYNETIX SCHEDULE - No.3 AND No.7 PLANTS
FISHER-ROSEMOUNTP.O. No. 99003994

Contract/ Drawing No	C10265H-P3	138	REV	A

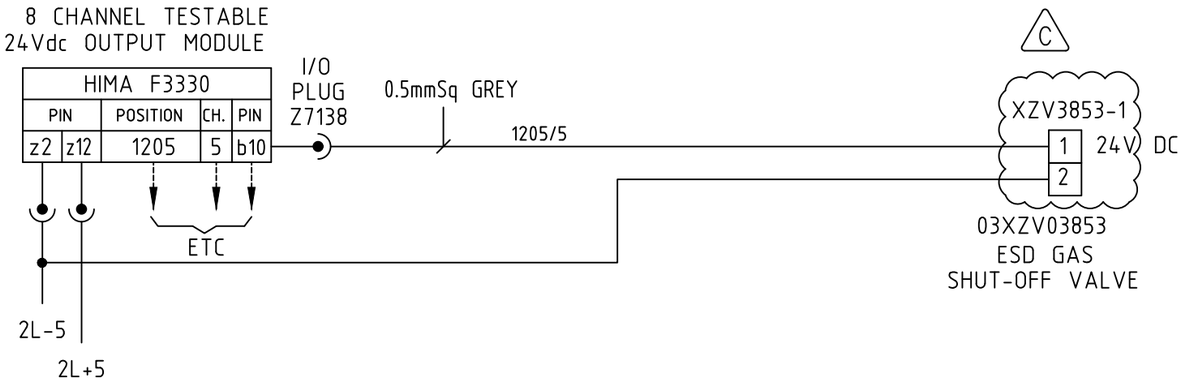

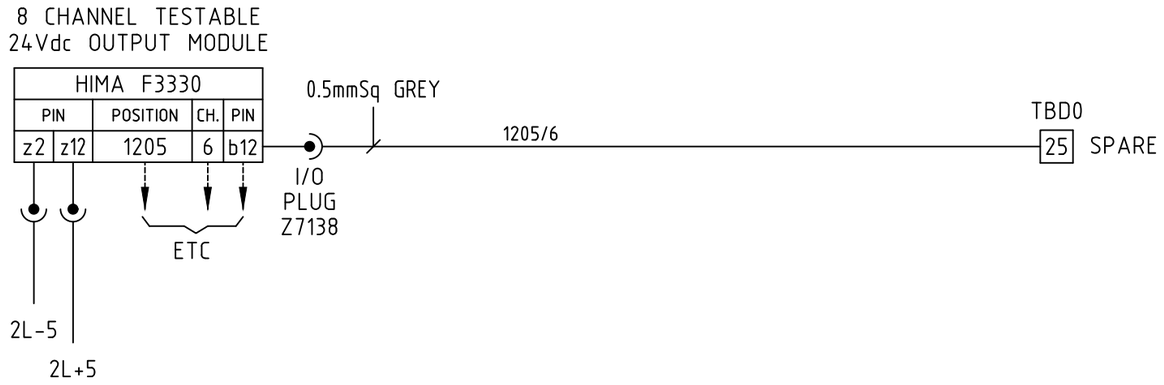

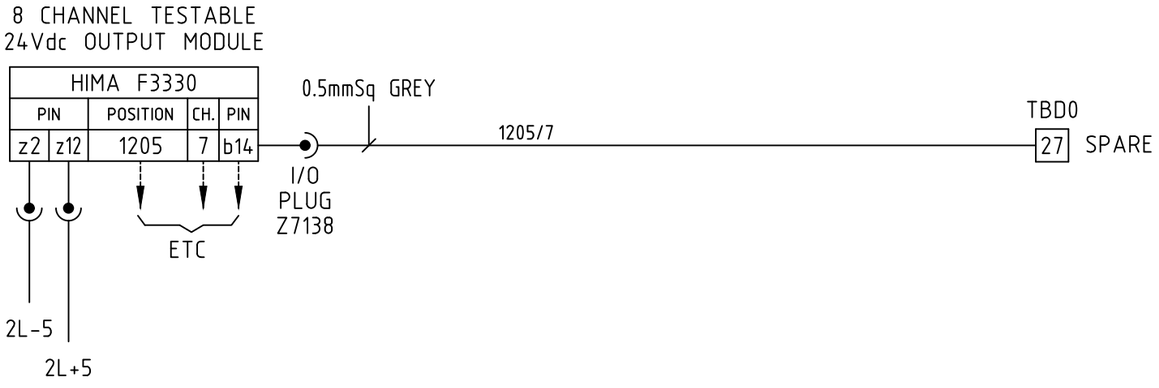

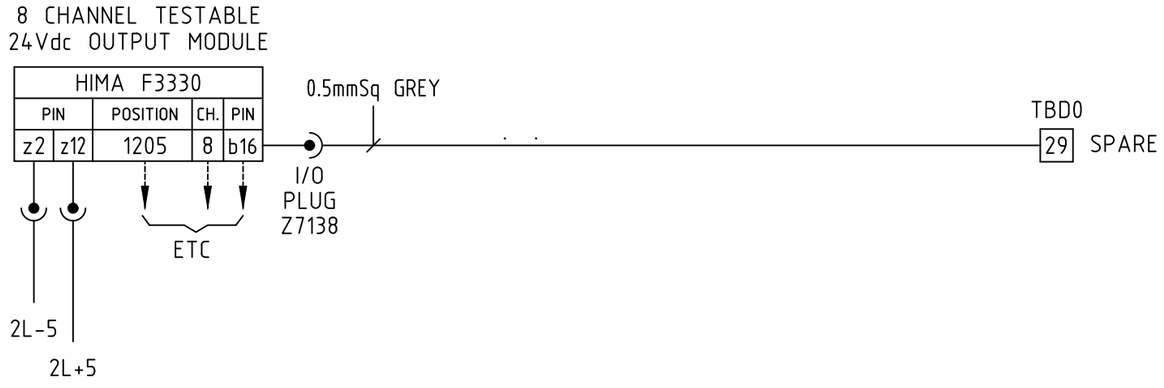

THIS DRAWING IS THE PROPERTY OF HIMA-SELLA LIMITED AND IS LOANED IN CONFIDENCE FOR USE WITH OUR WORK. IT IS NOT TO BE REPRODUCED IN ANY MANNER, SUBMITTED TO OUTSIDE PARTIES FOR EXAMINATION OR USED DIRECTLY OR INDIRECTLY FOR PURPOSES OTHER THAN THOSE FOR WHICH IT WAS FURNISHED WITHOUT WRITTEN CONSENT.

Template Revision – For Office Records Only

REV	AUTH	DATE	CAD TEMPLATE REF.
0	AB	18.07.11	A3-FRAME

Scale on A3 sheet	N/A
Dimensions	N/A

DO NOT STAMP 'MASTER' UNTIL ALL WORK IS FULLY CADDED

Rev	Design	Drawn	Chkd	Appd	Description	Date
A	IM	AB	AD	CT	WIRE NUMBERS ADDED	06.10.11
B	DP	DB	EEM	CT	PLANT 3 ESD CABINET MODS C10265039V	29.01.21
C	.	.	.	CT	AS BUILT C10265039V	13.07.21

Designed	IM
Drawn	JRM
Checked	IM
Approved	MHS
Date	18.07.11
Cad Reference	10265-P3-138

HIMA–SELLA LIMITED © HIMA-SELLA

Title : LOOP DRAWING - OUTPUTS
ICI SYNETIX SCHEDULE - No.3 AND No.7 PLANTS
FISHER-ROSEMOUNTP.O. No. 99003994

Contract/ Drawing No	C10265H-P3	138	REV	C

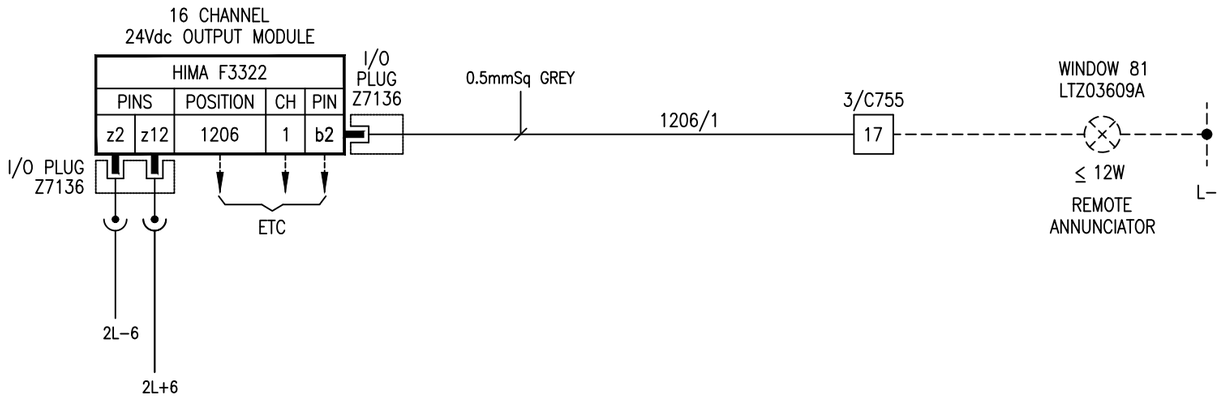

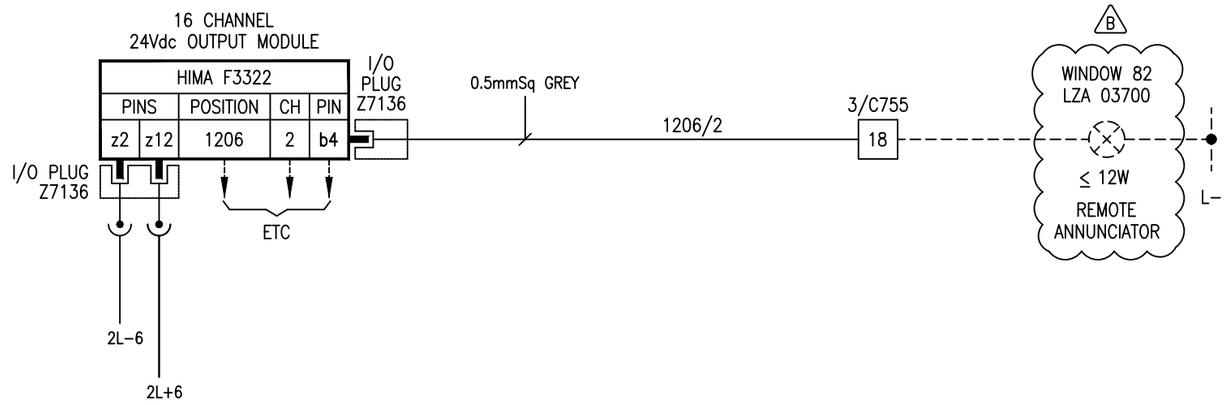

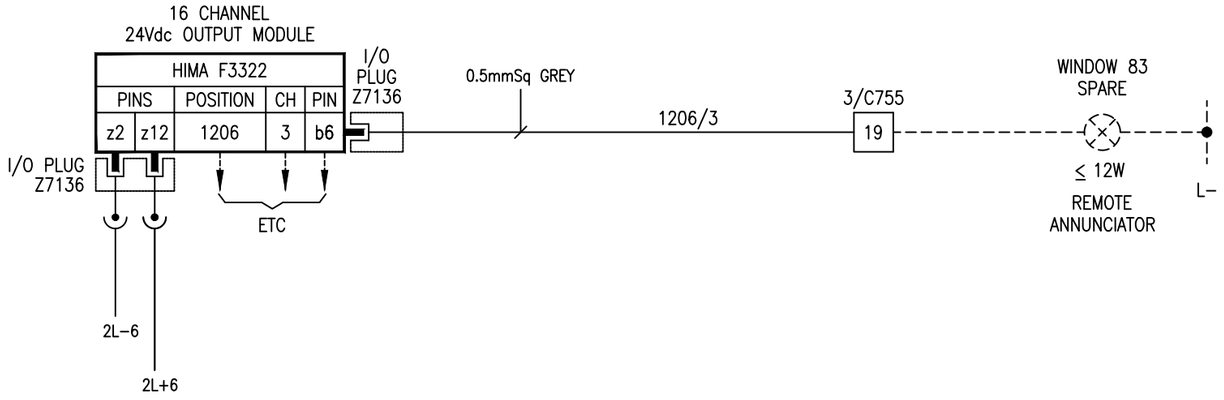

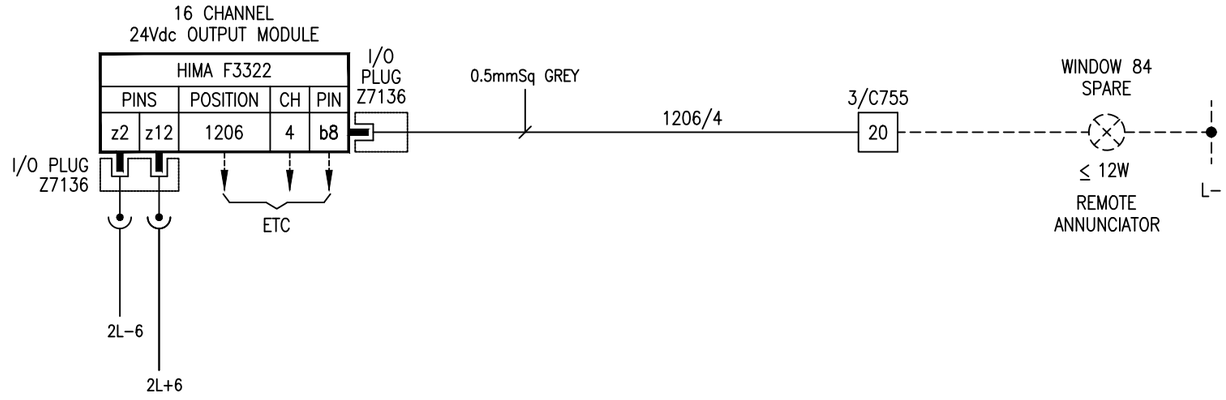

NOTES

1. FIRST TERMINAL OR PAIR SHOULD ALWAYS BE '+' (ASK1 (50mA) ON ANLOGUE INPUT ONLY).
2. ANALOGUE LOOPS WILL BE WIRED USING SCREENED CABLES WHERE POSSIBLE.
3. ALL WIRING TO BE TRI–RATED.
4. COMPENSATING CABLES FOR TYPE 'K' THERMOCOUPLES WITH COLD JUNCTION. COMPENSATION PROVIDED BY THE SIGNAL CONVERTER WILL BE USED ON ALL TYPES AI4 LOOPS.
5. L– FOR ALL REMOTE ANNUNCIATORS IS DELIVERED FROM THE ESD 24VDC SUPPLY.
6. WIRE No.s ARE DEFINED USING CARD POSITION / CHANNEL NUMBER.

THIS DRAWING IS THE PROPERTY OF HIMA-SELLA LIMITED AND IS LOANED IN CONFIDENCE FOR USE WITH OUR WORK. IT IS NOT TO BE REPRODUCED IN ANY MANNER, SUBMITTED TO OUTSIDE PARTIES FOR EXAMINATION OR USED DIRECTLY OR INDIRECTLY FOR PURPOSES OTHER THAN THOSE FOR WHICH IT WAS FURNISHED WITHOUT WRITTEN CONSENT.

Template Revision – For Office Records Only

REV	AUTH	DATE	CAD TEMPLATE REF.
B	MB	7.4.10	A3-FRAME

Scale on A3 sheet	N/A
Dimensions	N/A

DO NOT STAMP 'MASTER' UNTIL ALL WORK IS FULLY CADDED

Rev	Design	Drawn	Chkd	Appd	Description	Date
A	DP	MW	AD	CT	AS BUILT PER C10265-012V	29.10.14
B				CT	PROJECT ARPG 80 MODS TO 3 PLANT ESD SYSTEM	20.03.19

Designed	DP
Drawn	WB
Checked	RB
Approved	CT
Date	14.03.14
Cad Reference	10265-P3-139

HIMA–SELLA LIMITED © HIMA-SELLA

Title : LOOP DRAWING - OUTPUTS
ICI SYNETIX SCHEDULE - No.3 AND No.7 PLANTS
FISHER-ROSEMOUNTP.O. No. 99003994

Contract/ Drawing No	C10265H-P3	139	REV	B

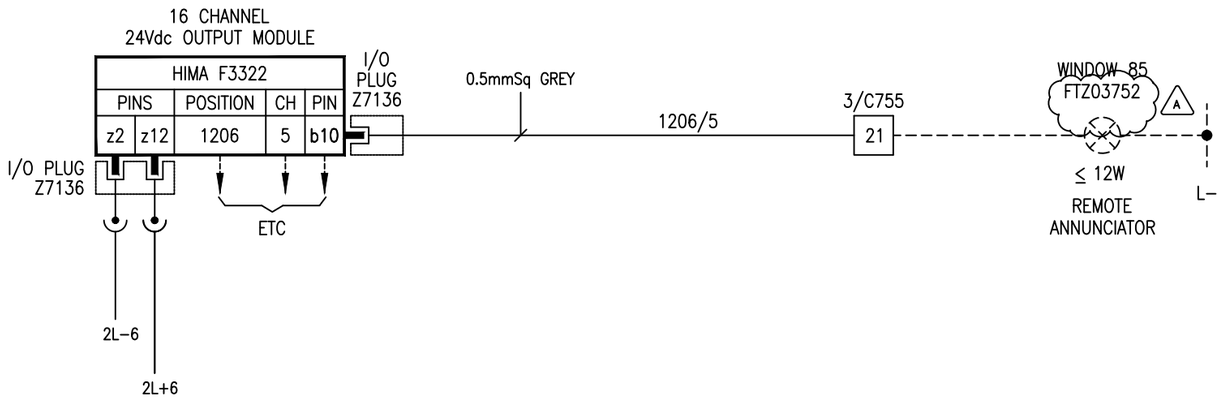

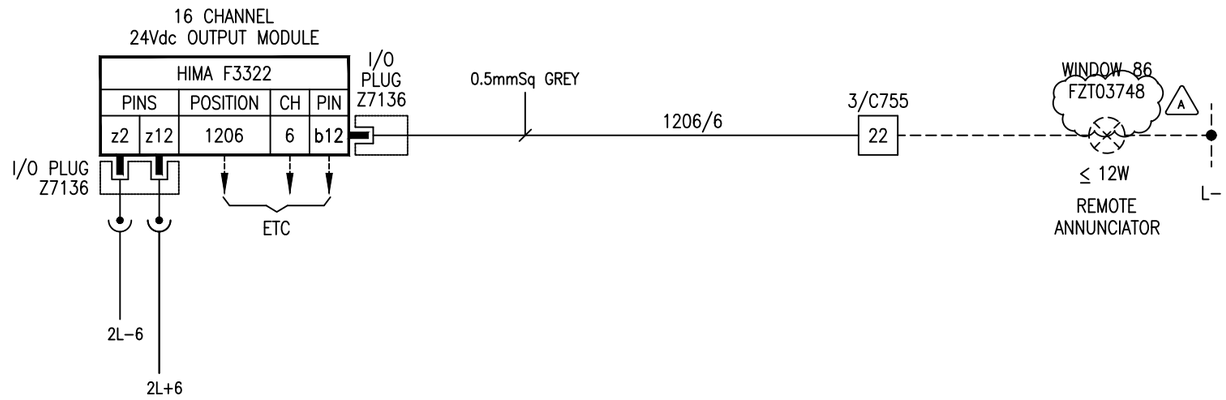

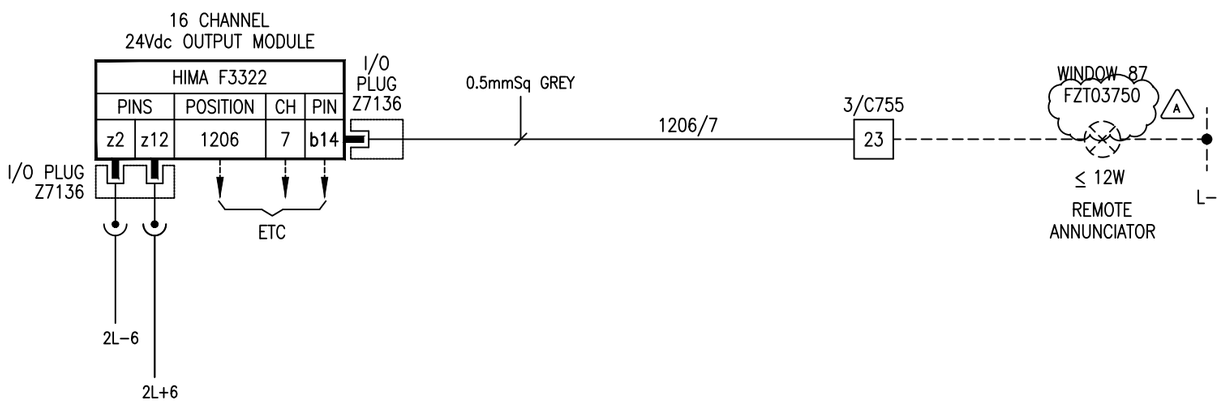

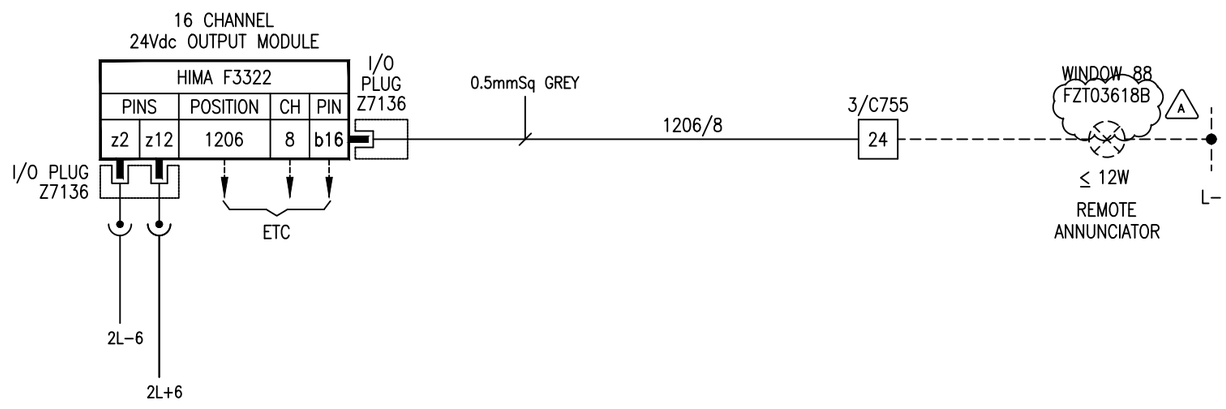

NOTES

1. FIRST TERMINAL OR PAIR SHOULD ALWAYS BE '+' (ASK1 (50mA) ON ANLOGUE INPUT ONLY).
2. ANALOGUE LOOPS WILL BE WIRED USING SCREENED CABLES WHERE POSSIBLE.
3. ALL WIRING TO BE TRI–RATED.
4. COMPENSATING CABLES FOR TYPE 'K' THERMOCOUPLES WITH COLD JUNCTION. COMPENSATION PROVIDED BY THE SIGNAL CONVERTER WILL BE USED ON ALL TYPES AI4 LOOPS.
5. L– FOR ALL REMOTE ANNUNCIATORS IS DELIVERED FROM THE ESD 24VDC SUPPLY.
6. WIRE No.s ARE DEFINED USING CARD POSITION / CHANNEL NUMBER.

THIS DRAWING IS THE PROPERTY OF HIMA-SELLA LIMITED AND IS LOANED IN CONFIDENCE FOR USE WITH OUR WORK. IT IS NOT TO BE REPRODUCED IN ANY MANNER, SUBMITTED TO OUTSIDE PARTIES FOR EXAMINATION OR USED DIRECTLY OR INDIRECTLY FOR PURPOSES OTHER THAN THOSE FOR WHICH IT WAS FURNISHED WITHOUT WRITTEN CONSENT.

Template Revision – For Office Records Only

REV	AUTH	DATE	CAD TEMPLATE REF.
B	MB	7.4.10	A3-FRAME

Scale on A3 sheet	N/A
Dimensions	N/A

DO NOT STAMP 'MASTER' UNTIL ALL WORK IS FULLY CADDED

Rev	Design	Drawn	Chkd	Appd	Description	Date
A				CT	AS BUILT PER C10265-012V	29.10.14

Designed	DP
Drawn	WB
Checked	RB
Approved	CT
Date	14.03.14
Cad Reference	10265-P3-140

HIMA–SELLA LIMITED © HIMA-SELLA

Title : LOOP DRAWING - OUTPUTS
ICI SYNETIX SCHEDULE - No.3 AND No.7 PLANTS
FISHER-ROSEMOUNTP.O. No. 99003994

Contract/ Drawing No	C10265H-P3	140	REV	A

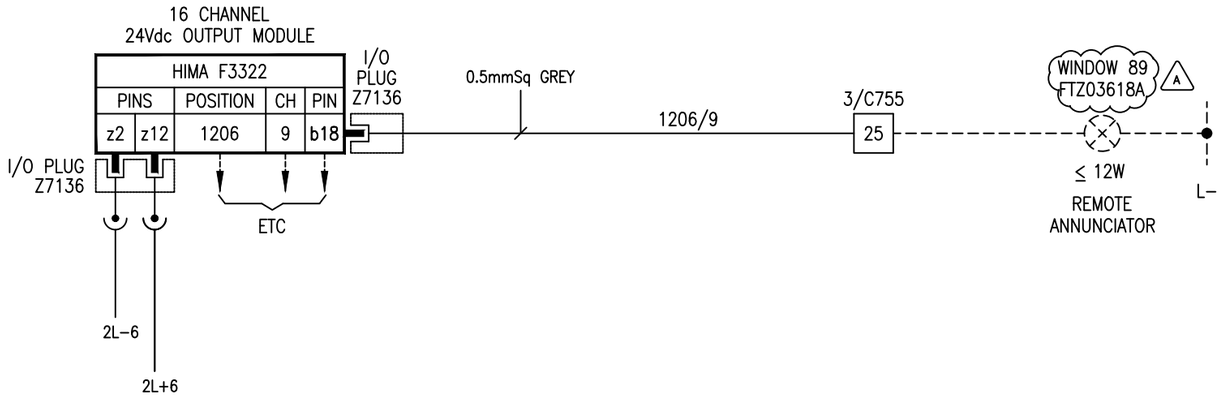

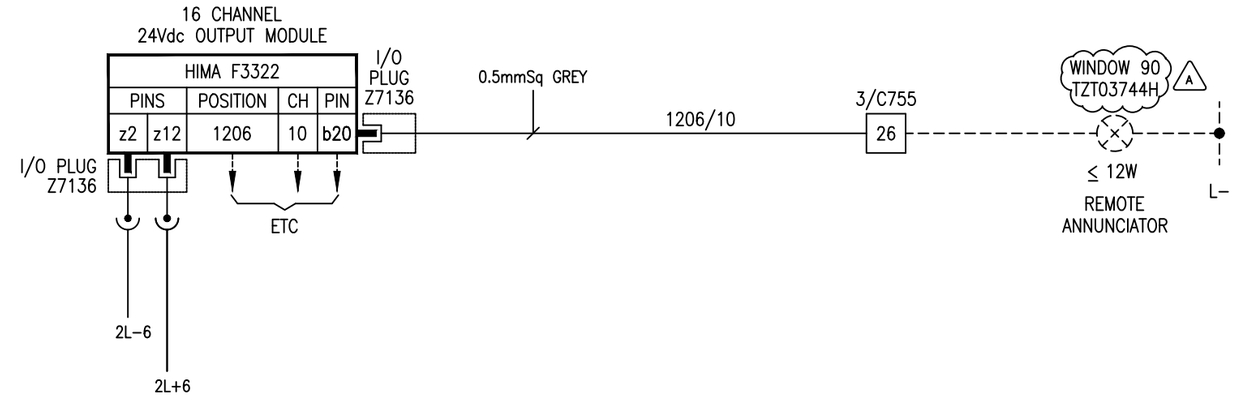

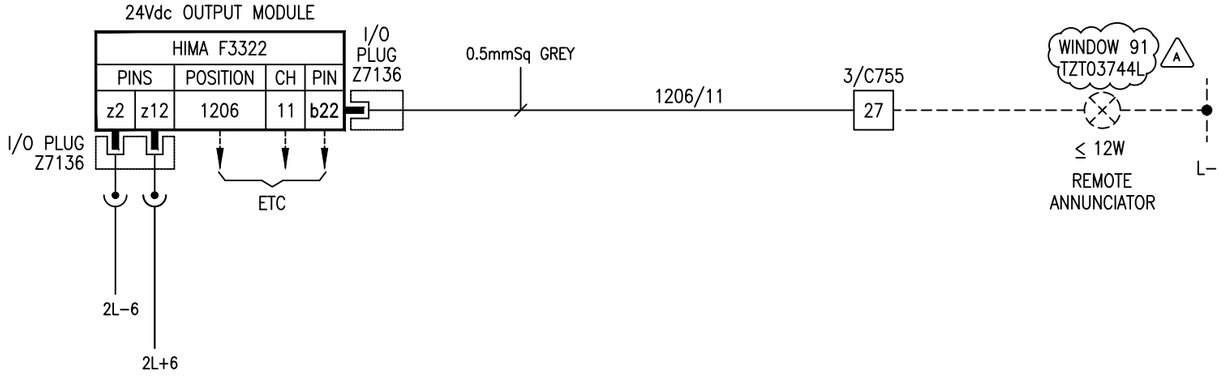

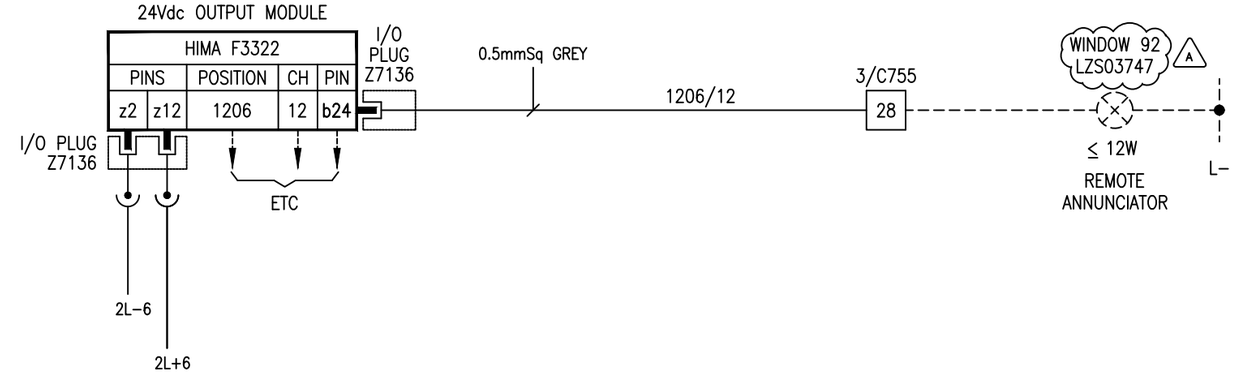

NOTES

1. FIRST TERMINAL OR PAIR SHOULD ALWAYS BE '+' (ASK1 (50mA) ON ANLOGUE INPUT ONLY).
2. ANALOGUE LOOPS WILL BE WIRED USING SCREENED CABLES WHERE POSSIBLE.
3. ALL WIRING TO BE TRI–RATED.
4. COMPENSATING CABLES FOR TYPE 'K' THERMOCOUPLES WITH COLD JUNCTION. COMPENSATION PROVIDED BY THE SIGNAL CONVERTER WILL BE USED ON ALL TYPES AI4 LOOPS.
5. L– FOR ALL REMOTE ANNUNCIATORS IS DELIVERED FROM THE ESD 24VDC SUPPLY.
6. WIRE No.s ARE DEFINED USING CARD POSITION / CHANNEL NUMBER.

THIS DRAWING IS THE PROPERTY OF HIMA-SELLA LIMITED AND IS LOANED IN CONFIDENCE FOR USE WITH OUR WORK. IT IS NOT TO BE REPRODUCED IN ANY MANNER, SUBMITTED TO OUTSIDE PARTIES FOR EXAMINATION OR USED DIRECTLY OR INDIRECTLY FOR PURPOSES OTHER THAN THOSE FOR WHICH IT WAS FURNISHED WITHOUT WRITTEN CONSENT.

Template Revision – For Office Records Only

REV	AUTH	DATE	CAD TEMPLATE REF.
B	MB	7.4.10	A3-FRAME

Scale on A3 sheet	N/A
Dimensions	N/A

DO NOT STAMP 'MASTER' UNTIL ALL WORK IS FULLY CADDED

Rev	Design	Drawn	Chkd	Appd	Description	Date
A				CT	AS BUILT PER C10265-012V	29.10.14

Designed	DP
Drawn	WB
Checked	RB
Approved	CT
Date	14.03.14
Cad Reference	10265-P3-141

HIMA–SELLA LIMITED © HIMA-SELLA

Title : LOOP DRAWING - OUTPUTS
ICI SYNETIX SCHEDULE - No.3 AND No.7 PLANTS
FISHER-ROSEMOUNTP.O. No. 99003994

Contract/ Drawing No	C10265H-P3	141	REV	A

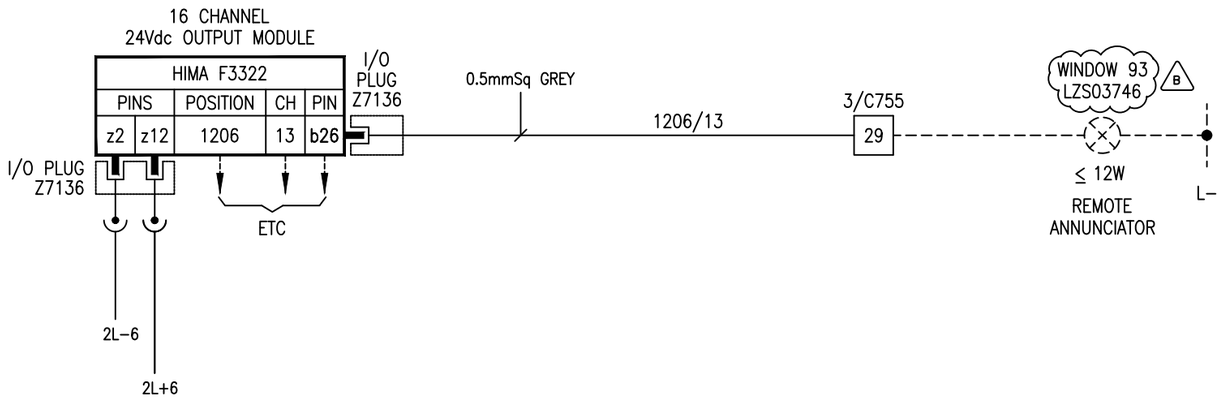

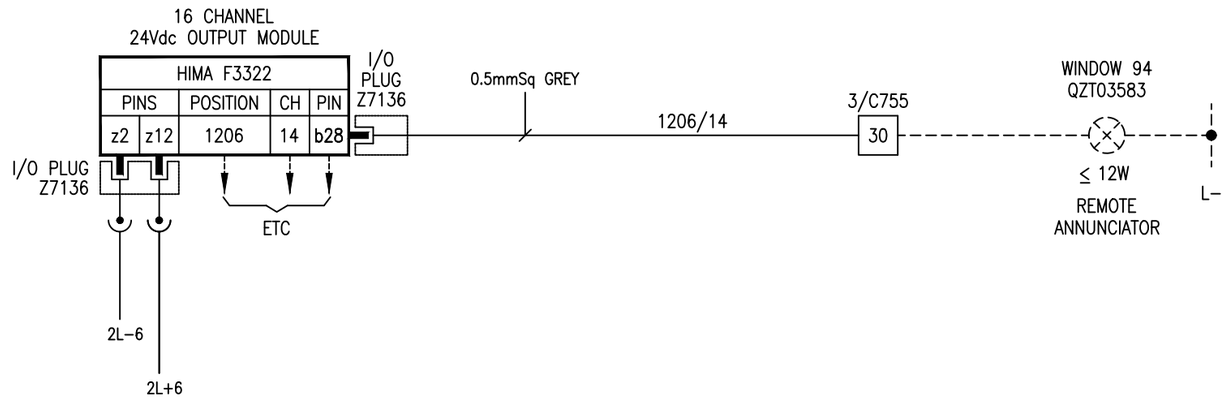

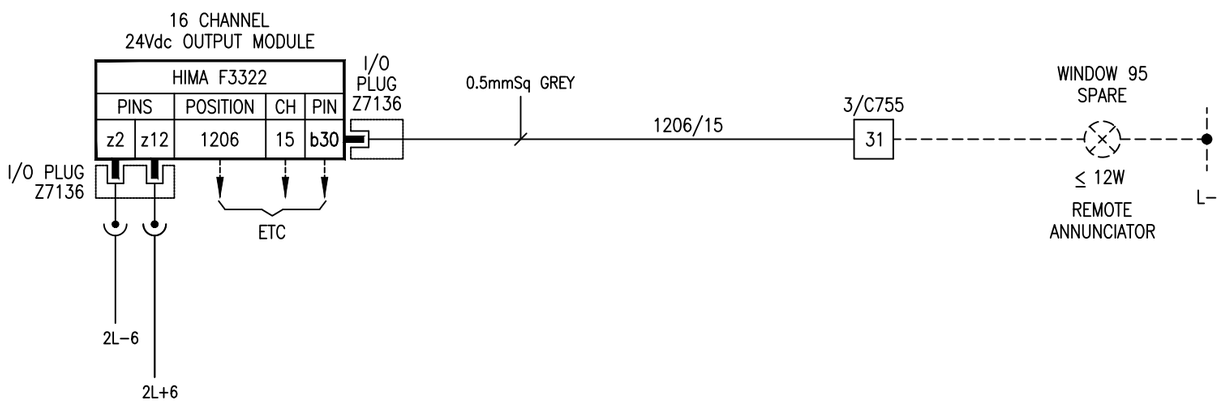

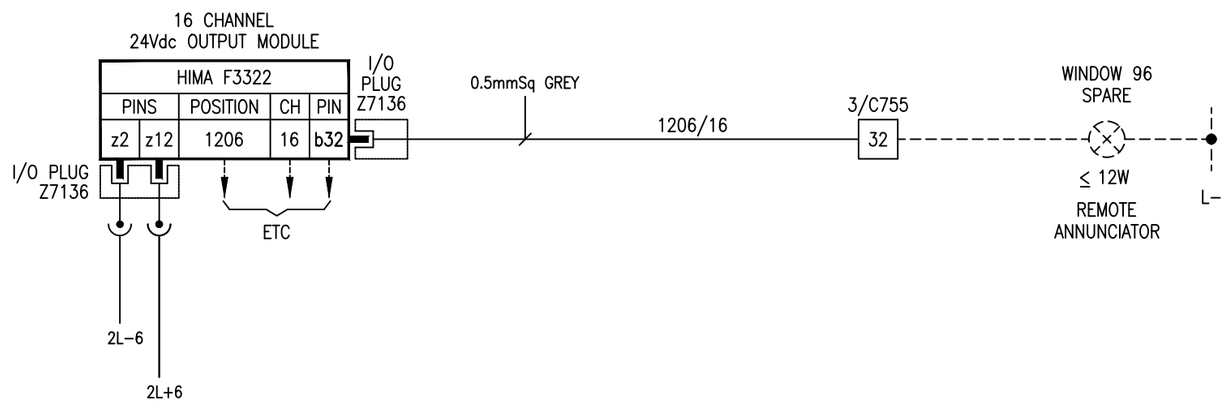

NOTES

1. FIRST TERMINAL OR PAIR SHOULD ALWAYS BE '+' (ASK1 (50mA) ON ANLOGUE INPUT ONLY).
2. ANALOGUE LOOPS WILL BE WIRED USING SCREENED CABLES WHERE POSSIBLE.
3. ALL WIRING TO BE TRI–RATED.
4. COMPENSATING CABLES FOR TYPE 'K' THERMOCOUPLES WITH COLD JUNCTION. COMPENSATION PROVIDED BY THE SIGNAL CONVERTER WILL BE USED ON ALL TYPES AI4 LOOPS.
5. L– FOR ALL REMOTE ANNUNCIATORS IS DELIVERED FROM THE ESD 24VDC SUPPLY.
6. WIRE No.s ARE DEFINED USING CARD POSITION / CHANNEL NUMBER.

THIS DRAWING IS THE PROPERTY OF HIMA-SELLA LIMITED AND IS LOANED IN CONFIDENCE FOR USE WITH OUR WORK. IT IS NOT TO BE REPRODUCED IN ANY MANNER, SUBMITTED TO OUTSIDE PARTIES FOR EXAMINATION OR USED DIRECTLY OR INDIRECTLY FOR PURPOSES OTHER THAN THOSE FOR WHICH IT WAS FURNISHED WITHOUT WRITTEN CONSENT.

Template Revision – For Office Records Only

REV	AUTH	DATE	CAD TEMPLATE REF.
B	MB	7.4.10	A3-FRAME

Scale on A3 sheet	N/A
Dimensions	N/A

DO NOT STAMP 'MASTER' UNTIL ALL WORK IS FULLY CADDED

Rev	Design	Drawn	Chkd	Appd	Description	Date
A	DP	MW	AD	CT	AS BUILT PER C10265-012V	29.10.14
B					MODS TO 3 PLANT AS PER C10265033V	26.30.19

Designed	DP
Drawn	WB
Checked	RB
Approved	CT
Date	24.02.14
Cad Reference	10265-P3-142

HIMA–SELLA LIMITED © HIMA-SELLA

Title : LOOP DRAWING - OUTPUTS
ICI SYNETIX SCHEDULE - No.3 AND No.7 PLANTS
FISHER-ROSEMOUNTP.O. No. 99003994

Contract/ Drawing No	C10265H-P3	142	REV	B

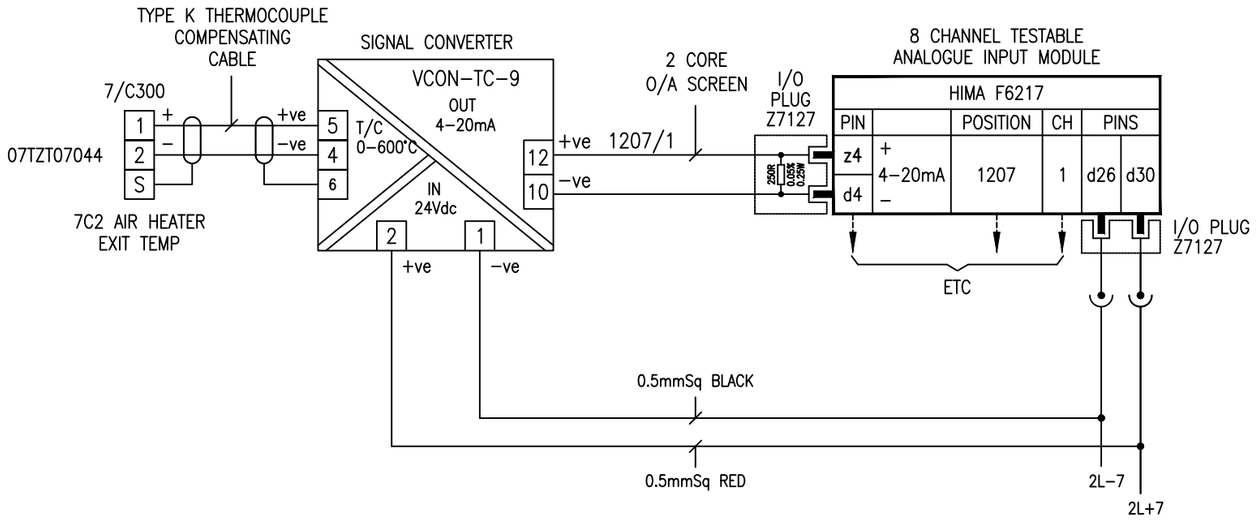

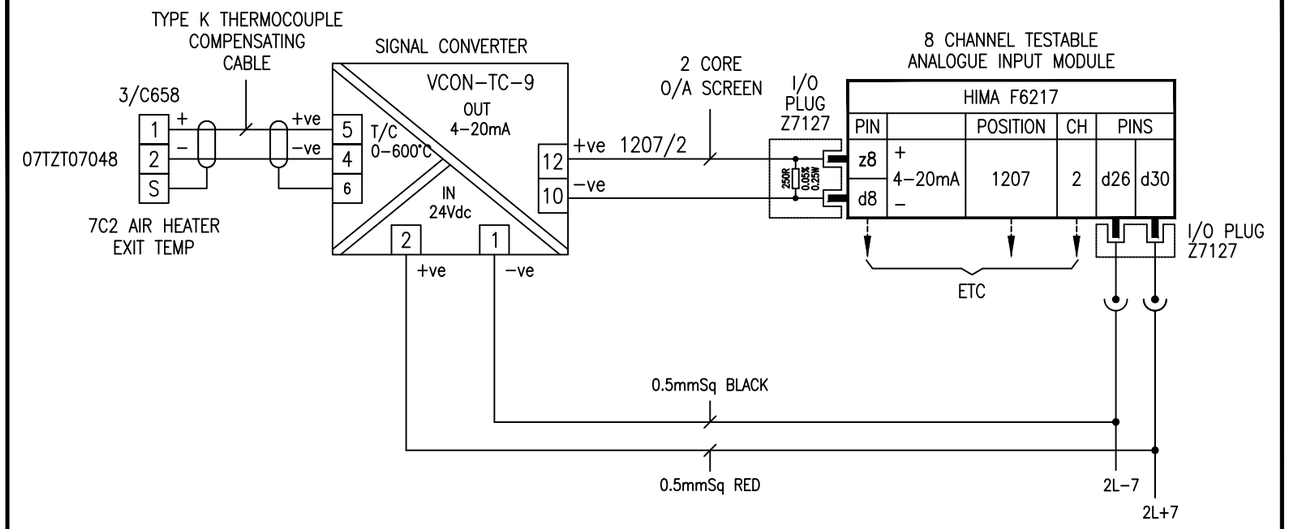

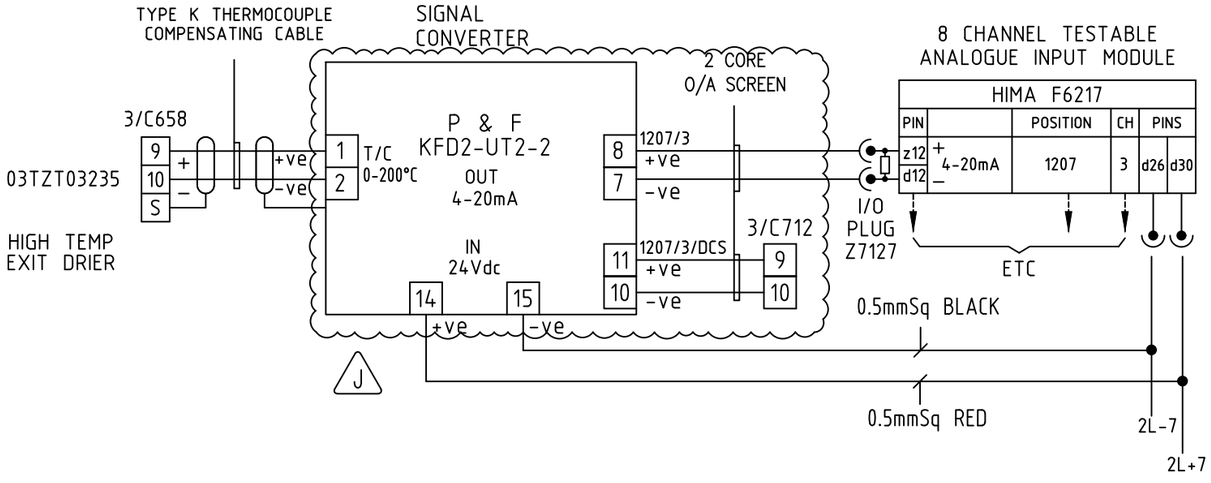

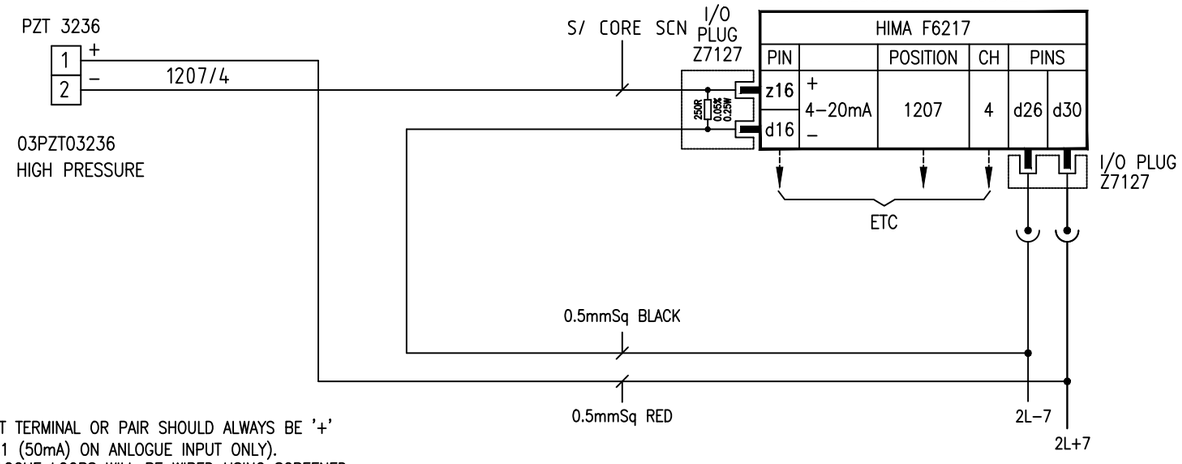

NOTES

1. FIRST TERMINAL OR PAIR SHOULD ALWAYS BE '+' (ASK1 (50mA) ON ANLOGUE INPUT ONLY).
2. ANALOGUE LOOPS WILL BE WIRED USING SCREENED CABLES WHERE POSSIBLE.
3. ALL WIRING TO BE TRI–RATED.
4. COMPENSATING CABLES FOR TYPE 'K' THERMOCOUPLES WITH COLD JUNCTION. COMPENSATION PROVIDED BY THE SIGNAL CONVERTER WILL BE USED ON ALL TYPES AI4 LOOPS.
5. L– FOR ALL REMOTE ANNUNCIATORS IS DELIVERED FROM THE ESD 24VDC SUPPLY.
6. WIRE No.s ARE DEFINED USING CARD POSITION / CHANNEL NUMBER.

THIS DRAWING IS THE PROPERTY OF HIMA-SELLA LIMITED AND IS LOANED IN CONFIDENCE FOR USE WITH OUR WORK. IT IS NOT TO BE REPRODUCED IN ANY MANNER, SUBMITTED TO OUTSIDE PARTIES FOR EXAMINATION OR USED DIRECTLY OR INDIRECTLY FOR PURPOSES OTHER THAN THOSE FOR WHICH IT WAS FURNISHED WITHOUT WRITTEN CONSENT.

Scale on A3 sheet	N/A
Dimensions	N/A

Template Revision – For Office Records Only			
REV	AUTH	DATE	CAD TEMPLATE REF.
B	MB	7.4.10	A3-FRAME

DO NOT STAMP 'MASTER' UNTIL ALL WORK IS FULLY CADDED

Rev	Design	Drawn	Chkd	Appd	Description	Date
C	NA	NA	CW	NGB	AS BUILT.	06.06.00
D	NA	NA	CW	NGB	TEXT ADDED	24.02.14
E	DP	MW	AD	CT	ZINC DISSOLVER PHR & MMN IMPROVEMENTS	24.02.14
F	DP	DB	EEM	CT	PLANT 3 ESD CABINET MODS C10265039V	29.01.21
G	DP	DB	JP	CT	PLANT 3 ESD CABINET MODS C10265039V	18.03.21
H	DP	AL	AD	CT	AS BUILT C10265039V	13.07.21
J				DP	C10265049V MODIFICATIONS	02.10.24

Designed	NH
Drawn	NH
Checked	CW
Approved	NGB
Date	29.03.00
Cad Reference	10265-P3-143

HIMA–SELLA LIMITED © HIMA-SELLA

Title : LOOP DRAWING - INPUTS
ICI SYNETIX SCHEDULE - No.3 AND No.7 PLANTS
FISHER-ROSEMOUNTP.O. No. 99003994

Contract/ Drawing No	C10265H-P3	143	REV	J

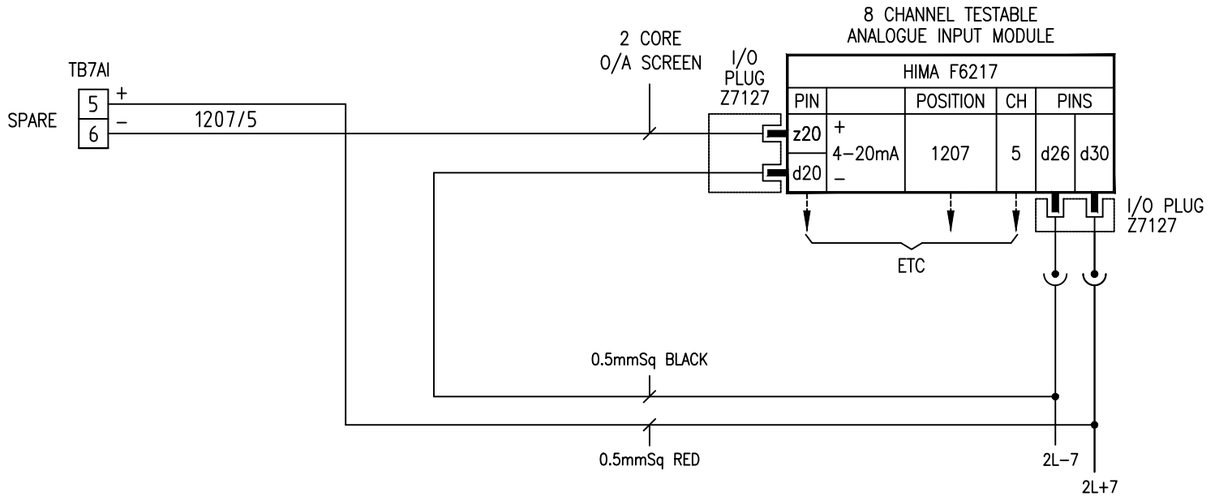

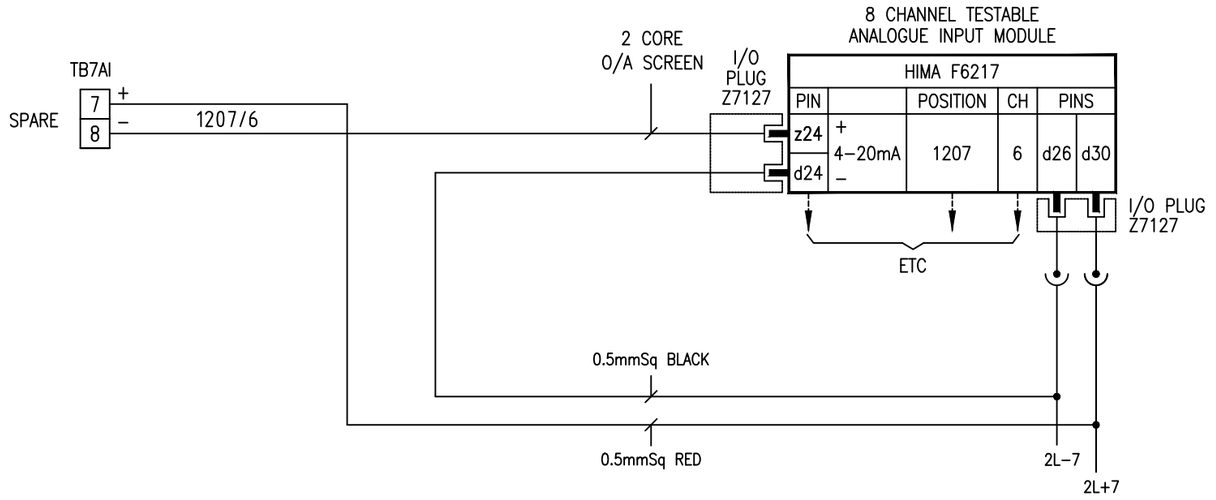

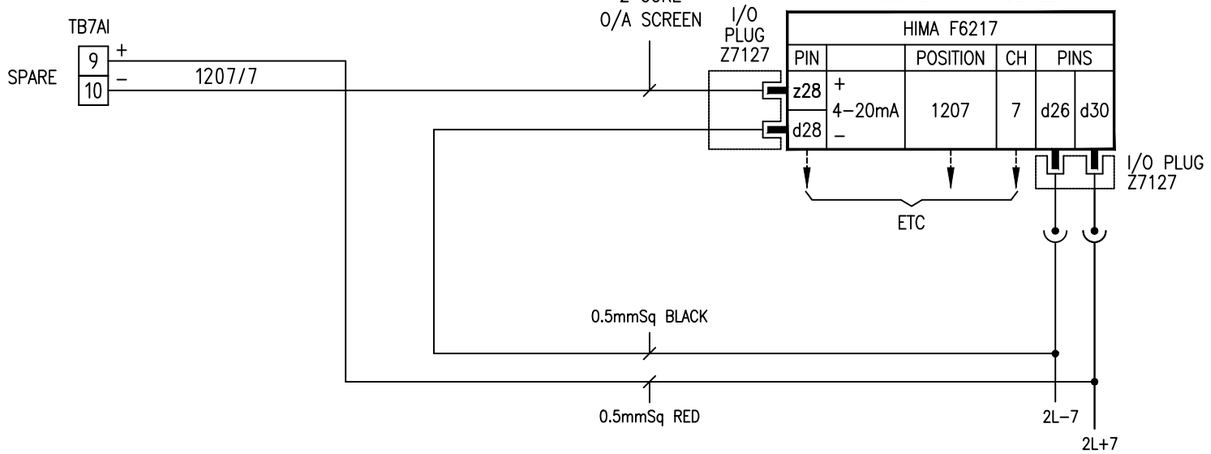

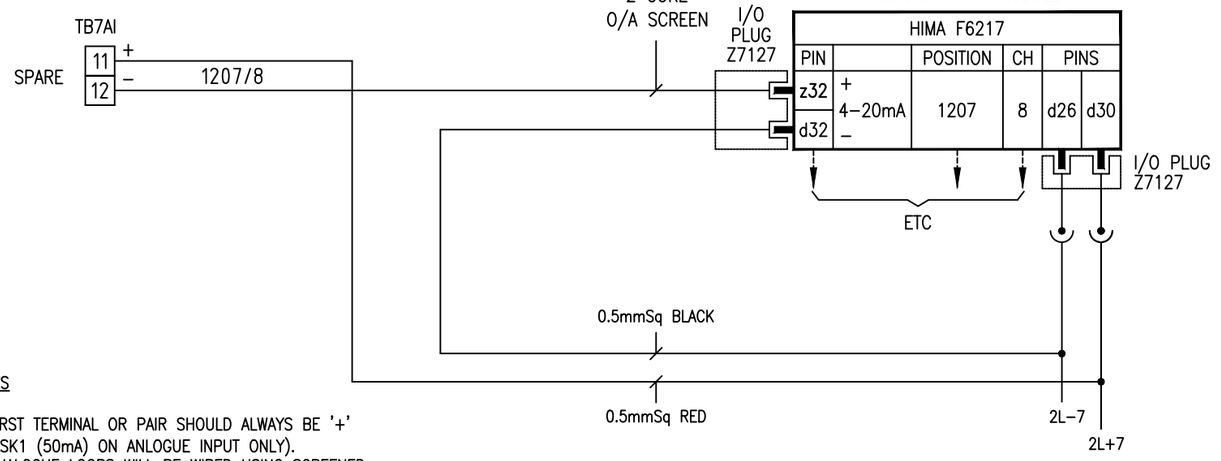

NOTES

1. FIRST TERMINAL OR PAIR SHOULD ALWAYS BE '+' (ASK1 (50mA) ON ANLOGUE INPUT ONLY).
2. ANALOGUE LOOPS WILL BE WIRED USING SCREENED CABLES WHERE POSSIBLE.
3. ALL WIRING TO BE TRI–RATED.
4. COMPENSATING CABLES FOR TYPE 'K' THERMOCOUPLES WITH COLD JUNCTION. COMPENSATION PROVIDED BY THE SIGNAL CONVERTER WILL BE USED ON ALL TYPES AI4 LOOPS.
5. L– FOR ALL REMOTE ANNUNCIATORS IS DELIVERED FROM THE ESD 24VDC SUPPLY.
6. WIRE No.s ARE DEFINED USING CARD POSITION / CHANNEL NUMBER.

THIS DRAWING IS THE PROPERTY OF HIMA-SELLA LIMITED AND IS LOANED IN CONFIDENCE FOR USE WITH OUR WORK. IT IS NOT TO BE REPRODUCED IN ANY MANNER, SUBMITTED TO OUTSIDE PARTIES FOR EXAMINATION OR USED DIRECTLY OR INDIRECTLY FOR PURPOSES OTHER THAN THOSE FOR WHICH IT WAS FURNISHED WITHOUT WRITTEN CONSENT.

Template Revision – For Office Records Only

REV	AUTH	DATE	CAD TEMPLATE REF.
B	MB	7.4.10	A3-FRAME

Scale on A3 sheet	N/A
Dimensions	N/A

DO NOT STAMP 'MASTER' UNTIL ALL WORK IS FULLY CADDED

Rev	Design	Drawn	Chkd	Appd	Description	Date
C	NA	NA	CW	NGB	AS BUILT.	06.06.00
D					TEXT ADDED	06.10.11
E					ZINC DISSOLVER PHR & MMN IMPROVEMENTS	24.02.14

Designed	NH
Drawn	NH
Checked	CW
Approved	NGB
Date	29.03.00
Cad Reference	10265-P3-144

HIMA–SELLA LIMITED © HIMA-SELLA

Title : LOOP DRAWING - INPUTS
ICI SYNETIX SCHEDULE - No.3 AND No.7 PLANTS
FISHER-ROSEMOUNTP.O. No. 99003994

Contract/ Drawing No	C10265H-P3	144	REV	E

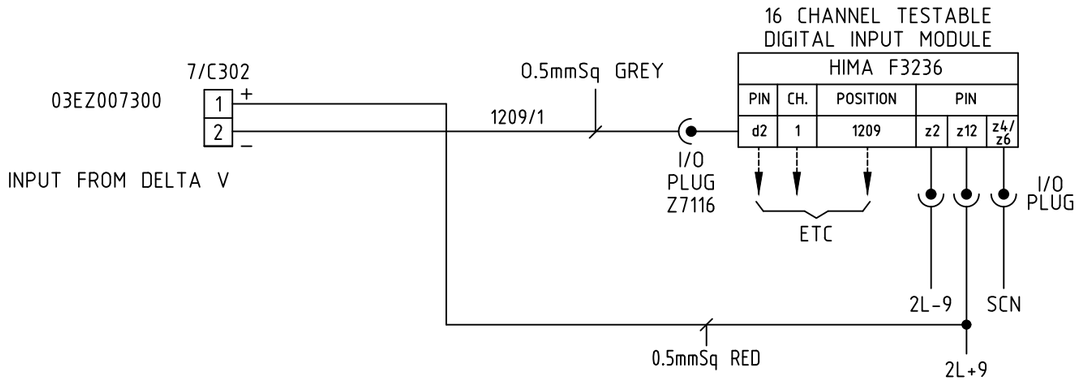

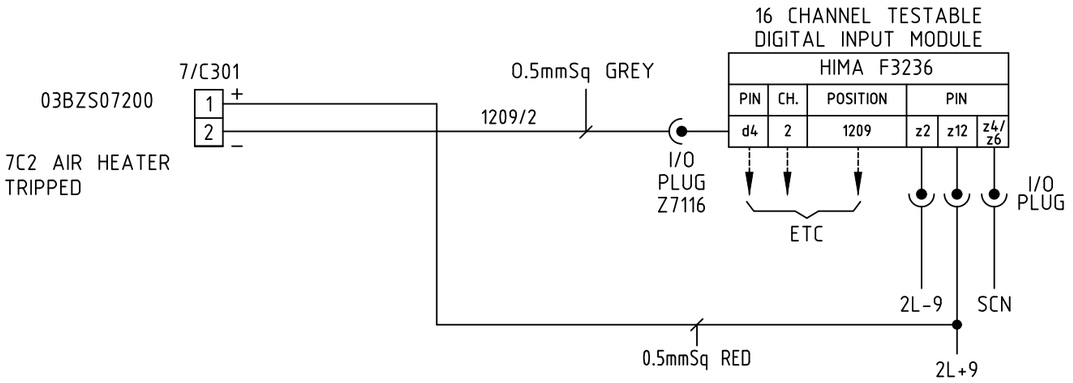

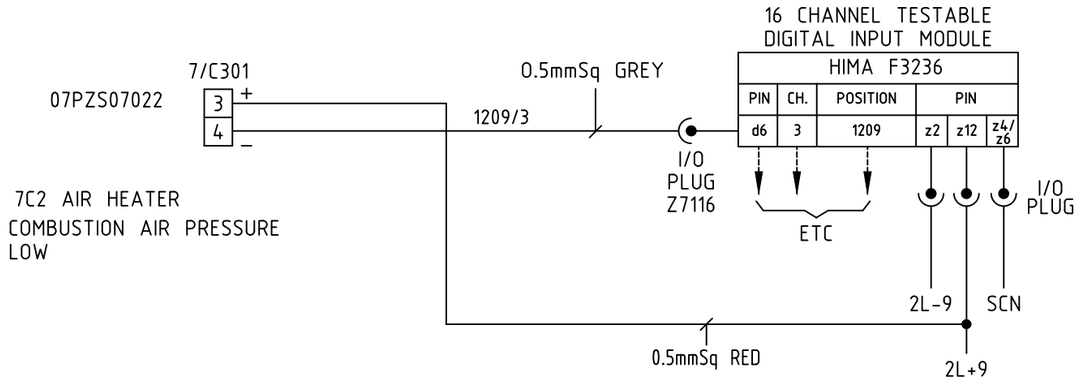

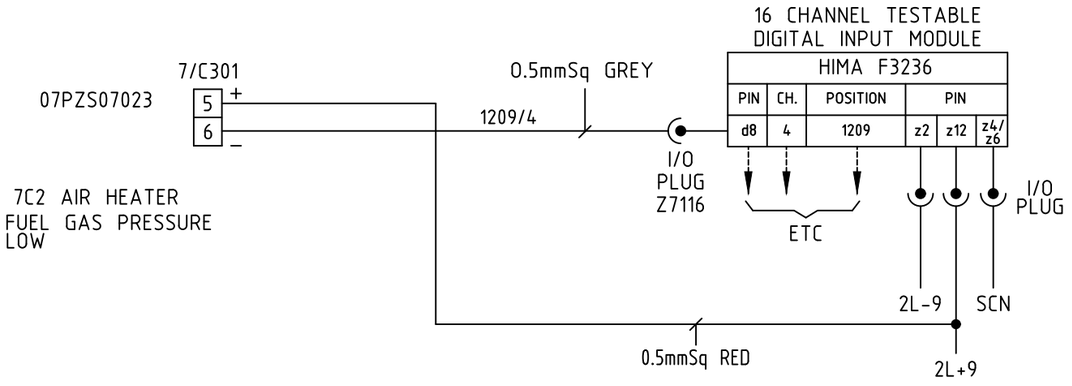

NOTES
1. FIRST TERMINAL OF PAIR SHOULD ALWAYS BE '+' (ASK1 (50mA) ON ANALOGUE INPUTS ONLY).
2. ANALOGUE LOOPS WILL BE WIRED USING SCREENED CABLES WHERE POSSIBLE.
3. ALL WIRING TO BE TRI-RATED.
4. COMPENSATING CABLES FOR TYPE 'K' THERMOCOUPLES WITH COLD JUNCTION.
   COMPENSATION PROVIDED BY THE SIGNAL CONVERTOR WILL BE USED ON ALL TYPE AI4 LOOPS.
5. L- FOR ALL REMOTE ANNUNCIATORS IS DERIVED FROM THE ESD 24Vdc SUPPLY.
6. WIRE No.s ARE DEFINED USING CARD POSITION/CHANNEL NUMBER.

THIS DRAWING IS THE PROPERTY OF HIMA-SELLA LIMITED AND IS LOANED IN CONFIDENCE FOR USE WITH OUR WORK. IT IS NOT TO BE REPRODUCED IN ANY MANNER, SUBMITTED TO OUTSIDE PARTIES FOR EXAMINATION OR USED DIRECTLY OR INDIRECTLY FOR PURPOSES OTHER THAN THOSE FOR WHICH IT WAS FURNISHED WITHOUT WRITTEN CONSENT.

Template Revision – For Office Records Only

REV	AUTH	DATE	CAD TEMPLATE REF.
B	MB	7.4.10	A3-FRAME

Scale on A3 sheet	N/A
Dimensions	N/A

DO NOT STAMP 'MASTER' UNTIL ALL WORK IS FULLY CADDED

Rev	Design	Drawn	Chkd	Appd	Description	Date
C	NH	NH	CW	NGB	AS BUILT.	06.06.00
D					TEXT ADDED	06.10.11

Designed	NH
Drawn	NH
Checked	CW
Approved	NGB
Date	29.03.00
Cad Reference	10265-P3-145

HIMA–SELLA LIMITED © HIMA-SELLA

Title : LOOP DRAWING - INPUTS
ICI SYNETIX SCHEDULE - No.3 AND No.7 PLANTS
FISHER-ROSEMOUNTP.O. No. 99003994

Contract/ Drawing No	C10265H-P3	145	REV	D

50 100 150 200 250 300 350 400

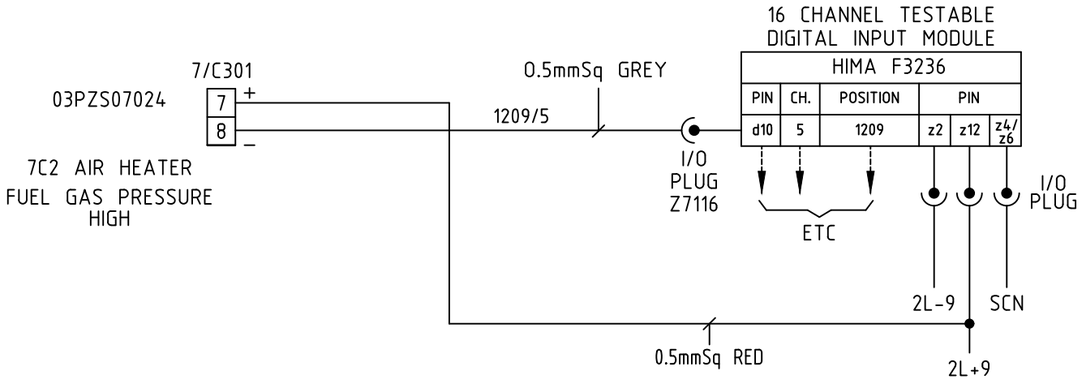

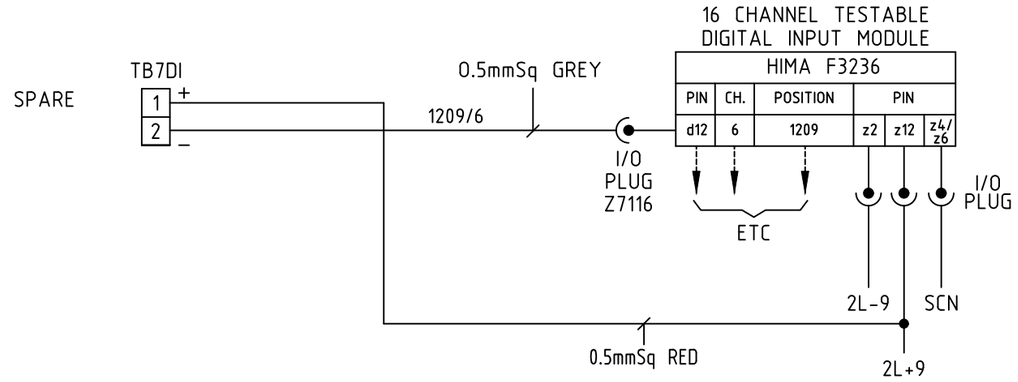

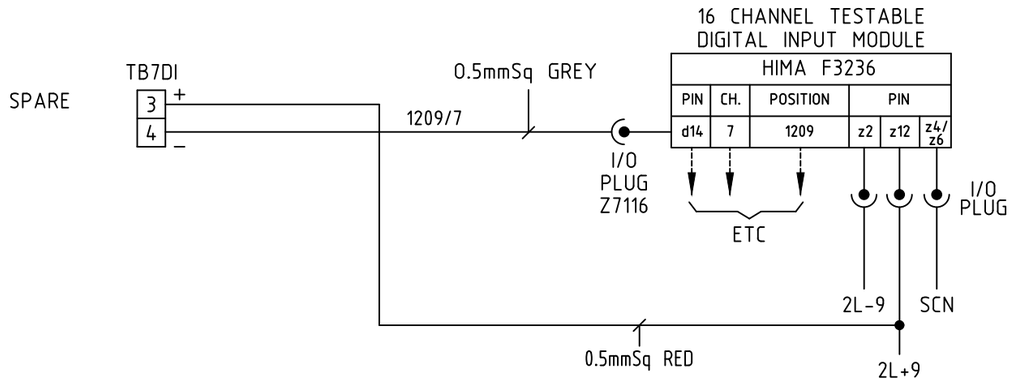

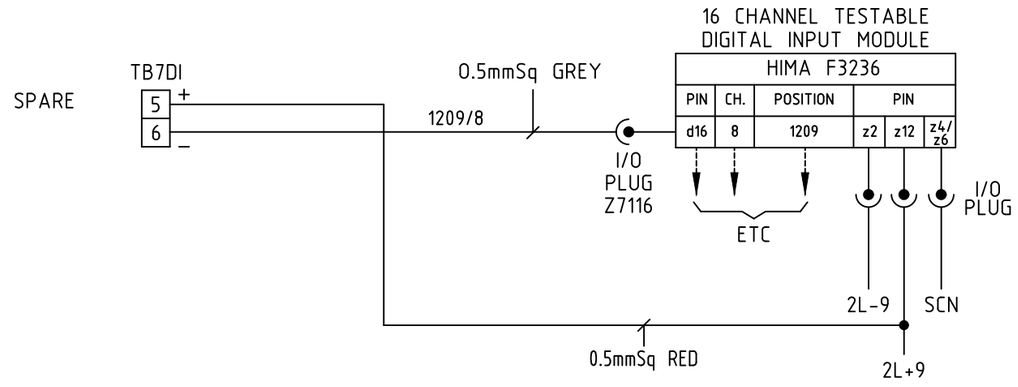

NOTES
1. FIRST TERMINAL OF PAIR SHOULD ALWAYS BE '+' (ASK1 (50mA) ON ANALOGUE INPUTS ONLY).
2. ANALOGUE LOOPS WILL BE WIRED USING SCREENED CABLES WHERE POSSIBLE.
3. ALL WIRING TO BE TRI-RATED.
4. COMPENSATING CABLES FOR TYPE 'K' THERMOCOUPLES WITH COLD JUNCTION.
   COMPENSATION PROVIDED BY THE SIGNAL CONVERTOR WILL BE USED ON ALL TYPE AI4 LOOPS.
5. L- FOR ALL REMOTE ANNUNCIATORS IS DERIVED FROM THE ESD 24Vdc SUPPLY.
6. WIRE No.s ARE DEFINED USING CARD POSITION/CHANNEL NUMBER.

THIS DRAWING IS THE PROPERTY OF HIMA-SELLA LIMITED AND IS LOANED IN CONFIDENCE FOR USE WITH OUR WORK. IT IS NOT TO BE REPRODUCED IN ANY MANNER, SUBMITTED TO OUTSIDE PARTIES FOR EXAMINATION OR USED DIRECTLY OR INDIRECTLY FOR PURPOSES OTHER THAN THOSE FOR WHICH IT WAS FURNISHED WITHOUT WRITTEN CONSENT.

Template Revision – For Office Records Only

REV	AUTH	DATE	CAD TEMPLATE REF.
B	MB	7.4.10	A3-FRAME

Scale on A3 sheet	N/A
Dimensions	N/A

DO NOT STAMP 'MASTER' UNTIL ALL WORK IS FULLY CADDED

Rev	Design	Drawn	Chkd	Appd	Description	Date
C	NH	NH	CW	NGB	AS BUILT.	06.06.00
D					TEXT ADDED	06.10.11

Designed	NH
Drawn	NH
Checked	CW
Approved	NGB
Date	29.03.00
Cad Reference	10265-P3-146

HIMA–SELLA LIMITED © HIMA-SELLA

Title : LOOP DRAWING - INPUTS
ICI SYNETIX SCHEDULE - No.3 AND No.7 PLANTS
FISHER-ROSEMOUNTP.O. No. 99003994

Contract/ Drawing No	C10265H-P3	146	REV	D

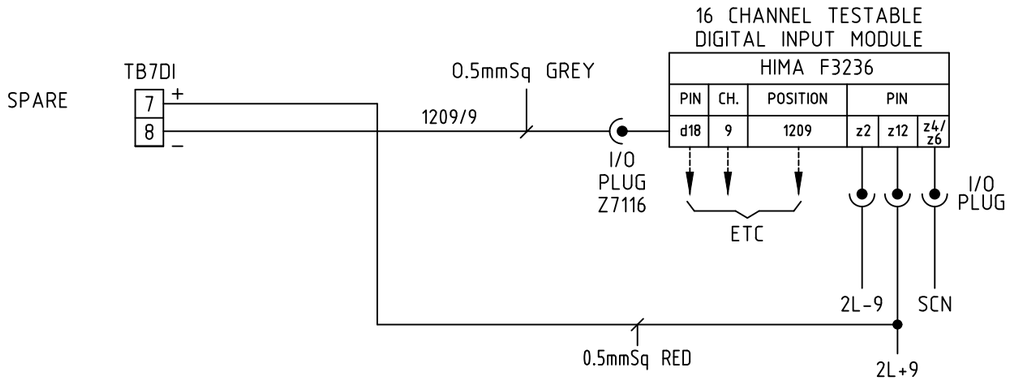

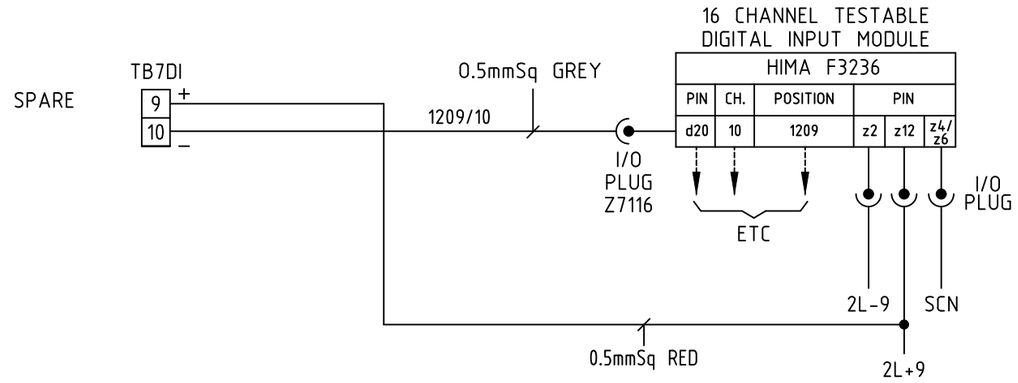

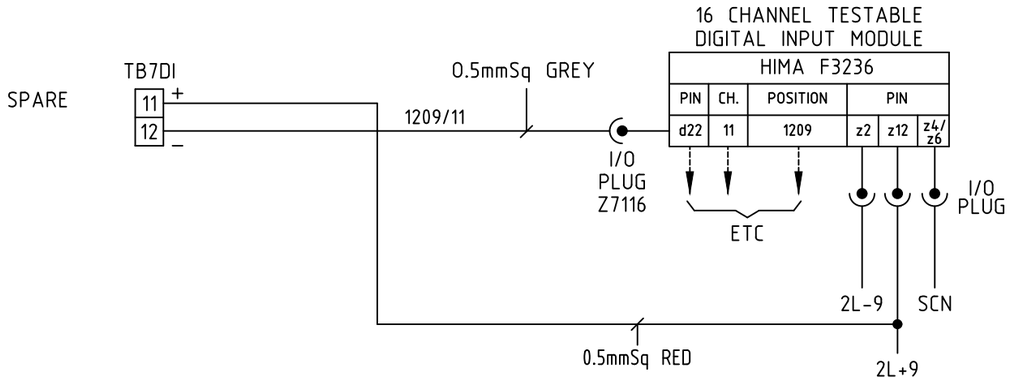

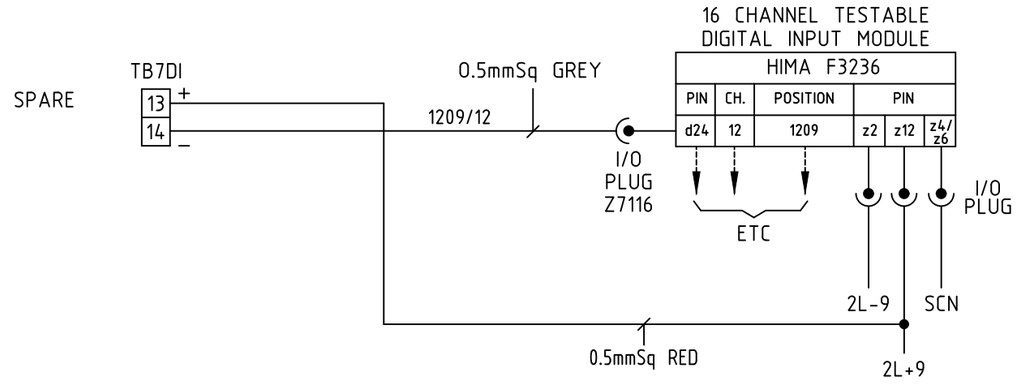

NOTES
1. FIRST TERMINAL OF PAIR SHOULD ALWAYS BE '+' (ASK1 (50mA) ON ANALOGUE INPUTS ONLY).
2. ANALOGUE LOOPS WILL BE WIRED USING SCREENED CABLES WHERE POSSIBLE.
3. ALL WIRING TO BE TRI-RATED.
4. COMPENSATING CABLES FOR TYPE 'K' THERMOCOUPLES WITH COLD JUNCTION.
   COMPENSATION PROVIDED BY THE SIGNAL CONVERTOR WILL BE USED ON ALL TYPE AI4 LOOPS.
5. L- FOR ALL REMOTE ANNUNCIATORS IS DERIVED FROM THE ESD 24Vdc SUPPLY.
6. WIRE No.s ARE DEFINED USING CARD POSITION/CHANNEL NUMBER.

THIS DRAWING IS THE PROPERTY OF HIMA-SELLA LIMITED AND IS LOANED IN CONFIDENCE FOR USE WITH OUR WORK. IT IS NOT TO BE REPRODUCED IN ANY MANNER, SUBMITTED TO OUTSIDE PARTIES FOR EXAMINATION OR USED DIRECTLY OR INDIRECTLY FOR PURPOSES OTHER THAN THOSE FOR WHICH IT WAS FURNISHED WITHOUT WRITTEN CONSENT.

Template Revision – For Office Records Only

REV	AUTH	DATE	CAD TEMPLATE REF.
B	MB	7.4.10	A3-FRAME

Scale on A3 sheet	N/A
Dimensions	N/A

DO NOT STAMP 'MASTER' UNTIL ALL WORK IS FULLY CADDED

Rev	Design	Drawn	Chkd	Appd	Description	Date
C	NH	NH	CW	NGB	AS BUILT.	06.06.00
D					TEXT ADDED	06.10.11

Designed	NH
Drawn	NH
Checked	CW
Approved	NGB
Date	29.03.00
Cad Reference	10265-P3-147

HIMA–SELLA LIMITED © HIMA-SELLA

Title : LOOP DRAWING - INPUTS
ICI SYNETIX SCHEDULE - No.3 AND No.7 PLANTS
FISHER-ROSEMOUNTP.O. No. 99003994

Contract/ Drawing No	C10265H-P3	147	REV	D

50 100 150 200 250 300 350 400

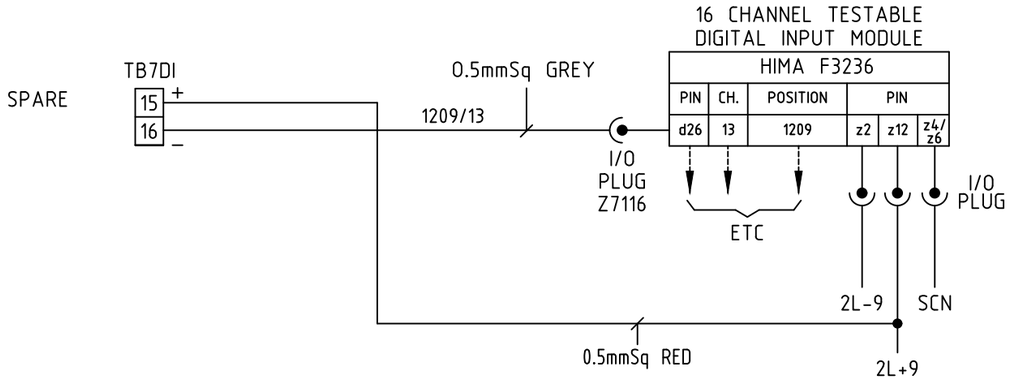

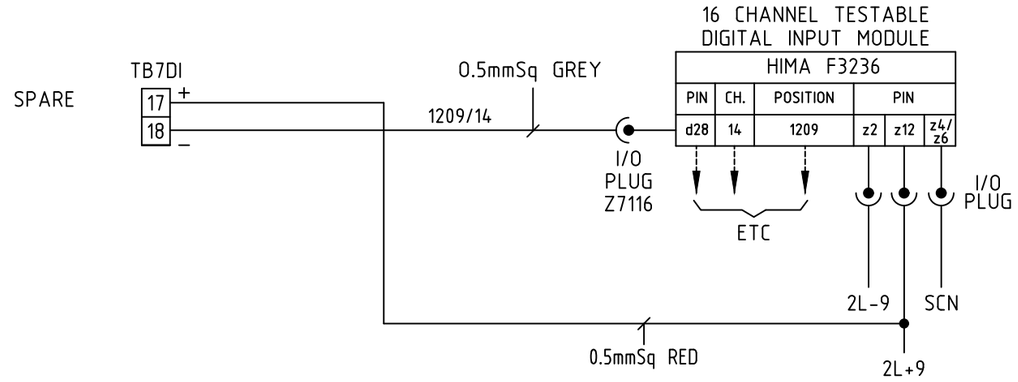

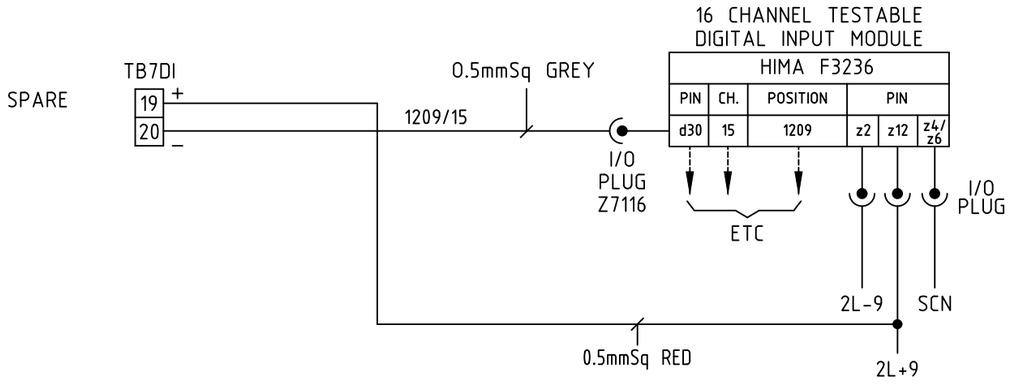

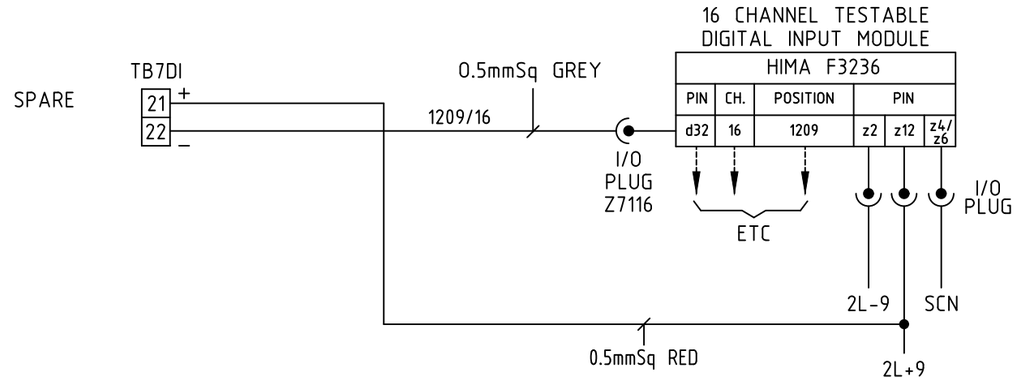

NOTES
1. FIRST TERMINAL OF PAIR SHOULD ALWAYS BE '+' (ASK1 (50mA) ON ANALOGUE INPUTS ONLY).
2. ANALOGUE LOOPS WILL BE WIRED USING SCREENED CABLES WHERE POSSIBLE.
3. ALL WIRING TO BE TRI-RATED.
4. COMPENSATING CABLES FOR TYPE 'K' THERMOCOUPLES WITH COLD JUNCTION.
   COMPENSATION PROVIDED BY THE SIGNAL CONVERTOR WILL BE USED ON ALL TYPE AI4 LOOPS.
5. L- FOR ALL REMOTE ANNUNCIATORS IS DERIVED FROM THE ESD 24Vdc SUPPLY.
6. WIRE No.s ARE DEFINED USING CARD POSITION/CHANNEL NUMBER.

THIS DRAWING IS THE PROPERTY OF HIMA-SELLA LIMITED AND IS LOANED IN CONFIDENCE FOR USE WITH OUR WORK. IT IS NOT TO BE REPRODUCED IN ANY MANNER, SUBMITTED TO OUTSIDE PARTIES FOR EXAMINATION OR USED DIRECTLY OR INDIRECTLY FOR PURPOSES OTHER THAN THOSE FOR WHICH IT WAS FURNISHED WITHOUT WRITTEN CONSENT.

Template Revision – For Office Records Only

REV	AUTH	DATE	CAD TEMPLATE REF.
B	MB	7.4.10	A3-FRAME

Scale on A3 sheet	N/A
Dimensions	N/A

DO NOT STAMP 'MASTER' UNTIL ALL WORK IS FULLY CADDED

Rev	Design	Drawn	Chkd	Appd	Description	Date
C	NH	NH	CW	NGB	AS BUILT.	06.06.00
D	IM		IM		SITE MODS	11.08.11

Designed	NH
Drawn	NH
Checked	CW
Approved	NGB
Date	30.03.00
Cad Reference	10265-P3-148

HIMA–SELLA LIMITED © HIMA-SELLA

Title : LOOP DRAWING - INPUTS
ICI SYNETIX SCHEDULE - No.3 AND No.7 PLANTS
FISHER-ROSEMOUNTP.O. No. 99003994

Contract/ Drawing No	C10265H-P3	148	REV	D

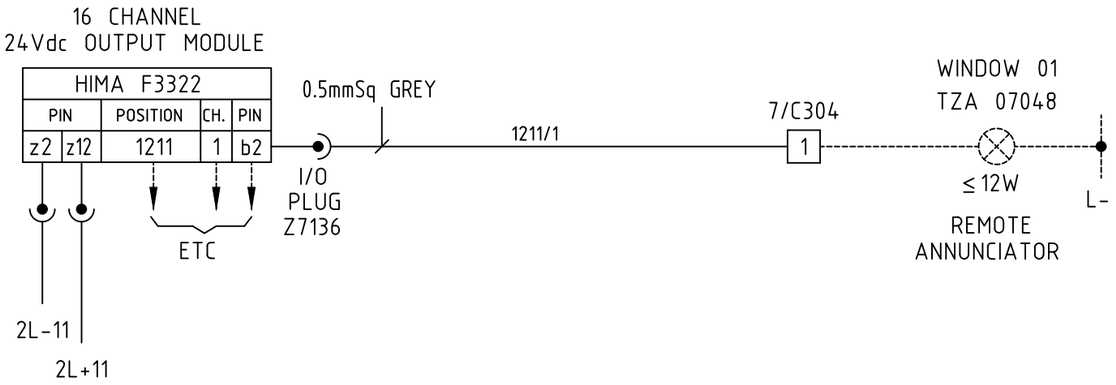

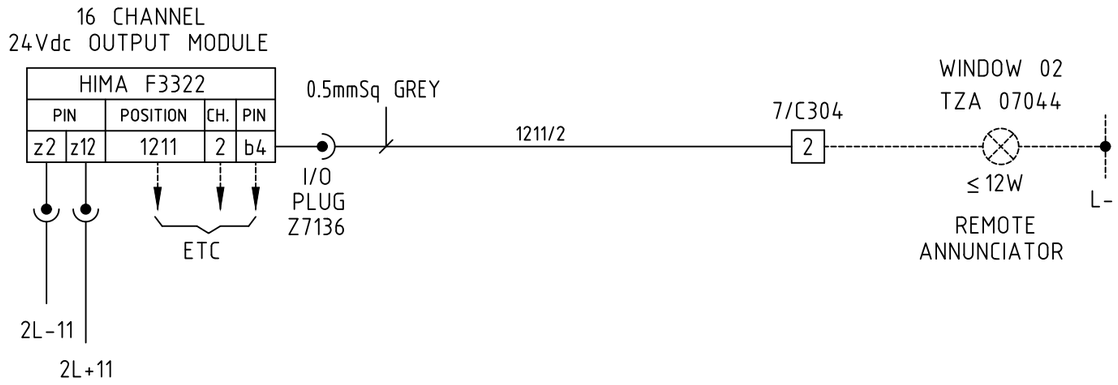

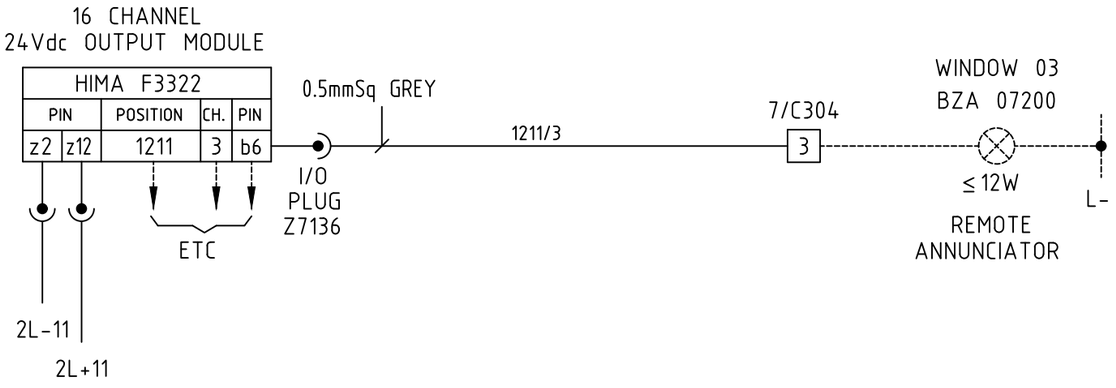

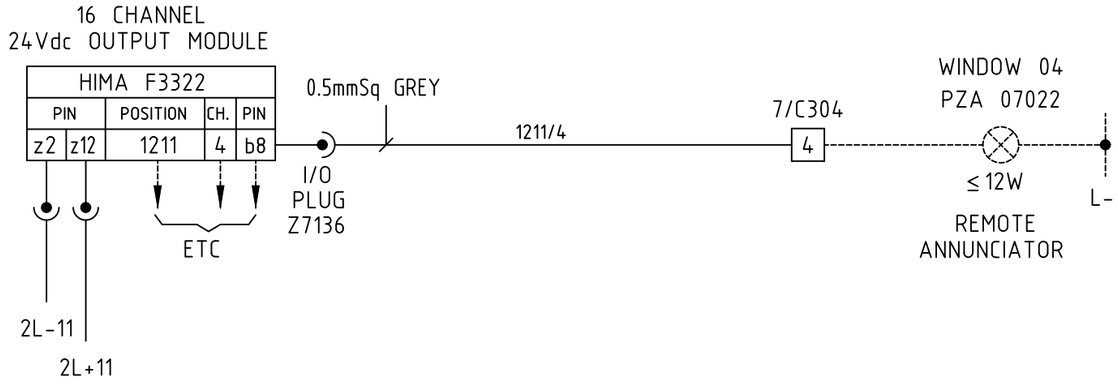

NOTES
1. FIRST TERMINAL OF PAIR SHOULD ALWAYS BE '+' (ASK1 (50mA) ON ANALOGUE INPUTS ONLY).
2. ANALOGUE LOOPS WILL BE WIRED USING SCREENED CABLES WHERE POSSIBLE.
3. ALL WIRING TO BE TRI-RATED.
4. COMPENSATING CABLES FOR TYPE 'K' THERMOCOUPLES WITH COLD JUNCTION.
   COMPENSATION PROVIDED BY THE SIGNAL CONVERTOR WILL BE USED ON ALL TYPE AI4 LOOPS.
5. L- FOR ALL REMOTE ANNUNCIATORS IS DERIVED FROM THE ESD 24Vdc SUPPLY.
6. WIRE No.s ARE DEFINED USING CARD POSITION/CHANNEL NUMBER.

THIS DRAWING IS THE PROPERTY OF HIMA-SELLA LIMITED AND IS LOANED IN CONFIDENCE FOR USE WITH OUR WORK. IT IS NOT TO BE REPRODUCED IN ANY MANNER, SUBMITTED TO OUTSIDE PARTIES FOR EXAMINATION OR USED DIRECTLY OR INDIRECTLY FOR PURPOSES OTHER THAN THOSE FOR WHICH IT WAS FURNISHED WITHOUT WRITTEN CONSENT.

Template Revision – For Office Records Only

REV	AUTH	DATE	CAD TEMPLATE REF.
B	MB	7.4.10	A3-FRAME

Scale on A3 sheet	N/A
Dimensions	N/A

DO NOT STAMP 'MASTER' UNTIL ALL WORK IS FULLY CADDED

Rev	Design	Drawn	Chkd	Appd	Description	Date
C	NH	NH	CW	NGB	AS BUILT.	06.06.00
.					. . .	. .

Designed	NH
Drawn	NH
Checked	CW
Approved	NGB
Date	30.03.00
Cad Reference	10265-P3-153

HIMA–SELLA LIMITED © HIMA-SELLA

Title : LOOP DRAWING - OUTPUTS
ICI SYNETIX SCHEDULE - No.3 AND No.7 PLANTS
FISHER-ROSEMOUNTP.O. No. 99003994

Contract/ Drawing No	C10265H-P3	153	REV	C

50 100 150 200 250 300 350 400

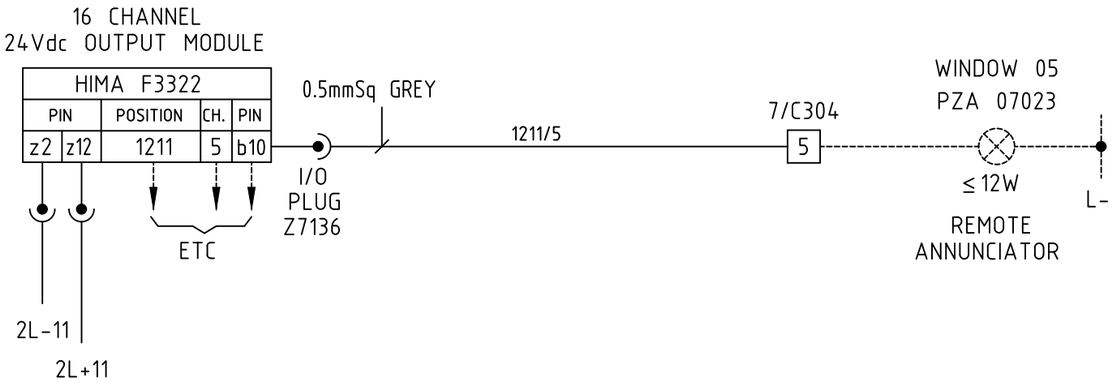

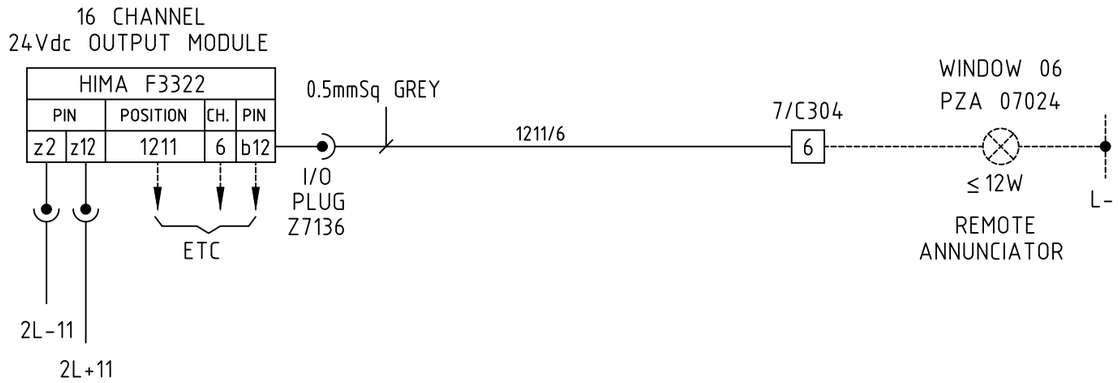

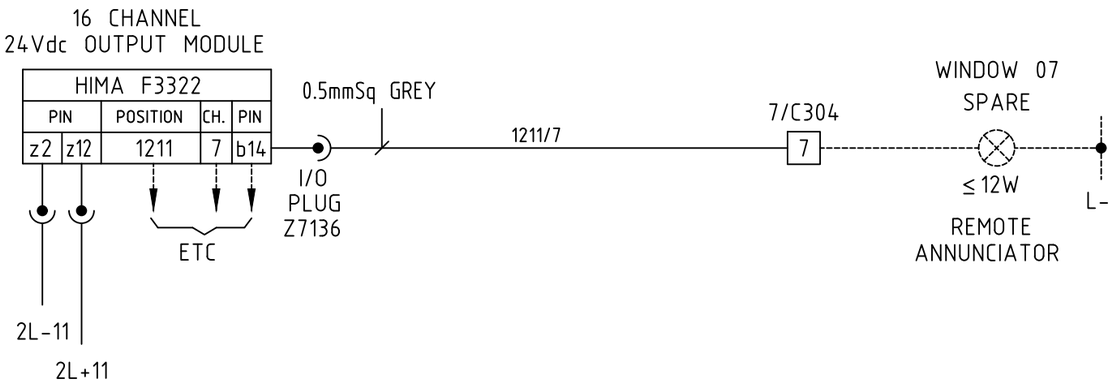

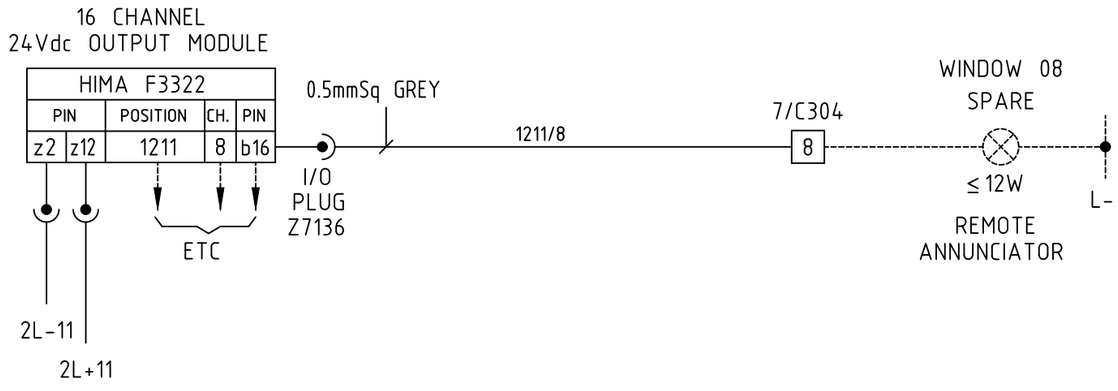

NOTES
1. FIRST TERMINAL OF PAIR SHOULD ALWAYS BE '+' (ASK1 (50mA) ON ANALOGUE INPUTS ONLY).
2. ANALOGUE LOOPS WILL BE WIRED USING SCREENED CABLES WHERE POSSIBLE.
3. ALL WIRING TO BE TRI-RATED.
4. COMPENSATING CABLES FOR TYPE 'K' THERMOCOUPLES WITH COLD JUNCTION.
   COMPENSATION PROVIDED BY THE SIGNAL CONVERTOR WILL BE USED ON ALL TYPE AI4 LOOPS.
5. L- FOR ALL REMOTE ANNUNCIATORS IS DERIVED FROM THE ESD 24Vdc SUPPLY.
6. WIRE No.s ARE DEFINED USING CARD POSITION/CHANNEL NUMBER.

THIS DRAWING IS THE PROPERTY OF HIMA-SELLA LIMITED AND IS LOANED IN CONFIDENCE FOR USE WITH OUR WORK. IT IS NOT TO BE REPRODUCED IN ANY MANNER, SUBMITTED TO OUTSIDE PARTIES FOR EXAMINATION OR USED DIRECTLY OR INDIRECTLY FOR PURPOSES OTHER THAN THOSE FOR WHICH IT WAS FURNISHED WITHOUT WRITTEN CONSENT.

Template Revision – For Office Records Only

REV	AUTH	DATE	CAD TEMPLATE REF.
B	MB	7.4.10	A3-FRAME

Scale on A3 sheet	N/A
Dimensions	N/A

DO NOT STAMP 'MASTER' UNTIL ALL WORK IS FULLY CADDED

Rev	Design	Drawn	Chkd	Appd	Description	Date
C	NH	NH	CW	NGB	AS BUILT.	06.06.00
.					. . .	. .

Designed	NH
Drawn	NH
Checked	CW
Approved	NGB
Date	30.03.00
Cad Reference	10265-P3-154

HIMA–SELLA LIMITED © HIMA-SELLA

Title : LOOP DRAWING - OUTPUTS
ICI SYNETIX SCHEDULE - No.3 AND No.7 PLANTS
FISHER-ROSEMOUNTP.O. No. 99003994

Contract/ Drawing No	C10265H-P3	154	REV	C

50 100 150 200 250 300 350 400

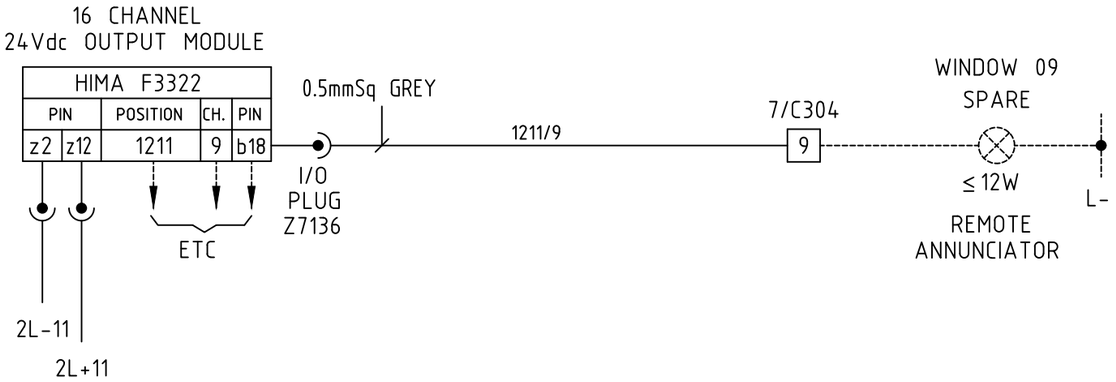

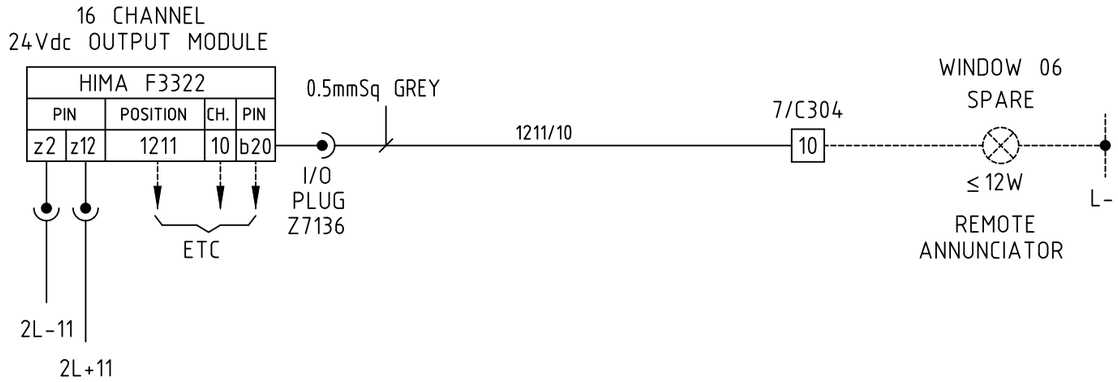

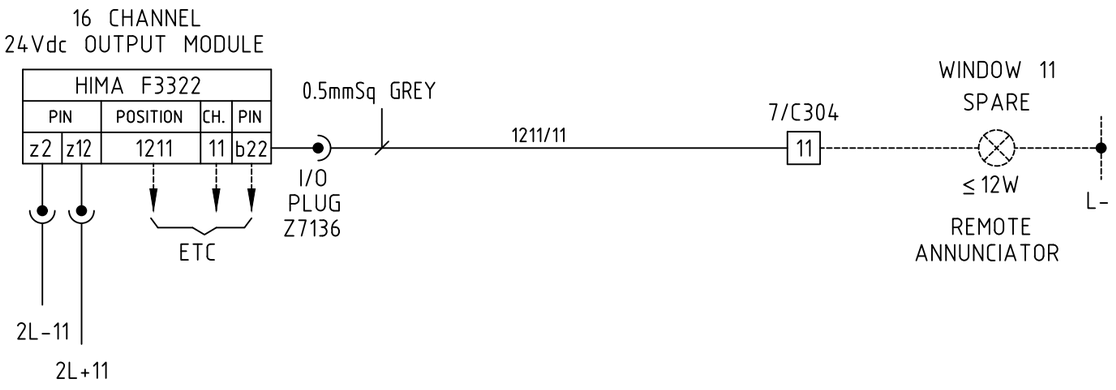

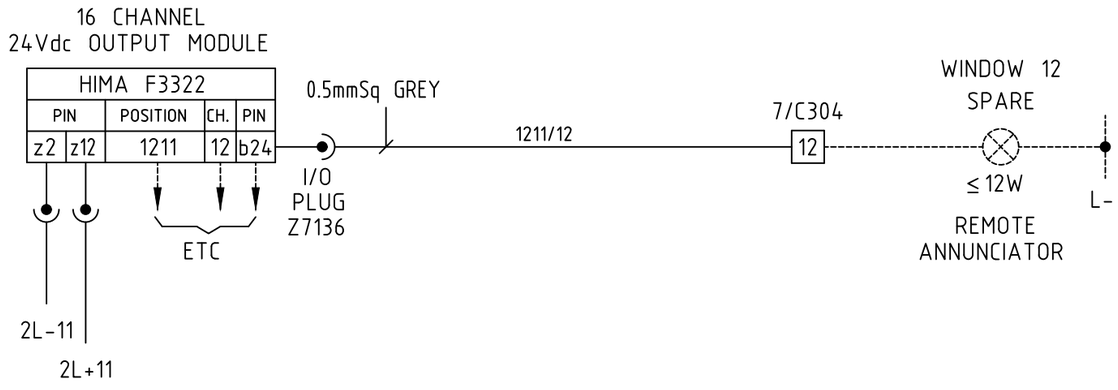

NOTES
1. FIRST TERMINAL OF PAIR SHOULD ALWAYS BE '+' (ASK1 (50mA) ON ANALOGUE INPUTS ONLY).
2. ANALOGUE LOOPS WILL BE WIRED USING SCREENED CABLES WHERE POSSIBLE.
3. ALL WIRING TO BE TRI-RATED.
4. COMPENSATING CABLES FOR TYPE 'K' THERMOCOUPLES WITH COLD JUNCTION.
   COMPENSATION PROVIDED BY THE SIGNAL CONVERTOR WILL BE USED ON ALL TYPE AI4 LOOPS.
5. L- FOR ALL REMOTE ANNUNCIATORS IS DERIVED FROM THE ESD 24Vdc SUPPLY.
6. WIRE No.s ARE DEFINED USING CARD POSITION/CHANNEL NUMBER.

THIS DRAWING IS THE PROPERTY OF HIMA-SELLA LIMITED AND IS LOANED IN CONFIDENCE FOR USE WITH OUR WORK. IT IS NOT TO BE REPRODUCED IN ANY MANNER, SUBMITTED TO OUTSIDE PARTIES FOR EXAMINATION OR USED DIRECTLY OR INDIRECTLY FOR PURPOSES OTHER THAN THOSE FOR WHICH IT WAS FURNISHED WITHOUT WRITTEN CONSENT.

Template Revision – For Office Records Only

REV	AUTH	DATE	CAD TEMPLATE REF.
B	MB	7.4.10	A3-FRAME

Scale on A3 sheet	N/A
Dimensions	N/A

DO NOT STAMP 'MASTER' UNTIL ALL WORK IS FULLY CADDED

Rev	Design	Drawn	Chkd	Appd	Description	Date
C	NH	NH	CW	NGB	AS BUILT.	06.06.00
.					. . .	. .

Designed	NH
Drawn	NH
Checked	CW
Approved	NGB
Date	30.03.00
Cad Reference	10265-P3-155

HIMA–SELLA LIMITED © HIMA-SELLA

Title : LOOP DRAWING - OUTPUTS
ICI SYNETIX SCHEDULE - No.3 AND No.7 PLANTS
FISHER-ROSEMOUNTP.O. No. 99003994

Contract/ Drawing No				
	C10265H-P3	155	REV	C

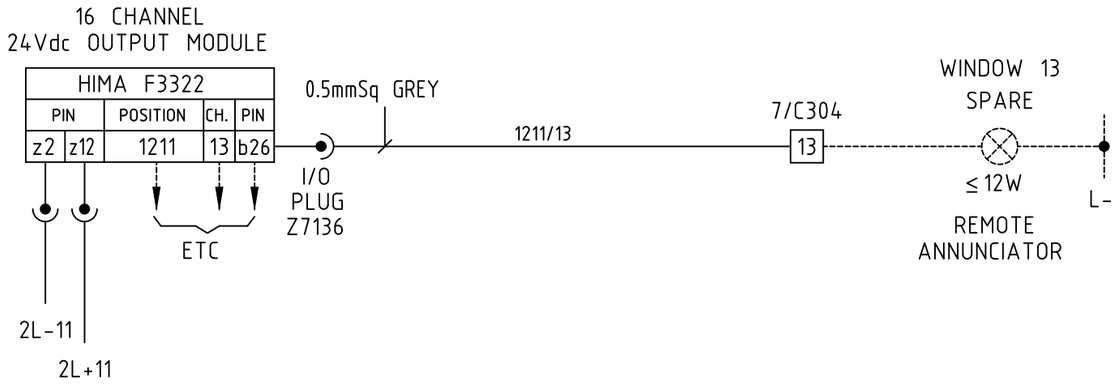

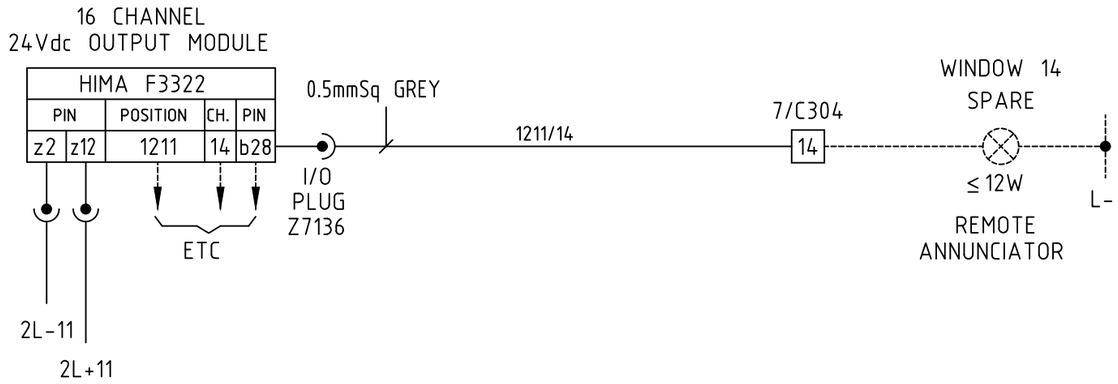

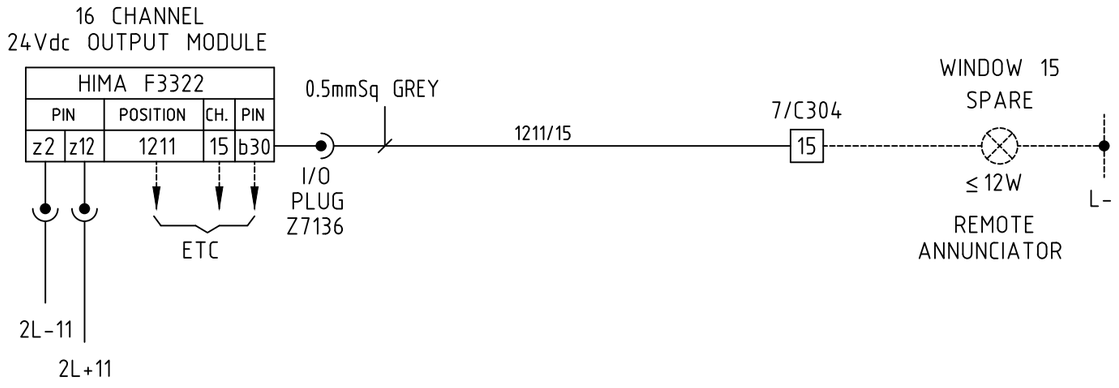

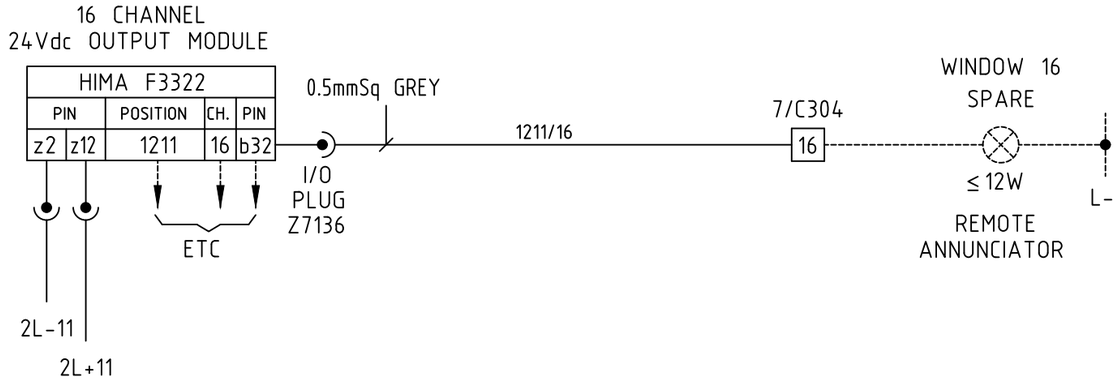

NOTES
1. FIRST TERMINAL OF PAIR SHOULD ALWAYS BE '+' (ASK1 (50mA) ON ANALOGUE INPUTS ONLY).
2. ANALOGUE LOOPS WILL BE WIRED USING SCREENED CABLES WHERE POSSIBLE.
3. ALL WIRING TO BE TRI-RATED.
4. COMPENSATING CABLES FOR TYPE 'K' THERMOCOUPLES WITH COLD JUNCTION.
   COMPENSATION PROVIDED BY THE SIGNAL CONVERTOR WILL BE USED ON ALL TYPE AI4 LOOPS.
5. L- FOR ALL REMOTE ANNUNCIATORS IS DERIVED FROM THE ESD 24Vdc SUPPLY.
6. WIRE No.s ARE DEFINED USING CARD POSITION/CHANNEL NUMBER.

THIS DRAWING IS THE PROPERTY OF HIMA-SELLA LIMITED AND IS LOANED IN CONFIDENCE FOR USE WITH OUR WORK. IT IS NOT TO BE REPRODUCED IN ANY MANNER, SUBMITTED TO OUTSIDE PARTIES FOR EXAMINATION OR USED DIRECTLY OR INDIRECTLY FOR PURPOSES OTHER THAN THOSE FOR WHICH IT WAS FURNISHED WITHOUT WRITTEN CONSENT.

Template Revision – For Office Records Only

REV	AUTH	DATE	CAD TEMPLATE REF.
B	MB	7.4.10	A3-FRAME

Scale on A3 sheet	N/A
Dimensions	N/A

DO NOT STAMP 'MASTER' UNTIL ALL WORK IS FULLY CADDED

Rev	Design	Drawn	Chkd	Appd	Description	Date
C	NH	NH	CW	NGB	AS BUILT.	06.06.00
.					. . .	. .

Designed	NH
Drawn	NH
Checked	CW
Approved	NGB
Date	30.03.00
Cad Reference	10265-P3-156

HIMA–SELLA LIMITED © HIMA-SELLA

Title : LOOP DRAWING - OUTPUTS
ICI SYNETIX SCHEDULE - No.3 AND No.7 PLANTS
FISHER-ROSEMOUNTP.O. No. 99003994

Contract/ Drawing No	C10265H-P3	156	REV	C

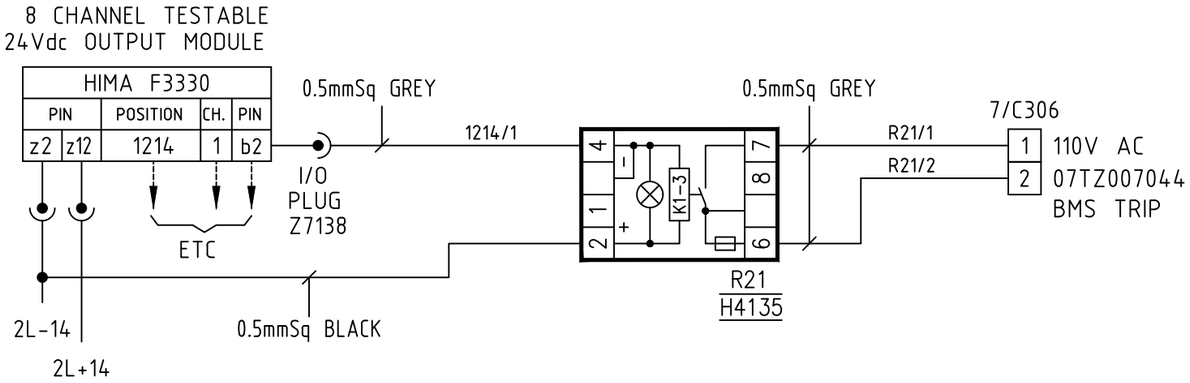

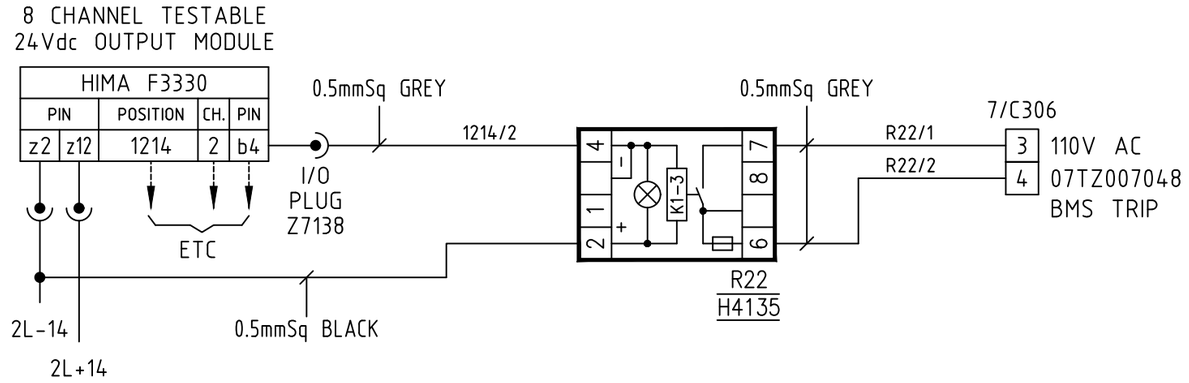

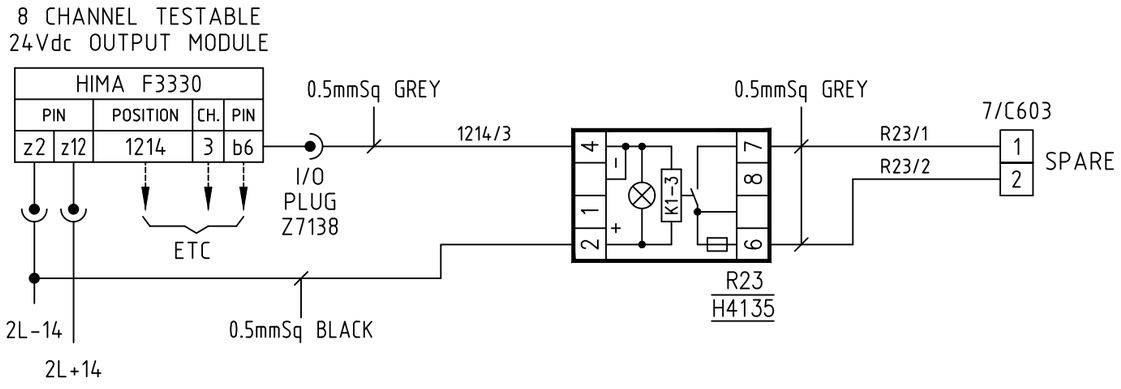

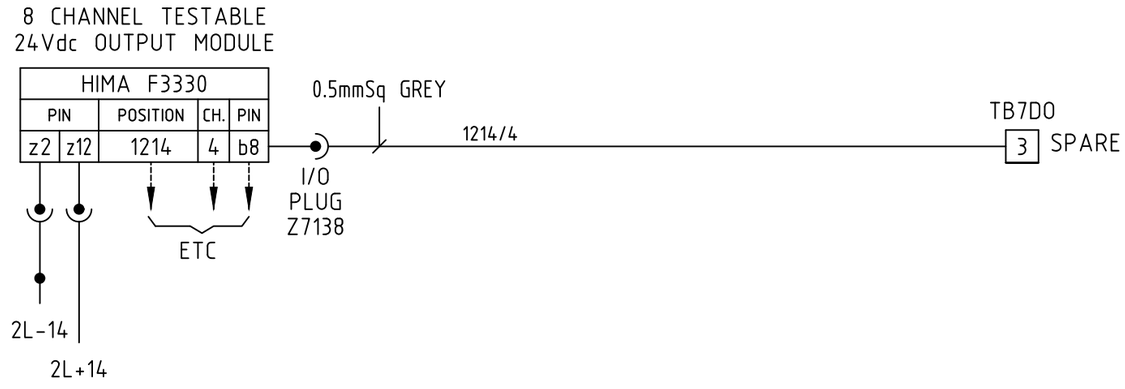

NOTES
1. FIRST TERMINAL OF PAIR SHOULD ALWAYS BE '+' (ASK1 (50mA) ON ANALOGUE INPUTS ONLY).
2. ANALOGUE LOOPS WILL BE WIRED USING SCREENED CABLES WHERE POSSIBLE.
3. ALL WIRING TO BE TRI-RATED.
4. COMPENSATING CABLES FOR TYPE 'K' THERMOCOUPLES WITH COLD JUNCTION.
   COMPENSATION PROVIDED BY THE SIGNAL CONVERTOR WILL BE USED ON ALL TYPE AI4 LOOPS.
5. L- FOR ALL REMOTE ANNUNCIATORS IS DERIVED FROM THE ESD 24Vdc SUPPLY.
6. WIRE No.s ARE DEFINED USING CARD POSITION/CHANNEL NUMBER.

THIS DRAWING IS THE PROPERTY OF HIMA-SELLA LIMITED AND IS LOANED IN CONFIDENCE FOR USE WITH OUR WORK. IT IS NOT TO BE REPRODUCED IN ANY MANNER, SUBMITTED TO OUTSIDE PARTIES FOR EXAMINATION OR USED DIRECTLY OR INDIRECTLY FOR PURPOSES OTHER THAN THOSE FOR WHICH IT WAS FURNISHED WITHOUT WRITTEN CONSENT.

Template Revision – For Office Records Only

REV	AUTH	DATE	CAD TEMPLATE REF.
B	MB	7.4.10	A3-FRAME

Scale on A3 sheet	N/A
Dimensions	N/A

DO NOT STAMP 'MASTER' UNTIL ALL WORK IS FULLY CADDED

Rev	Design	Drawn	Chkd	Appd	Description	Date
C	NH	NH	CW	NGB	AS BUILT.	06.06.00
.					. . .	. .

Designed	NH
Drawn	NH
Checked	CW
Approved	NGB
Date	31.03.00
Cad Reference	10265-P3-165

HIMA–SELLA LIMITED © HIMA-SELLA

Title : LOOP DRAWING - OUTPUTS
ICI SYNETIX SCHEDULE - No.3 AND No.7 PLANTS
FISHER-ROSEMOUNTP.O. No. 99003994

Contract/ Drawing No			REV	
	C10265H-P3	165	REV	C

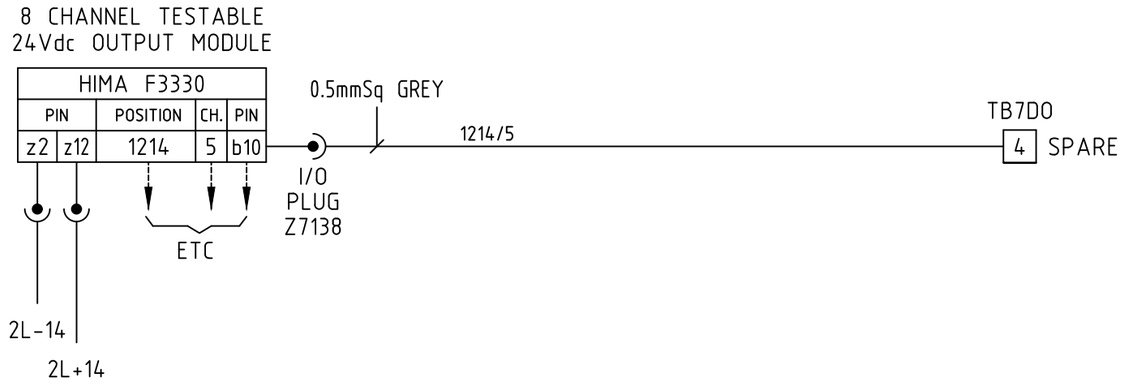

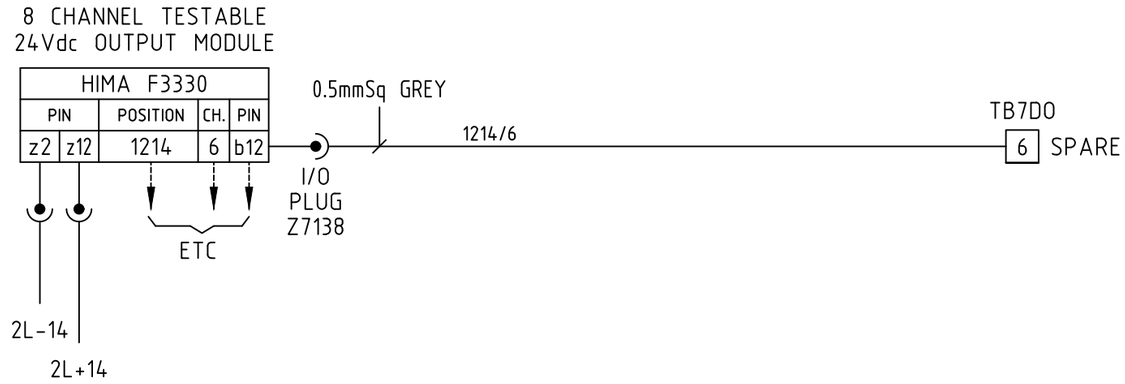

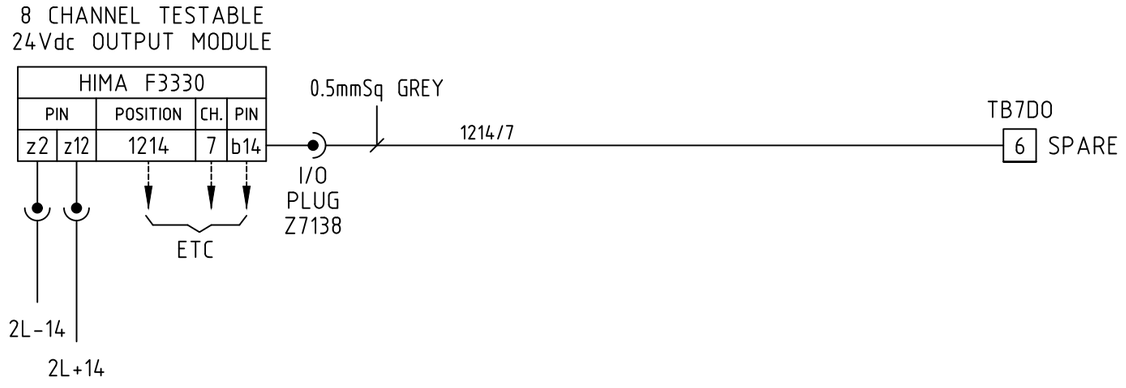

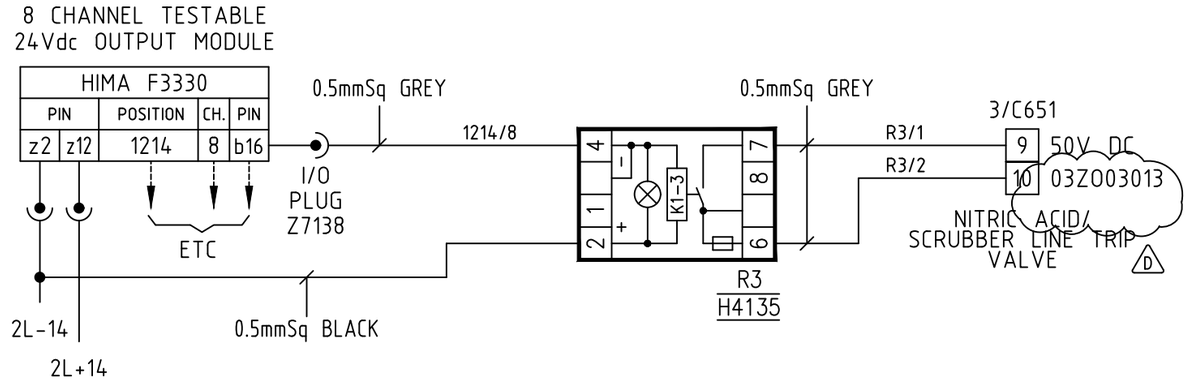

NOTES
1. FIRST TERMINAL OF PAIR SHOULD ALWAYS BE '+' (ASK1 (50mA) ON ANALOGUE INPUTS ONLY).
2. ANALOGUE LOOPS WILL BE WIRED USING SCREENED CABLES WHERE POSSIBLE.
3. ALL WIRING TO BE TRI-RATED.
4. COMPENSATING CABLES FOR TYPE 'K' THERMOCOUPLES WITH COLD JUNCTION.
   COMPENSATION PROVIDED BY THE SIGNAL CONVERTOR WILL BE USED ON ALL TYPE AI4 LOOPS.
5. L- FOR ALL REMOTE ANNUNCIATORS IS DERIVED FROM THE ESD 24Vdc SUPPLY.
6. WIRE No.s ARE DEFINED USING CARD POSITION/CHANNEL NUMBER.

THIS DRAWING IS THE PROPERTY OF HIMA-SELLA LIMITED AND IS LOANED IN CONFIDENCE FOR USE WITH OUR WORK. IT IS NOT TO BE REPRODUCED IN ANY MANNER, SUBMITTED TO OUTSIDE PARTIES FOR EXAMINATION OR USED DIRECTLY OR INDIRECTLY FOR PURPOSES OTHER THAN THOSE FOR WHICH IT WAS FURNISHED WITHOUT WRITTEN CONSENT.

Template Revision – For Office Records Only

REV	AUTH	DATE	CAD TEMPLATE REF.
B	MB	7.4.10	A3-FRAME

Scale on A3 sheet	N/A
Dimensions	N/A

DO NOT STAMP 'MASTER' UNTIL ALL WORK IS FULLY CADDED

Rev	Design	Drawn	Chkd	Appd	Description	Date
C	NH	NH	CW	NGB	AS BUILT.	06.06.00
D	..		..		TEXT CORRECTED	06.10.11

Designed	NH
Drawn	NH
Checked	CW
Approved	NGB
Date	31.03.00
Cad Reference	10265-P3-166

HIMA–SELLA LIMITED © HIMA-SELLA

Title : LOOP DRAWING - OUTPUTS
ICI SYNETIX SCHEDULE - No.3 AND No.7 PLANTS
FISHER-ROSEMOUNTP.O. No. 99003994

Contract/ Drawing No	C10265H-P3	166	REV	D

NON I.S. - ESD TO ANNUNCIATOR SIGNALS

TYPE	CODING: R-S-1-S-1
PE	CABLE NUMBER 3/C652

No.3 PLANT ANNUNCIATOR CABINET

VARELCO BLOCK 3/C652

PIN	TERM	CONTROLS	RED
A	1	HZA 03350 - W12	BLUE
B	2	FZA 03002 - W01	GREEN
C	3	FZA 03004 - W02	YELLOW
D	4	PZT 03923 - W03	WHITE
E	5	FZA 03012 - W14	BLACK
F	6	PDZA 03078 - W11	BROWN
H	7	ES 03738 - W05	VIOLET
J	8	SPARE - W08	ORANGE
K	9	EZS 03412 - W15	PINK
L	10	LZA 03110A - W06	TURQUOISE
M	11	LZA 03110B - W07	GREY
N	12	LZA 03110C - W16	RED/BLUE
P	13	LZA 03110D - W17	GREEN/RED
R	14	SPARE - W09	YELLOW/RED
S	15	SPARE - W10	WHITE/RED
T	16	HZS 03351 - W04	RED/BLACK
U	17	QZS 03164 - W13	RED/BROWN
V	18	PZA 03087 - W18	
W	19		
X	20		
Y	21		
Z	22		
AA	23		
BB	24		
CC	25		
DD	26		
EE	27		
FF	28		
HH	29		
JJ	30		
KK	31		
LL	32		
MM	33		
NN	34		
PP	35		
RR	36		
SS	37		
TT	38		

NON IS CABLE

INTERCONNECTING CABLE	
COLOUR	BLACK
SIZE	18 Core x 0.5
LENGTH	20/50 METRES

No.3 AND No.7 PLANT ESD CABINET

VARELCO BLOCK 3/C652

PIN	TERM	ESD	RED
A	1	1112:b2	BLUE
B	2	1112:b4	GREEN
C	3	1112:b6	YELLOW
D	4	1112:b8	WHITE
E	5	1112:b10	BLACK
F	6	1112:b12	BROWN
H	7	1112:b14	VIOLET
J	8	1112:b16	ORANGE
K	9	1112:b18	PINK
L	10	1112:b20	TURQUOISE
M	11	1112:b22	GREY
N	12	1112:b24	RED/BLUE
P	13	1112:b26	GREEN/RED
R	14	1112:b28	YELLOW/RED
S	15	1112:b30	WHITE/RED
T	16	1112:b32	RED/BLACK
U	17	1113:b2	RED/BROWN
V	18	1113:b4	
W	19		
X	20		
Y	21		
Z	22		
AA	23		
BB	24		
CC	25		
DD	26		
EE	27		
FF	28		
HH	29		
JJ	30		
KK	31		
LL	32		
MM	33		
NN	34		
PP	35		
RR	36		
SS	37		
TT	38		

POLARISING CODE

INSULATOR BODY TYPE: R-G-4-S-3
- MALE P
- FEMALE R

LOCATION SIDE (LARGE DIA):
- GUIDE PIN G
- GUIDE SOCKET S

POSITIONS: 1 THROUGH 6

POSITIONS: 1 THROUGH 6

(THIS EXAMPLE MATES WITH P-S-4-G-3)

THIS DRAWING IS THE PROPERTY OF HIMA-SELLA LIMITED AND IS LOANED IN CONFIDENCE FOR USE WITH OUR WORK. IT IS NOT TO BE REPRODUCED IN ANY MANNER, SUBMITTED TO OUTSIDE PARTIES FOR EXAMINATION OR USED DIRECTLY OR INDIRECTLY FOR PURPOSES OTHER THAN THOSE FOR WHICH IT WAS FURNISHED WITHOUT WRITTEN CONSENT.

Template Revision – For Office Records Only

REV	AUTH	DATE	CAD TEMPLATE REF.
A	PRS	9.2.00	A3-FRAME

Scale on A3 sheet	N/A
Dimensions	N/A

DO NOT STAMP 'MASTER' UNTIL ALL WORK IS FULLY CADDED

Rev	Design	Drawn	Chkd	Appd	Description	Date
P2	NH	NH	MTH	NGB	GENERALLY REVISED INCLUDING CABLE LENGTH.	16.05.00
C	NH	NH	CW	NGB	AS BUILT.	06.06.00
D	IM	JRM	IM	MHS	SITE MODS	11.08.11
E				CT	AS BUILT PER C10265-012V	29.10.14

Designed	NH
Drawn	NH
Checked	CW
Approved	NGB
Date	05.04.00
Cad Reference	
10265-P3-SCHEDULE#NH01	

HIMA–SELLA LIMITED © HIMA-SELLA

Title : ELCO SCHEDULES - ESD/ANNUNCIATOR
ICI SYNETIX ESD SYSTEM - No.3 AND No.7 PLANTS
FISHER-ROSEMOUNT - P.O. No. 99003994

Contract/ Drawing No	C10265H/P3	200	REV	E

NON I.S. - ESD TO ANNUNCIATOR SIGNALS

CODING: R-S-1-S-2
CABLE NUMBER
3/C653

No.3 PLANT ANNUNCIATOR CABINET

VARELCO BLOCK 3/C653

PIN	TERM	CONTROLS	RED
A	1	TZA 03730 - W19	BLUE
B	2	PZA 03734 - W20	GREEN
C	3	YSA 03228 - W21	YELLOW
D	4	YSA 03229 - W22	WHITE
E	5	SPARE - W23	BLACK
F	6	SPARE - W24	BROWN
H	7	SPARE - W26	VIOLET
J	8	SPARE - W27	ORANGE
K	9	TZA 03220 - W25	PINK
L	10	EZA 03446 - W28	TURQUOISE
M	11	EZA 03402 - W29	GREY
N	12	EZA 03449 - W30	RED/BLUE
P	13	GZA 03568 - W31	GREEN/RED
R	14	EZA 03448 - W32	YELLOW/RED
S	15	FZA 03622 - W33	WHITE/RED
T	16	LZA 03613 - W41	RED/BLACK
U	17	TZA 03610A - W35	RED/BROWN
V	18	SPARE - W36	
W	19		
X	20		
Y	21		
Z	22		
AA	23		
BB	24		
CC	25		
DD	26		
EE	27		
FF	28		
HH	29		
JJ	30		
KK	31		
LL	32		
MM	33		
NN	34		
PP	35		
RR	36		
SS	37		
TT	38		

NON IS CABLE

INTERCONNECTING CABLE	
COLOUR	BLACK
SIZE	18 Core x 0.5
LENGTH	20/50 METRES

No.3 AND No.7 PLANT ESD CABINET

VARELCO BLOCK 3/C653

PIN	TERM	ESD	RED
A	1	1113:b6	BLUE
B	2	1113:b8	GREEN
C	3	1113:b10	YELLOW
D	4	1113:b12	WHITE
E	5	1113:b14	BLACK
F	6	1113:b16	BROWN
H	7	1113:b18	VIOLET
J	8	1113:b20	ORANGE
K	9	1113:b22	PINK
L	10	1113:b24	TURQUOISE
M	11	1113:b26	GREY
N	12	1113:b28	RED/BLUE
P	13	1113:b30	GREEN/RED
R	14	1113:b32	YELLOW/RED
S	15	1114:b2	WHITE/RED
T	16	1114:b4	RED/BLACK
U	17	1114:b6	RED/BROWN
V	18	1114:b8	
W	19		
X	20		
Y	21		
Z	22		
AA	23		
BB	24		
CC	25		
DD	26		
EE	27		
FF	28		
HH	29		
JJ	30		
KK	31		
LL	32		
MM	33		
NN	34		
PP	35		
RR	36		
SS	37		
TT	38		

POLARISING CODE

INSULATOR BODY TYPE: R-G-4-S-3
- MALE P
- FEMALE R

LOCATION SIDE (LARGE DIA):
- GUIDE PIN G
- GUIDE SOCKET S

POSITIONS:
- 1 THROUGH 6

LOCATION SIDE (SMALL DIA):
- GUIDE PIN G
- GUIDE SOCKET S

POSITIONS:
- 1 THROUGH 6

(THIS EXAMPLE MATES WITH P-S-4-G-3)

THIS DRAWING IS THE PROPERTY OF HIMA-SELLA LIMITED AND IS LOANED IN CONFIDENCE FOR USE WITH OUR WORK. IT IS NOT TO BE REPRODUCED IN ANY MANNER, SUBMITTED TO OUTSIDE PARTIES FOR EXAMINATION OR USED DIRECTLY OR INDIRECTLY FOR PURPOSES OTHER THAN THOSE FOR WHICH IT WAS FURNISHED WITHOUT WRITTEN CONSENT.

Scale on A3 sheet	N/A
Dimensions	N/A

DO NOT STAMP 'MASTER' UNTIL ALL WORK IS FULLY CADDED

Template Revision – For Office Records Only			
REV	AUTH	DATE	CAD TEMPLATE REF.
A	PRS	9.2.00	A3-FRAME

Rev	Design	Drawn	Chkd	Appd	Description	Date
P2	NH	NH	MTH	NGB	GENERALLY REVISED INCLUDING CABLE LENGTH.	16.05.00
C	NH	NH	CW	NGB	AS BUILT.	06.06.00
D	DP	MW	AD	CT	AS BUILT PER C10265-012V	29.10.14
E	DP	MW	AD	CW	PLANT 3 ESD CABINET MODS C10265033V	28.03.19
F				CT	PLANT 3 ESD CABINET MODS C10265039V	29.01.21

Designed	NH
Drawn	NH
Checked	CW
Approved	NGB
Date	05.04.00
Cad Reference	10265-P3-SCHEDULE#NH0

HIMA–SELLA LIMITED © HIMA-SELLA

Title : ELCO SCHEDULES - ESD/ANNUNCIATOR
ICI SYNETIX ESD SYSTEM - No.3 AND No.7 PLANTS
FISHER-ROSEMOUNT - P.O. No. 99003994

Contract/ Drawing No	C10265H/P3	201	REV	F

50 100 150 200 250 300 350 400

NON I.S. - ESD TO ANNUNCIATOR SIGNALS

TYPE	CODING: R-S-1-S-3
	CABLE NUMBER
	3/C656

No.3 PLANT ANNUNCIATOR CABINET

VARELCO BLOCK 3/C656

PIN	TERM	CONTROLS	RED
A	1	SPARE - W37	
B	2	LZA 03610B - W39	BLUE
C	3	LZA 03609B - W40	GREEN
D	4	FZA 03647 - W34	YELLOW
E	5	SPARE - W42	WHITE
F	6	LZA 03148 - W38	BLACK
H	7	LZS 03615 - W43	BROWN
J	8	EZS 03344 - W44	VIOLET
K	9	LZA 03691 - W45	ORANGE
L	10	FZA 03007 - W46	PINK
M	11	FZA 03008 - W47	TURQUOISE
N	12	FZA 03010 - W48	GREY
P	13	SIL	RED/BLUE
R	14	ACK	GREEN/RED
S	15	RST	YELLOW/RED
T	16	CCT	WHITE/RED
U	17	LPT	RED/BLACK
V	18	ANNUN/0V	RED/BROWN
W	19		
X	20		
Y	21		
Z	22		
AA	23		
BB	24		
CC	25		
DD	26		
EE	27		
FF	28		
HH	29		
JJ	30		
KK	31		
LL	32		
MM	33		
NN	34		
PP	35		
RR	36		
SS	37		
TT	38		

NON IS CABLE

INTERCONNECTING CABLE	
COLOUR	BLACK
SIZE	18 Core x 0.5
LENGTH	20/50 METRES

No.3 AND No.7 PLANT ESD CABINET

VARELCO BLOCK 3/C656

PIN	TERM	ESD	RED
A	1	1114:b10	
B	2	1114:b12	BLUE
C	3	1114:b14	GREEN
D	4	1114:b16	YELLOW
E	5	1114:b18	WHITE
F	6	1114:b20	BLACK
H	7	1114:b22	BROWN
J	8	1114:b24	VIOLET
K	9	1114:b26	ORANGE
L	10	1114:b28	PINK
M	11	1114:b30	TURQUOISE
N	12	1114:b32	GREY
P	13	3/C654:20	RED/BLUE
R	14	3/C654:21	GREEN/RED
S	15	3/C654:22	YELLOW/RED
T	16	3/C654:23	WHITE/RED
U	17	3/C654:24	RED/BLACK
V	18	3/C654:25	RED/BROWN
W	19		
X	20		
Y	21		
Z	22		
AA	23		
BB	24		
CC	25		
DD	26		
EE	27		
FF	28		
HH	29		
JJ	30		
KK	31		
LL	32		
MM	33		
NN	34		
PP	35		
RR	36		
SS	37		
TT	38		

POLARISING CODE

INSULATOR BODY TYPE: R-G-4-S-3
- MALE P
- FEMALE R

LOCATION SIDE (LARGE DIA):
- GUIDE PIN G
- GUIDE SOCKET S

POSITIONS:
- 1 THROUGH 6

LOCATION SIDE (SMALL DIA):
- GUIDE PIN G
- GUIDE SOCKET S

POSITIONS:
- 1 THROUGH 6

(THIS EXAMPLE MATES WITH P-S-4-G-3)

THIS DRAWING IS THE PROPERTY OF HIMA-SELLA LIMITED AND IS LOANED IN CONFIDENCE FOR USE WITH OUR WORK. IT IS NOT TO BE REPRODUCED IN ANY MANNER, SUBMITTED TO OUTSIDE PARTIES FOR EXAMINATION OR USED DIRECTLY OR INDIRECTLY FOR PURPOSES OTHER THAN THOSE FOR WHICH IT WAS FURNISHED WITHOUT WRITTEN CONSENT.

Scale on A3 sheet	N/A
Dimensions	N/A

DO NOT STAMP 'MASTER' UNTIL ALL WORK IS FULLY CADDED

Template Revision – For Office Records Only

REV	AUTH	DATE	CAD TEMPLATE REF.
A	PRS	9.2.00	A3-FRAME

Rev	Design	Drawn	Chkd	Appd	Description	Date
P2	NH	NH	MTH	NGB	GENERALLY REVISED INCLUDING CABLE LENGTH.	16.05.00
C	NH	NH	CW	NGB	AS BUILT.	06.06.00
D	CP	EJC	CW	NGB	SITE MODS	15.09.00
E	DP	MW	AD	CT	AS BUILT PER C10265-012V	29.10.14
F				CW	MODS TO 3 PLANT ESD SYSTEM AS PER C10265-013V	26.03.19

Designed	NH
Drawn	NH
Checked	CW
Approved	NGB
Date	05.04.00
Cad Reference	10265-P3-SCHEDULE#NH0

HIMA–SELLA LIMITED © HIMA-SELLA

Title : ELCO SCHEDULES - ESD/ANNUNCIATOR
ICI SYNETIX ESD SYSTEM - No.3 AND No.7 PLANTS
FISHER-ROSEMOUNT - P.O. No. 99003994

Contract/ Drawing No	C10265H/P3	202	REV	F

NON I.S. - ESD TO OPERATORS CONSOLE

TYPE	CODING: R-S-1-S-4
	CABLE NUMBER
	3/C654

No.3 PLANT CONTROL PLATE

VARELCO BLOCK 3/C654

PIN	TERM	CONTROLS	RED
A	1	03HZS03351B	BLUE
B	2	03HZS03351A	GREEN
C	3	03HZS03110	YELLOW
D	4	03HZS03350	WHITE
E	5	SPARE	BLACK
F	6	03HS03858 (TS)	BROWN
H	7	SPARE	VIOLET
J	8	03HZS03354	ORANGE
K	9	SPARE	PINK
L	10	SPARE	TURQUOISE
M	11	1L+7	GREY
N	12	03HZS03355	RED/BLUE
P	13	03HZS03576	GREEN/RED
R	14	03HZS03615A	YELLOW/RED
S	15	03HZS03615B	WHITE/RED
T	16	1L+8	RED/BLACK
U	17	SPARE	RED/BROWN
V	18	SPARE	YELL/BLUE
W	19	SPARE	WHITE/BLUE
X	20	SIL	BLUE/BLACK
Y	21	ACK	ORANGE/BLUE
Z	22	RST	YELLOW/GRN
AA	23	CCT	WHITE/GREEN
BB	24	LPT	ORANGE/GRN
CC	25	ANNUN/0V	
DD	26		
EE	27		
FF	28		
HH	29		
JJ	30		
KK	31		
LL	32		
MM	33		
NN	34		
PP	35		
RR	36		
SS	37		
TT	38		

NON IS CABLE

INTERCONNECTING CABLE	
COLOUR	BLACK
SIZE	25 Core x 0.5
LENGTH	20/50 METRES

No.3 AND No.7 PLANT ESD CABINET

VARELCO BLOCK 3/C654

PIN	TERM	ESD	RED
A	1	1107:d14	BLUE
B	2	1107:d12	GREEN
C	3	1107:d10	YELLOW
D	4	1107:d2	WHITE
E	5	1107:d20	BLACK
F	6	1107:d16	BROWN
H	7	1107:d18	VIOLET
J	8	1107:d4	ORANGE
K	9	SPARE	PINK
L	10	SPARE	TURQUOISE
M	11	1L+7	GREY
N	12	1108:d14	RED/BLUE
P	13	1108:d16	GREEN/RED
R	14	1108:d10	YELLOW/RED
S	15	1108:d12	WHITE/RED
T	16	1L+8	RED/BLACK
U	17	SPARE	RED/BROWN
V	18	SPARE	YELL/BLUE
W	19	SPARE	WHITE/BLUE
X	20	3/C656:13	BLUE/BLACK
Y	21	3/C656:14	ORANGE/BLUE
Z	22	3/C656:15	YELLOW/GRN
AA	23	3/C656:16	WHITE/GREEN
BB	24	3/C656:17	ORANGE/GRN
CC	25	3/C656:18	
DD	26		
EE	27		
FF	28		
HH	29		
JJ	30		
KK	31		
LL	32		
MM	33		
NN	34		
PP	35		
RR	36		
SS	37		
TT	38		

POLARISING CODE

INSULATOR BODY TYPE: R-G-4-S-3
- MALE P
- FEMALE R

LOCATION SIDE (LARGE DIA):
- GUIDE PIN G
- GUIDE SOCKET S

POSITIONS:
- 1 THROUGH 6

LOCATION SIDE (SMALL DIA):
- GUIDE PIN G
- GUIDE SOCKET S

POSITIONS:
- 1 THROUGH 6

(THIS EXAMPLE MATES WITH P-S-4-G-3)

THIS DRAWING IS THE PROPERTY OF HIMA-SELLA LIMITED AND IS LOANED IN CONFIDENCE FOR USE WITH OUR WORK. IT IS NOT TO BE REPRODUCED IN ANY MANNER, SUBMITTED TO OUTSIDE PARTIES FOR EXAMINATION OR USED DIRECTLY OR INDIRECTLY FOR PURPOSES OTHER THAN THOSE FOR WHICH IT WAS FURNISHED WITHOUT WRITTEN CONSENT.

Scale on A3 sheet	N/A
Dimensions	N/A

Template Revision – For Office Records Only			
REV	AUTH	DATE	CAD TEMPLATE REF.
A	PRS	9.2.00	A3-FRAME

DO NOT STAMP 'MASTER' UNTIL ALL WORK IS FULLY CADDED

Rev	Design	Drawn	Chkd	Appd	Description	Date
P2	NH	NH	MTH	NGB	GENERALLY REVISED INCLUDING CABLE LENGTH.	16.05.00
C	NH	NH	CW	NGB	AS BUILT.	06.06.00
D	CP	EJC	CW	NGB	SITE MODS	15.09.00
E	DP	MW	AD	CW	PLANT 3 ESD CABINET MODS C10265033V	28.03.19
F				CT	PLANT 3 ESD CABINET MODS C10265039V	29.01.21

Designed	NH
Drawn	NH
Checked	CW
Approved	NGB
Date	05.04.00
Cad Reference	10265-P3-SCHEDULE#NH0

HIMA–SELLA LIMITED © HIMA-SELLA

Title : ELCO SCHEDULES - ESD/OPERATORS CONSOLE
ICI SYNETIX ESD SYSTEM - No.3 AND No.7 PLANTS
FISHER-ROSEMOUNT - P.O. No. 99003994

Contract/ Drawing No	C10265H/P3	203	REV	F

NON I.S. - ESD TO OPERATORS CONSOLE

No.7 PLANT ANNUNCIATOR CABINET

TERMINAL BLOCK 7/C303

TERM	CONTROLS
1	PELLET SELECTION No.3 OR No.4
2	PELLET SELECTION No.3 OR No.4
3	PELLET SELECTION No.3 OR No.4
4	RESET RSD & CHAIN SENSORS
5	RESET RSD & CHAIN SENSORS
6	RESET METAL DISTORTION TRIP 7T15
7	RESET METAL DISTORTION TRIP 7T15
8	LOCKOUT RESET
9	LOCKOUT RESET
10	BURNER - OFF ON
11	BURNER - OFF ON
12	BURNER - NORMAL O'RIDE
13	BURNER - NORMAL O'RIDE
14	FV 7002 - OPEN CLOSE
15	FV 7002 - OPEN CLOSE
16	FV 7003 - OPEN CLOSE
17	FV 7003 - OPEN CLOSE
18	FLAME SIGNAL METER
19	FLAME SIGNAL METER
20	LOCKOUT RESET LAMP
21	LOCKOUT RESET LAMP
22	
23	
24	
25	
26	
27	

7/C303
NON IS CABLE
SUPPLIED BY CLIENT

No.3 AND No.7 PLANT ESD CABINET

TERMINAL BLOCK 7/C303

TERM	ESD
1	
2	
3	
4	
5	
6	
7	
8	
9	
10	
11	
12	
13	
14	
15	
16	
17	
18	
19	
20	
21	
22	
23	
24	
25	
26	
27	

THIS DRAWING IS THE PROPERTY OF HIMA-SELLA LIMITED AND IS LOANED IN CONFIDENCE FOR USE WITH OUR WORK. IT IS NOT TO BE REPRODUCED IN ANY MANNER, SUBMITTED TO OUTSIDE PARTIES FOR EXAMINATION OR USED DIRECTLY OR INDIRECTLY FOR PURPOSES OTHER THAN THOSE FOR WHICH IT WAS FURNISHED WITHOUT WRITTEN CONSENT.

Template Revision – For Office Records Only

REV	AUTH	DATE	CAD TEMPLATE REF.
A	PRS	9.2.00	A3-FRAME

Scale on A3 sheet	N/A
Dimensions	N/A

DO NOT STAMP 'MASTER' UNTIL ALL WORK IS FULLY CADDED

Rev	Design	Drawn	Chkd	Appd	Description	Date
P2	NH	NH	CW	NGB	GENERALLY REVISED	16.05.00
C	NH	NH	CW	NGB	AS BUILT.	06.06.00

Designed	NH
Drawn	NH
Checked	CW
Approved	NGB
Date	28.04.00
Cad Reference	
10265-P3-SCHEDULE#NH01	

HIMA–SELLA LIMITED © HIMA-SELLA

Title : ELCO SCHEDULES - ESD/OPERATORS CONSOLE
ICI SYNETIX ESD SYSTEM - No.3 AND No.7 PLANTS
FISHER-ROSEMOUNT - P.O. No. 99003994

Contract/ Drawing No	C10265H/P3	204	REV	C

NON I.S. - ESD TO OPERATORS CONSOLE

No.7 PLANT ANNUNCIATOR CABINET

TERMINAL BLOCK 7/C304

TERM	ANNUN
1	TZA 07048 - W01
2	TZA 07044 - W02
3	BZA 07200 - W03
4	PZA 07022 - W04
5	PZA 07023 - W05
6	PZA 07024 - W06
7	SPARE - W07
8	SPARE - W08
9	SPARE - W09
10	SPARE - W10
11	SPARE - W11
12	SPARE - W12
13	SPARE - W13
14	SPARE - W14
15	SPARE - W15
16	SPARE - W16
17	
18	
19	
20	
21	
22	
23	
24	
25	
26	
27	

7/C304
NON IS CABLE
SUPPLIED BY CLIENT

No.3 AND No.7 PLANT ESD CABINET

TERMINAL BLOCK 7/C304

TERM	ESD
1	1211:b2
2	1211:b4
3	1211:b6
4	1211:b8
5	1211:b10
6	1211:b12
7	1211:b14
8	1211:b16
9	1211:b18
10	1211:b20
11	1211:b22
12	1211:b24
13	1211:b26
14	1211:b28
15	1211:b30
16	1211:b32
17	
18	
19	
20	
21	
22	
23	
24	
25	
26	
27	

THIS DRAWING IS THE PROPERTY OF HIMA-SELLA LIMITED AND IS LOANED IN CONFIDENCE FOR USE WITH OUR WORK. IT IS NOT TO BE REPRODUCED IN ANY MANNER, SUBMITTED TO OUTSIDE PARTIES FOR EXAMINATION OR USED DIRECTLY OR INDIRECTLY FOR PURPOSES OTHER THAN THOSE FOR WHICH IT WAS FURNISHED WITHOUT WRITTEN CONSENT.

Template Revision – For Office Records Only

REV	AUTH	DATE	CAD TEMPLATE REF.
A	PRS	9.2.00	A3-FRAME

Scale on A3 sheet	N/A
Dimensions	N/A

DO NOT STAMP 'MASTER' UNTIL ALL WORK IS FULLY CADDED

Rev	Design	Drawn	Chkd	Appd	Description	Date
P2	NH	NH	CW	NGB	GENERALLY REVISED	16.05.00
C	NH	NH	CW	NGB	AS BUILT.	06.06.00

Designed	NH
Drawn	NH
Checked	CW
Approved	NGB
Date	28.04.00
Cad Reference	
10265-P3-SCHEDULE#NH01	

HIMA–SELLA LIMITED © HIMA-SELLA

Title : ELCO SCHEDULES - ESD/OPERATORS CONSOLE
ICI SYNETIX ESD SYSTEM - No.3 AND No.7 PLANTS
FISHER-ROSEMOUNT - P.O. No. 99003994

Contract/ Drawing No	C10265H/P3	205	REV	C

50 100 150 200 250 300 350 400

NON I.S. - ESD TO OPERATORS CONSOLE

TYPE	CODING: R-S-1-S-4
	CABLE NUMBER
	3/C737

No.3 AND No.7 PLANT CONTROL PLATE

VARELCO BLOCK 3/C737

PIN	TERM	CONTROLS
A	1	EZA 03713 - W49
B	2	IZT 03715 - W50
C	3	TZA 03213 - W51
D	4	FZA 03006A - W52
E	5	SPARE - W53
F	6	LZS 03692 - W54
H	7	TZA 03234 A/B - W55
J	8	TZA 03714 - W56
K	9	QZA 03581 - W57
L	10	IZA 03052A - W58
M	11	TZA 03235 - W59
N	12	TZA 03052B - W60
P	13	SPARE - W61
R	14	PZA 03079 - W62
S	15	PZA 03236 - W63
T	16	ESA 03712 - W64
U	17	SPARE
V	18	SPARE
W	19	SPARE
X	20	SPARE
Y	21	SPARE
Z	22	SPARE
AA	23	SPARE
BB	24	SPARE
CC	25	SPARE
DD	26	SPARE
EE	27	SPARE
FF	28	SPARE
HH	29	SPARE
JJ	30	SPARE
KK	31	SPARE
LL	32	SPARE
MM	33	SPARE
NN	34	SPARE
PP	35	SPARE
RR	36	SPARE
SS	37	SPARE
TT	38	
UU	39	
VV	40	
WW	41	
XX	42	
YY	43	
ZZ	44	
a	45	
b	46	
c	47	
d	48	
e	49	
f	50	
g	51	
h	52	
i	53	
j	54	

RED
BLUE
GREEN
YELLOW
WHITE
BLACK
BROWN
VIOLET
ORANGE
PINK
TURQUOISE
GREY
RED/BLUE
GREEN/RED
YELLOW/RED
WHITE/RED
RED/BLACK
RED/BROWN
YELLOW/BLUE
WHITE/BLUE
BLUE/BLACK
ORANGE/BLUE
GREEN/BLUE
GREY/BLUE
YELLOW/GREEN
WHITE/GREEN
GREEN/BLACK
ORANGE/GREEN
GREY/GREEN
YELLOW/BROWN
WHITE/BROWN
BROWN/BLACK
GREY/BROWN
YELLOW/VIOLET
VIOLET/BLACK
WHITE/VIOLET

NON IS CABLE

INTERCONNECTING CABLE	
COLOUR	BLACK
SIZE	50 Core x 0.5
LENGTH	

No.3 AND No.7 PLANT ESD CABINET

VARELCO BLOCK 3/C737

PIN	TERM	ESD
A	1	1116:b2
B	2	1116:b4
C	3	1116:b6
D	4	1116:b8
E	5	1116:b10
F	6	1116:b12
H	7	1116:b14
J	8	1116:b16
K	9	1116:b18
L	10	1116:b20
M	11	1116:b22
N	12	1116:b24
P	13	1116:b26
R	14	1116:b28
S	15	1116:b30
T	16	1116:b32
U	17	
V	18	
W	19	
X	20	
Y	21	
Z	22	
AA	23	
BB	24	
CC	25	
DD	26	
EE	27	
FF	28	
HH	29	
JJ	30	
KK	31	
LL	32	
MM	33	
NN	34	
PP	35	
RR	36	
SS	37	
TT	38	
UU	39	
VV	40	
WW	41	
XX	42	
YY	43	
ZZ	44	
a	45	
b	46	
c	47	
d	48	
e	49	
f	50	
g	51	
h	52	
i	53	
j	54	

POLARISING CODE

INSULATOR BODY TYPE: R-G-4-S-3
MALE P
FEMALE R
LOCATION SIDE (LARGE DIA): G
GUIDE PIN G
GUIDE SOCKET S
POSITIONS: S
1 THROUGH 6 6

(THIS EXAMPLE MATES WITH P-S-4-G-3)

THIS DRAWING IS THE PROPERTY OF HIMA-SELLA LIMITED AND IS LOANED IN CONFIDENCE FOR USE WITH OUR WORK. IT IS NOT TO BE REPRODUCED IN ANY MANNER, SUBMITTED TO OUTSIDE PARTIES FOR EXAMINATION OR USED DIRECTLY OR INDIRECTLY FOR PURPOSES OTHER THAN THOSE FOR WHICH IT WAS FURNISHED WITHOUT WRITTEN CONSENT.

Template Revision – For Office Records Only

REV	AUTH	DATE	CAD TEMPLATE REF.
A	PRS	9.2.00	A3-FRAME

Scale on A3 sheet	N/A
Dimensions	N/A

DO NOT STAMP 'MASTER' UNTIL ALL WORK IS FULLY CADDED

Rev	Design	Drawn	Chkd	Appd	Description	Date
A	CT	RE	PGB	NGB	AS BUILT PER C10265-006V	29.05.12
B	DP	MW	AD	CT	AS BUILT PER C10265-012V	29.10.14
C	DP	MW	AD	CT	DRAWING ALTERATIONS	02.05.19
D				CT	PLANT 3 ESD CABINET MODS C10265039V	29.01.21

Designed	IM
Drawn	AB
Checked	IM
Approved	MRS
Date	11.08.11
Cad Reference	10265-P3-SCHEDULE#NH01

HIMA–SELLA LIMITED © HIMA-SELLA

Title : ELCO SCHEDULES - ESD/OPERATORS CONSOLE
ICI SYNETIX ESD SYSTEM - No.3 AND No.7 PLANTS
FISHER-ROSEMOUNT - P.O. No. 99003994

Contract/ Drawing No	C10265H/P3	206	REV	D

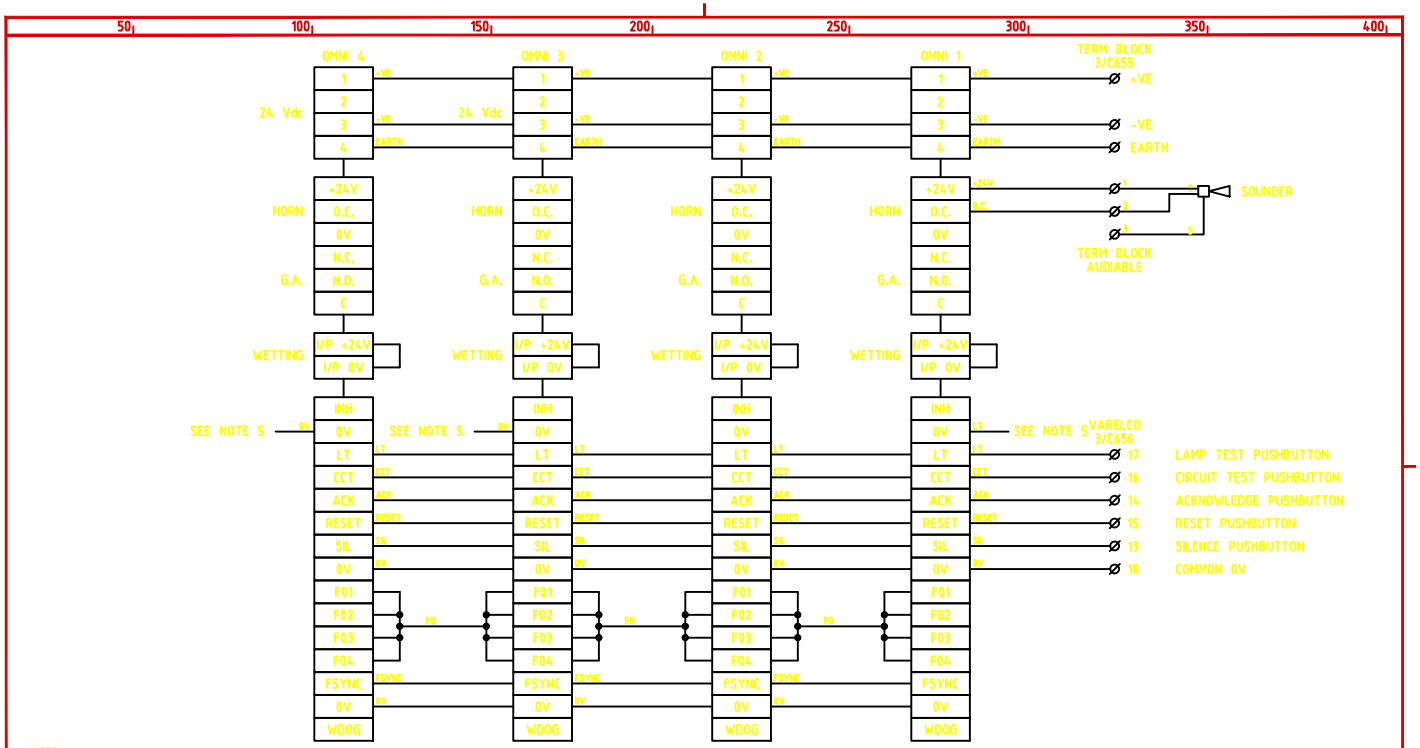

NOTES

1. POWER SUPPLY INPUTS TO BE WIRED IN PARALLEL.
2. PUSHBUTTON INPUTS TO BE WIRED IN PARALLEL.
3. F01, F02, F03 & F04 TO BE WIRED TOGETHER TO FORM ONE FIRST OUT GROUP OF 16.
4. FSYNC TO BE WIRED TOGETHER TO ENABLE THE ALARM WINDOWS TO FLASH IN SYNCHRONIZATION.
5. COMMON 0V CONNECTION USED FOR WINDOWS 01 TO 48. (WIRED AS RING)

THIS DRAWING IS THE PROPERTY OF HIMA-SELLA LIMITED AND IS LOANED IN CONFIDENCE FOR USE WITH OUR WORK. IT IS NOT TO BE REPRODUCED IN ANY MANNER, SUBMITTED TO OUTSIDE PARTIES FOR EXAMINATION OR USED DIRECTLY OR INDIRECTLY FOR PURPOSES OTHER THAN THOSE FOR WHICH IT WAS FURNISHED WITHOUT WRITTEN CONSENT.

Scale on A3 sheet N/A
Dimensions N/A

Template Revision – For Office Records Only

REV	AUTH	DATE	CAD TEMPLATE REF.
A	PRS	9.2.00	A3-FRAME

DO NOT STAMP 'MASTER' UNTIL ALL WORK IS FULLY CADDED

Rev	Design	Drawn	Chkd	Appd	Description	Date
C	NH	NH	CW	NGB	AS BUILT.	06.06.00
D	IM		IM		SITE MODS	11.08.11

Designed	NH
Drawn	NH
Checked	CW
Approved	NGB
Date	02.05.00
Cad Reference	10265-P3-SCHEDULE#NH01

HIMA–SELLA LIMITED © HIMA-SELLA

Title : ANNUNCIATOR WIRING DIAGRAM – No.3 PLANT
ICI SYNETIX ESD SYSTEM – No.3 AND No.7 PLANT
FISHER-ROSEMOUNT – P.O. No. 99003994

Contract/ Drawing No C10265H/P3 208 REV D

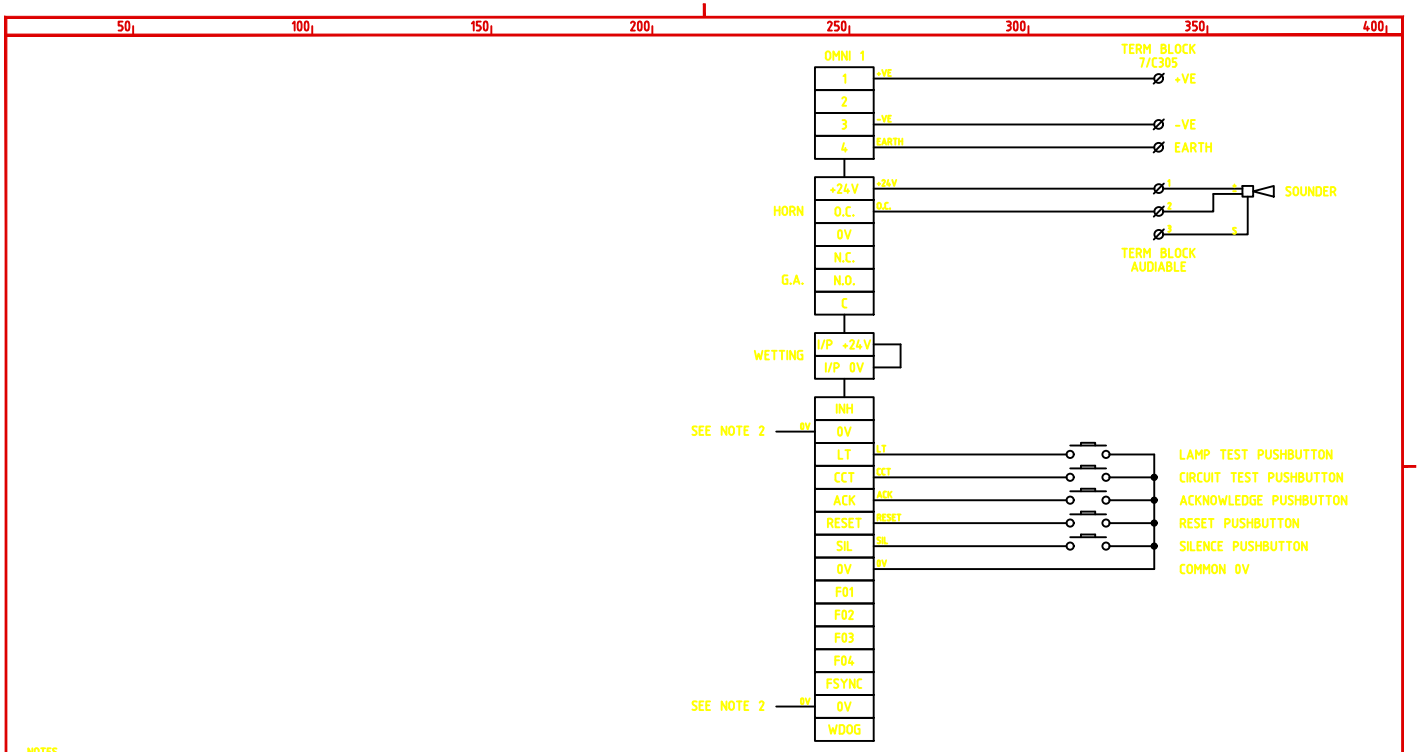

NOTES:

1. POWER SUPPLY INPUTS TO BE WIRED IN PARALLEL.
2. PUSHBUTTON INPUTS TO BE WIRED IN PARALLEL.
3. F01, F02, F03 & F04 TO BE WIRED TOGETHER TO FORM ONE FIRST OUT GROUP OF 16.
4. FSYNC TO BE WIRED TOGETHER TO ENABLE THE ALARM WINDOWS TO FLASH IN SYNCHRONIZATION.
5. COMMON 0V CONNECTION USED FOR WINDOWS 01 TO 48. (WIRED AS RING)

THIS DRAWING IS THE PROPERTY OF HIMA-SELLA LIMITED AND IS LOANED IN CONFIDENCE FOR USE WITH OUR WORK. IT IS NOT TO BE REPRODUCED IN ANY MANNER, SUBMITTED TO OUTSIDE PARTIES FOR EXAMINATION OR USED DIRECTLY OR INDIRECTLY FOR PURPOSES OTHER THAN THOSE FOR WHICH IT WAS FURNISHED WITHOUT WRITTEN CONSENT.

Scale on A3 sheet: N/A
Dimensions: N/A

Rev	Design	Drawn	Chkd	Appd	Description	Date
C	NH	NH	CW	NGB	AS BUILT.	06.06.00

Designed	NH
Drawn	NH
Checked	CW
Approved	NGB
Date	02.05.00
Cad Reference	10265-P3-SCHEDULE#NH01

Template Revision – For Office Records Only

REV	AUTH	DATE	CAD TEMPLATE REF.
A	PRS	9.2.00	A3-FRAME

DO NOT STAMP 'MASTER' UNTIL ALL WORK IS FULLY CADDED

HIMA–SELLA LIMITED © HIMA-SELLA

Title : ANNUNCIATOR WIRING DIAGRAM – No.7 PLANT
ICI SYNETIX ESD SYSTEM – No.3 AND No.7 PLANT
FISHER-ROSEMOUNT – P.O. No. 99003994

Contract/ Drawing No			REV	
C10265H/P3	209		REV	C

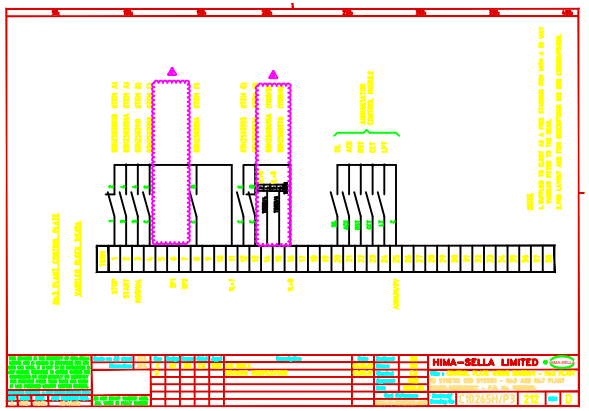
HIMA-SELLA LIMITED
C10265H/P3
212
D

THIS DRAWING IS THE PROPERTY OF HIMA-SELLA LIMITED AND IS LOANED SUBJECT TO AGREEMENT WITH OUR WORK. IT IS NOT TO BE REPRODUCED IN ANY MANNER, SUBMITTED TO OUTSIDE PARTIES FOR EXAMINATION OR USED DIRECTLY OR INDIRECTLY FOR PURPOSES OTHER THAN THOSE FOR WHICH IT WAS FURNISHED WITHOUT WRITTEN CONSENT.

REV	AUTH	DATE	CAD TEMPLATE REF
A	PMS	27.3.01	A3PORTRAIT

Template Revision - For Office Records Only

DO NOT STAMP 'MASTER UNTIL ALL WORK IS FULLY CHECKED

Scale on A3 sheet	N/A
Dimensions	N/A

				C	NH	NH
				CW	NGB	AS BUILT.
				06.06.00		

Rev | Desn'gnd | Drawn | Chkd | Appd | Description | Date

Cust Reference	Designed
Date	Drawn
Checked	NH
Approved	CW
05.04.00	NGB

TERM

1	1	2	PELLET SELECTION No.3 OR No.4 (ITEM AF)
2	3	4	PELLET SELECTION No.3 OR No.4 (ITEM AF)
3			
4	C	E	RESET RSD & CHAIN SENSORS (ITEM AG)
5			
6	C	E	RESET METAL DISTORTION TRIP 7T15 (ITEM AH)
7			
8	C	E	LOCKOUT RESET (ITEM AJ)
9			
10	C	E	BURNER - OFF ON (ITEM AL)
11			
12	C	E	BURNER - NORMAL OVERRIDE (ITEM AM)
13			
14	C	E	FV 7002 - OPEN CLOSE (ITEM AN)
15			
16	C	E	FV 7003 - OPEN CLOSE (ITEM AP)
17			
18			
19			BURNER - NORMAL OVERRIDE (ITEM AM)
20	1	2	LOCKOUT RESET LAMP (ITEM AJ)
21			
22			
23			
24			
25			
26			
27			

No.7 PLANT CONTROL PLATE

TERMINAL BLOCK 7/C303

NOTES

1. SUPPLIED TO CLIENT AS A FREE STANDING ITEM WITH A 38 WAY VARELCO FITTED TO THE REAR.
2. FOR LAYOUT AND ITEM DESCRIPTIONS SEE DRG C10265H/P3/028.

HIMA-SELLA LIMITED

Title : CONTROL PLATE WIRING DIAGRAM - No.7 PLANT

ICI SYNETIX ESD SYSTEM - No.3 AND No.7 PLANT

FISHER-ROSEMOUNT - P.O. No. 99003994.

Coursheet/ Drawing No	REV
C10265H/P3	C
213	

50 100 150 200 250 300 350 400